


**CURVE DATA**  
 Shelburne Conn. M.B.  
 P.C. = 178+54.90  
 D = 2°-00' Chord Def.  
 Δ = 10°-22'-55.2"  
 R = 2,864.93'  
 L = 519.10'  
 T = 260.20'  
 Bank 1/4" per ft.





ESTIMATED QUANTITIES						
FINAL	ITEM #	ITEM	UNIT	NEAT	OVERRUN	TOTAL
333	107	Structure Excavation	C.Y.	338	338	676
145	204	Subbase of Crushed Rock Mod. (Under Structure)	C.Y.	348	348	696
*	0	361-B Bit Conc. Pav't. (Incl. Appr. Slab) Mod.	Ton	418	418	836
717	401-B	Conc. Class B Mod. (Incl. Appr. Slab)	C.Y.	368	368	736
110,504	402	Reinforcing Steel (Incl. Appr. Slab)	Lb.	110,503	—	110,503
1	403	Spiral Reinforcement (7.75")	Lb.	1-25	—	1-25
284,339	404-A	Structural Steel	Lb.	283,339	1,000	284,339
54	407	Asphaltic Asbestos Coating	S.Y.	50	—	50
1/2	501	Furnishing Equipment for Driving Piles	L.S.	—	—	—
3,764	502-B	Treated Timber Piling	L.F.	3,764	—	3,764
1	503	Splices for Steel Piling	Each	—	—	—
1,116	504	Steel H Piling (12BP53)	L.F.	1,116	—	1,116
564	556-C	Granite Bridge Curb (Incl. Appr. Slab) Mod.	L.F.	564	—	564
523	572	Bridge Railing	L.F.	523	—	523
*	0	222 Gravel Backfill	C.Y.	—	—	—
*	0	318 Tar Emulsion for Bridge Floors	Gal.	423	—	423
*	0	372 Joint Sealer Hot Poured Plastic Type	L.F.	122	—	122

**\* Included in Roadway Quantity GENERAL NOTES**

- All materials and construction shall conform to the State of Vermont, Department of Highways, Standard Specifications for Road and Bridge Construction dated Jan. 1956 and the A.A.S.H.O. Standard Specifications dated 1957 designed for H-20-S16-44 loading modified for National System of Interstate Highways applied in accordance with the provision of the A.A.S.H.O. Standard Specifications, Article 3.2.8.
- Unless otherwise called for all beams shall be rolled to a true circular camber the middle ordinate being that shown in the A.I.S.C. handbook as being the minimum camber likely to remain permanent.
- Final coat of field paint shall be Green, unless otherwise directed by the Engineer.
- All dimensions given are measured horizontally, or vertically unless, otherwise noted.
- All dimensions given at 68°F.
- All reinforcing to have a clear cover of 3", unless, otherwise noted.
- All exposed edges of concrete shall be chamfered 1/4" unless, otherwise noted.
- Soilings indicated on the drawings have been made for design purposes only and are not warranted to show actual subsurface conditions.
- Elevation Datum Sea Level based on Bench Line U.S.C.G.S. Survey Level Line Vermont 25 (Second Order).
- Steel Bearing Piles shall be driven to ledge rock unless otherwise approved by the Engineer. When Piles are driven in fill, the material should be such as to have no stones large enough to interfere with the driving of piles.
- Cross slope of Approach Slab to conform with the Cross Slope of Bridge.
- The top surfaces of all piers and abutments shall be sloped 1/4" per foot from back edge of abutments or centerlines of piers, except for bearing pads projecting 1" or more above the general area, which surfaces shall be level. The entire exposed top surface of the Piers & Abutments shall be coated with asphaltic asbestos coating 1/2" thick as per item 40 of specifications.

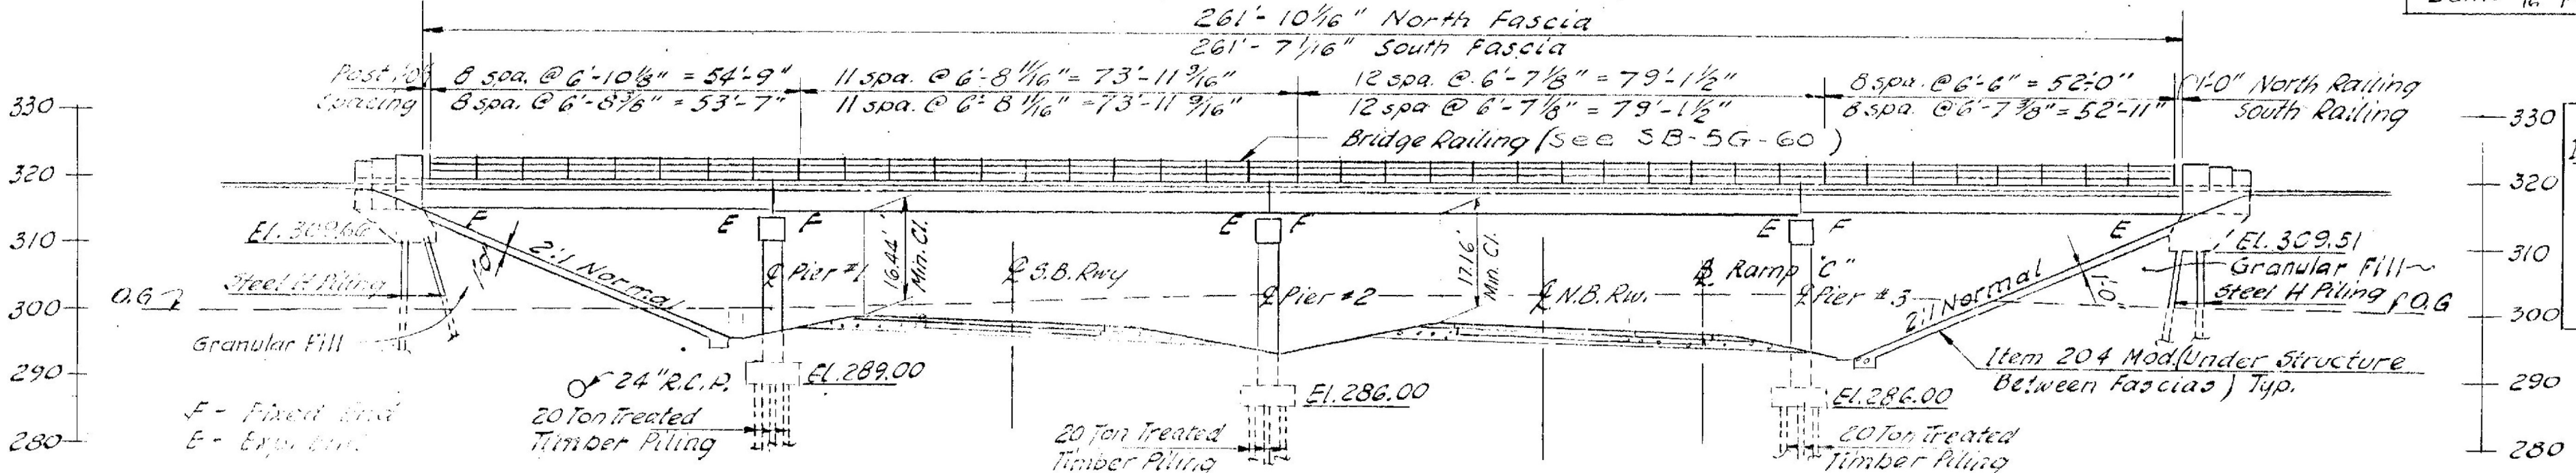

**CURVE DATA**  
 Interstate Base Line  
 Δ = 37°-21'-05.92"  
 D = 1°-45' (Chord)  
 R = 3274.17'  
 L = 1851.52'  
 T = 951.29'  
 Bank 1/4" per ft.

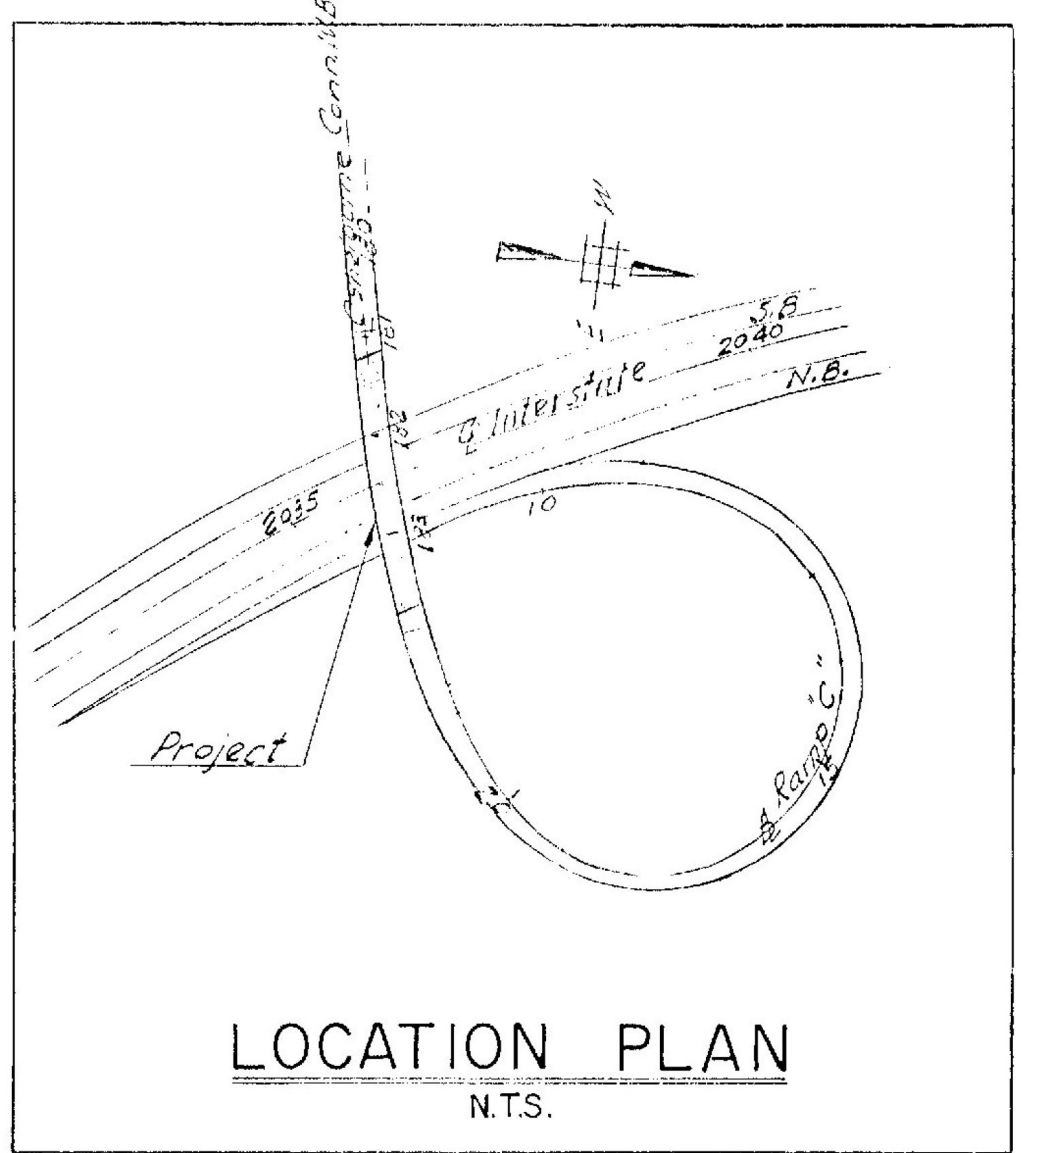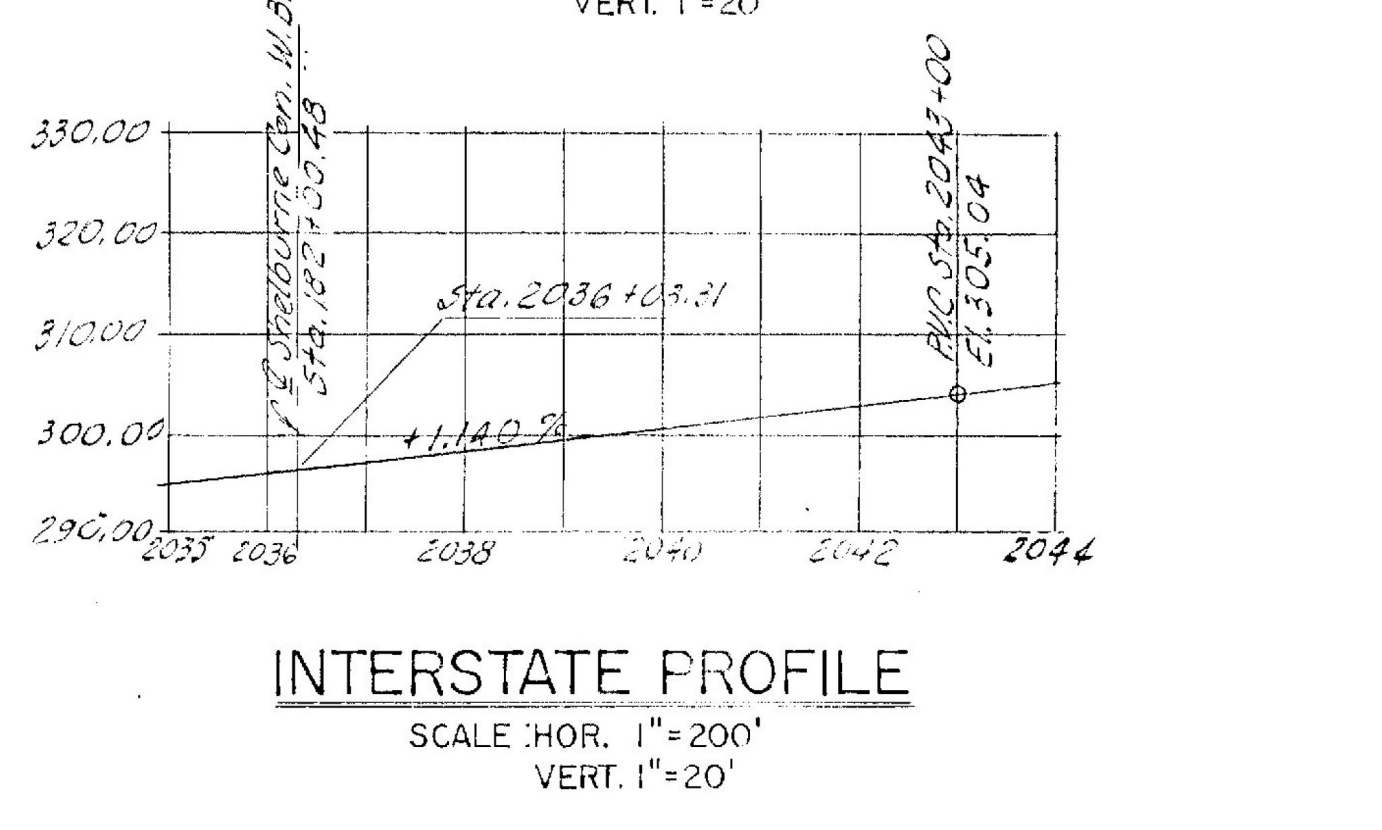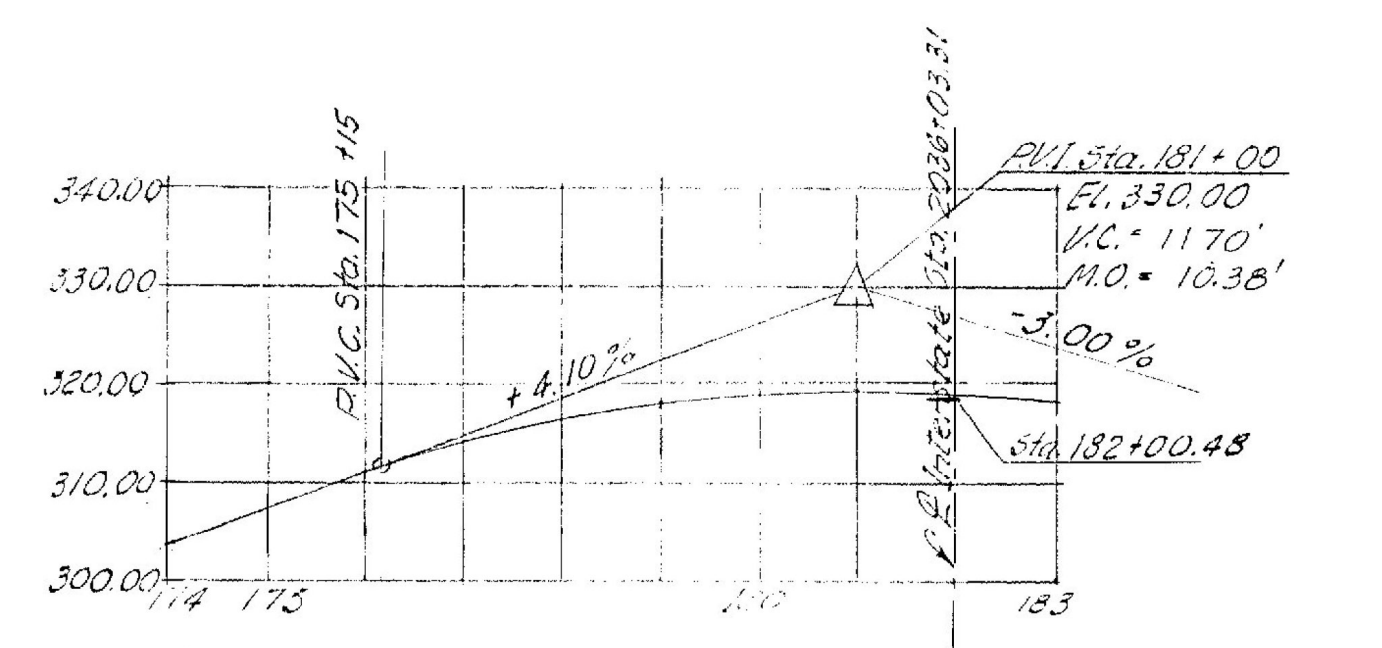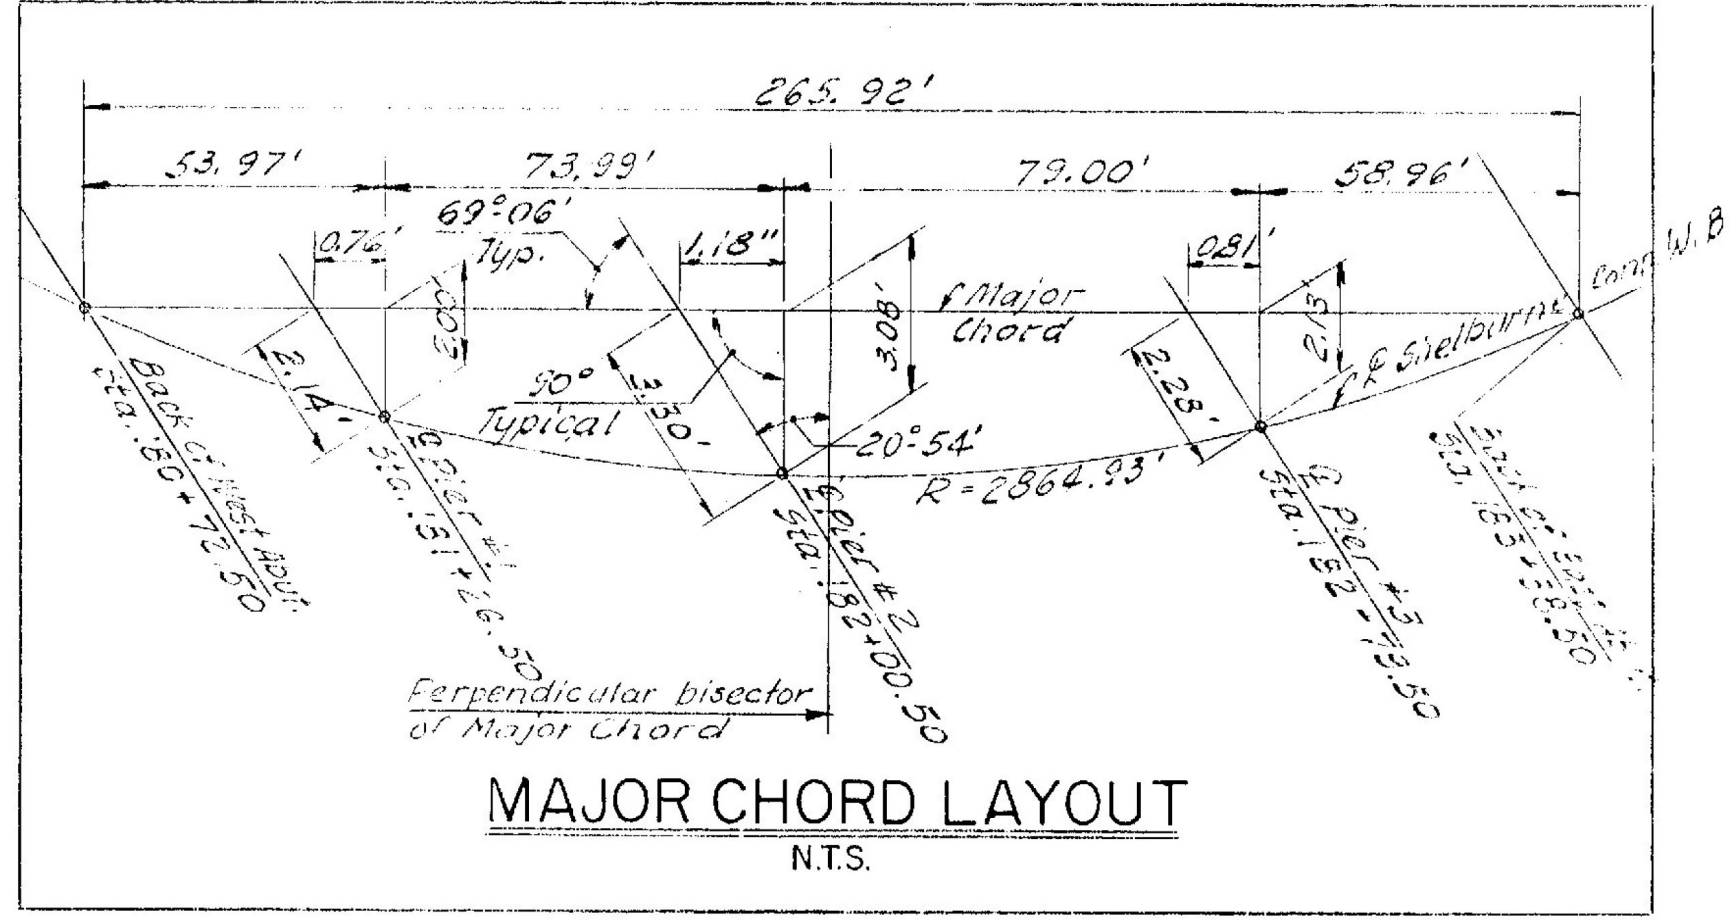

**REFERENCE DRAWINGS**

- |                                     |                              |
|-------------------------------------|------------------------------|
| Plan Interstate                     | Sh. # 12                     |
| Profile Interstate                  | Sh. # 13                     |
| Cross Sections Interstate           | Sh. # 36, Sh. # 37, Sh. # 38 |
| Profile Shelburne Conn. W.B.        | Sh. # 20                     |
| Cross Sections Shelburne Conn. W.B. | Sh. # 67, Sh. # 68, Sh. # 74 |
| Plan Shelburne Conn. W.B.           | Sh. # 11, Sh. # 12, Sh. # 16 |

**LIST OF DRAWINGS**

- |                               |                   |
|-------------------------------|-------------------|
| General Plan & Elevation      | Sh. # B-1         |
| Pier Plans & Elevations       | Sh. # B-2         |
| Pier Details                  | Sh. # B-3         |
| Abutment Details              | Sh. # B-4         |
| Finality Plan                 | Sh. # B-5         |
| Approach Slab #1              | Sh. # B-6         |
| Approach Slab #2              | Sh. # B-7         |
| Bearing Plans                 | Sh. # B-8         |
| Bar Schedule                  | Sh. # B-9         |
| Preliminary Information Sheet | Sh. # B-10        |
| SC B-10-60                    | Sh. # 150         |
| SC B-11-60                    | Sh. # 151         |
| SB 5G-60 1 or 2 of 2 of 2     | Sh. # 152 & # 153 |
| SB-20-60                      | Sh. # 156         |
| SB-22-60                      | Sh. # 157         |

**WILLISTON - GEORGIA**  
 IM MEMB (25)  
 SHEET 24 OF 38  
 BRIDGE 67  
 FOR REFERENCE ONLY

**FOR REFERENCE ONLY**  
 BRIDGE # 67

STATE OF VERMONT  
 DEPARTMENT OF HIGHWAYS

INTERSTATE PROJECT IN THE TOWN OF  
 SOUTH BURLINGTON

UNDERPASS STA. 2036+03.31  
 SHELburne INTERCHANGE W.B.  
 GENERAL PLAN & ELEVATION

BOSWELL ENGINEERING CO. RIDGEFIELD PARK, N.J.

DRAWN BY A.M. IN CHARGE A.L.L.  
 CHECKED BY S.L.L. DATE SCALE AS SHOWN

PROJECT NO. I 89-3 (14) SHEET 170 OF 195