


View A-A (Typical each end)
Scale 3/4" = 1'-0"

Notes:

1. For curb details not shown see std. Shs. SCB-D6-65, Detail A, and SCB-37.25-65.
2. For joint details see App. Slabs #1 & #2 Bridge Sh. BR-110.
3. For railing details not shown see Std. Sh. SB-R1-G4, sheet #1 & #2 and SB-R2-G5.
4. For details of Construction Joints & Score Marks see Std. Sheet SCB-D6-65, Detail B.

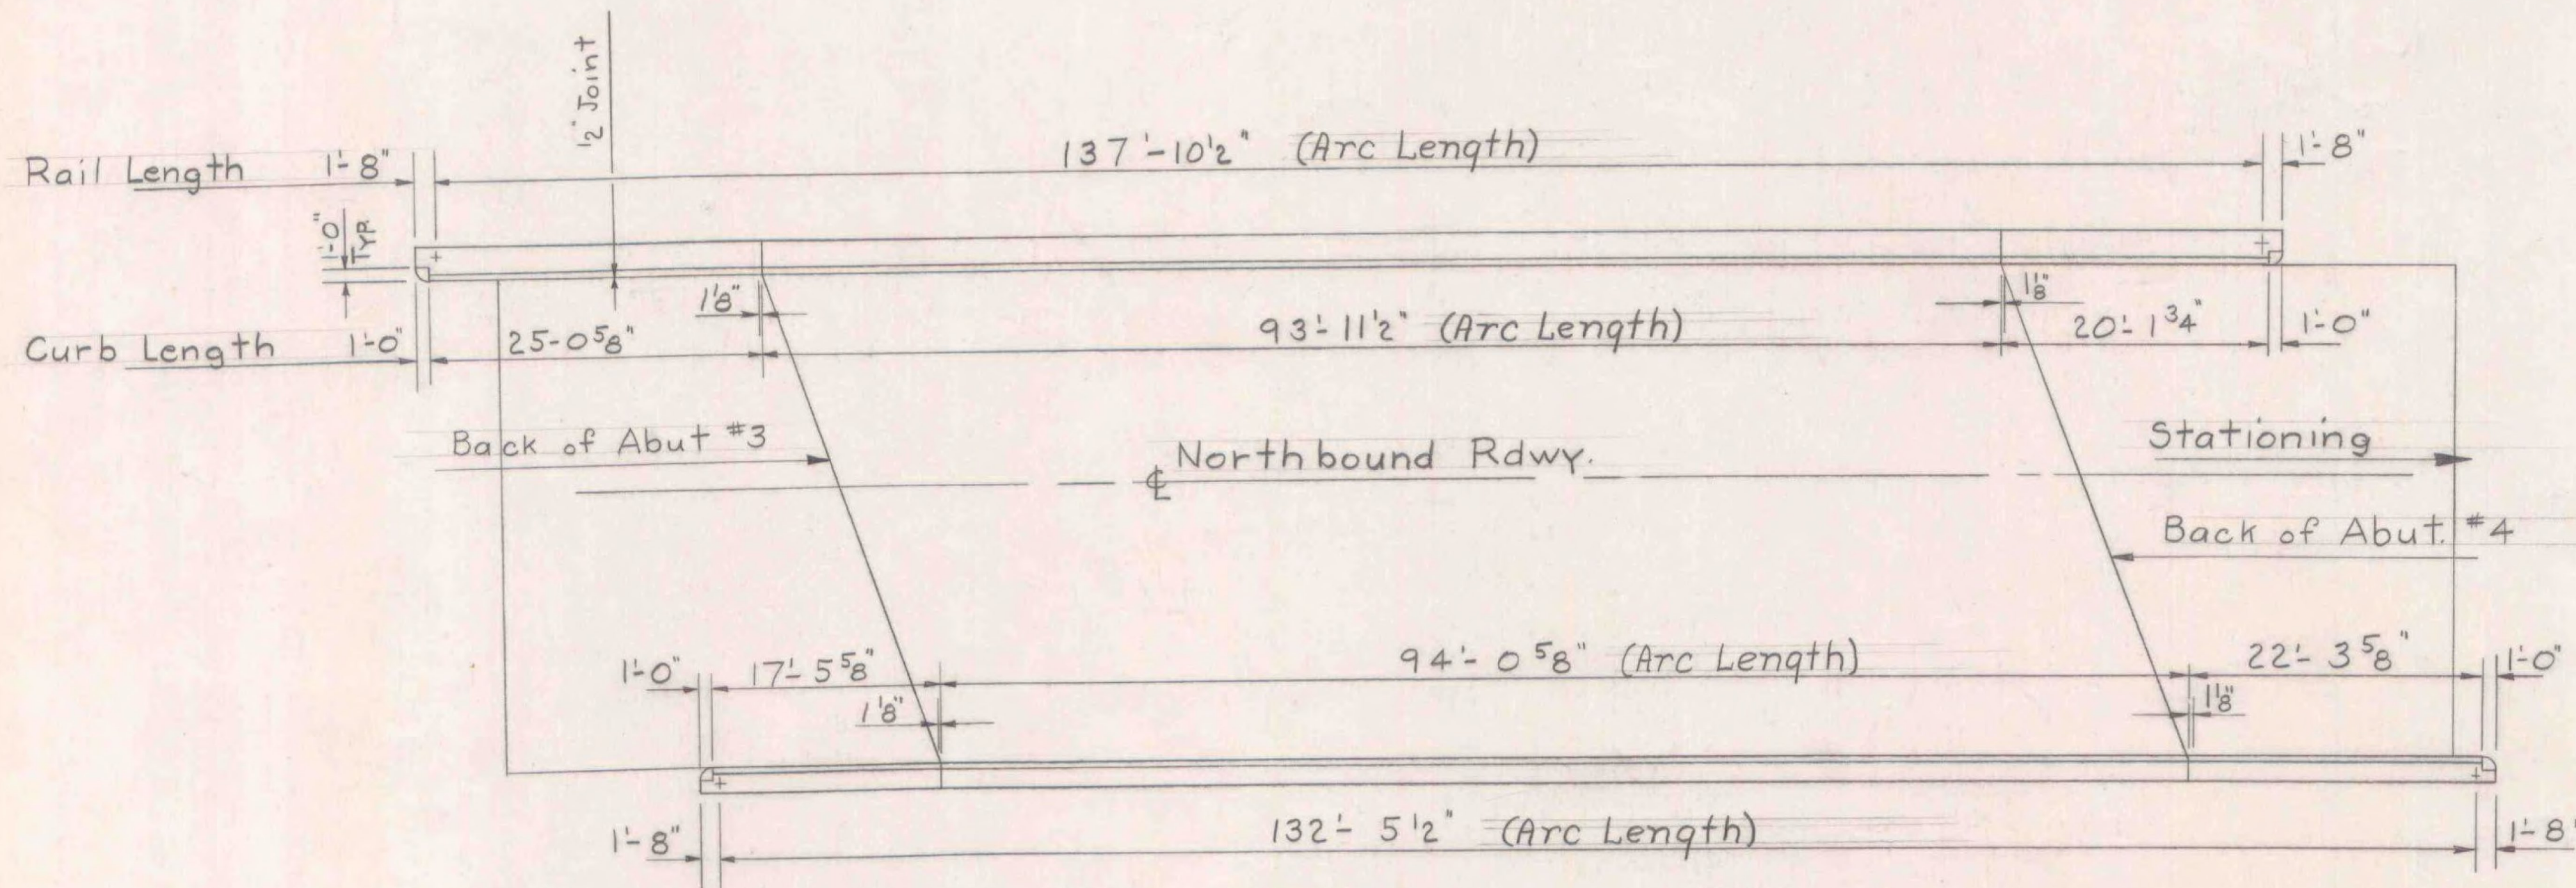

Curb and Rail Plan
Scale 1" = 10'-0"

WILLISTON - GEORGIA
 IM MEMB(25)
 SHEET 32 OF 38
 BRIDGES 84 N AND S
 FOR REFERENCE ONLY

ITEM NO.	ITEM	UNIT	NET	TOTAL	FINAL
	CHAN. EXCAV. OF EARTH	C.Y.			
	CHAN. EXCAV. OF ROCK	C.Y.			
	UNCLASS. CHAN. EXCAV.	C.Y.			
	STRUCT. EXCAV.	C.Y.			
	CONC. CLASS AA (MOD.)	C.Y.			
	CONC. CLASS B (MOD.)	C.Y.			
	REINF. STEEL	LBS.			
	ASPHALTIC-ASB. COATING	S.Y.			
	TREATED TIMBER PILING	L.F.			
	SPLICES FOR STEEL PILING	EA.			
	STEEL PILING	L.F.			
	UNTREATED TIMBER PILING	L.F.			

STATE OF VERMONT
DEPARTMENT OF HIGHWAYS

TOWN OF Milton-Georgia
 ROUTE No. I 89 LOG STA. I 89 over Town Road #6
Curb and Rail Plan
 SCALE As Noted

SURVEYED BY _____
 DRAWN BY A.J.C. CHECKED BY J.W.
 PROJECT NO. I 89-309
 SHEET 32 OF 38