


Plan-Approach Slab #1
Scale 1/4" = 1'-0"

Plan-Approach Slab #2
Scale 1/4" = 1'-0"

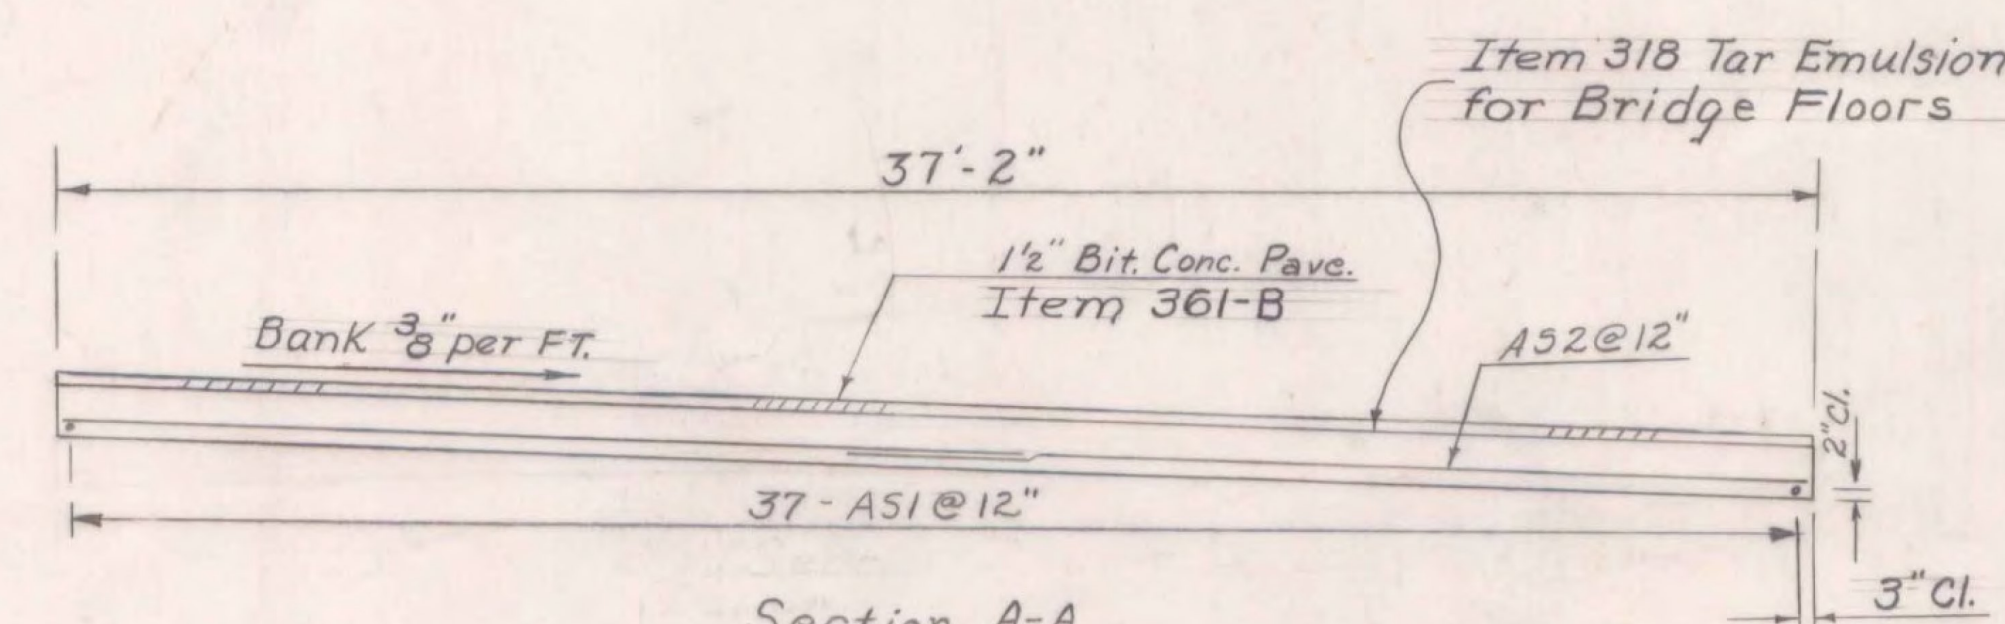

Section A-A
Scale 1/4" = 1'-0"

Note:
Approach Slabs and Bridge
to have same Cross Slope.

- Notes:
- For details of Item 372-C see Approach Slabs #3 & 4, Sh. BR111
 - For reinforcing steel details in section C-C and details of Approach Slab bracket, not shown, see Std. Sh. SCB-D2-65, Detail A.

**WILLISTON - GEORGIA
IM MEMB(25)
SHEET 37 OF 38
BRIDGES 84 N AND S
FOR REFERENCE ONLY**

ITEM NO.	ITEM	UNIT	NET	TOTAL	FINAL
	CHAN. EXCAV. OF EARTH	C.Y.			
	CHAN. EXCAV. OF ROCK	C.Y.			
	UNCLASS. CHAN. EXCAV.	C.Y.			
	STRUCT. EXCAV.	C.Y.			
	CONC. CLASS AA (MOD.)	C.Y.			
	CONC. CLASS B (MOD.)	C.Y.			
	REINF. STEEL	LBS.			
	ASPHALTIC-ASB. COATING	S.Y.			
	TREATED TIMBER PILING	L.F.			
	SPLICES FOR STEEL PILING	EA.			
	STEEL PILING	L.F.			
	UNTREATED TIMBER PILING	L.F.			

STATE OF VERMONT
DEPARTMENT OF HIGHWAYS

TOWN OF Milton-Georgia
ROUTE No. I 89 LOG STA. I 89 over Town Highway No. 6
Approach Slabs 1 & 2 (S.B.)
SCALE As Noted
SURVEYED BY _____
DRAWN BY J.W. CHECKED BY A.J.C.
PROJECT No. I 89-2(29)
SHEET 60 OF 272