


GENERAL NOTES:

1. Elevation Datum is sea level based on nearest U. S. Government vertical control.
2. For additional notes see SCB-DI-63.

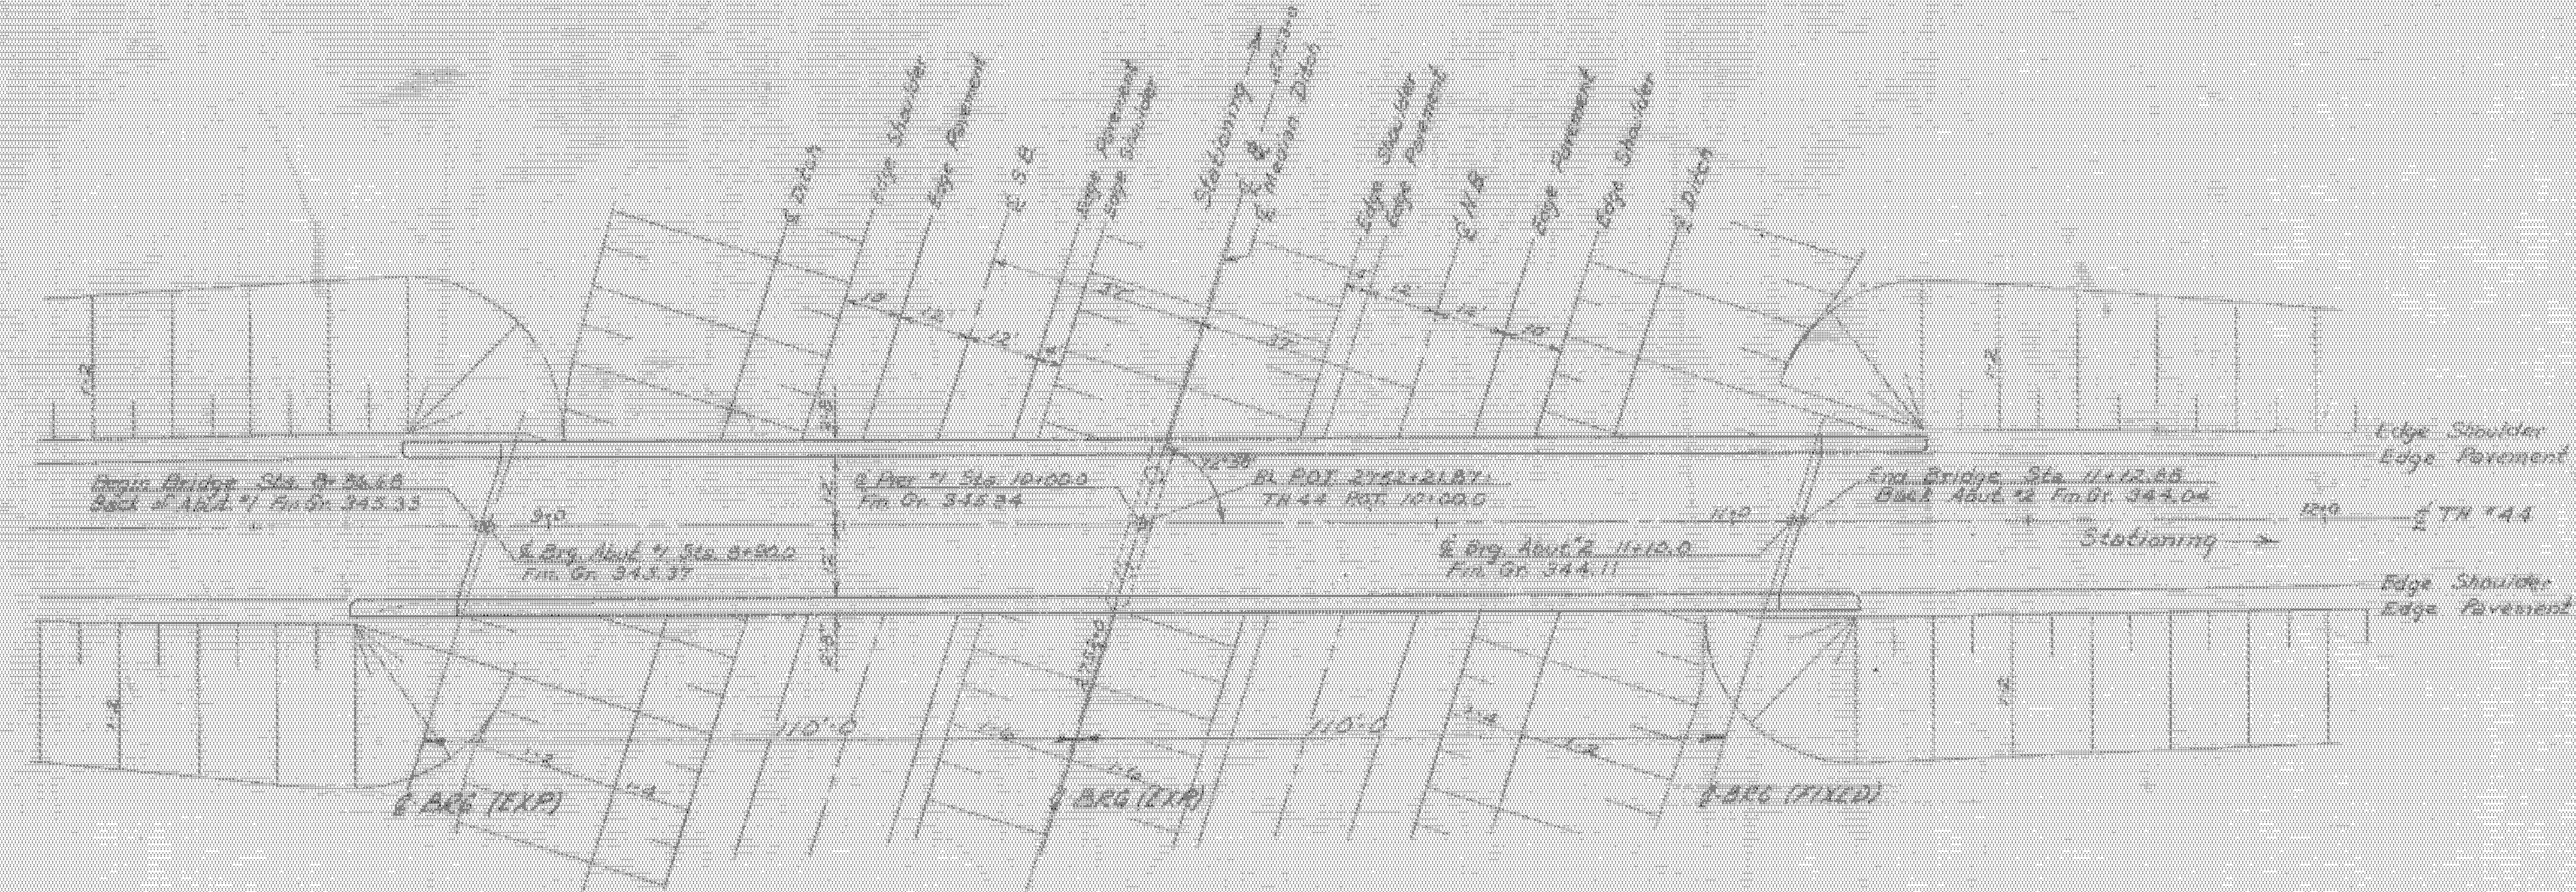


Plan
Scale: 1" = 20'

LIST OF SHEETS:

- BR. 100 - Plan and Elevation
- 101 - Bridge Quantity Sheet
- 102 - Preliminary Information Sheet
- 103 - Borings
- 104 - Girder Details
- 105 - Bracing Details and Bearing Details
- 106 - Expansion Dam Details
- 107 - Abutment No. 1
- 108 - Abutment No. 2
- 109 - Pier
- BR. 110 - Reinforcing Steel Schedule

STANDARD SHEETS

- G-3a
- SCB-DI-65
- SCB-D4-65
- SB-R1-64 Sh 1 of 2
- SB-R2-65
- SCB-D4-65

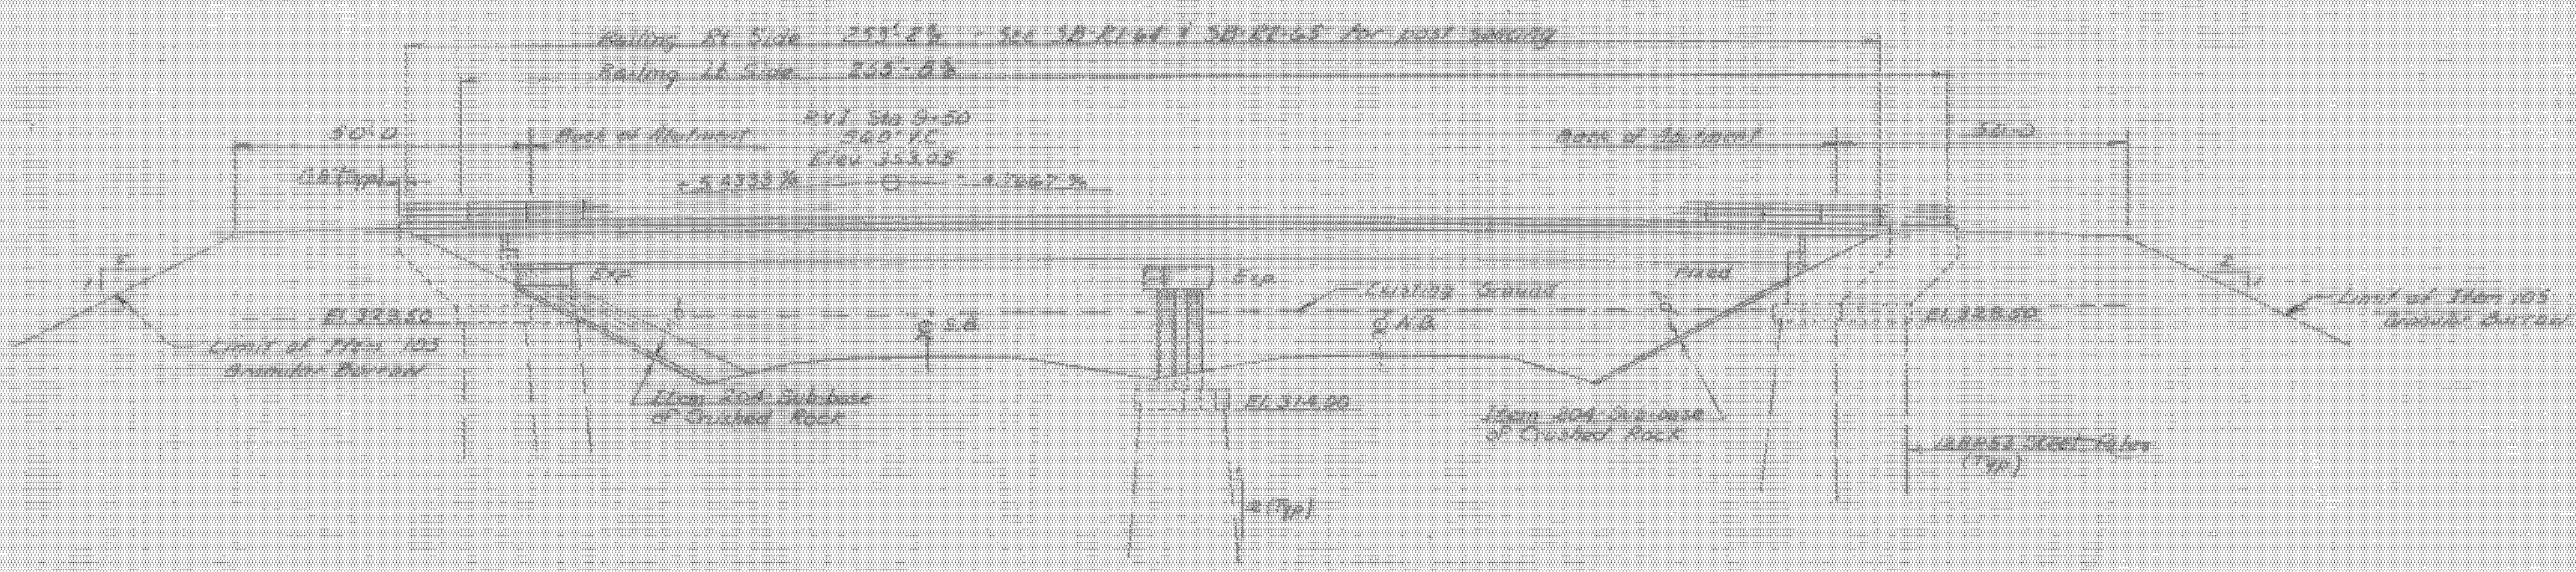

Elevation
Scale: 1" = 20'

MILTON-HIGHGATE
IM MEMB(26)

SHEET 18 OF 70
BRIDGE 80
FOR REFERENCE ONLY

188-B
M

ITEM NO.	ITEM	UNIT	REV	TOTAL	FMUL
	CRACK REPAIR OF GIRTH	C.Y.			
	CRACK REPAIR OF RIBS	C.Y.			
	UNCLASSED CHOL. CONCR.	C.Y.			
	STRUT CURVE	C.Y.			
	CONC. CLASS. AS. G.F.B.I.	C.Y.			
	FORM. CLASS. B. G.F.B.I.	C.Y.			
	REBAR SWELL	LSB.			
	REPAIR TO AND STRUTS	C.Y.			
	HEAVY TRUSS FRINGE	C.Y.			
	FRYING FOR STEEL TRUSS	LS.			
	WELD PLATE	C.Y.			
	REINFORCED CONCR. PILING	C.Y.			

BR. 100 OF 110

STATE OF VERMONT
DEPARTMENT OF HIGHWAYS

PROJECT NAME COLCHESTER MILTON
TOWN OF MILTON
New Class 2
ROUTE NO. TR 44 Loc Sta
TR 44 OVER 109 & STA 2752+21.87

PLAN AND ELEVATION
SCALE As shown

DRAWN BY VBT CHECKED BY RLO
PROJECT NO. 109-3(24)
SHEET 102 OF 419