


147

147



Dated November 4, 1965
FRANK PALAZZI & SONS, INC.
THE PALAZZI CORPORATION
John Palazzi Thomas Palazzi
 PRESIDENT Assistant Treasurer
 Contractor
Russell A. Holden
 Commissioner of Highways

STATE OF VERMONT
 DEPARTMENT OF HIGHWAYS
PROPOSED IMPROVEMENT
 INTERSTATE PROJECT
 PROJECT I 89-3 (34)
TOWNS OF COLCHESTER-MILTON
 COUNTY OF CHITTENDEN
 INTERSTATE ROUTE 89
 BURLINGTON-ST. ALBANS ROAD

BEGINNING AT A POINT IN THE TOWN OF COLCHESTER, 0.416 MILE
 SOUTHERLY OF THE COLCHESTER-MILTON TOWN LINE AND EXTENDING
 NORTHERLY FOR A DISTANCE OF 6.699 MILES
 LENGTH OF ROADWAY 34,855.86 FEET = 6.602 MILES
 LENGTH OF BRIDGES 515.29 FEET = 0.097 MILE
 LENGTH OF PROJECT 35,371.06 FEET = 6.699 MILES

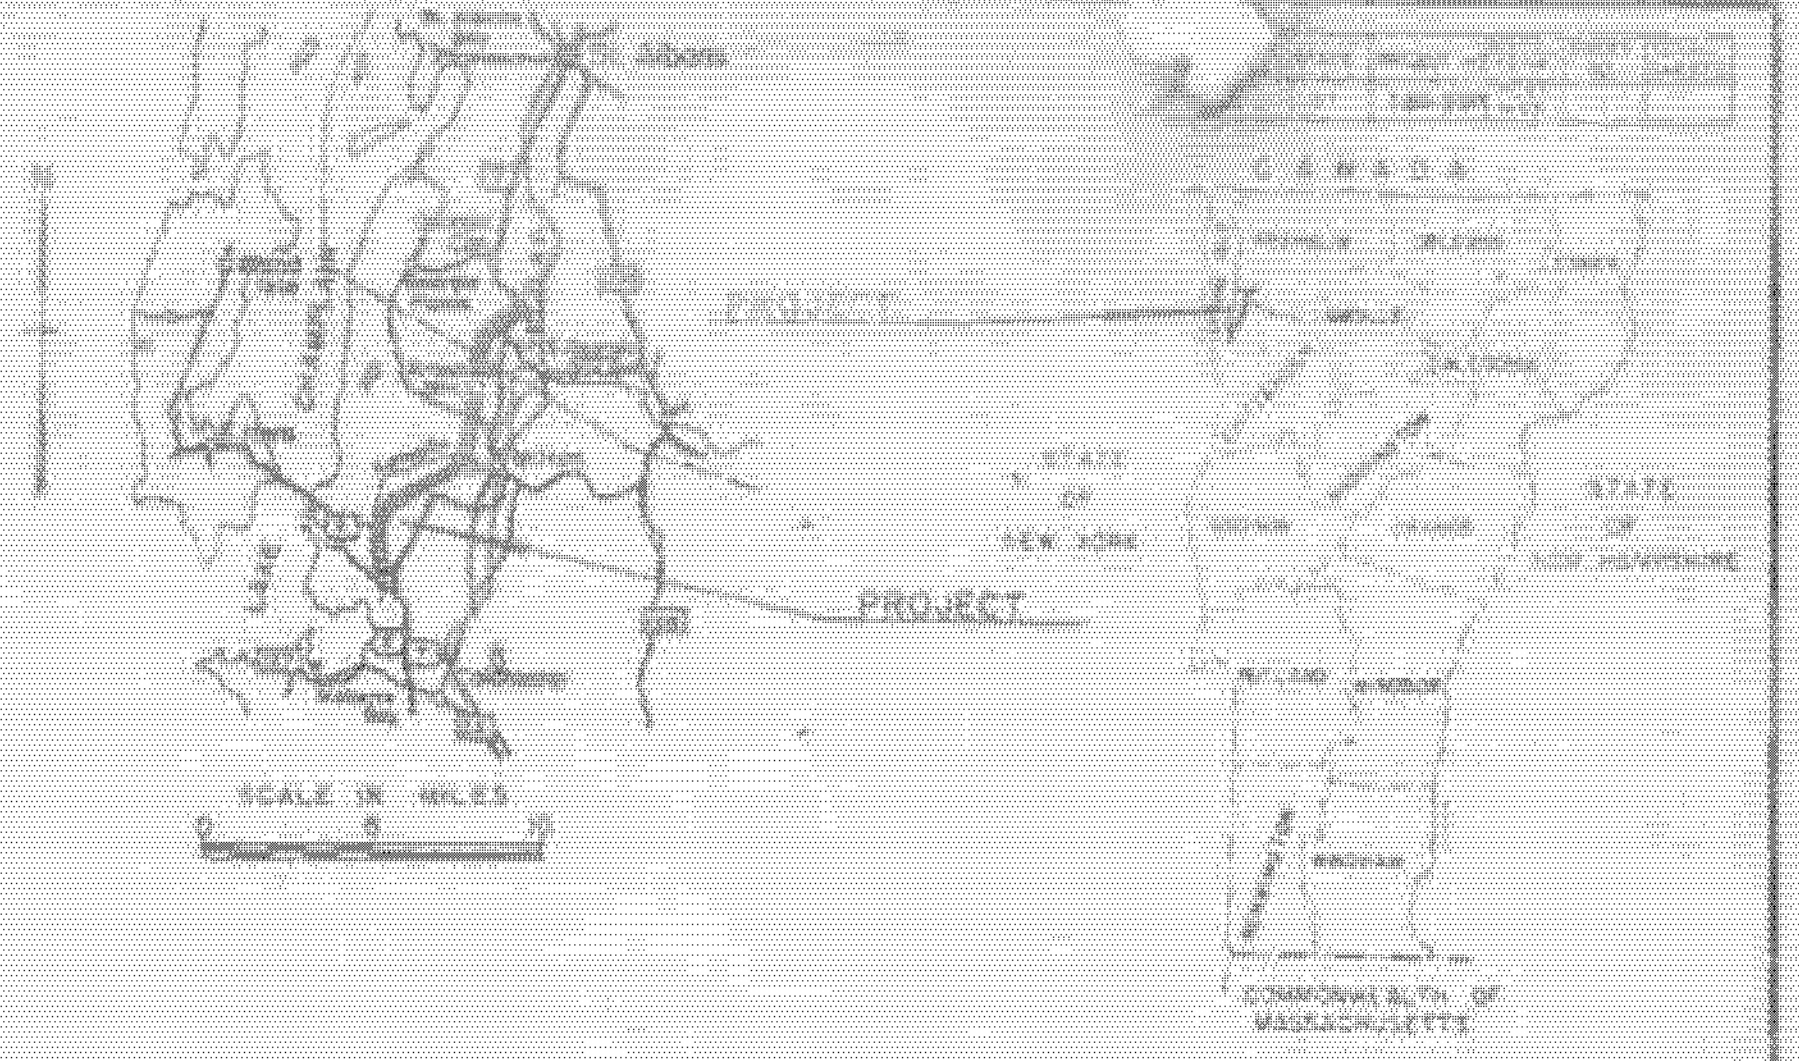

THESE PLANS HAVE BEEN REDUCED PHOTOGRAPHICALLY
 TO APPROXIMATELY 1/8 SCALE

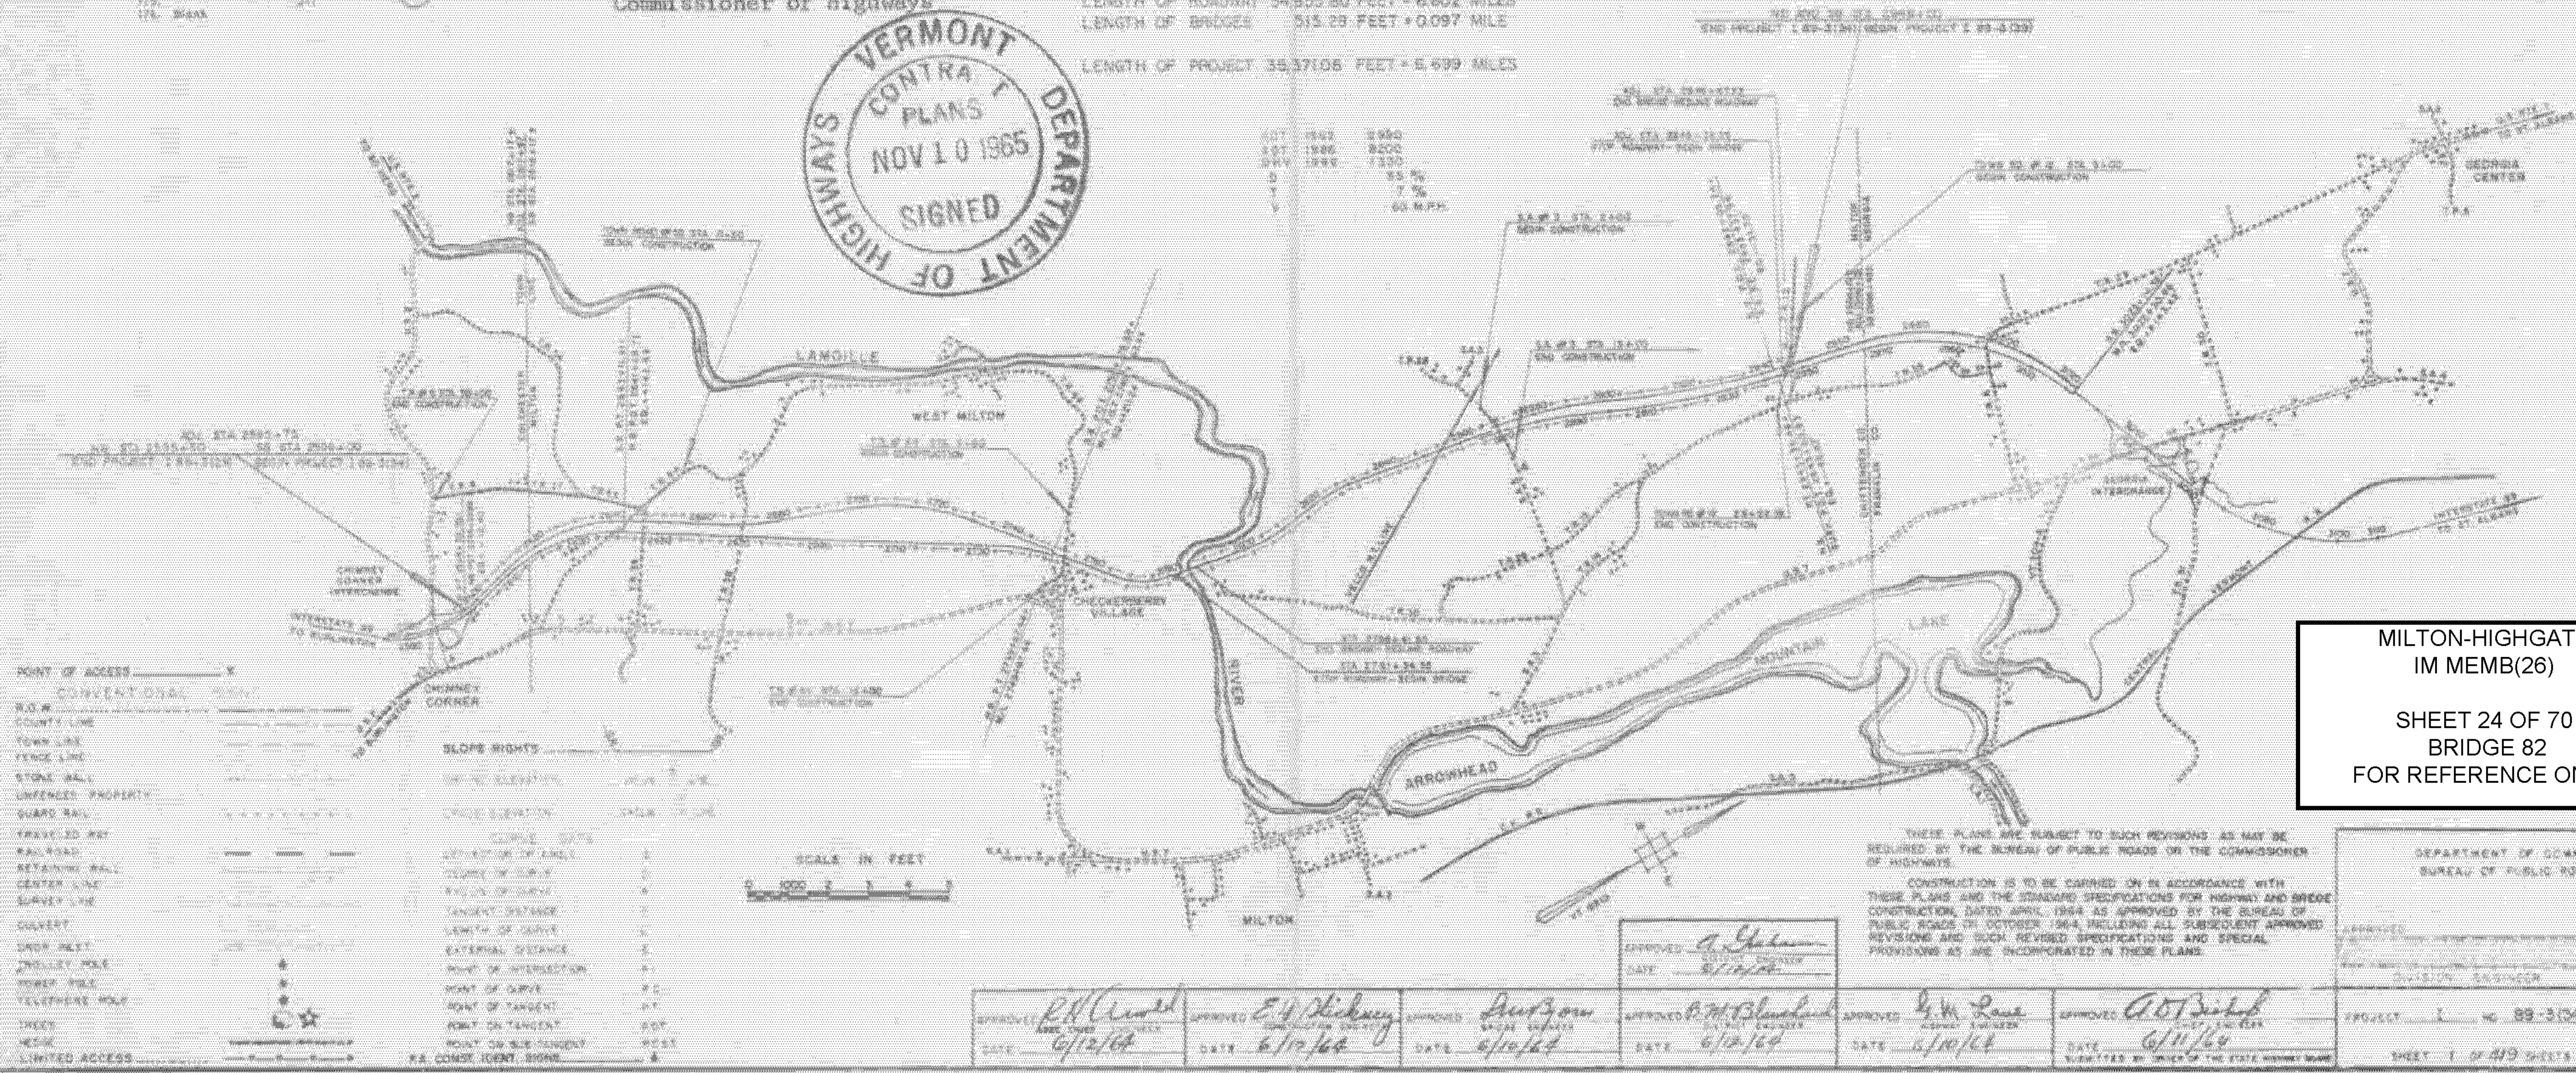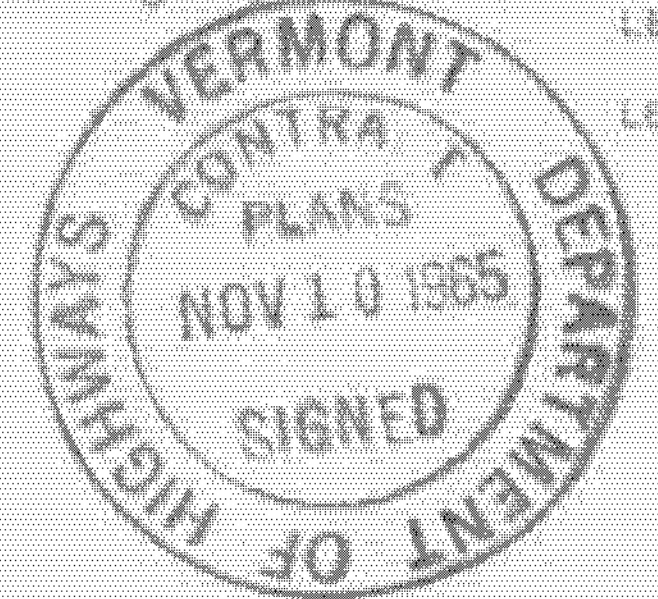

MILTON-HIGHGATE
 IM MEMB(26)
 SHEET 24 OF 70
 BRIDGE 82
 FOR REFERENCE ONLY