




Note:  
Do not construct above this joint until structural steel is in place and final grade is determined. (Typical both sides)

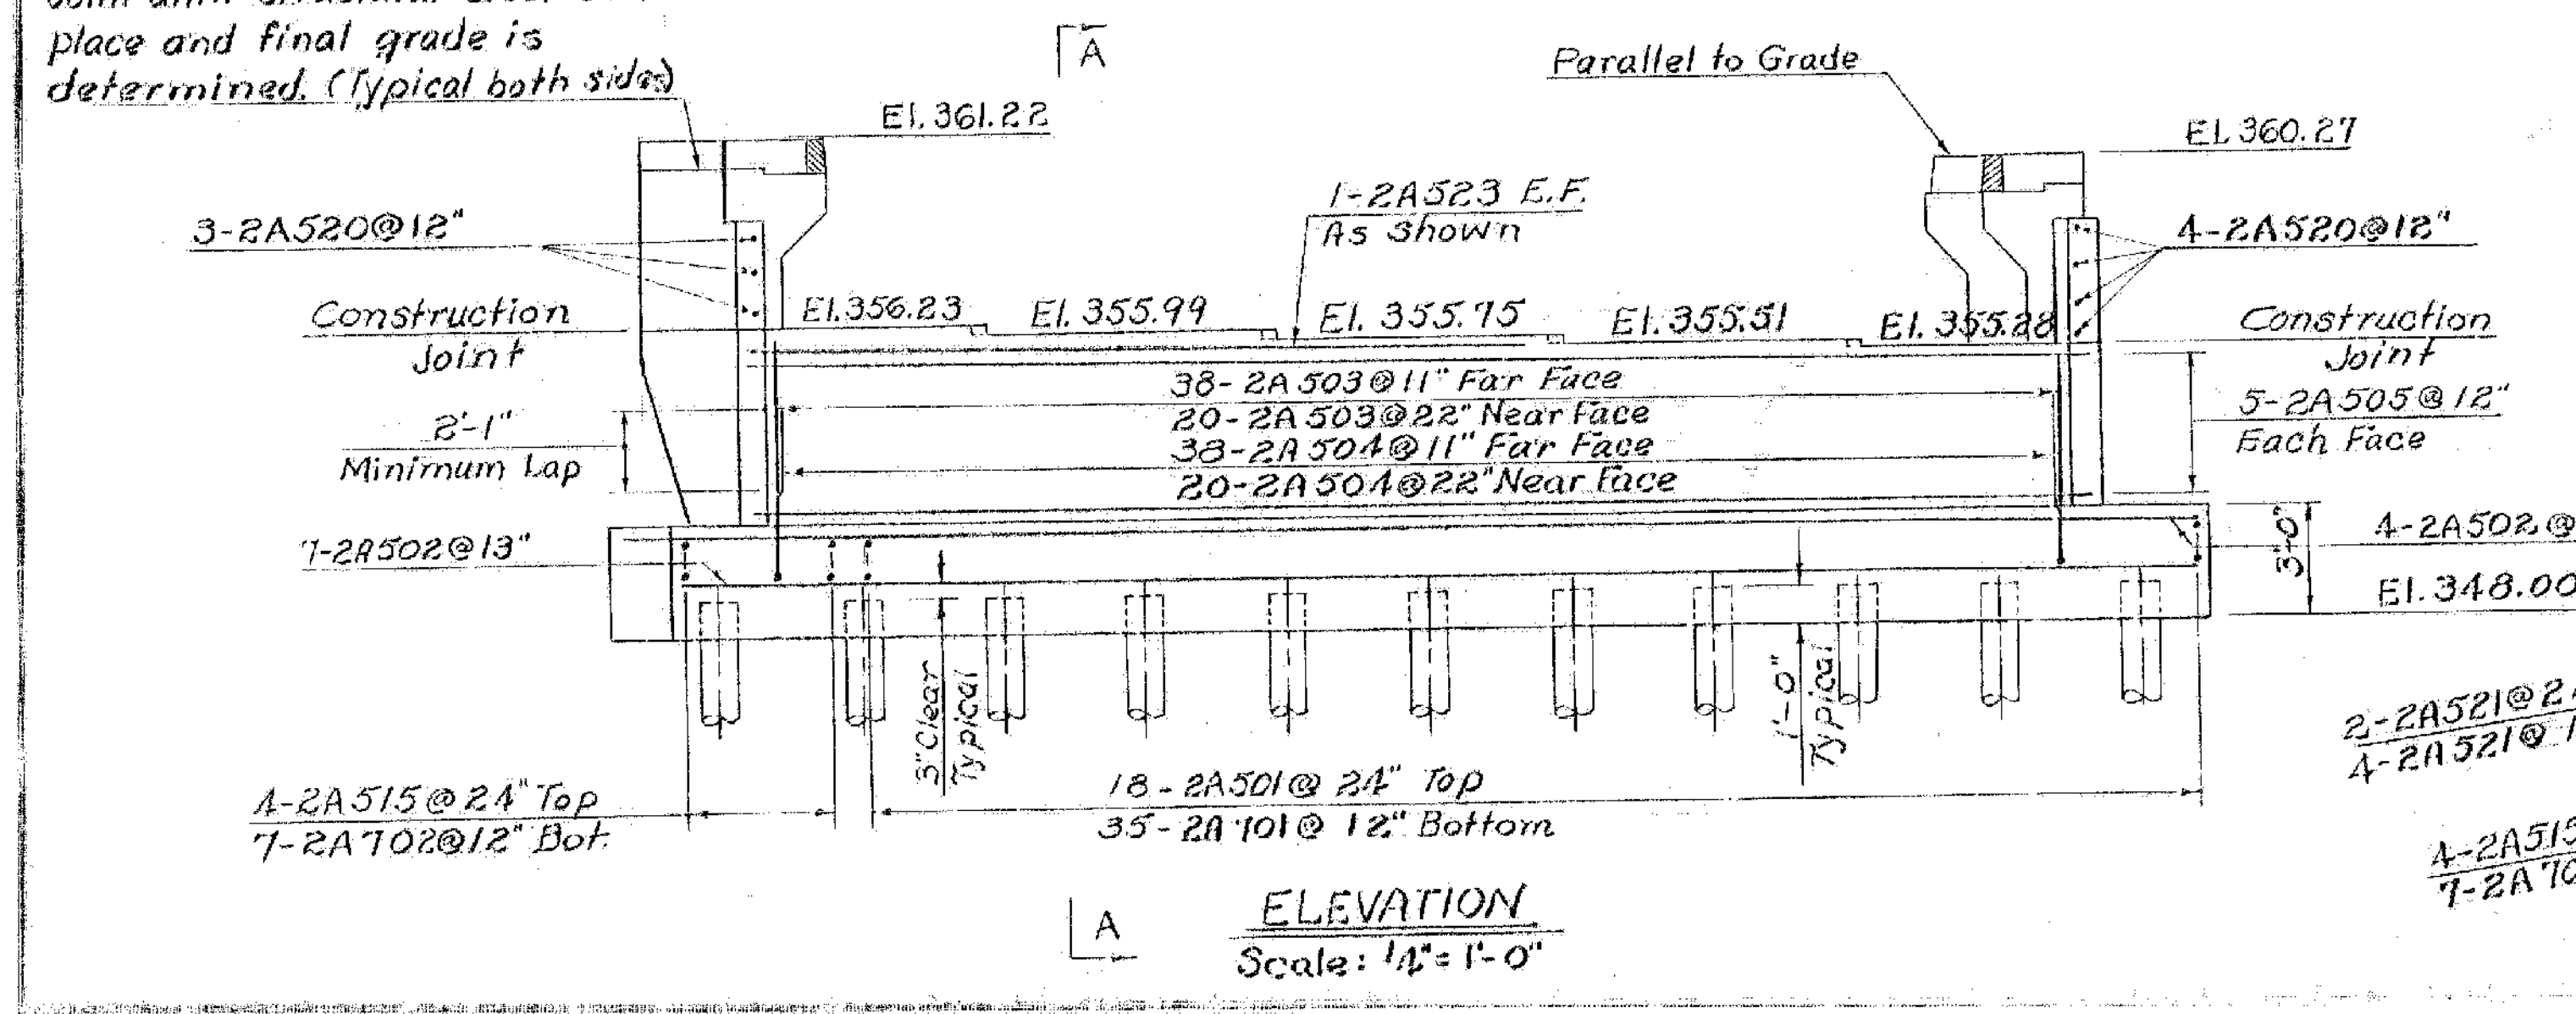

Item 372-C, Type "A" - For details see sheet BR-304

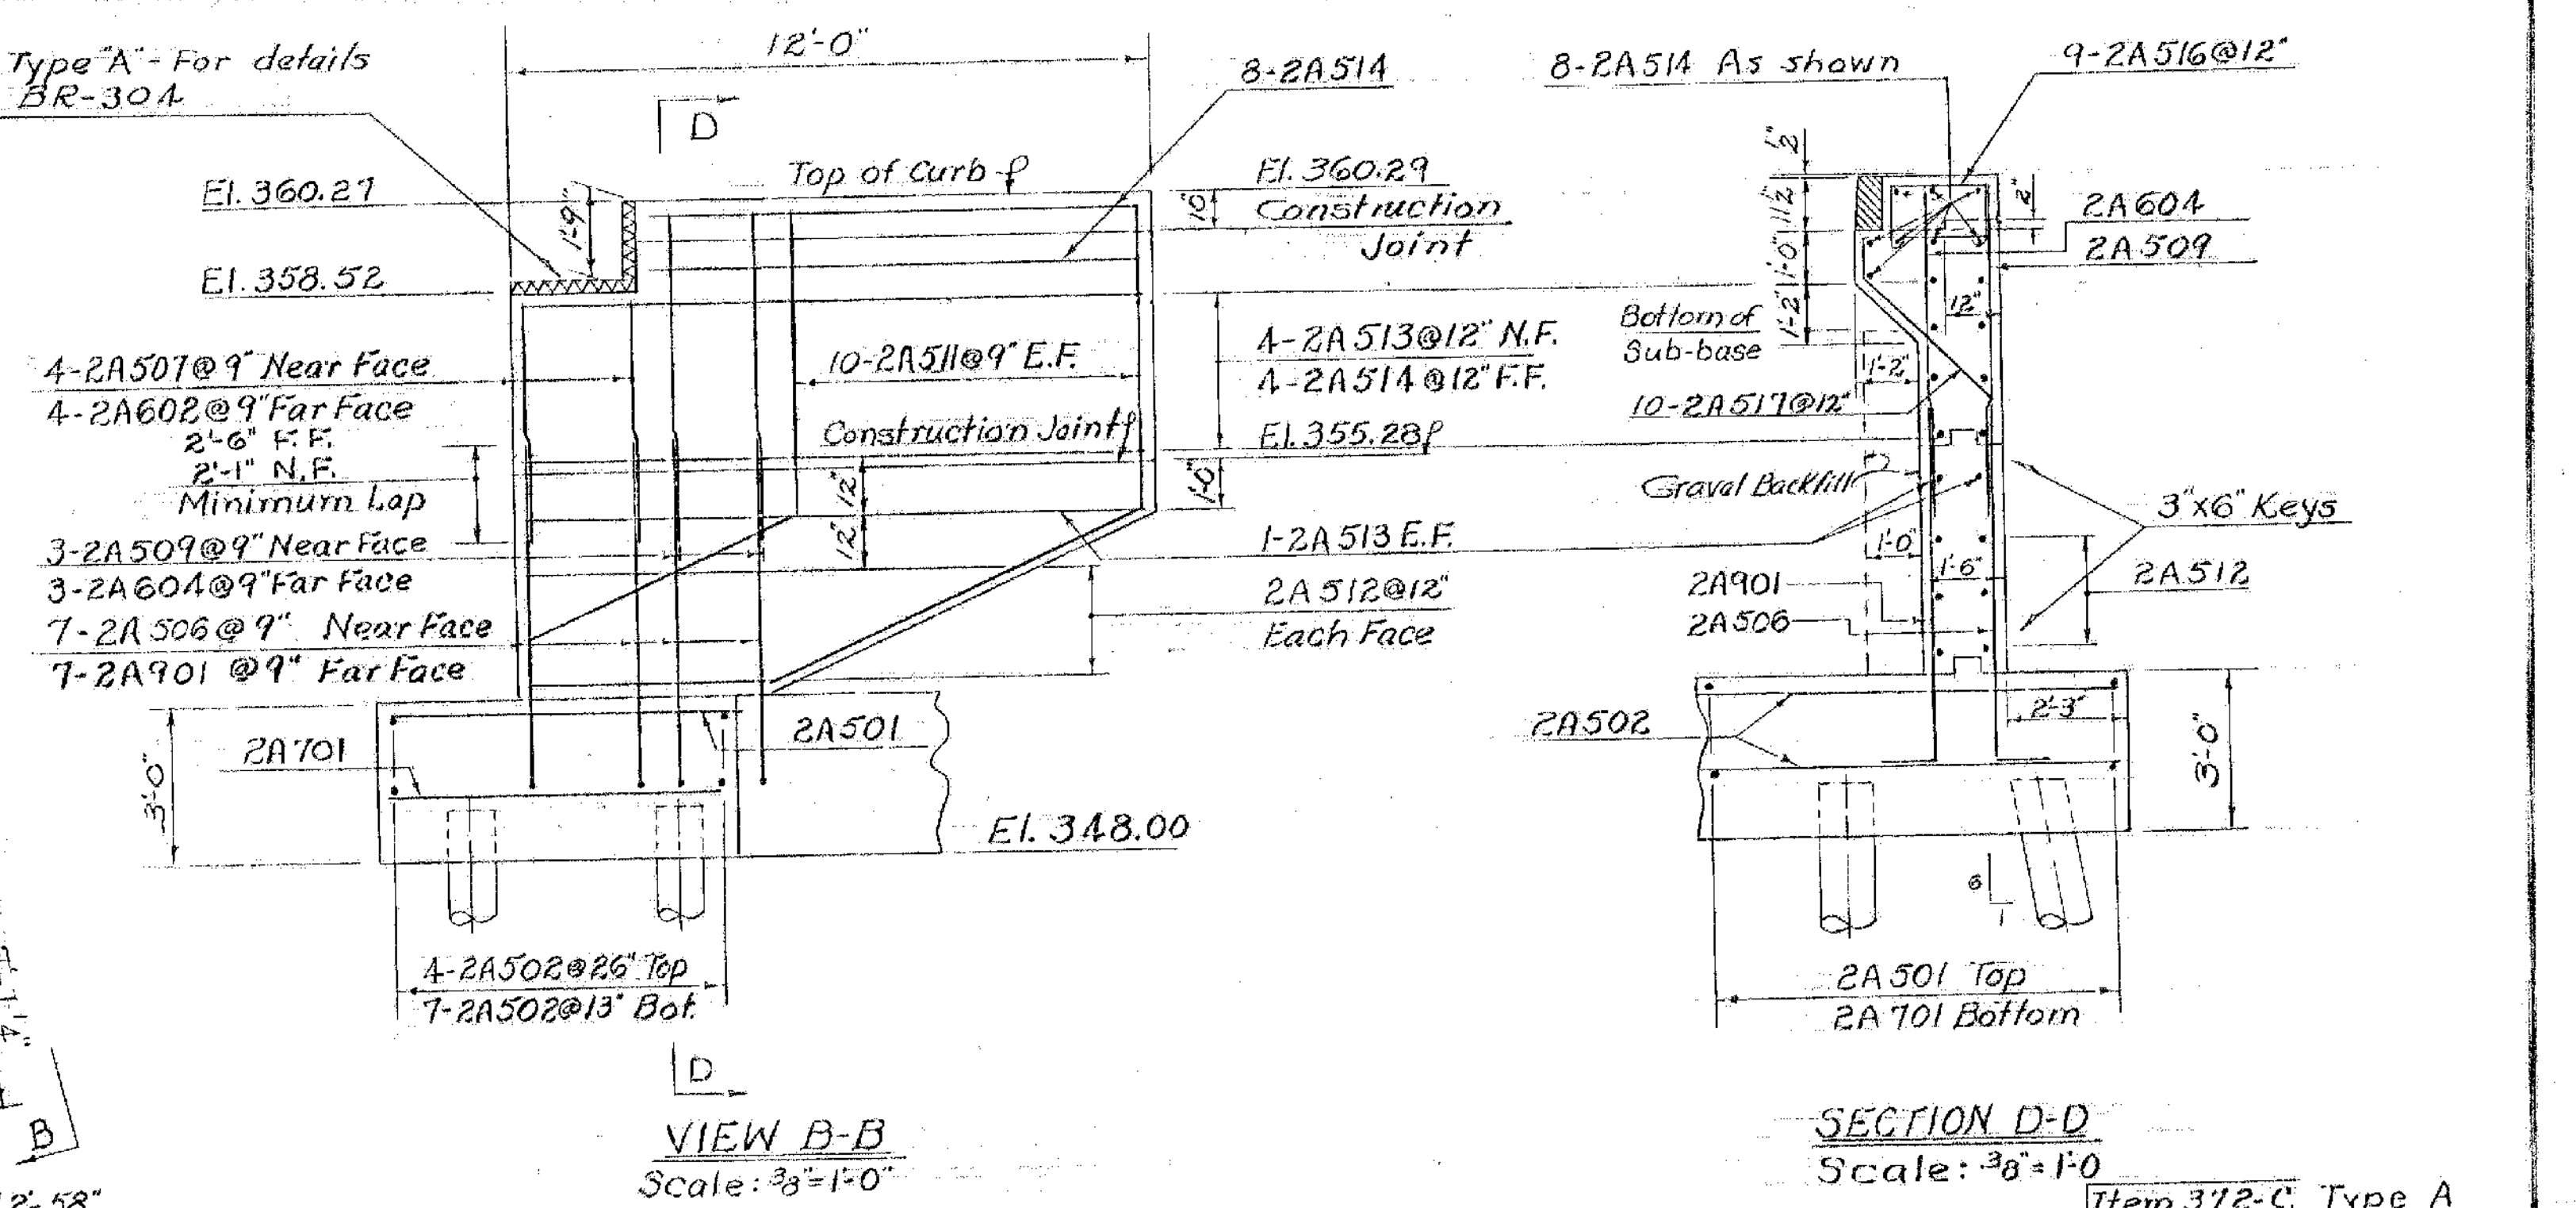

Item 372-C, Type A For details see sheet BR-304

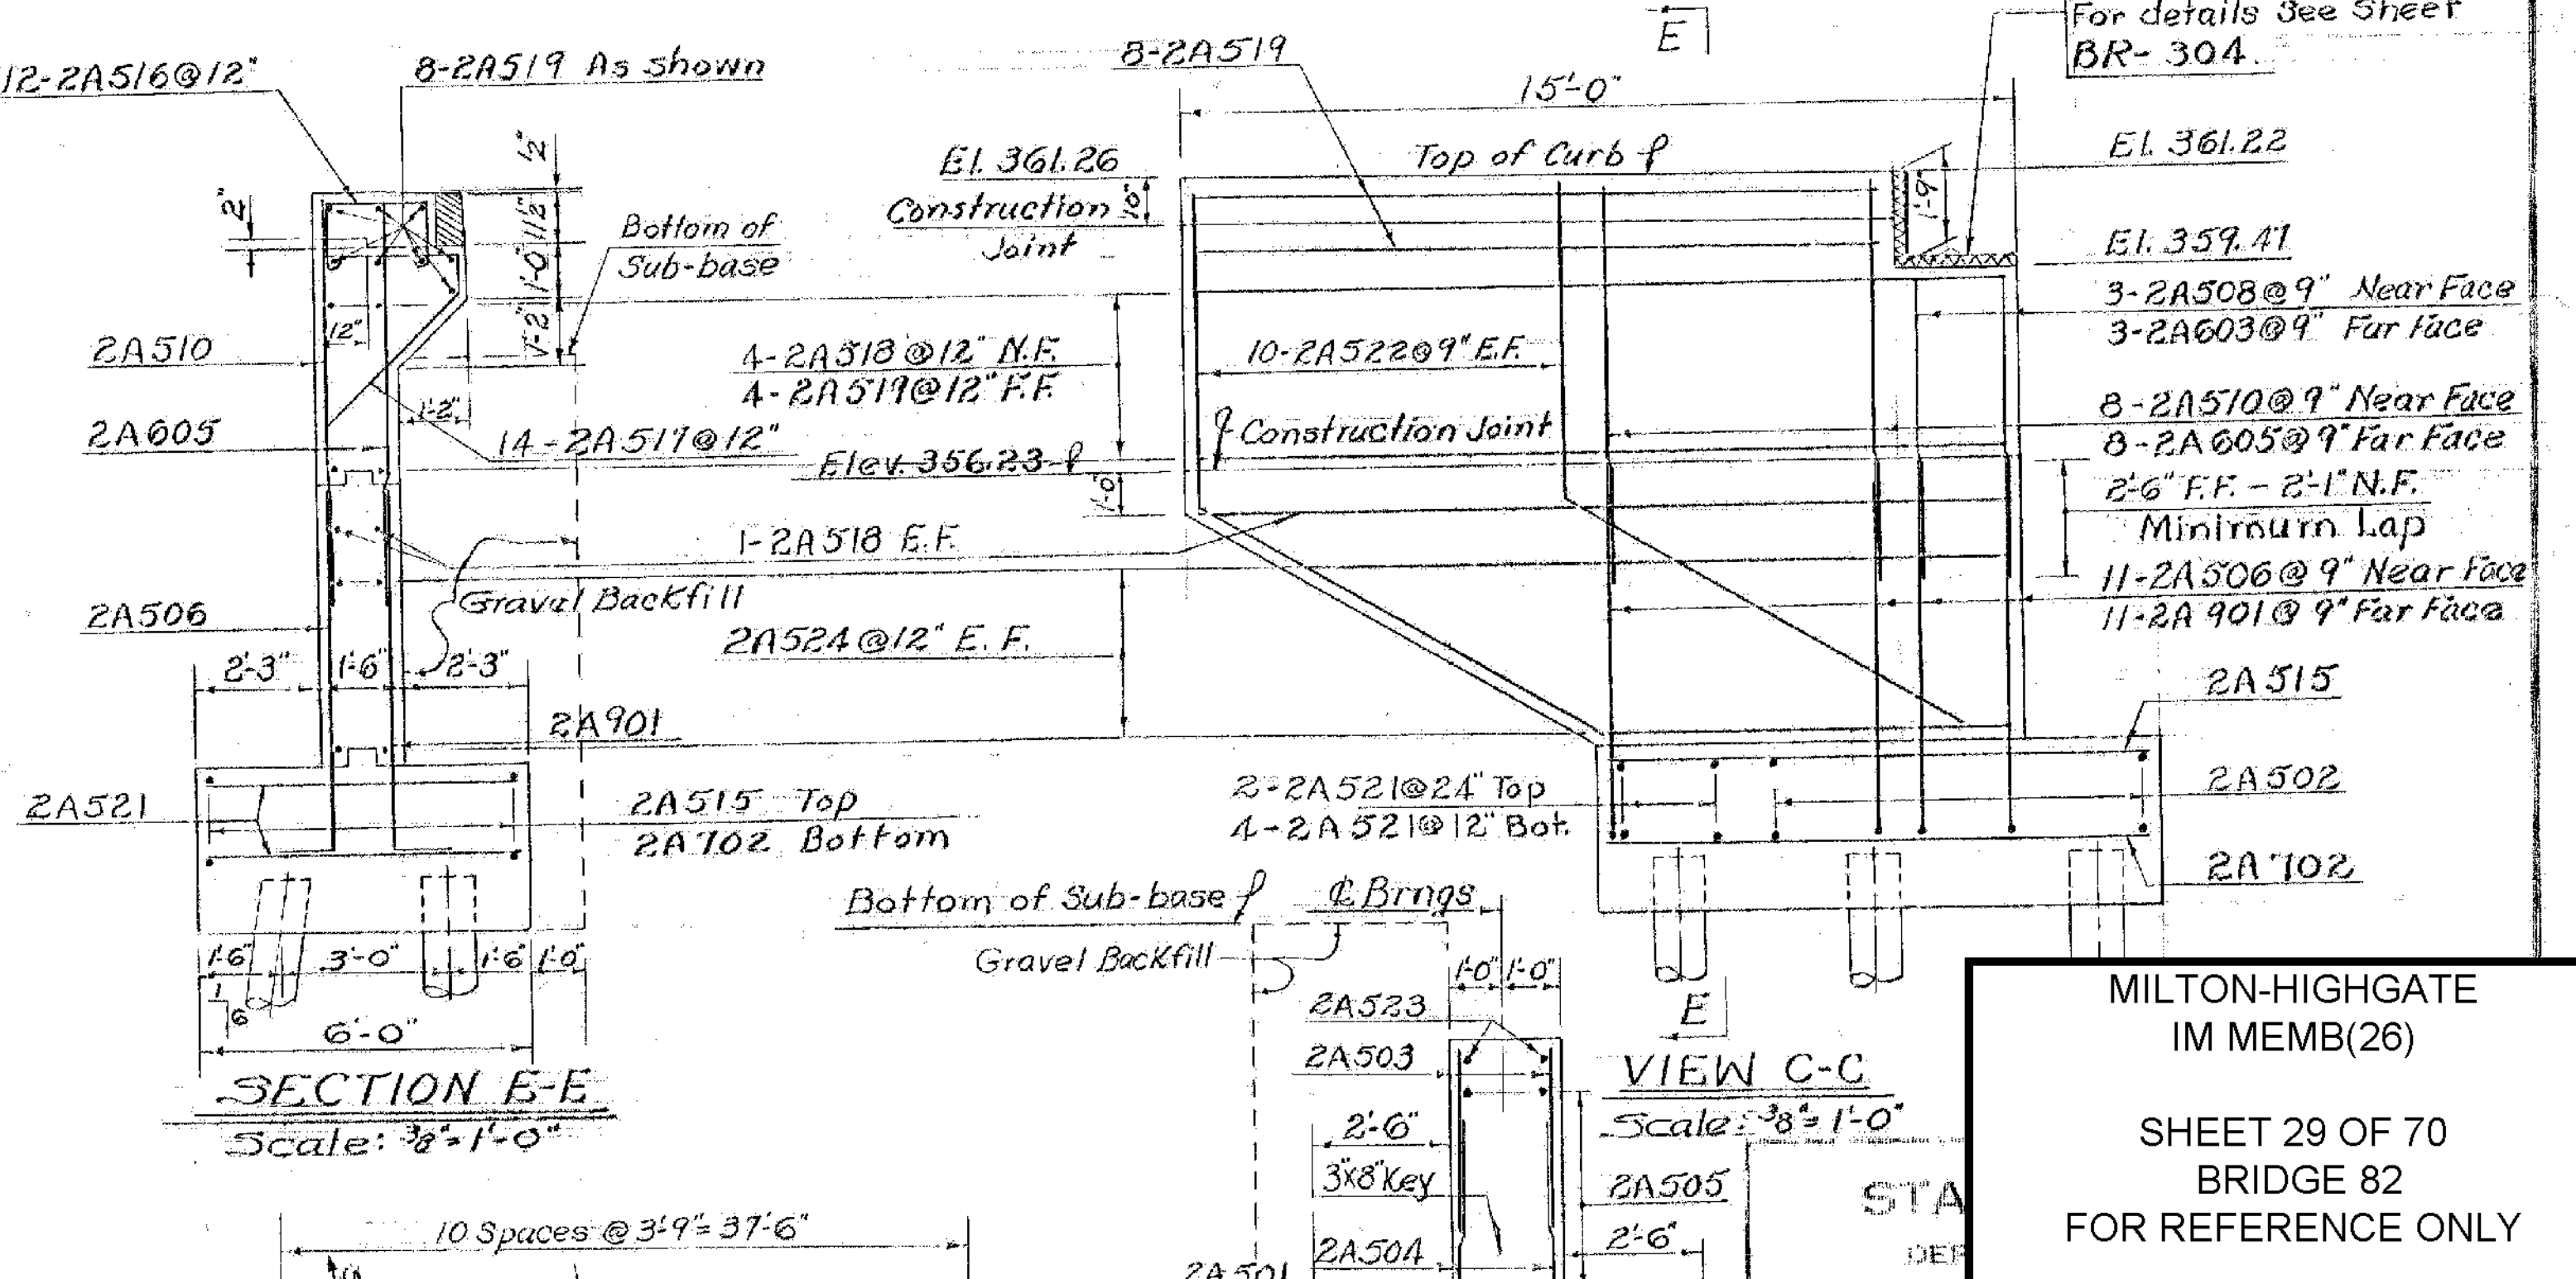

MILTON-HIGHGATE  
IM MEMB(26)  
SHEET 29 OF 70  
BRIDGE 82  
FOR REFERENCE ONLY

TOWN OF Colchester-Milton  
ROUTE No. 189 LOC STA  
Details of Abutment No. 2  
SA3 over 189  
SCALE: AS NOTED  
SURVEYED BY: L. VALLEE 5/63  
DRAWN BY: J.J.C. CHECKED BY: J.L.W.  
PROJECT No. 189-3(34)  
SHEET 136 OF 419