

1.	Title Page
2.	Alignment Sheet
3.	Typical
4,5.	Quantity Sheets
6,7.	Plan Detail and Drainage Sheets
8-10.	Earthwork Sheets
11.	R.O.W. Detail Sheet
12-17.	Plan and Profile Sheets
18.	Blank
19.	A-61 Drilling and Blasting of Solid Rock Subgrade, Item 115
20.	B-1 Benching Tables
21.	B-5 Typical Slope Grading
22.	B-6 Muck Excavation, Item 117
23.	B-10 Embankment on a Slope
24.	B-11 Methods of Slope Stabilization
25.	B-2 Cement Rubble Masonry
26.	B-3 Underdrain Flooding Basin
27.	B-8 Drop Inlets
28.	B-10 Top for a Drop Inlet w/Bituminous Concrete Curb
29.	B-11 Grates
30.	B-12 Top for Asphalt Curb, Galv. Met. Pipe Drop Inlets w/Grates, Item 532
31.	B-16 Precast Concrete Drop Inlet, Item 531
32.	B-17 Asphalt Curb, Galv. Met. Pipe Vertical Rise
33.	C-1 Barricades, Signs and Lights
34.	C-31 Federal Aid Construction Identification Signs
35.	F-1 Property Line Fence
36.	J-1 Boundary Markers
37.	Blank
38-39.	Bridge Sheets
40.	SCB-20-65 Typical Section, Plan view and Quantities
41.	SCB-21-65 Details A, B & C
42.	SCB-22-65 Details A, B, C, D & E
43.	SCB-23-65 Details A, B, C & D
44.	SCB-24-65 Details A, B, C & D
45.	SCB-25-65 Details A, B, C & D
46.	SCB-26-65 Details A, B, C & D
47.	SCB-27-65 Details A, B, C & D
48.	SCB-28-65 Details A & B
49.	SCB-29-65 Detail A, Details of W/ Span Bridges
50.	SB-R1-64 Sheet 1
51.	SB-R1-64 Sheet 2
52.	SB-R2-65 Details of Bridge Bailing
53.	S-2a Dead End Anchorage & Bridge Approach
54.	Blank
55-116.	Cross Sections


STATE OF VERMONT
DEPARTMENT OF HIGHWAYS
Proposed Improvement
TOWNS OF GEORGIA-FAIRFAX-
FAIRFIELD-ST. ALBANS
COUNTY OF FRANKLIN
INTERSTATE ROUTE 89
BURLINGTON-ST. ALBANS ROAD

CONTRACT NO. 1
BEGINNING AT A POINT 3.973 MILES SOUTHERLY OF
GEORGIA-FAIRFAX TOWN LINE AND EXTENDING NORTHERLY
0.681 MILES
LENGTH OF ROADWAY 2800.67 FEET = 0.530 MILES (AVE.)
LENGTH OF BRIDGE 799.33 FEET = 0.151 MILE (AVE.)
LENGTH OF CONTRACT 3,600.00 FEET = 0.681 MILES (AVE.)

ADT 1958	2440
ADT 1975	5400
DHV	825
D	54
T	8
V	60 M.P.H.

PROJECT NAME: ROUTE 1, TYPE PAVEMENT: AREA 51	
SUB-PAVE OF SAND	
CRUSHED GRAVEL	
REFINED TACK	
OUTBACK ASPHALT	
GRAVEL OR PAVEMENT	
CONCRETE CLASS "C"	
HOT OIL PAVEMENT	
REINFORCING STEEL	
METAL PIPE CULVERT	
R.C.P.	
CAST IRON GRATE	
DROP HEADS	
SHARD IRON STEMS	
STRUCTURAL STEEL	
CAST IRON COVER FOR P.E.	
STEEL CONNECTIONS	
BRIDGE PAINT	
WATER REPELLANT	

COMMISSIONER	Carroll L. Lavoie	CONTRACT DATED	24 March, 1966
RESIDENT ENGINEER	R. E. Deane	APPROVED	25 March, 1966
INSPECTOR	R. E. Deane	COMPLETED	11 Aug., 1967
SECORD PLANS	R. E. Deane	RECEIVED	18 Aug., 1967

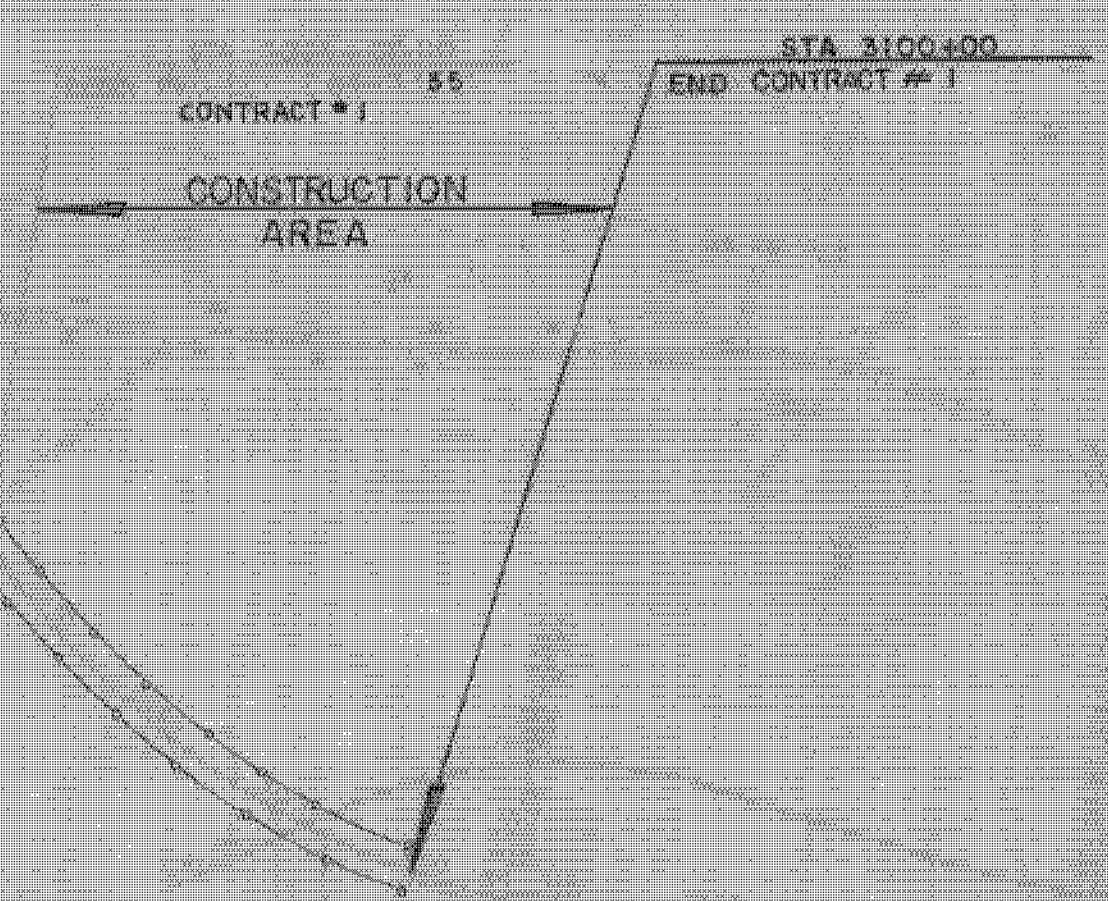

201

ROW LIMITS

LIMITS OF ACCESS

PROJECT: GEORGIA-FAIRFAX-FAIRFIELD-ST. ALBANS
NUMBER: I. 89-2135 C.C.
TYPE: GRADINGS & DRAINAGE - STAGE I
CONTRACTOR: Curran - Lavoie
LOCATION: Littleton, N.H.
YEAR 1967
Beginning at a point 3.973 miles
southerly of the Georgia-Fairfax town line and
extending northerly 0.681 miles

FOR R.O.W. DETAILS, SEE
R.O.W. PLANS FOR THIS PROJECT.

R. E. Deane 7/12/64 *B. M. Bennett* 7/15/67 *E. H. Stebbins* 10 July 1964 *L. M. Deane* 7/16/64 *L. H. Lane* 7/10/64 *A. J. Deane* 7/16/64

MILTON-HIGHGATE
IM MEMB(26)

SHEET 36 OF 70
BRIDGE 865
FOR REFERENCE ONLY

THESE PLANS ARE SUBJECT TO SUCH REVISIONS AS MAY BE
REQUIRED BY THE BUREAU OF PUBLIC ROADS OR THE COMMISSIONER
OF HIGHWAYS.
CONSTRUCTION IS TO BE CARRIED ON IN ACCORDANCE WITH
THESE PLANS AND THE STANDARD SPECIFICATIONS FOR HIGHWAY AND BRIDGE
CONSTRUCTION DATED APRIL, 1964, AS APPROVED BY THE BUREAU OF
PUBLIC ROADS ON OCTOBER 12, 1964, INCLUDING ALL SUBSEQUENT
APPROVED REVISIONS AND SUCH REVISED SPECIFICATIONS AND SPECIAL
PROVISIONS AS ARE INCORPORATED IN THESE PLANS.

Stage Construction
DEPARTMENT OF TRANSPORTATION