

GENERAL NOTES

- ALL WORK AND MATERIALS SHALL CONFORM TO THE STATE OF VERMONT, DEPARTMENT OF HIGHWAYS, STANDARD SPECIFICATIONS FOR HIGHWAY AND BRIDGE CONSTRUCTION DATED APRIL 1964, AND THE A.A.S.H.O. SPECIFICATIONS DATED 1961. DESIGNED FOR HS 20-44 LOADINGS.
- ALL REINFORCING STEEL SHALL BE DETAILED ON THE REINFORCING STEEL SCHEDULE. ALL SPLICES SHALL BE A MINIMUM OF 10 BAR DIAMETERS.

MILTON-HIGHGATE
 IM MEMB(26)
 SHEET 40 OF 70
 BRIDGE 86S
 FOR REFERENCE ONLY

Stage 12 Construction
CONTRACT 1


REINFORCING BENDING DETAILS

DETAIL SHOWN IS FOR AS1 BAR. ALL OTHER BARS ARE TO BE STRAIGHT.

REINFORCING		STEEL		
BAR NO.	NO. PIECES	LENGTH	WEIGHT PER FT.	WEIGHT IN LBS.
AS 1			4.503	
AS 2			4.503	
AS 3			1.013	
AS 4			1.043	
TOTAL WEIGHT				

SUMMARY OF QUANTITIES

ITEM NO.	ITEM	UNIT	TOTAL	FINAL
312	TAR EMULSION FOR BRIDGE FLOORS	GAL.		
301-B	BITUMINOUS CONCRETE PAVEMENT	TONS		
372-A	JOINT SEALER - HOT Poured	L.F.		
372-C	JOINT SEALER - PREFORMED, TYPE A	L.F.		
401-B	CONCRETE CLASS B	CY.		
402	REINFORCING STEEL	L.B.		

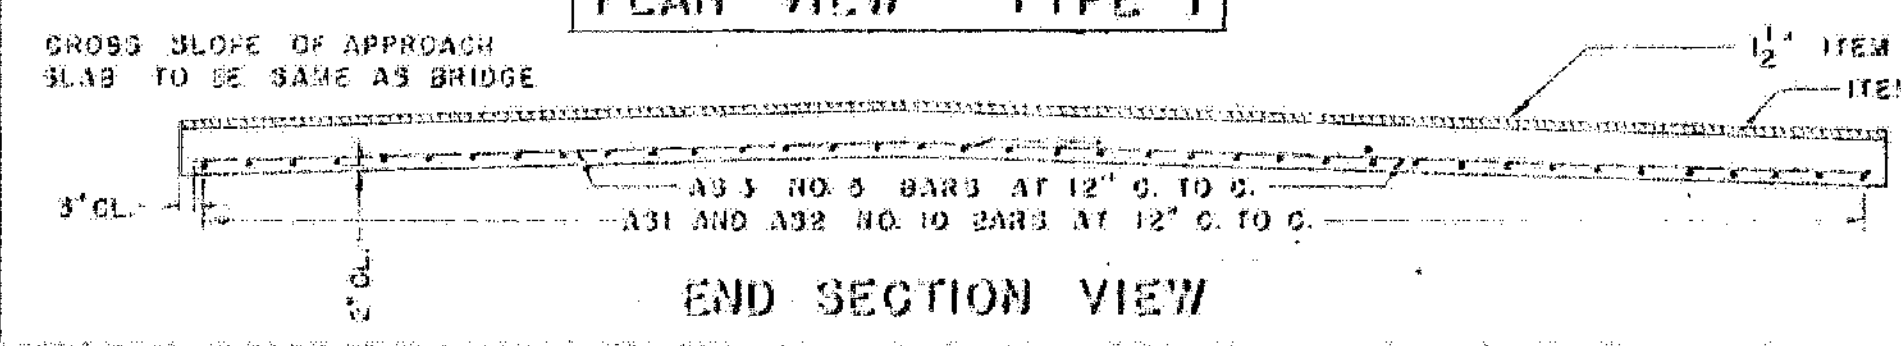

REVISIONS AND CORRECTIONS

1. DIMENSIONS OF JOINT FOR SEALER TYPE A REVISED. 12/8/65 W.B.C.
 2. DIMENSIONS OF JOINT SEALER TYPE B REVISED AND MODIFICATION OF ITEM 372-C ADDED. 2/23/65 W.B.C.

DRAWN BY: W.B.T. Jan. 1965
 CHECKED BY: W.M.S. Feb. 1965
 RECOMMENDED FOR APPROVAL: [Signature] 2/11/65
 RECOMMENDED FOR APPROVAL: [Signature] 2/11/65
 APPROVED BY: [Signature] 2/11/65

DETAILS OF APPROACH SLAB #2 S.B.
 FOR 30.00 FOOT BRIDGE
 TO BE USED FOR BRIDGE AT STATION 3092±
 LOCATION I 89 over C.V.R.R.

STATE OF VERMONT
 DEPARTMENT OF HIGHWAYS
 STANDARD STRUCTURE
SB-AS-65

TOWN OF Georgia-Fairfax
 ROUTE NO. I 89
 LOG STA. _____
 DESIGNED BY J.J.C. CHECKED BY A.J.C.
 PROJECT NO. I 89-3(35) Cont. 1
 BR OF SHEET 40 OF 70
 BR-129