


CURB & RAILING PLAN
Scale: 1" = 10'-0"

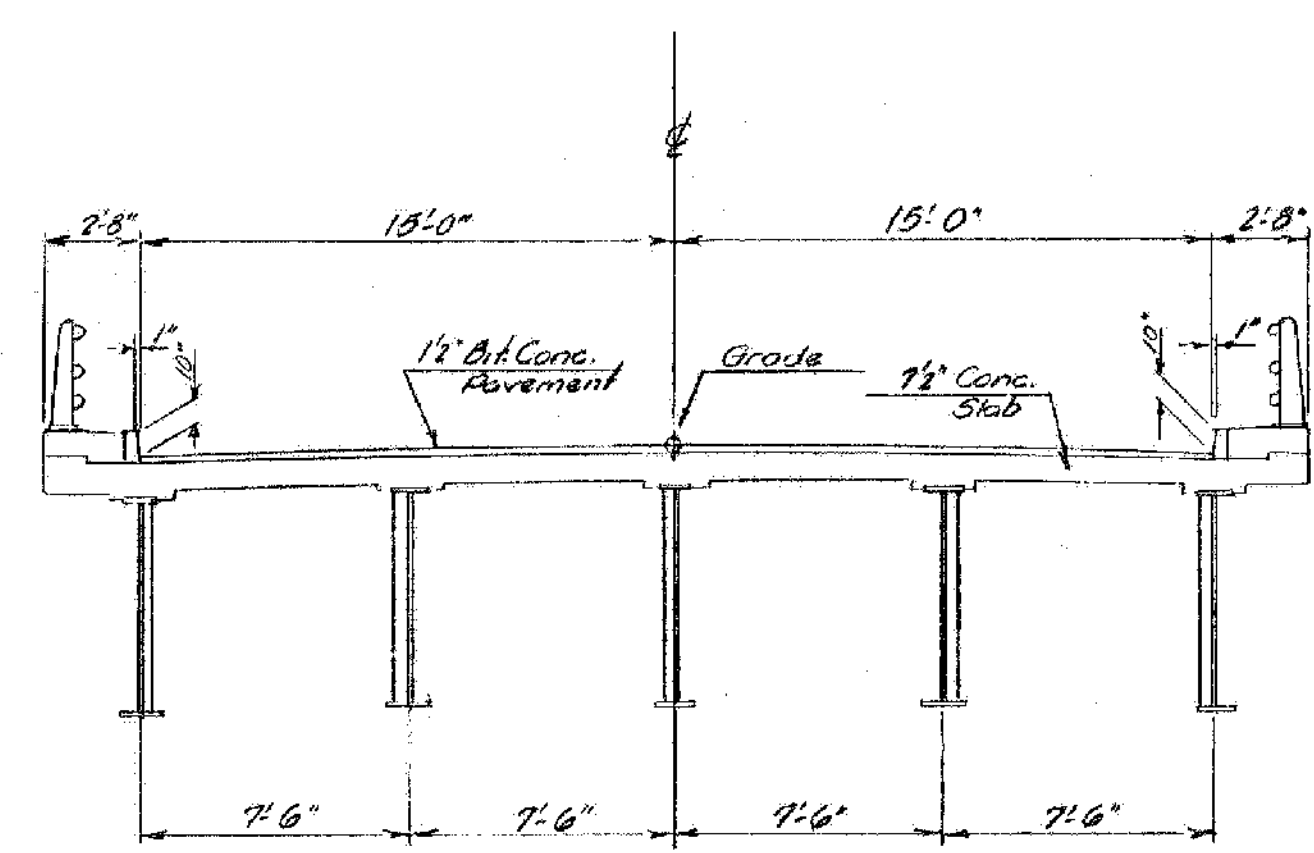

TYPICAL SECTION
Scale: 1" = 3'-0"

For Bridge Railing details, see SB-21-64 sheets 1 & 2, & SB-21-65
For Superstructure details see sheet Bc 103

MILTON-HIGHGATE
IM MEMB(26)

SHEET 51 OF 70
BRIDGE 89
FOR REFERENCE ONLY

B12 110 OF 113

ITEM NO.	ITEM	UNIT	NET	TOTAL	FINAL
	CHAN. EXCAV. OF EARTH	C.Y.			
	CHAN. EXCAV. OF ROCK	C.Y.			
	UNCLAS. CHAN. EXCAV.	C.Y.			
	STRUCT. EXCAV.	C.Y.			
	CONC. CLASS AA (MOD.)	C.Y.			
	CONC. CLASS B (MOD.)	C.Y.			
	REIN. STEEL	LB.			
	ASPHALTIC-ASB. COATING	S.Y.			
	TREATED TIMBER PILING	L.F.			
	SPLICES FOR STEEL PILING	EA.			
	STEEL PILING	L.F.			
	UNTREATED TIMBER PILING	L.F.			

STATE OF VERMONT
DEPARTMENT OF HIGHWAYS

TOWN OF ST. ALBANS - SWANTON
ROUTE NO. 14 Rte 36 LOG STA. _____
VERMONT Rte 36 OVER I-89
CURB & RAILING PLAN
SCALE As NOTED
SURVEYED BY _____
DRAWN BY W CHECKED BY AGC
PROJECT NO. I-89-3(36) 91
SHEET 71 OF 278