

for breakdown of final quantities see sheets 153, 156 & 157

ITEM NO.	ITEM	UNIT	SUPER	ASB*	NET	TOTAL	FINAL
101-A	Common Excavation	C.Y.	6000*			6000*	AB
107	Structure Excavation	C.Y.		88	80	168	187
204	Crushed Rock (Mod - Under Struct)	C.Y.		65		65	59
222	Gravel Backfill	C.Y.		22		22	0
318	Tar Emulsion for Bridge Floors	GAL	158*			158*	
361-B	Bituminous Conc. Pk (Mod)	TON	38*			38*	
373	Rubber Joint Material	L.F.	22			22	21
401-AA	Concrete, Class AA (Mod)	C.Y.	134			134	132
401-B	Concrete, Class B (Mod)	C.Y.	48	56		104	105
402	Reinforcing Steel	LBS	20,000	2,020	9,600	41,620	42,111
403	Spiral Reinf. @ Sta 783+2.4 (400*)	L.S.	1/1			1/1	1
404-A	Structural Steel	LBS	112,000			112,000	111,305
407	Asphaltic-Asbestos Coating	S.Y.	4	16		20	19
501	Furn. Equipment for Drilling Piles	L.S.		1/2		1/2	1/2
503	Splices for Steel Piling	E.A.	18	20		38	32
504	Steel Piling (12RP53)	L.F.	1104	1732		2836	2710
556-C	Granite Bridge Curb (Mod)	L.F.	240V			240V	240
572	Bridge Railings (Galv. Metal)	L.F.	238			238	235
	Cut-offs @ 80% Unit Price	L.F.					180


\* Indicates quantity to be included in Roadway quantities.

GENERAL NOTES

- Elevation datum is sea level based on nearest U.S. Government vertical control.
- Steel piles shall be driven to point bearing on ledge rock.
- Standard Structures Sheets are modified so as to eliminate the Approach Slab Bracket.
- The cost of removing present end posts, curbs, and bridge deck to the limits indicated on this sheet, or as directed by the Engineer, shall be included in the unit price bid for Concrete, Class AA, Item 401-AA (Mod).
- Rearrange present bridge rails at Pier #2 to avoid applying more than two rails in any rail span.
- Standard Structures Sheet SCB-D3-62 Detail 15 is modified to require Expansion Anchors for 1/2" bolts which are used to attach brackets for drains to existing Pier #2 Sta 39+58.0.
- Provide 1/2"x9"x10" slabs under new bearings @ Pier #2.

FOR SUPERSTRUCTURE DETAILS SEE STD. SHEET SCB-30-62  
FOR CURB AND RAIL DETAILS SEE STD. SHEET SB-56-62 SHEETS 1 & 2A

PVI 40+40  
E. 156.00  
420 V.C.

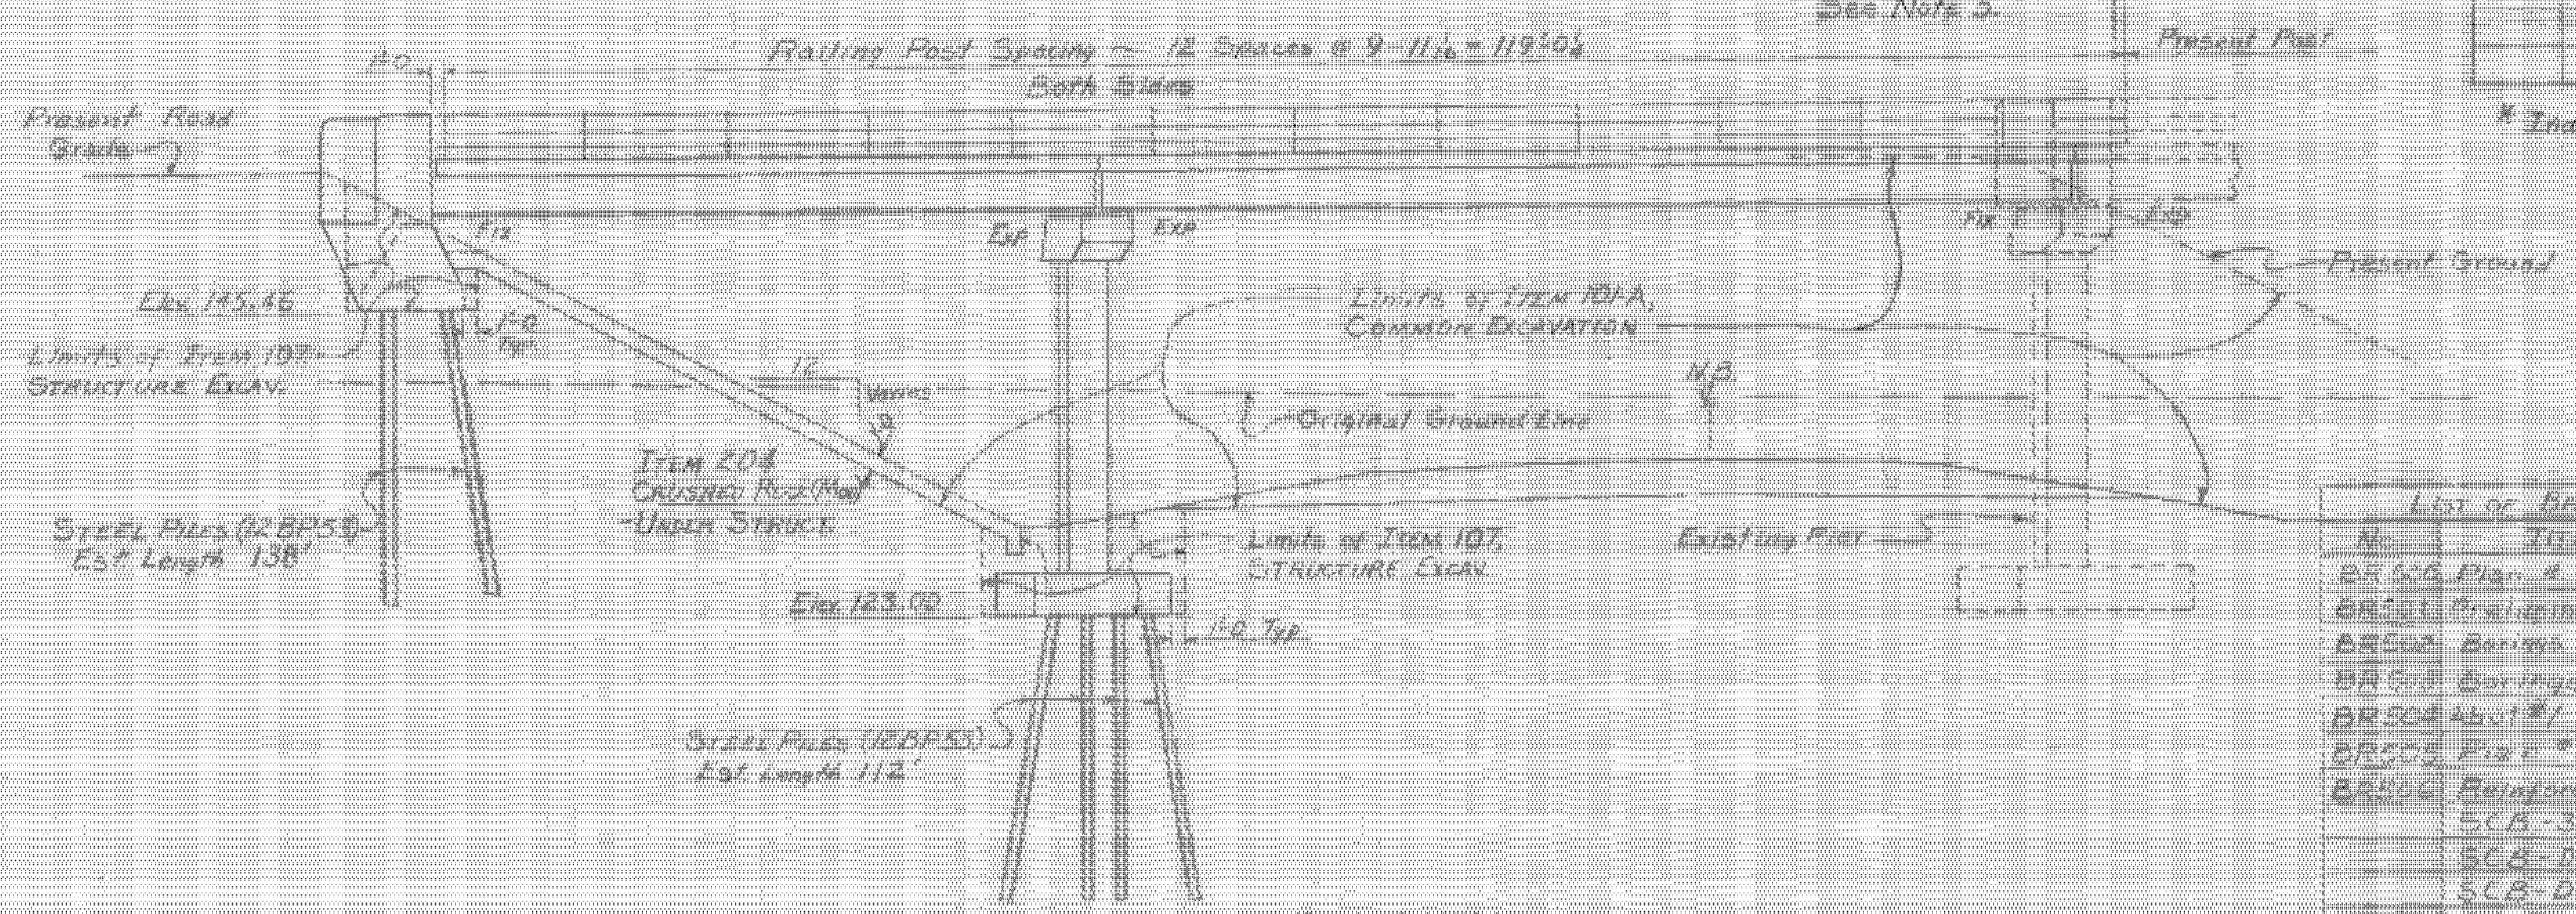

LIST OF BRIDGE SHEETS

No.	TITLE
BR500 Plan & Elevation	
BR501 Preliminary Information	
BR502 Bearings	
BR503 Bearings	
BR504 Abut #1 Details	
BR505 Pier #1 Details	
BR506 Reinforcing Steel Sched.	

SUPERSTRUCTURE QUANTITIES

ITEM NO.	UNIT	NET	TOTAL	FINAL
101-A	Common Excavation	C.Y.	6,000	AB
401-AA	CONC. CLASS AA (MOD)	C.Y.	134	132
402	REIN. STEEL	LBS	See Reinforcing Schedule	
318	Tar Emulsion for Bridge Floors	GAL	158	
361-B	Bituminous Concrete Pk (Mod)	TON	38	
373	Rubber Joint Material	L.F.	22	21
403	Spiral Reinforcement (400*)	L.S.	1/1	1
404-A	Structural Steel	LBS	112,000	111,305
556-C	Granite Bridge Curb (Mod)	L.F.	240V	240
572	Bridge Railings (Galv. Metal)	L.F.	238	235

MILTON-HIGHGATE  
IM MEMB(26)

SHEET 61 OF 70  
BRIDGE 99  
FOR REFERENCE ONLY

STATE OF VERMONT  
DEPARTMENT OF HIGHWAYS

TOWN OF SWANTON - HIGHGATE

ROUTE NO. 189 STA. 783+76.0 AB

HIGHGATE S.A. #4 OVER INTERSTATE

PLAN AND ELEVATION NORTH BOUND CONSTRUCTION

SCALE 1"=10'-0" E.A.S. NOTED

SURVEYED BY

DRAWN BY RLM CHECKED BY NGT

PROJECT NO. 789-3(32)

SHEET 151 OF 246 BR 500