


STATE OF VERMONT
AGENCY OF TRANSPORTATION



PROPOSED IMPROVEMENT
BRIDGE PROJECT
TOWN OF WINDSOR
COUNTY OF WINDSOR
INTERSTATE 91, BRIDGES NO. 33N & 33S

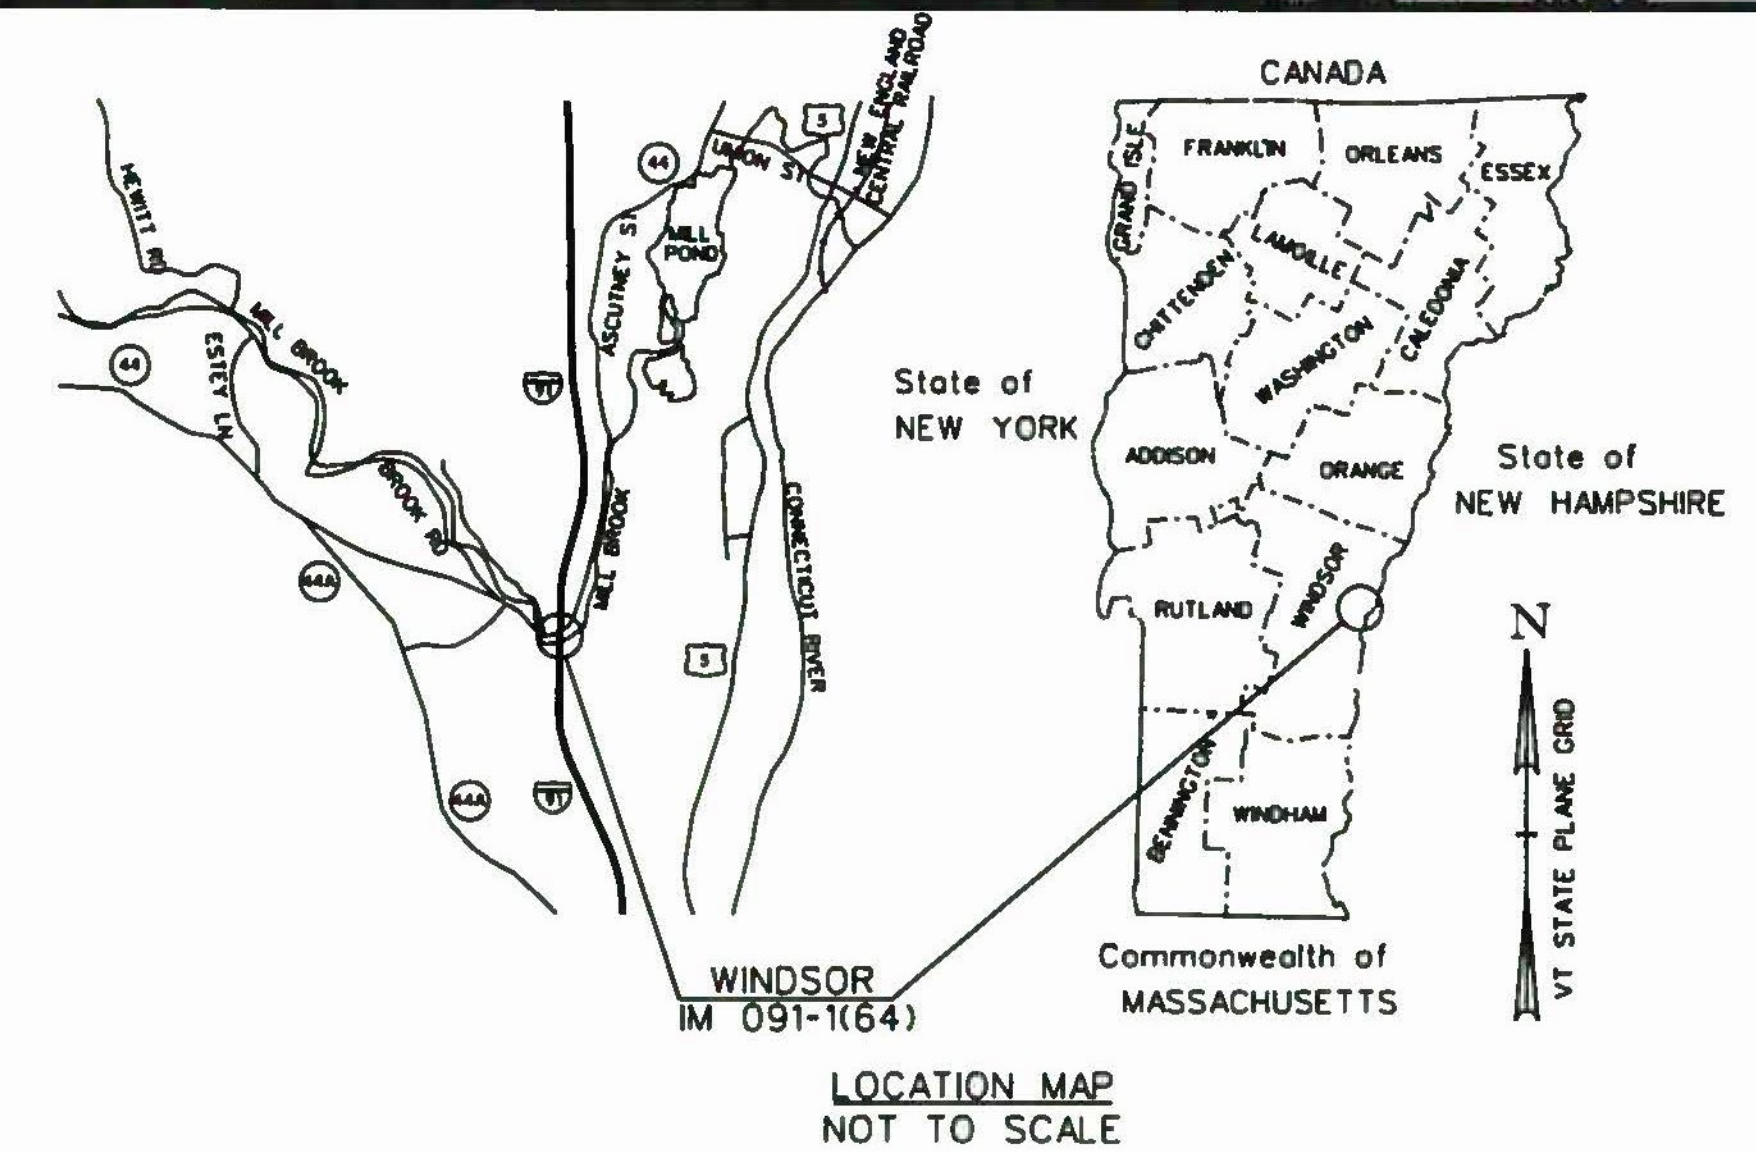

PROJECT LOCATION: LOCATED IN THE COUNTY OF WINDSOR, TOWN OF WINDSOR, VT
INTERSTATE 91 (RURAL PRINCIPAL ARTERIAL); BRIDGE NOS. 33N & 33S OVER MILL BROOK AND VT ROUTE 44.


PROJECT DESCRIPTION: INSTALL TRAFFIC CONTROL, REPLACE BRIDGE NOS. 33N & 33S AND
WIDEN APPROACHES, REMOVE TRAFFIC CONTROL.

LENGTH OF STRUCTURES: 33N • 645.00 FEET
33S • 645.00 FEET

LENGTH OF ROADWAY: NORTHBOUND • 4775.00 FEET
SOUTHBOUND • 5650.00 FEET

STOP ROADWAY/BEGIN BRIDGE
STA. 1920+58.50 SB
STA. 2920+82.50 NB

BRIDGE 33S
END BRIDGE/RESUME ROADWAY
STA. 1927+03.50 SB

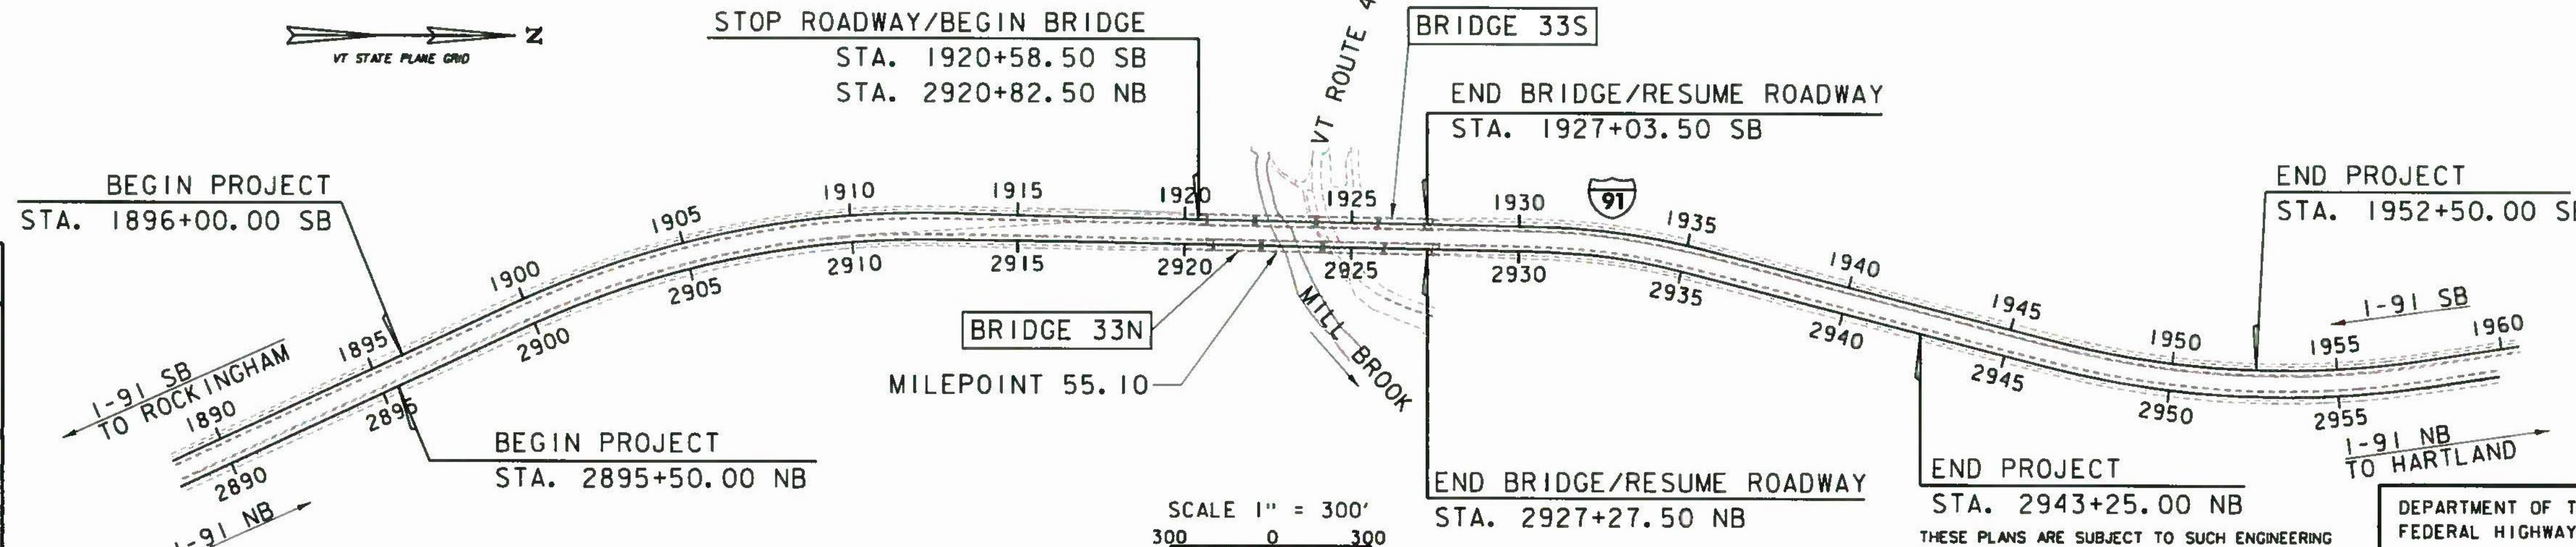

CONVENTIONAL SYMBOLS

COUNTY LINE	— — — — —
TOWN LINE	— — — — —
LIMITS OF ACCESS	— o — o — o — o —
POINT OF ACCESS	X
FENCE LINE	X — X — X — X —
STONE WALL	— o — o — o — o —
TRAVELED WAY	— — — — —
GUARD RAIL	— o — o — o — o —
RAILROAD	— — — — —
SURVEY LINE	— — — — —
CULVERT	— — — — —
POWER POLE	⊕
TELEPHONE POLE	⊕
TREES	⊕
CONTROL OF ACCESS	— // — // — // —
PROPERTY LINE	— — — — —
R.O.W. TAKING LINE	— SR — SR — SR —
SLOPE RIGHTS	— o — o — o — o —
TOP OF CUT	— o — o — o — o —
TOE OF SLOPE	— o — o — o — o —

SURVEYED BY : VERMONT SURVEY & ENGINEERING, INC
SURVEYED DATE : FEBRUARY 1, 2013

DATUM
VERTICAL NAVD88
HORIZONTAL NAD 83 (07)

AS-BUILT PLANS (BRIDGES 33N & 33S)
JULY 2015

THESE PLANS ARE SUBJECT TO SUCH ENGINEERING CHANGES AS MAY BE REQUIRED BY THE FEDERAL HIGHWAY ADMINISTRATION OR THE DIRECTOR OF PROGRAM DEVELOPMENT.
CONSTRUCTION IS TO BE CARRIED ON IN ACCORDANCE WITH THESE PLANS AND THE STANDARD SPECIFICATIONS FOR CONSTRUCTION DATED 2006, AS APPROVED BY THE FEDERAL HIGHWAY ADMINISTRATION ON JUNE 15, 2006 FOR USE ON THIS PROJECT, INCLUDING ALL SUBSEQUENT REVISIONS AND SUCH REVISED SPECIFICATIONS AND SPECIAL PROVISIONS AS ARE INCORPORATED IN THESE PLANS.

LANE / JACOBS

DEPARTMENT OF TRANSPORTATION
FEDERAL HIGHWAY ADMINISTRATOR

APPROVED _____ DATE _____

DIRECTOR OF PROGRAM DEVELOPMENT

APPROVED _____ DATE _____

PROJECT MANAGER : TODD SUMNER, P. E.

PROJECT NAME : WINDSOR
PROJECT NUMBER : IM 091-1 (64)

SHEET 1 OF 156 SHEETS

STATE OF VERMONT
MICHAEL R. DESROCHERS
NO. 94425
CIVIL
LICENSED PROFESSIONAL ENGINEER
7-31-15
MICHAEL R. DESROCHERS, P. E.

STATE OF VERMONT
JOHN J. WILSON
NO. 9081
CIVIL
LICENSED PROFESSIONAL ENGINEER
7-31-15
JOHN J. WILSON, P. E.

JACOBS