


ITEMS USED ON THESE SHEET	
ITEM NO.	DESCRIPTION
203.31	SAND BORROW
210.10	COLD PLANING, BITUMINOUS
301.35	DENSE GRADED CRUSHED STONE
404.65	EMULSIFIED ASPHALT
490.30	SUPERPAVE BITUMINOUS CONCRETE PAVEMENT
613.11	STONE FILL, TYPE II
613.12	STONE FILL, TYPE III
616.305	BITUMINOUS CONCRETE CURB, TYPE A
649.31	GEOTEXTILE UNDER STONE FILL
651.15	SEED
651.18	FERTILIZER
651.25	HAY MULCH
651.35	TOPSOIL

**AS-BUILT NOTES:**

1. THERE IS AN EXISTING 1/2" TO 3/4" LAYER OF "SHIM PAVE" WITHIN THE PROPOSED LIMITS OF COLD PLANE AND PAVE. PAVE THICKNESS REMAINS AT 1 3/4"; COLD PLANE ADJUSTED TO 2 1/4" SO FINISHED PAVE IS CLOSER TO FLUSH WITH EXISTING SHOULDER.

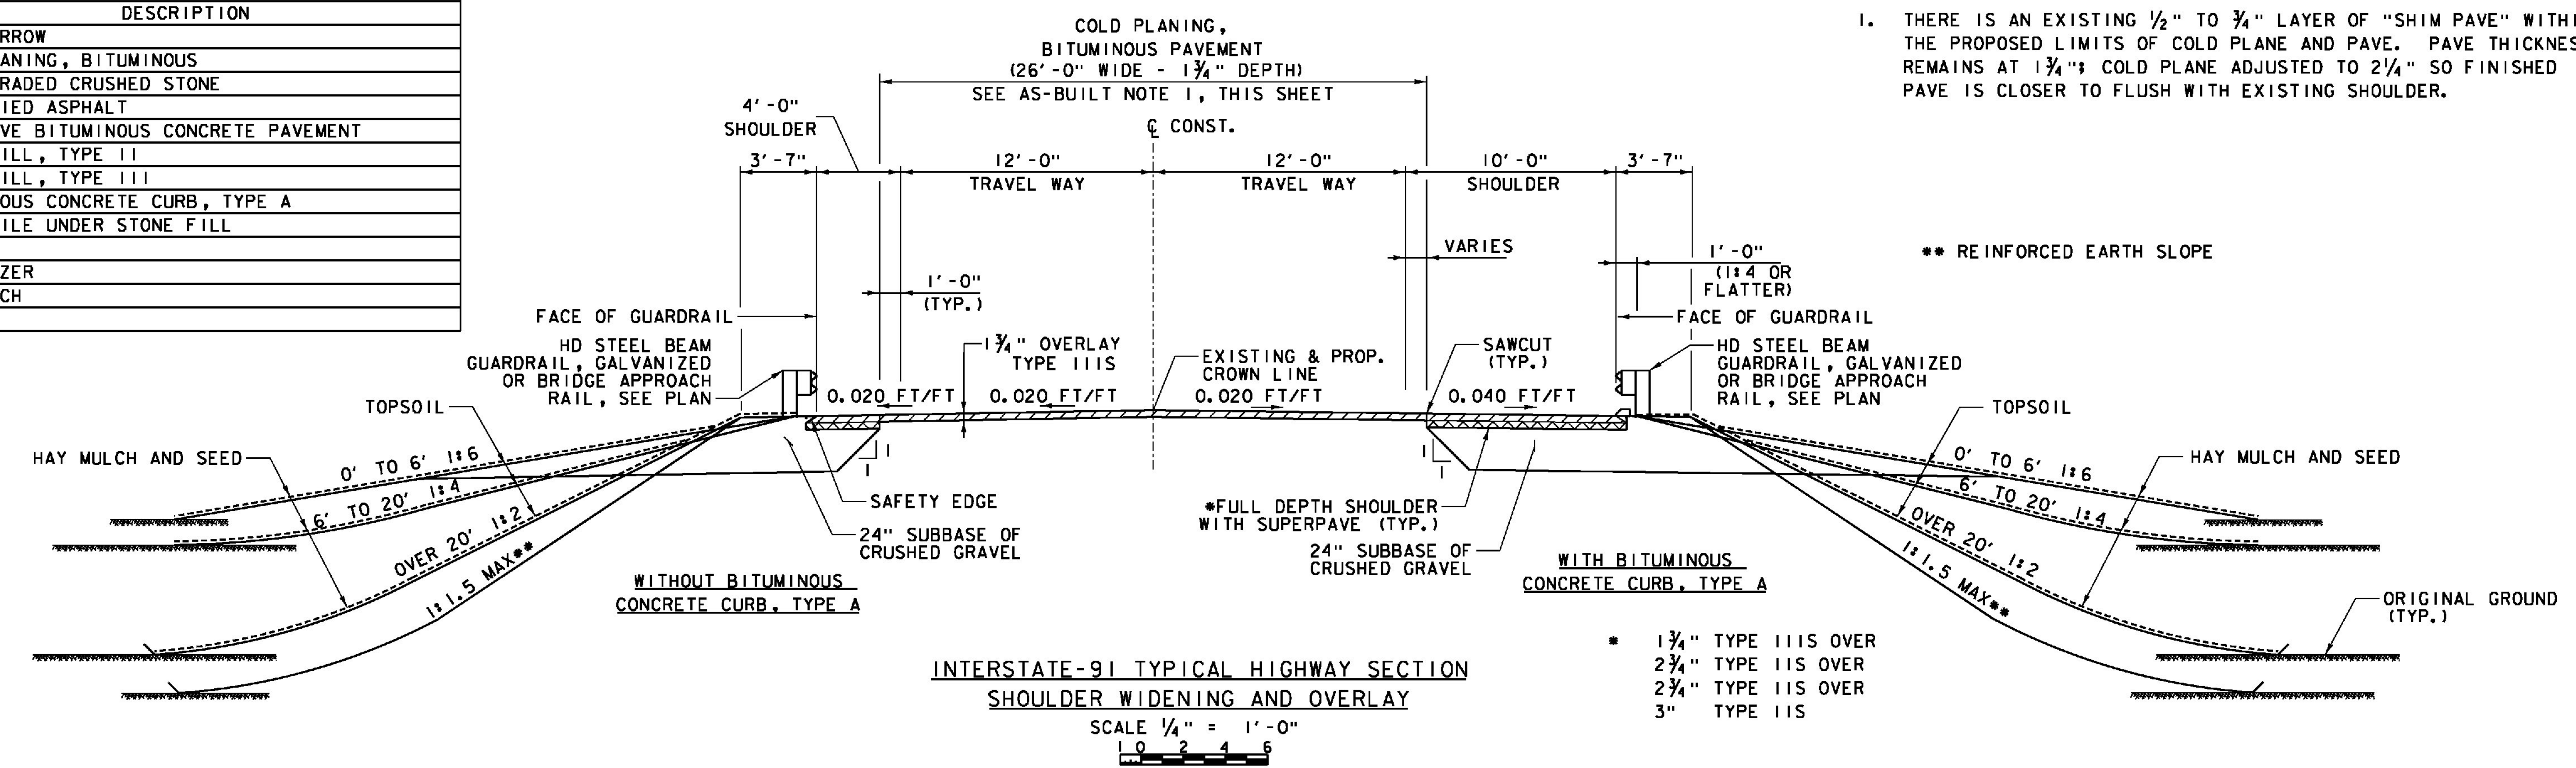


**INTERSTATE-91 TYPICAL HIGHWAY SECTION  
SHOULDER WIDENING AND OVERLAY**

SCALE 1/4" = 1'-0"  
1 0 2 4 6

- \* 1 3/4" TYPE IIIIS OVER
- 2 3/4" TYPE IIS OVER
- 2 3/4" TYPE IIS OVER
- 3" TYPE IIS

**NOTES:**

1. RUMBLE STRIPS TO BE CONSTRUCTED IN SHOULDER AREAS.
2. TYPICALS SHOWN IN DIRECTION OF TRAFFIC.
3. SEE EPSC DRAWINGS FOR SEED MIX.

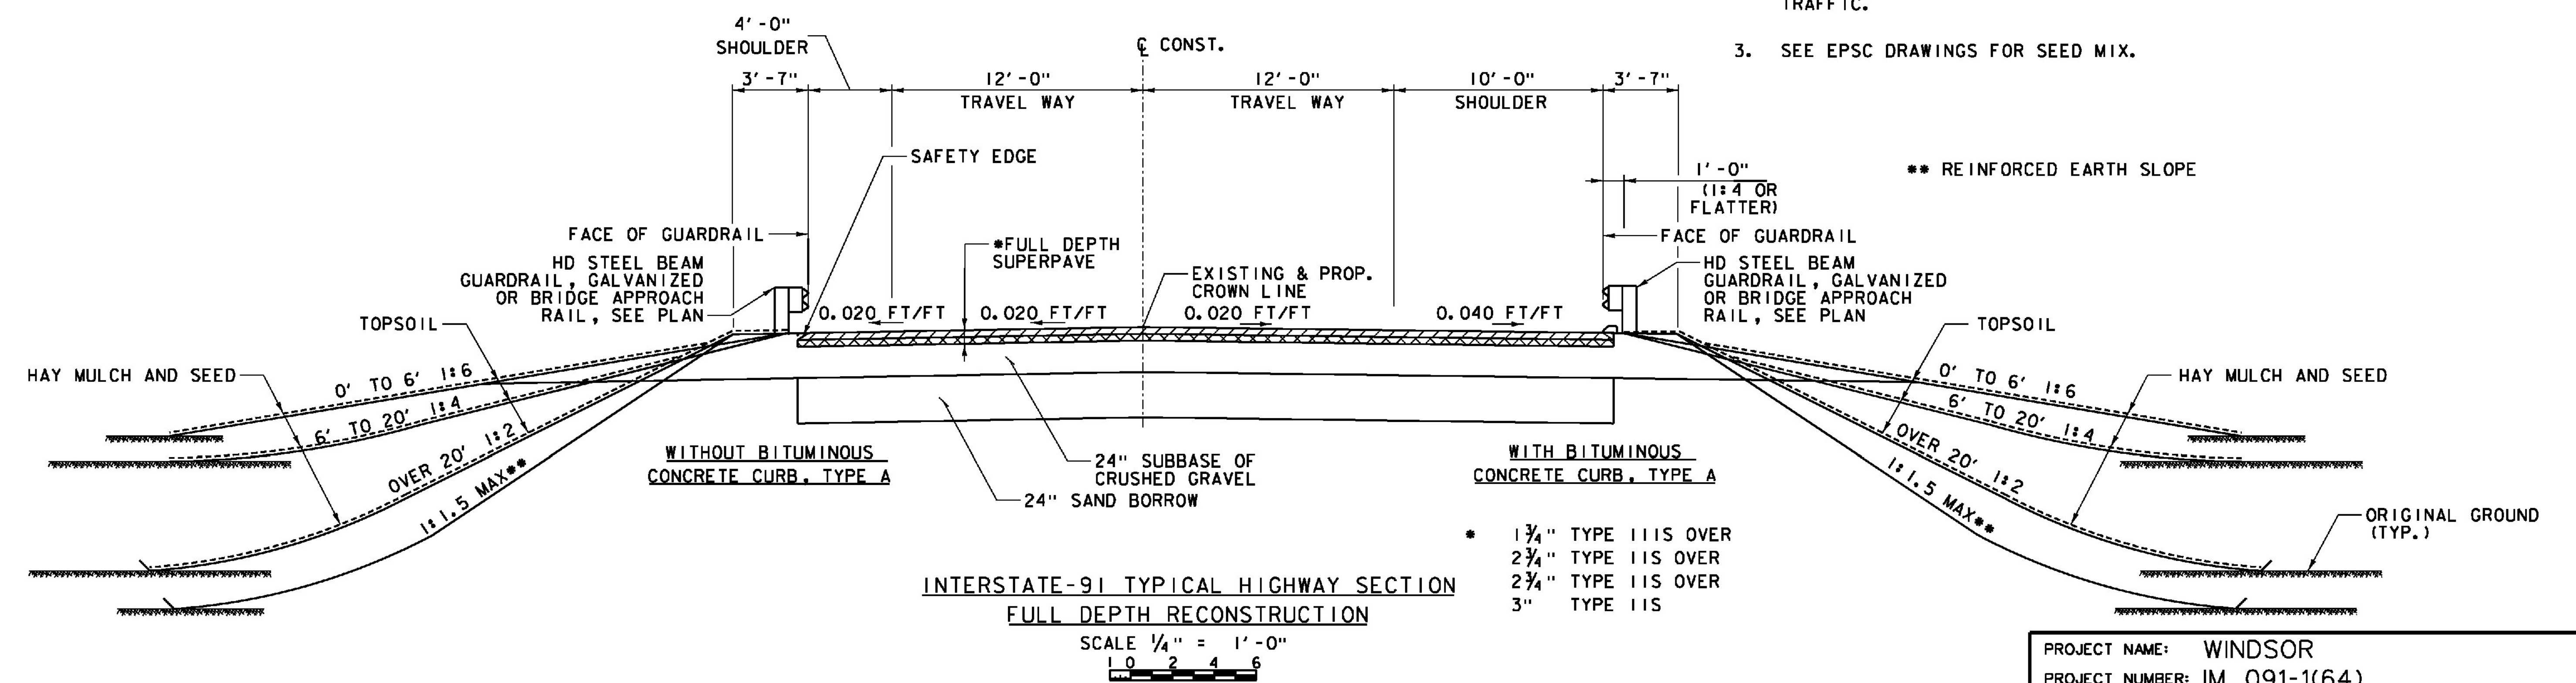

**INTERSTATE-91 TYPICAL HIGHWAY SECTION  
FULL DEPTH RECONSTRUCTION**

SCALE 1/4" = 1'-0"  
1 0 2 4 6

- \* 1 3/4" TYPE IIIIS OVER
- 2 3/4" TYPE IIS OVER
- 2 3/4" TYPE IIS OVER
- 3" TYPE IIS

PROJECT NAME:	WINDSOR
PROJECT NUMBER:	IM 091-1(64)
FILE NAME:	z10o188RTYP1.dgn
PROJECT LEADER:	J. WILSON
DESIGNED BY:	H. FULLER
TYPICAL ROADWAY SECTIONS - SHEET 1	
PLOT DATE:	7/30/2015
DRAWN BY:	S. GUNN
CHECKED BY:	T. MORIN
SHEET 5	OF 156