

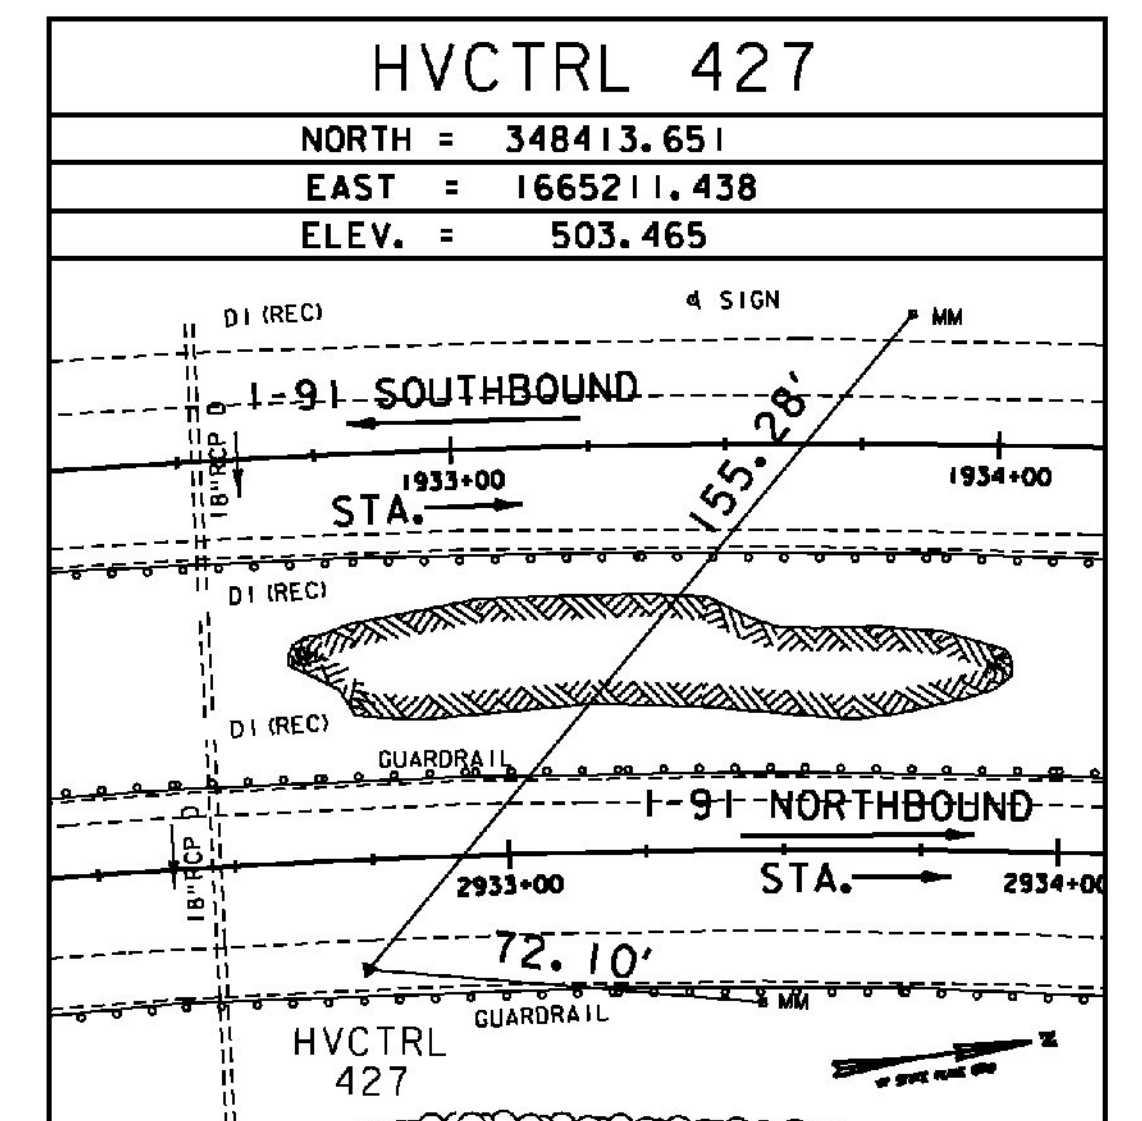
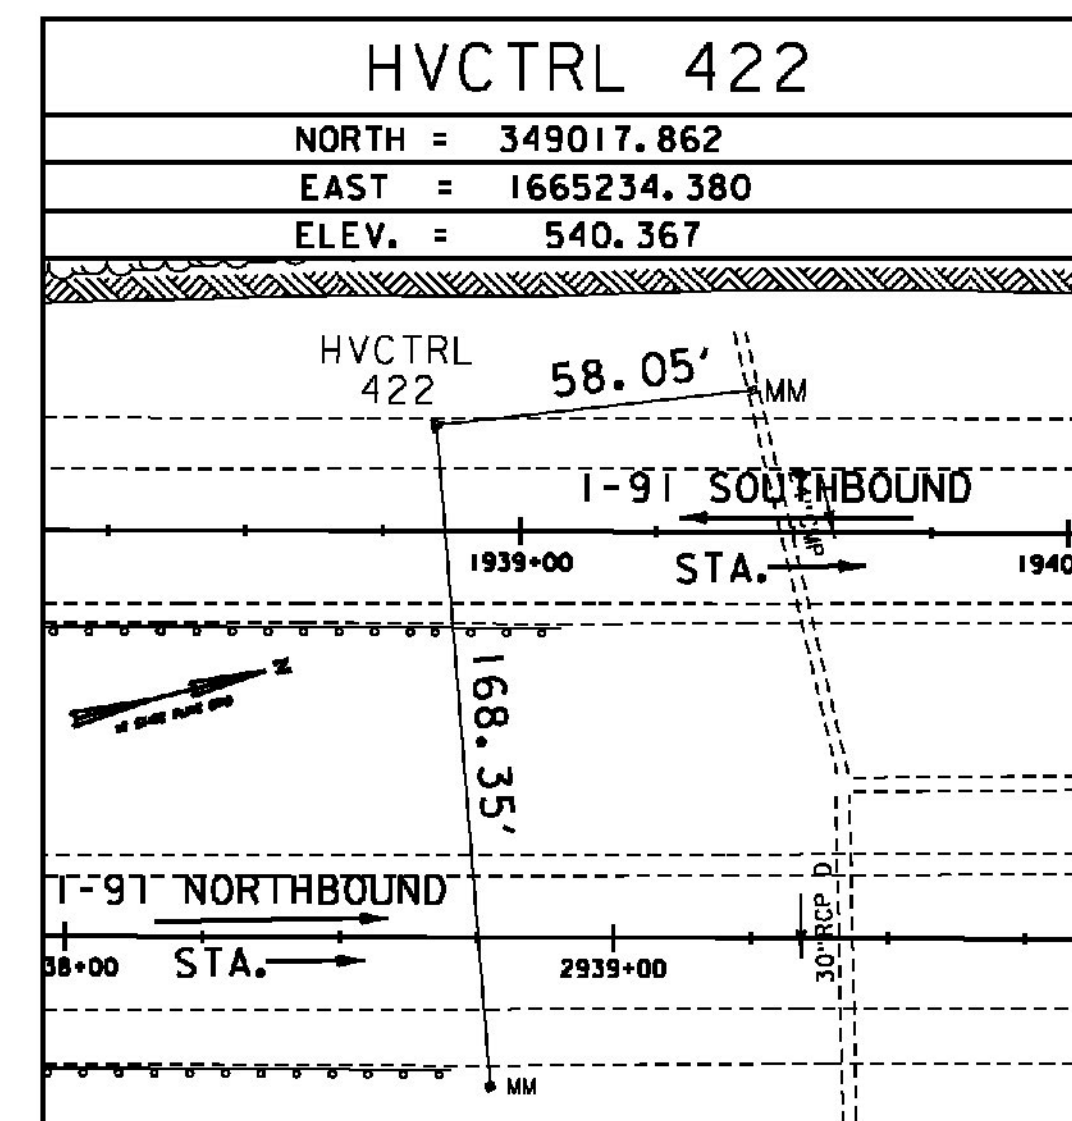
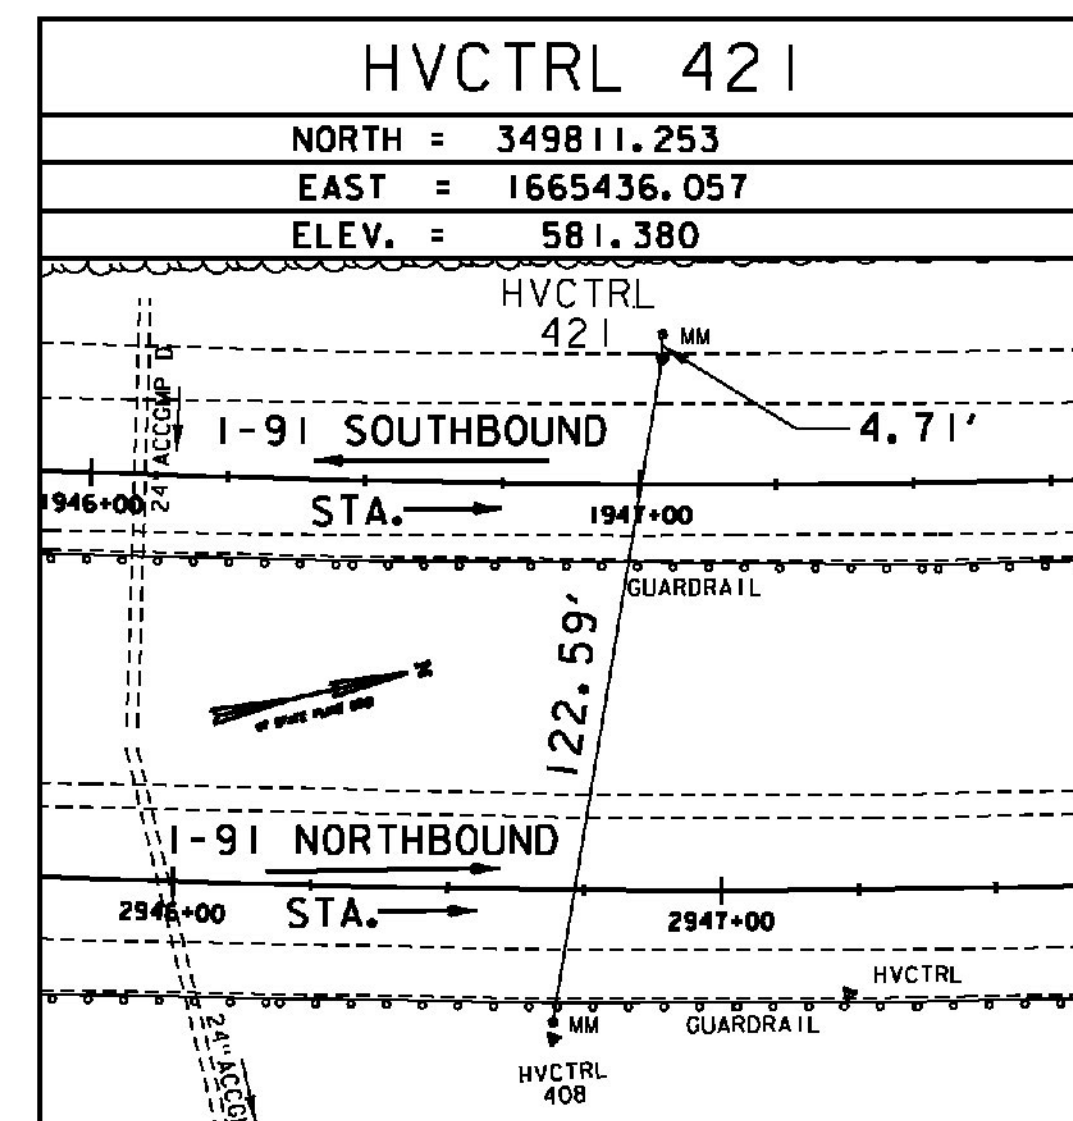
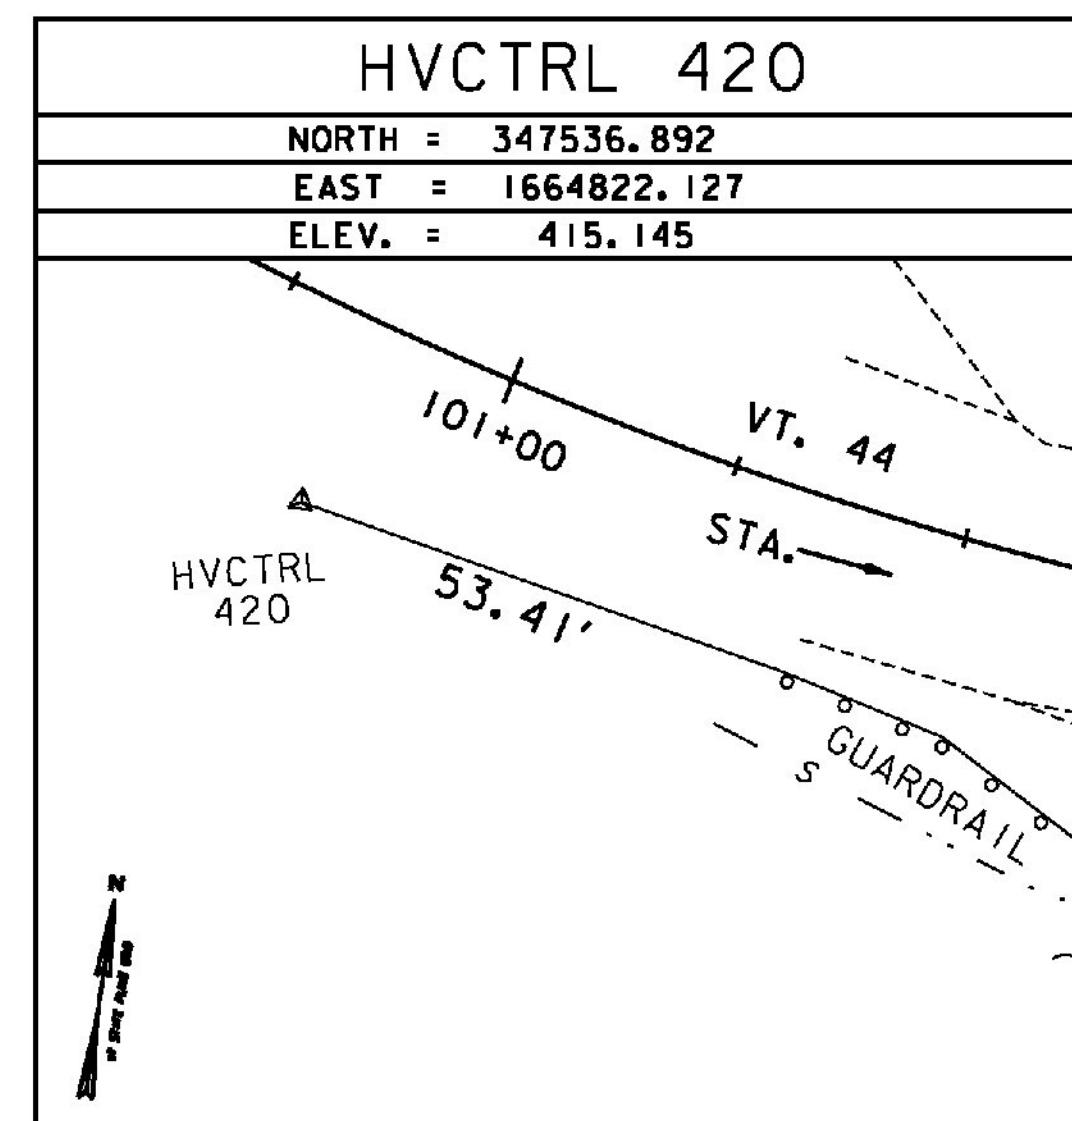
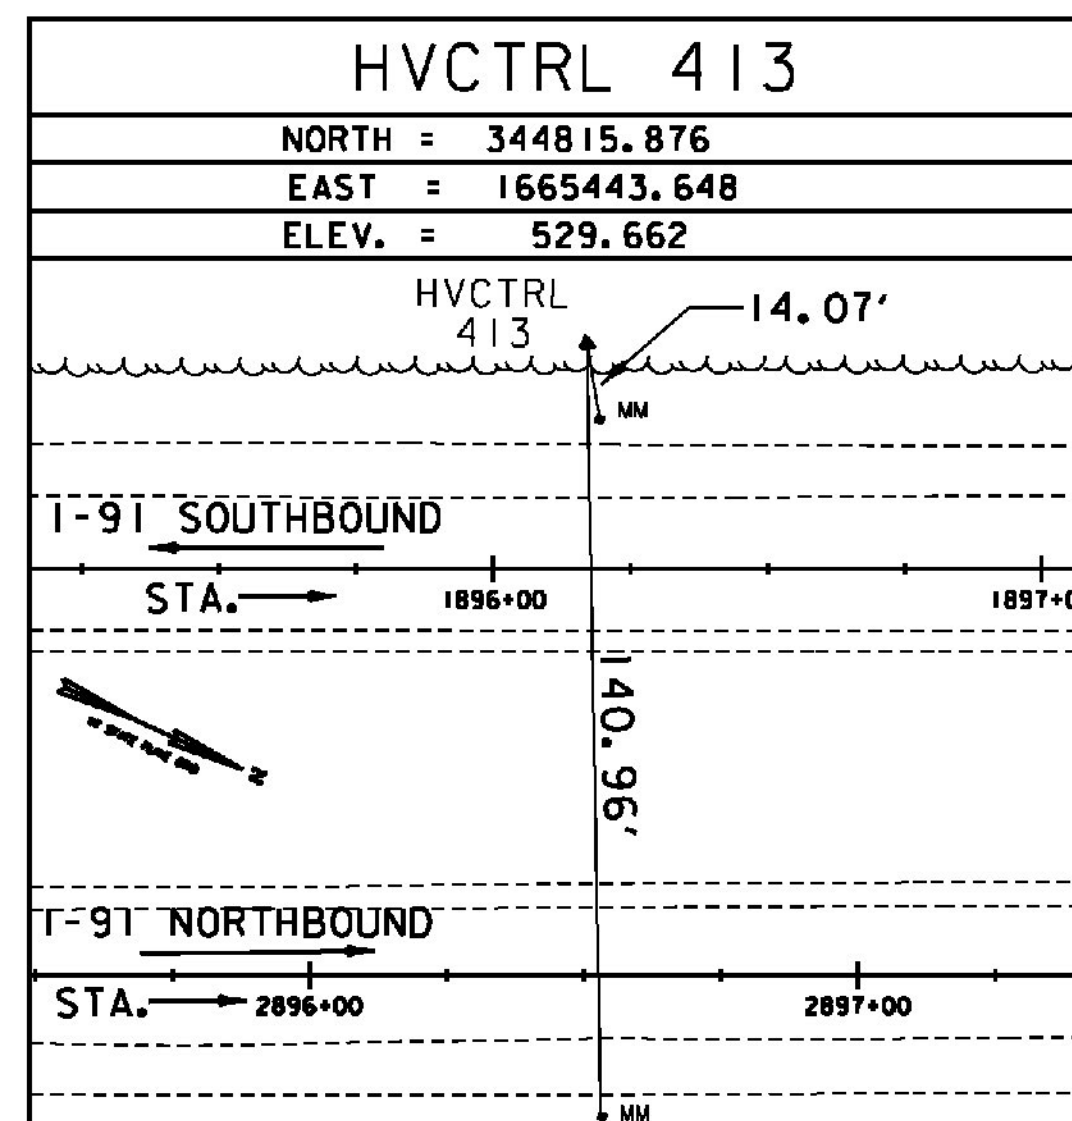
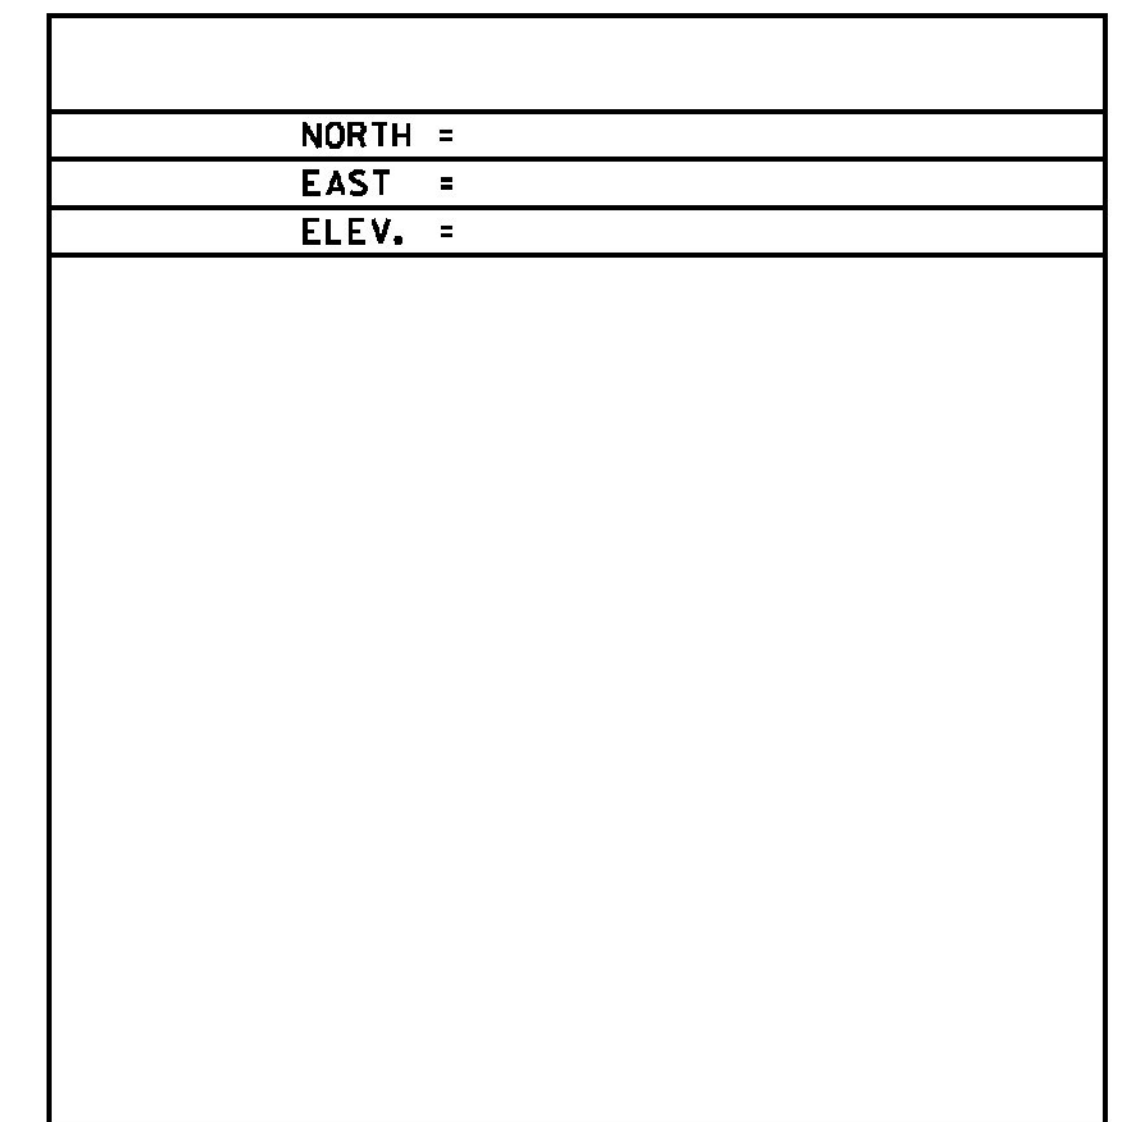
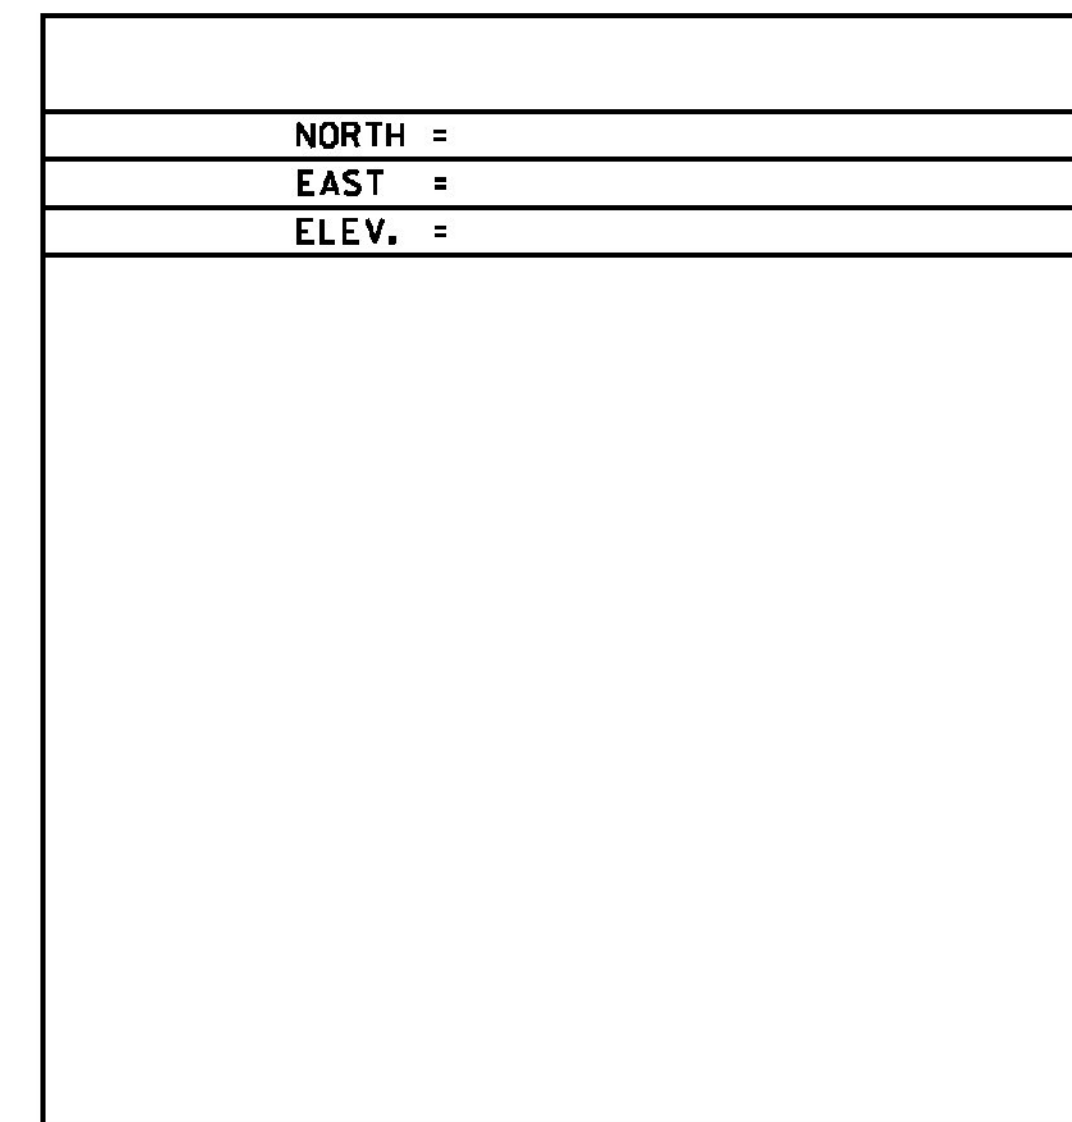
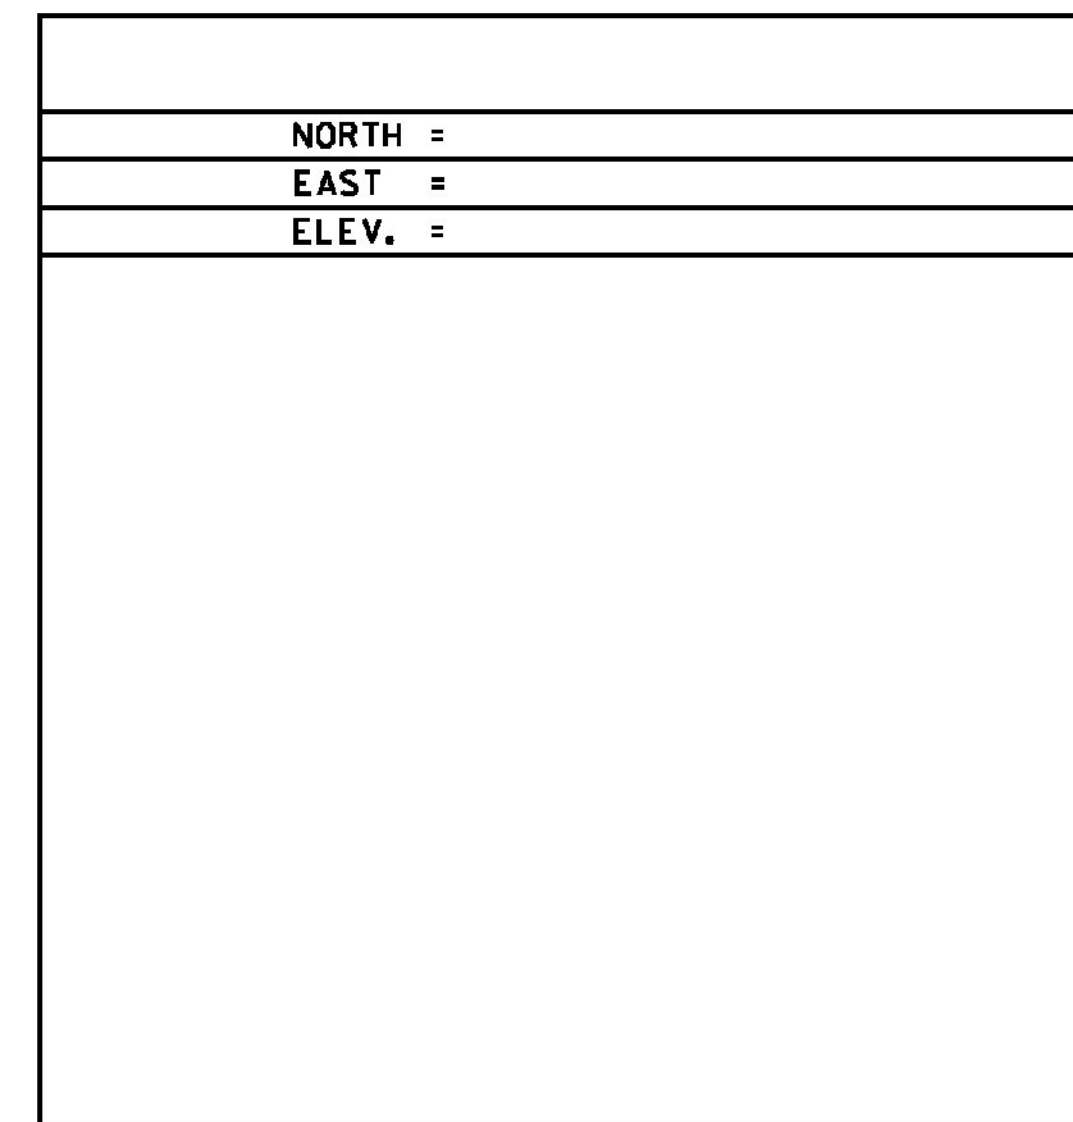


TRAVERSE TIES





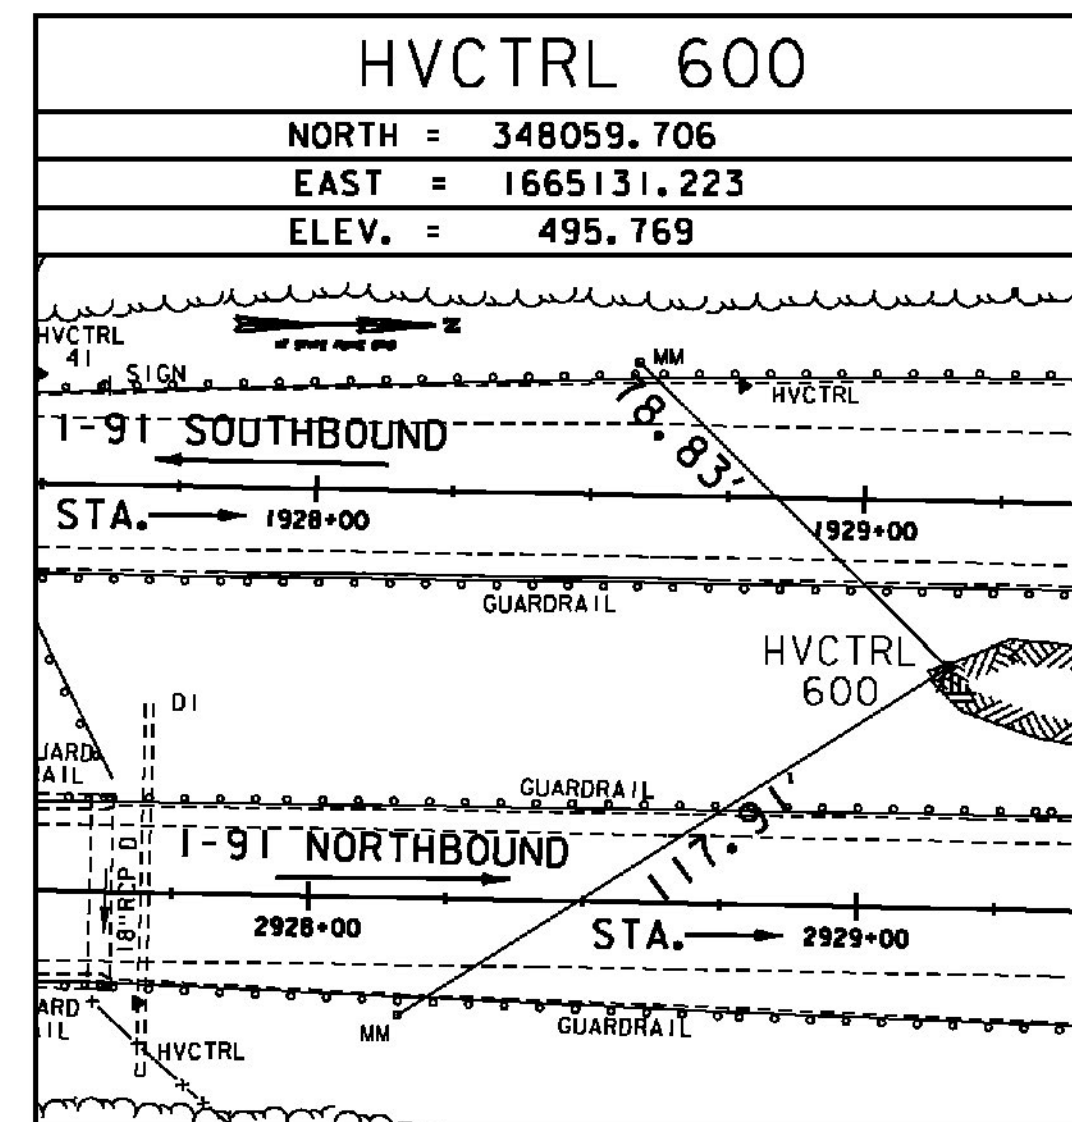


*MAIN TRAVERSE COMPLETED 2/23/2011 BY R. GILMAN P. C. & P. WINTERS

TRAVERSE TIES

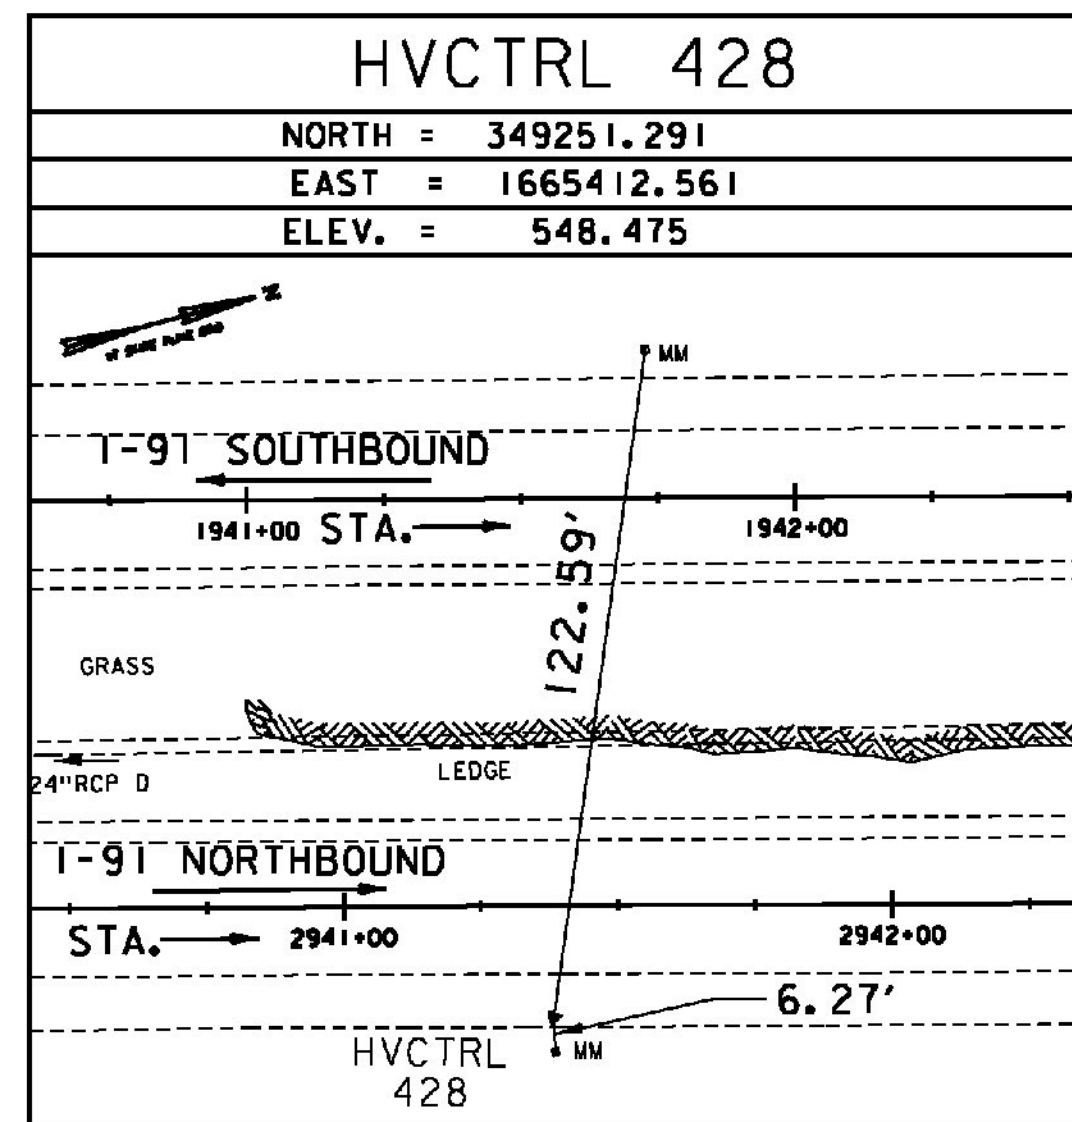

TRAVERSE TIES

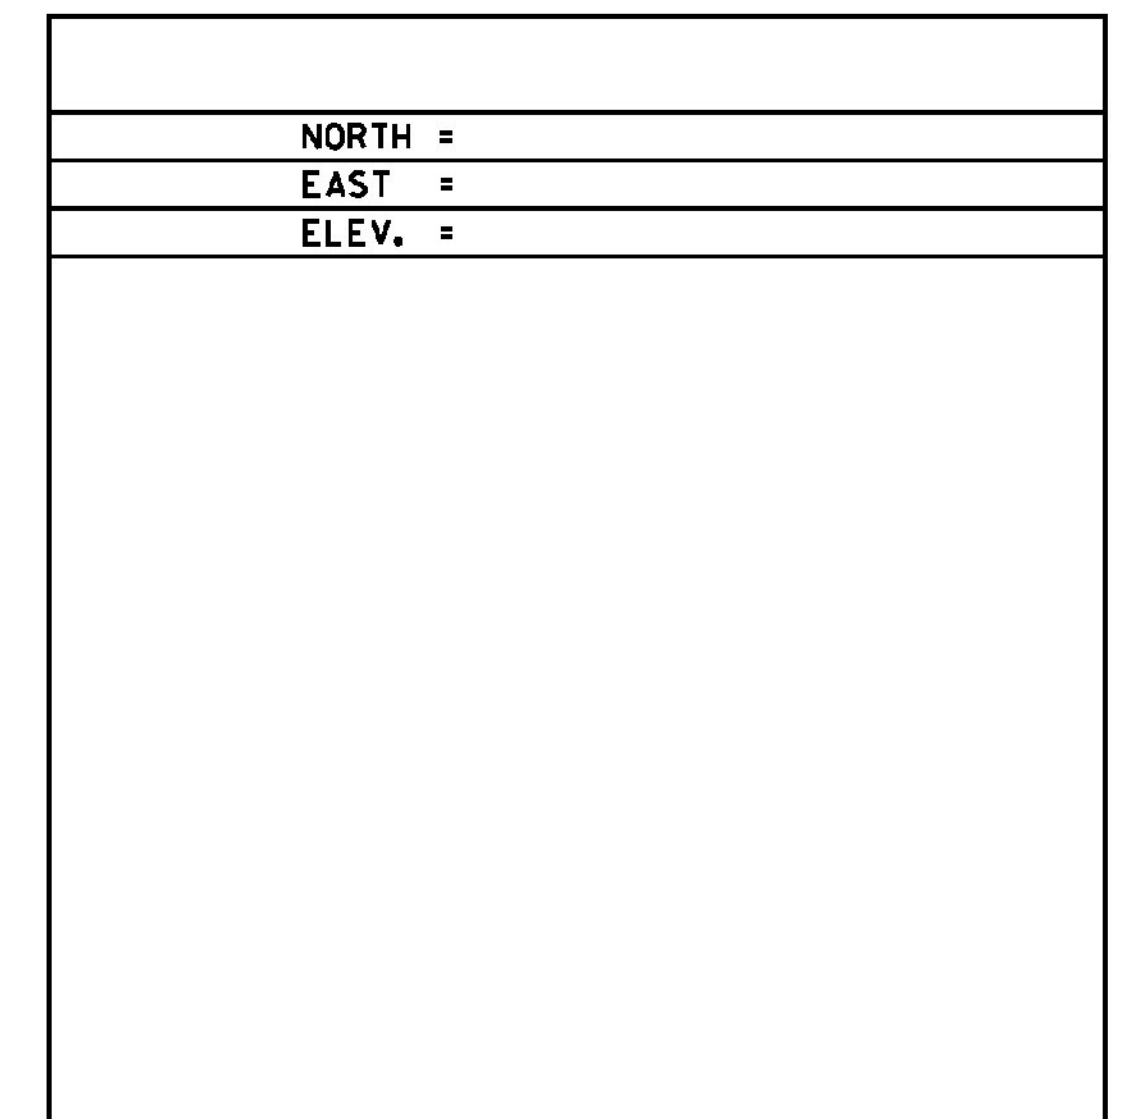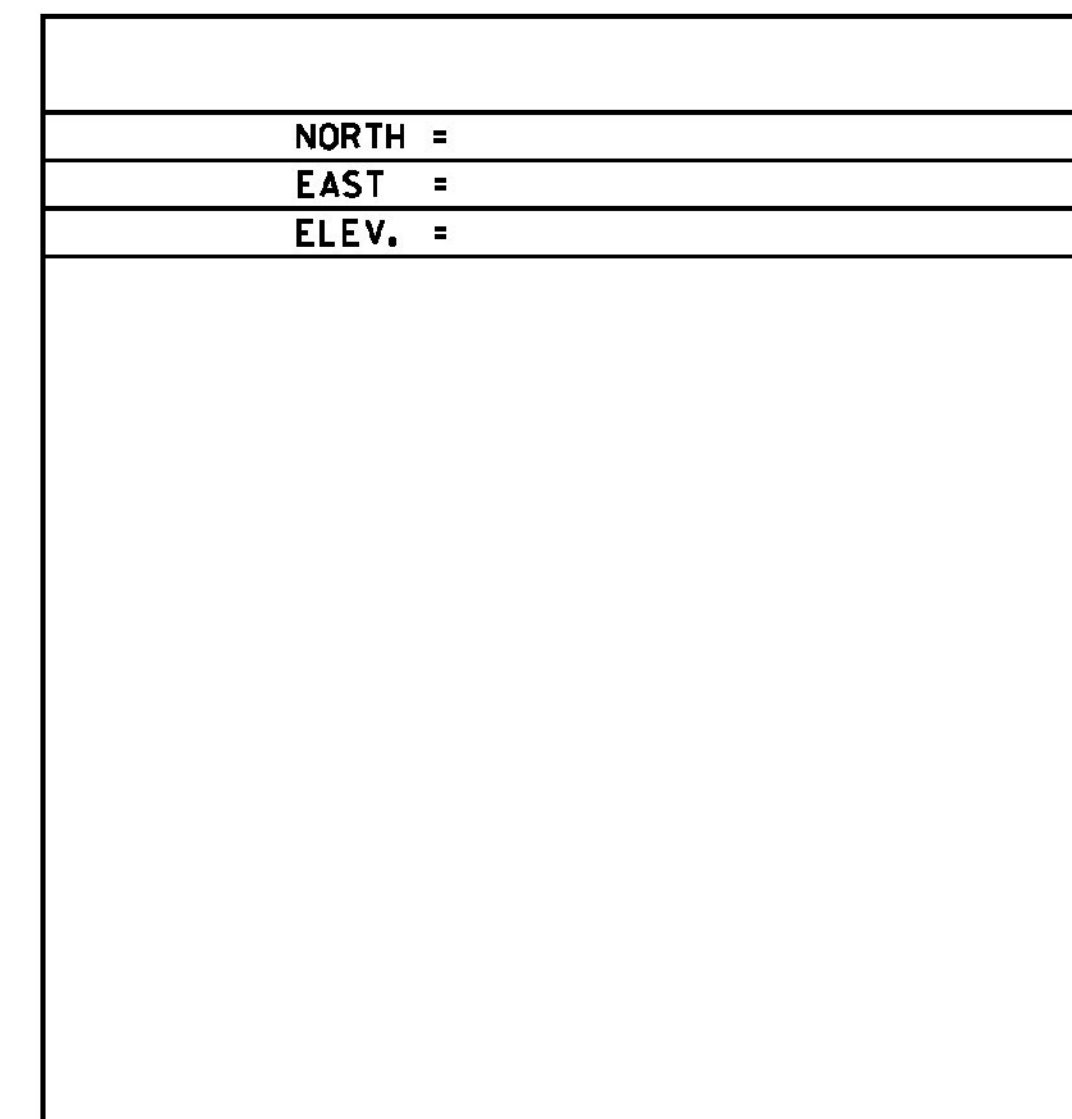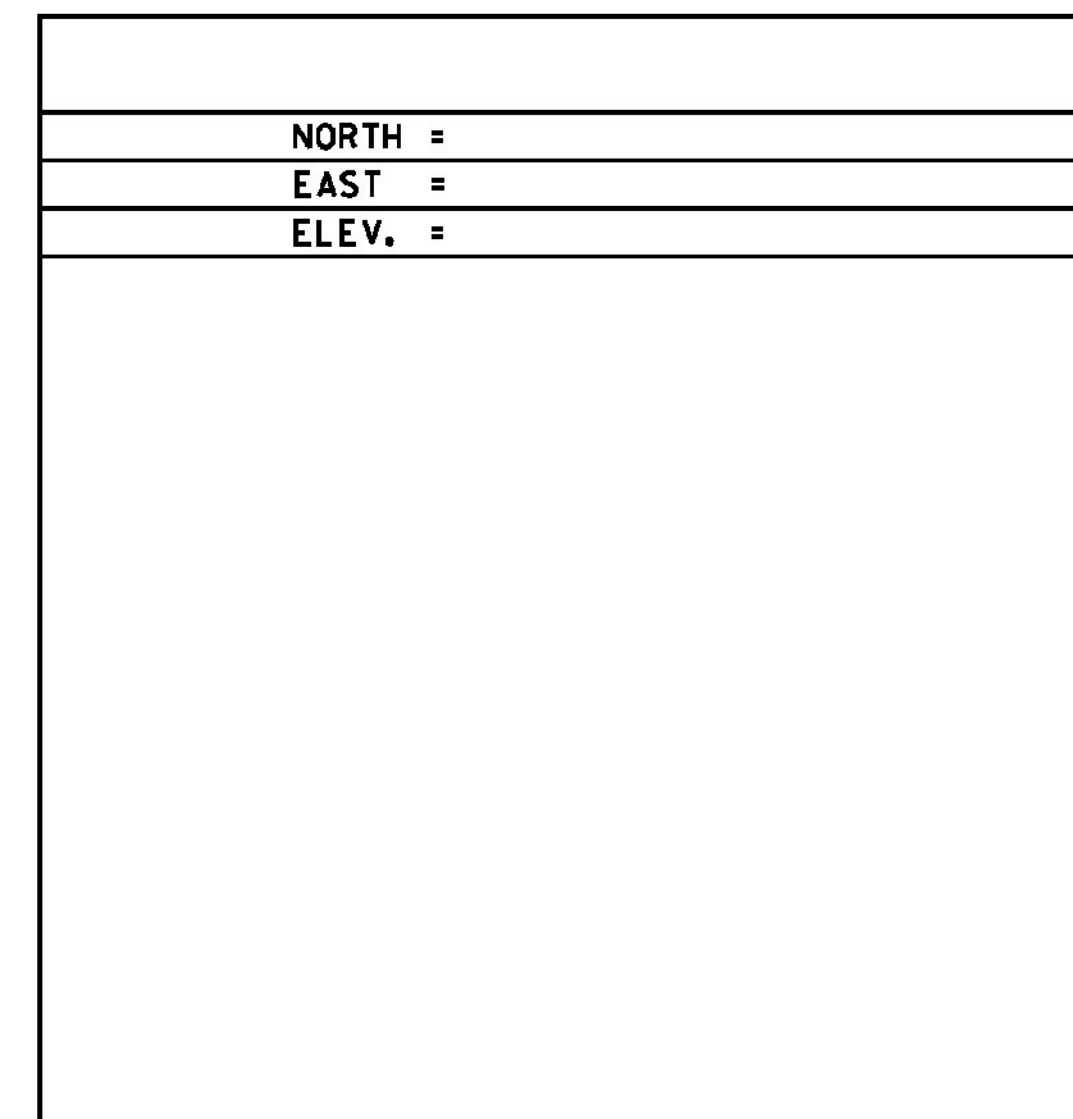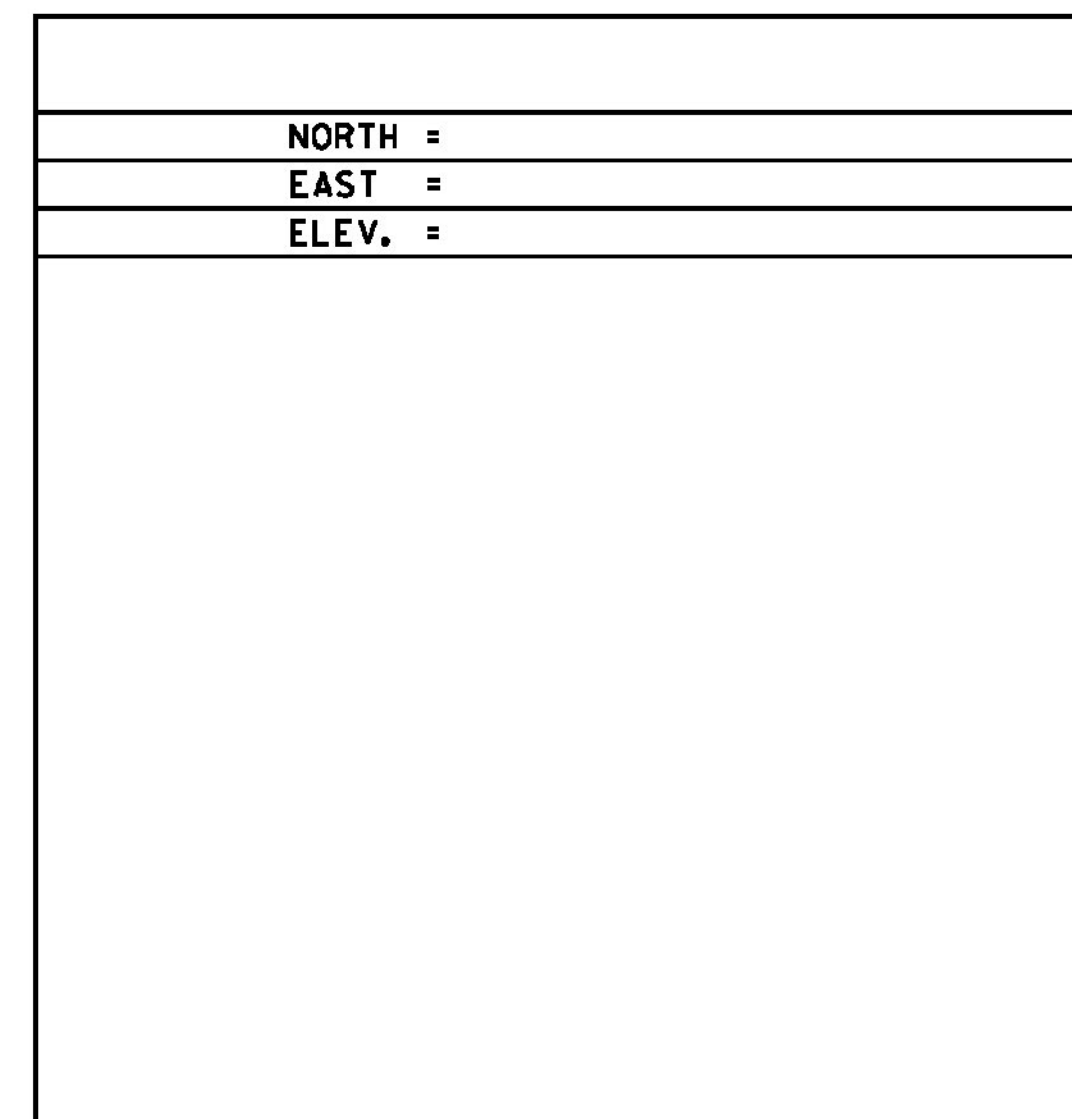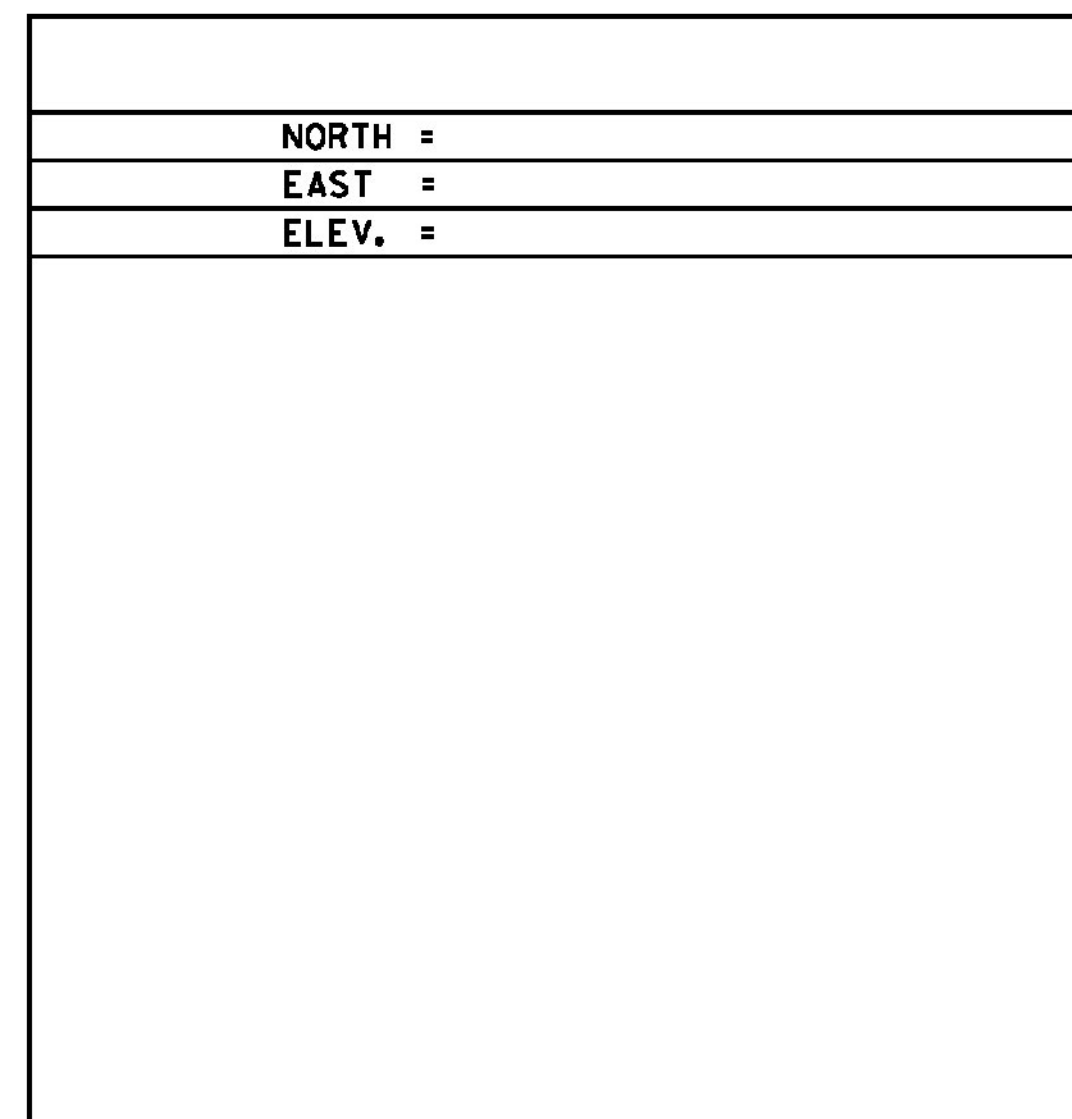

DATUM	
VERTICAL	NAVD 88
HORIZONTAL	NAD 83 (07)
ADJUSTMENT	COMPASS

ALL TIES NOT SHOWN TO SCALE

PROJECT NAME:	WINDSOR
PROJECT NUMBER:	IM 091-1(64)
FILE NAME:	z10o188T1.dgn
PROJECT LEADER:	J. WILSON
DESIGNED BY:	H. FULLER
TIE SHEET	3
PLOT DATE:	7/30/2015
DRAWN BY:	S. GUNN
CHECKED BY:	T. MORIN
SHEET	13
OF	156