


APPROXIMATE STATE RIGHT OF WAY

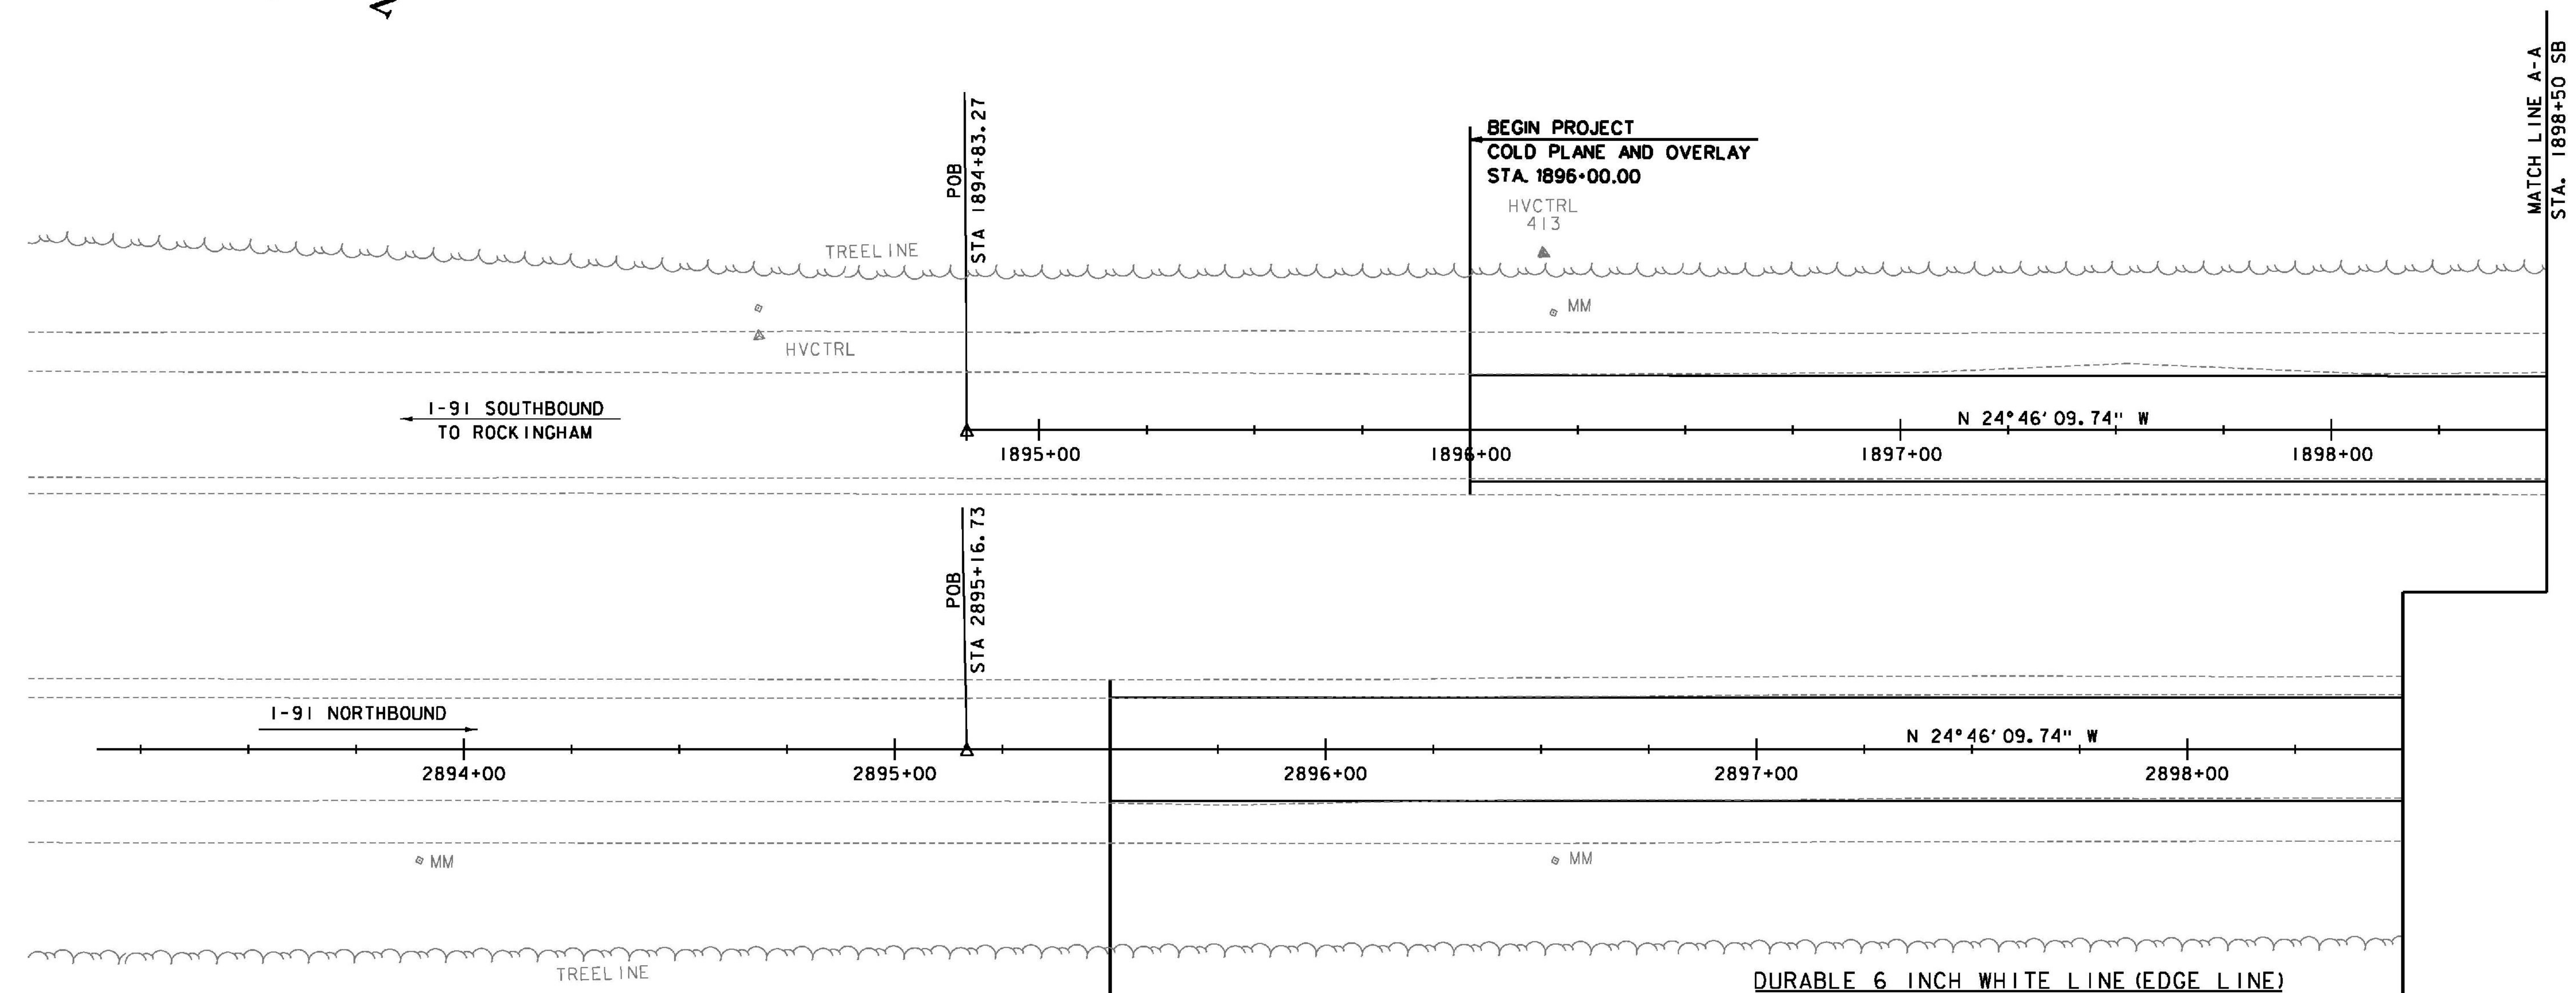

ITEMS USED ON THIS SHEET SET	
ITEM NO.	DESCRIPTION
213.10	MILLED RUMBLE STRIPS
621.21	HD STEEL BEAM GUARDRAIL, GALVANIZED
621.218	STEEL BEAM GUARDRAIL DELINEATOR
621.50	MANUFACTURED TERMINAL SECTION, FLARED
621.53	TERMINAL CONNECTOR FOR STEEL BEAM GUARDRAIL
621.747	GUARDRAIL APPROACH SECTION TO CONCRETE BRIDGE RAILING, TL3
646.420	DURABLE 6 INCH WHITE LINE
646.430	DURABLE 6 INCH YELLOW LINE
675.20	TRAFFIC SIGN, TYPE A

\* FOR DRAINAGE ITEMS SEE ITEM DETAIL DRAINAGE SHEET AND MISC. ROADWAY DETAILS  
 FOR PAVEMENT AND EMBANKMENT ITEMS, SEE TYPICAL SECTIONS  
 FOR SEED MIX ITEMS, SEE EPSC SHEETS

BEGIN PROJECT  
 COLD PLANE AND OVERLAY  
 STA. 2895+50.00

DURABLE 6 INCH WHITE LINE (EDGE LINE)  
 I-91 SB: STA. 1896+00 - STA. 1952+50 LT.  
 I-91 NB: STA. 2895+50 - STA. 2943+25 RT.

DURABLE 6 INCH YELLOW LINE (EDGE LINE)  
 I-91 SB: STA. 1896+00 - STA. 1952+50 RT.  
 I-91 NB: STA. 2895+50 - STA. 2943+25 LT.

DURABLE 6 INCH WHITE (CENTERLINE)  
 I-91 SB: STA. 1896+00 - STA. 1952+50  
 I-91 NB: STA. 2895+50 - STA. 2943+25

MILLED RUMBLE STRIPS  
 I-91 SB: STA. 1918+00 - STA. 1920+10 LT.  
 I-91 SB: STA. 1927+50 - STA. 1929+75 LT.  
 I-91 NB: STA. 2918+25 - STA. 2920+30 RT.  
 I-91 NB: STA. 2927+80 - STA. 2930+25 RT.

APPROXIMATE STATE RIGHT OF WAY

DATUM  
 VERTICAL NAVD88  
 HORIZONTAL NAD 83 (07)

SCALE 1" = 20' - 0"  
 20 0 20

PROJECT NAME: WINDSOR  
 PROJECT NUMBER: IM 091-1(64)

FILE NAME: z10o188bdr.dgn  
 PROJECT LEADER: J. WILSON  
 DESIGNED BY: H. FULLER  
 LAYOUT SHEET 1

PLOT DATE: 7/30/2015  
 DRAWN BY: S. GUNN  
 CHECKED BY: T. MORIN  
 SHEET 14 OF 156