


**CURVE #1 I-91 SB**  
 DELTA = 25°54'13" RT  
 D = 1°58'28"  
 R = 2901.78'  
 T = 667.36'  
 L = 1311.91'  
 E = 75.75'  
 BANK = EXISTING

MATCH LINE A-A  
 STA. 1898+50 SB

MATCH LINE B-B  
 STA. 1903+50 SB

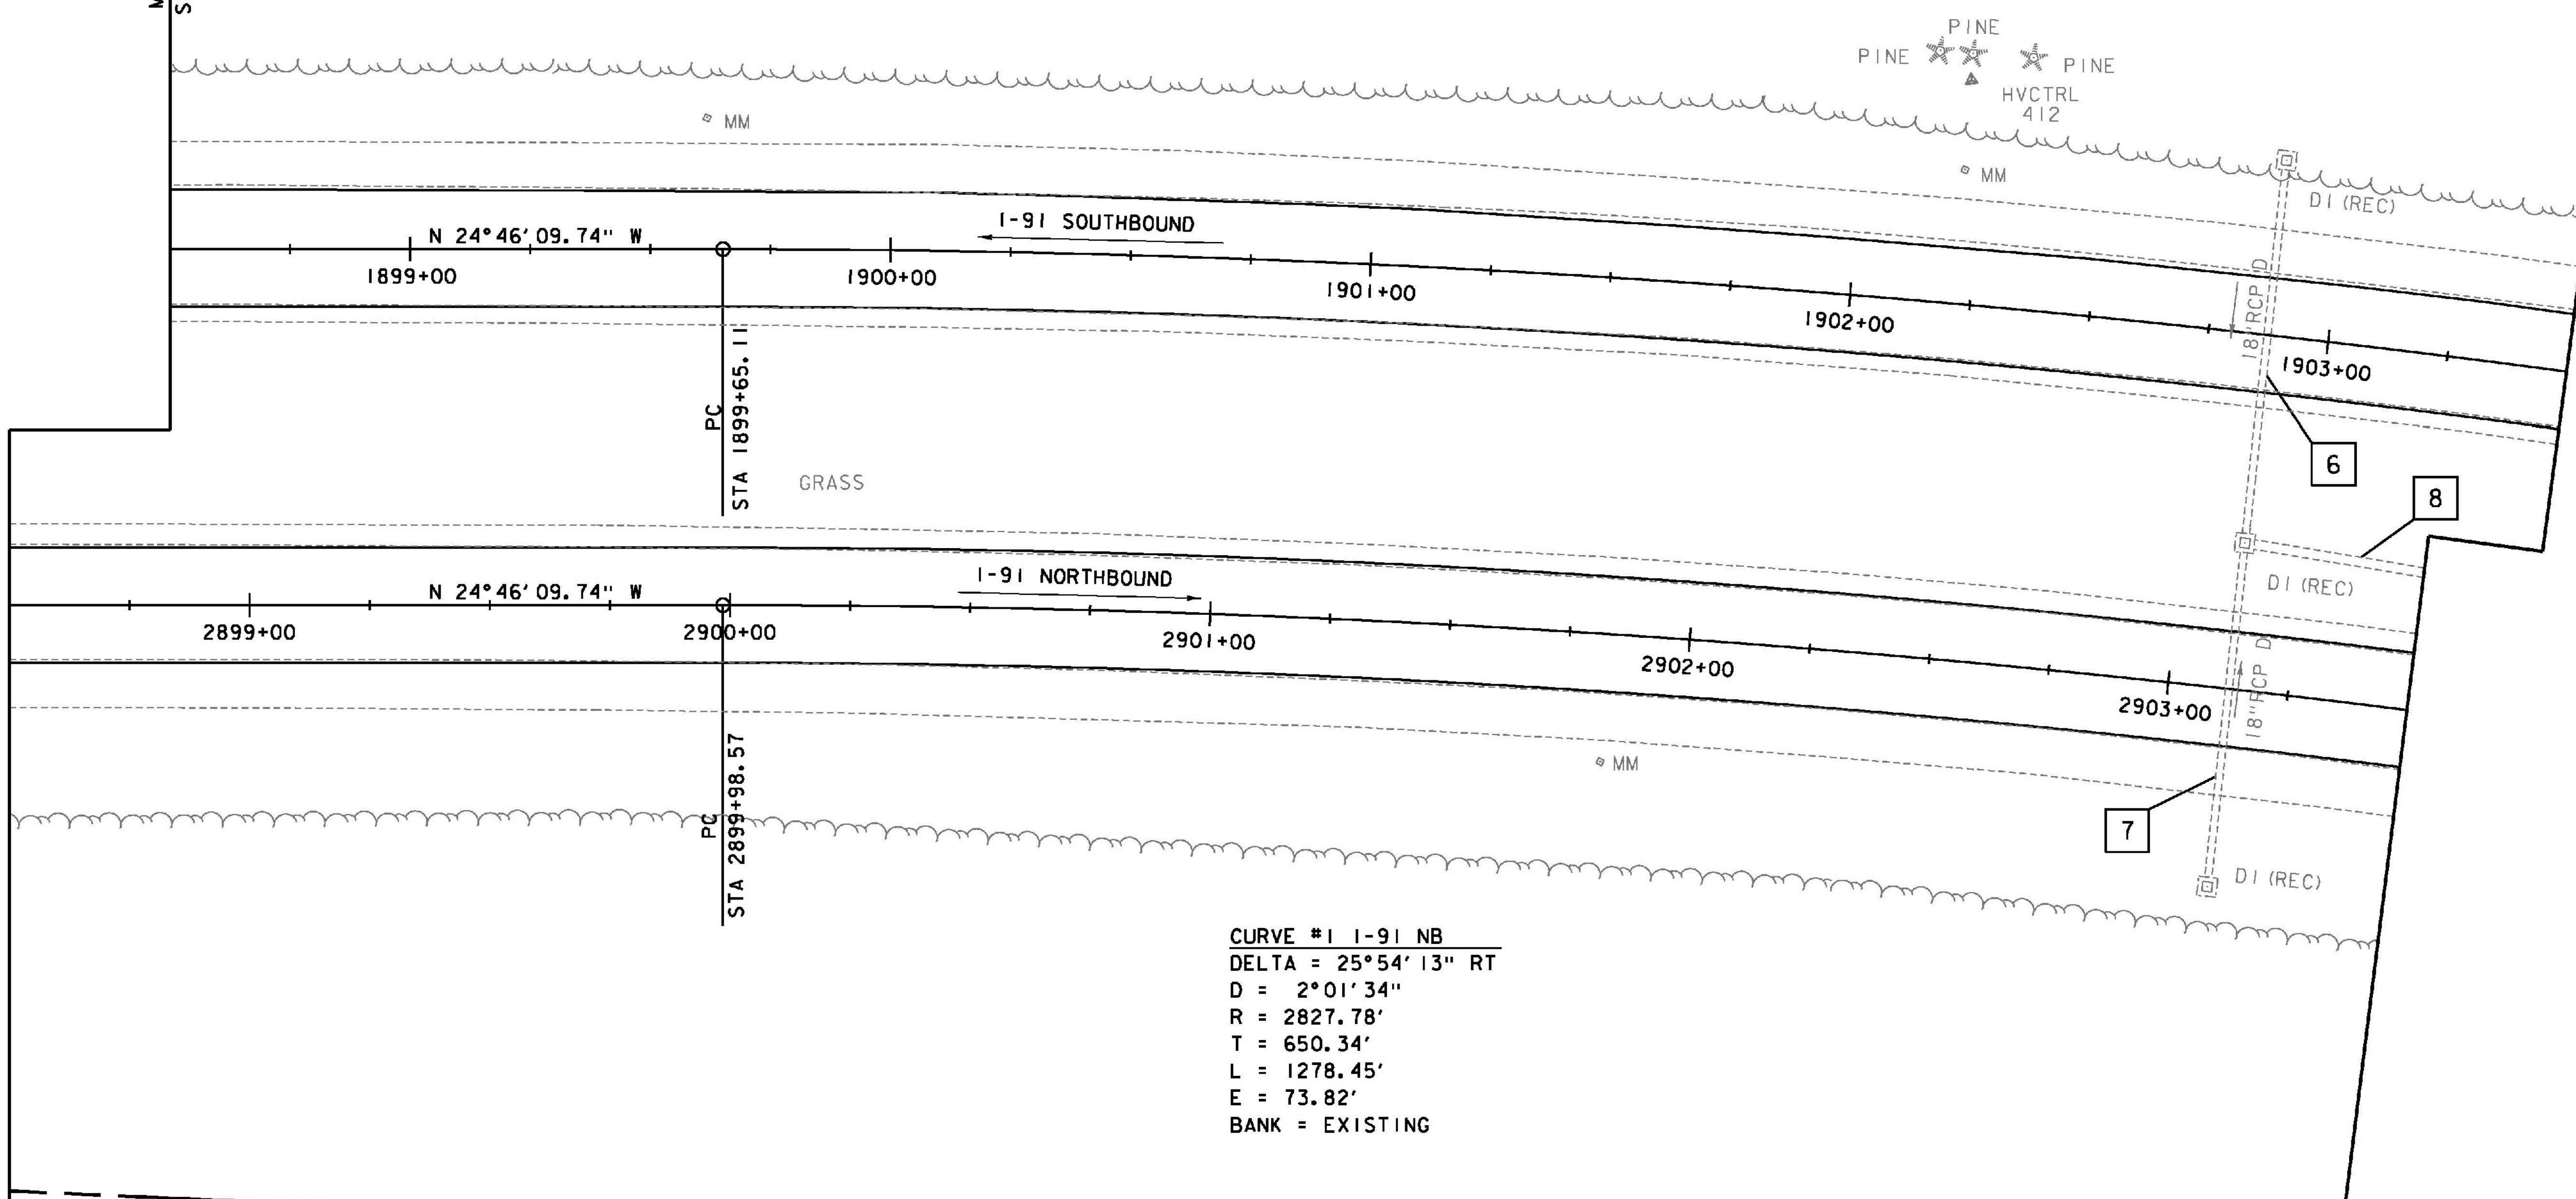

**CURVE #1 I-91 NB**  
 DELTA = 25°54'13" RT  
 D = 2°01'34"  
 R = 2827.78'  
 T = 650.34'  
 L = 1278.45'  
 E = 73.82'  
 BANK = EXISTING

DATUM  
 VERTICAL NAVD88  
 HORIZONTAL NAD 83 (07)

SCALE 1" = 20'-0"  
 20 0 20

PROJECT NAME: WINDSOR	PLOT DATE: 7/30/2015
PROJECT NUMBER: IM 091-1(64)	DRAWN BY: S. GUNN
FILE NAME: z10o188bdr.dgn	CHECKED BY: T. MORIN
PROJECT LEADER: J. WILSON	SHEET 15 OF 156
DESIGNED BY: H. FULLER	
LAYOUT SHEET 2	