


**CURVE #3 I-91 SB**  
 DELTA = 23°18'53" LT  
 D = 2°01'34"  
 R = 2827.79'  
 T = 583.41'  
 L = 1150.68'  
 E = 59.56'  
 BANK = EXISTING

**END PROJECT**  
**COLD PLANE & OVERLAY**  
**STA. 1952+50.00**

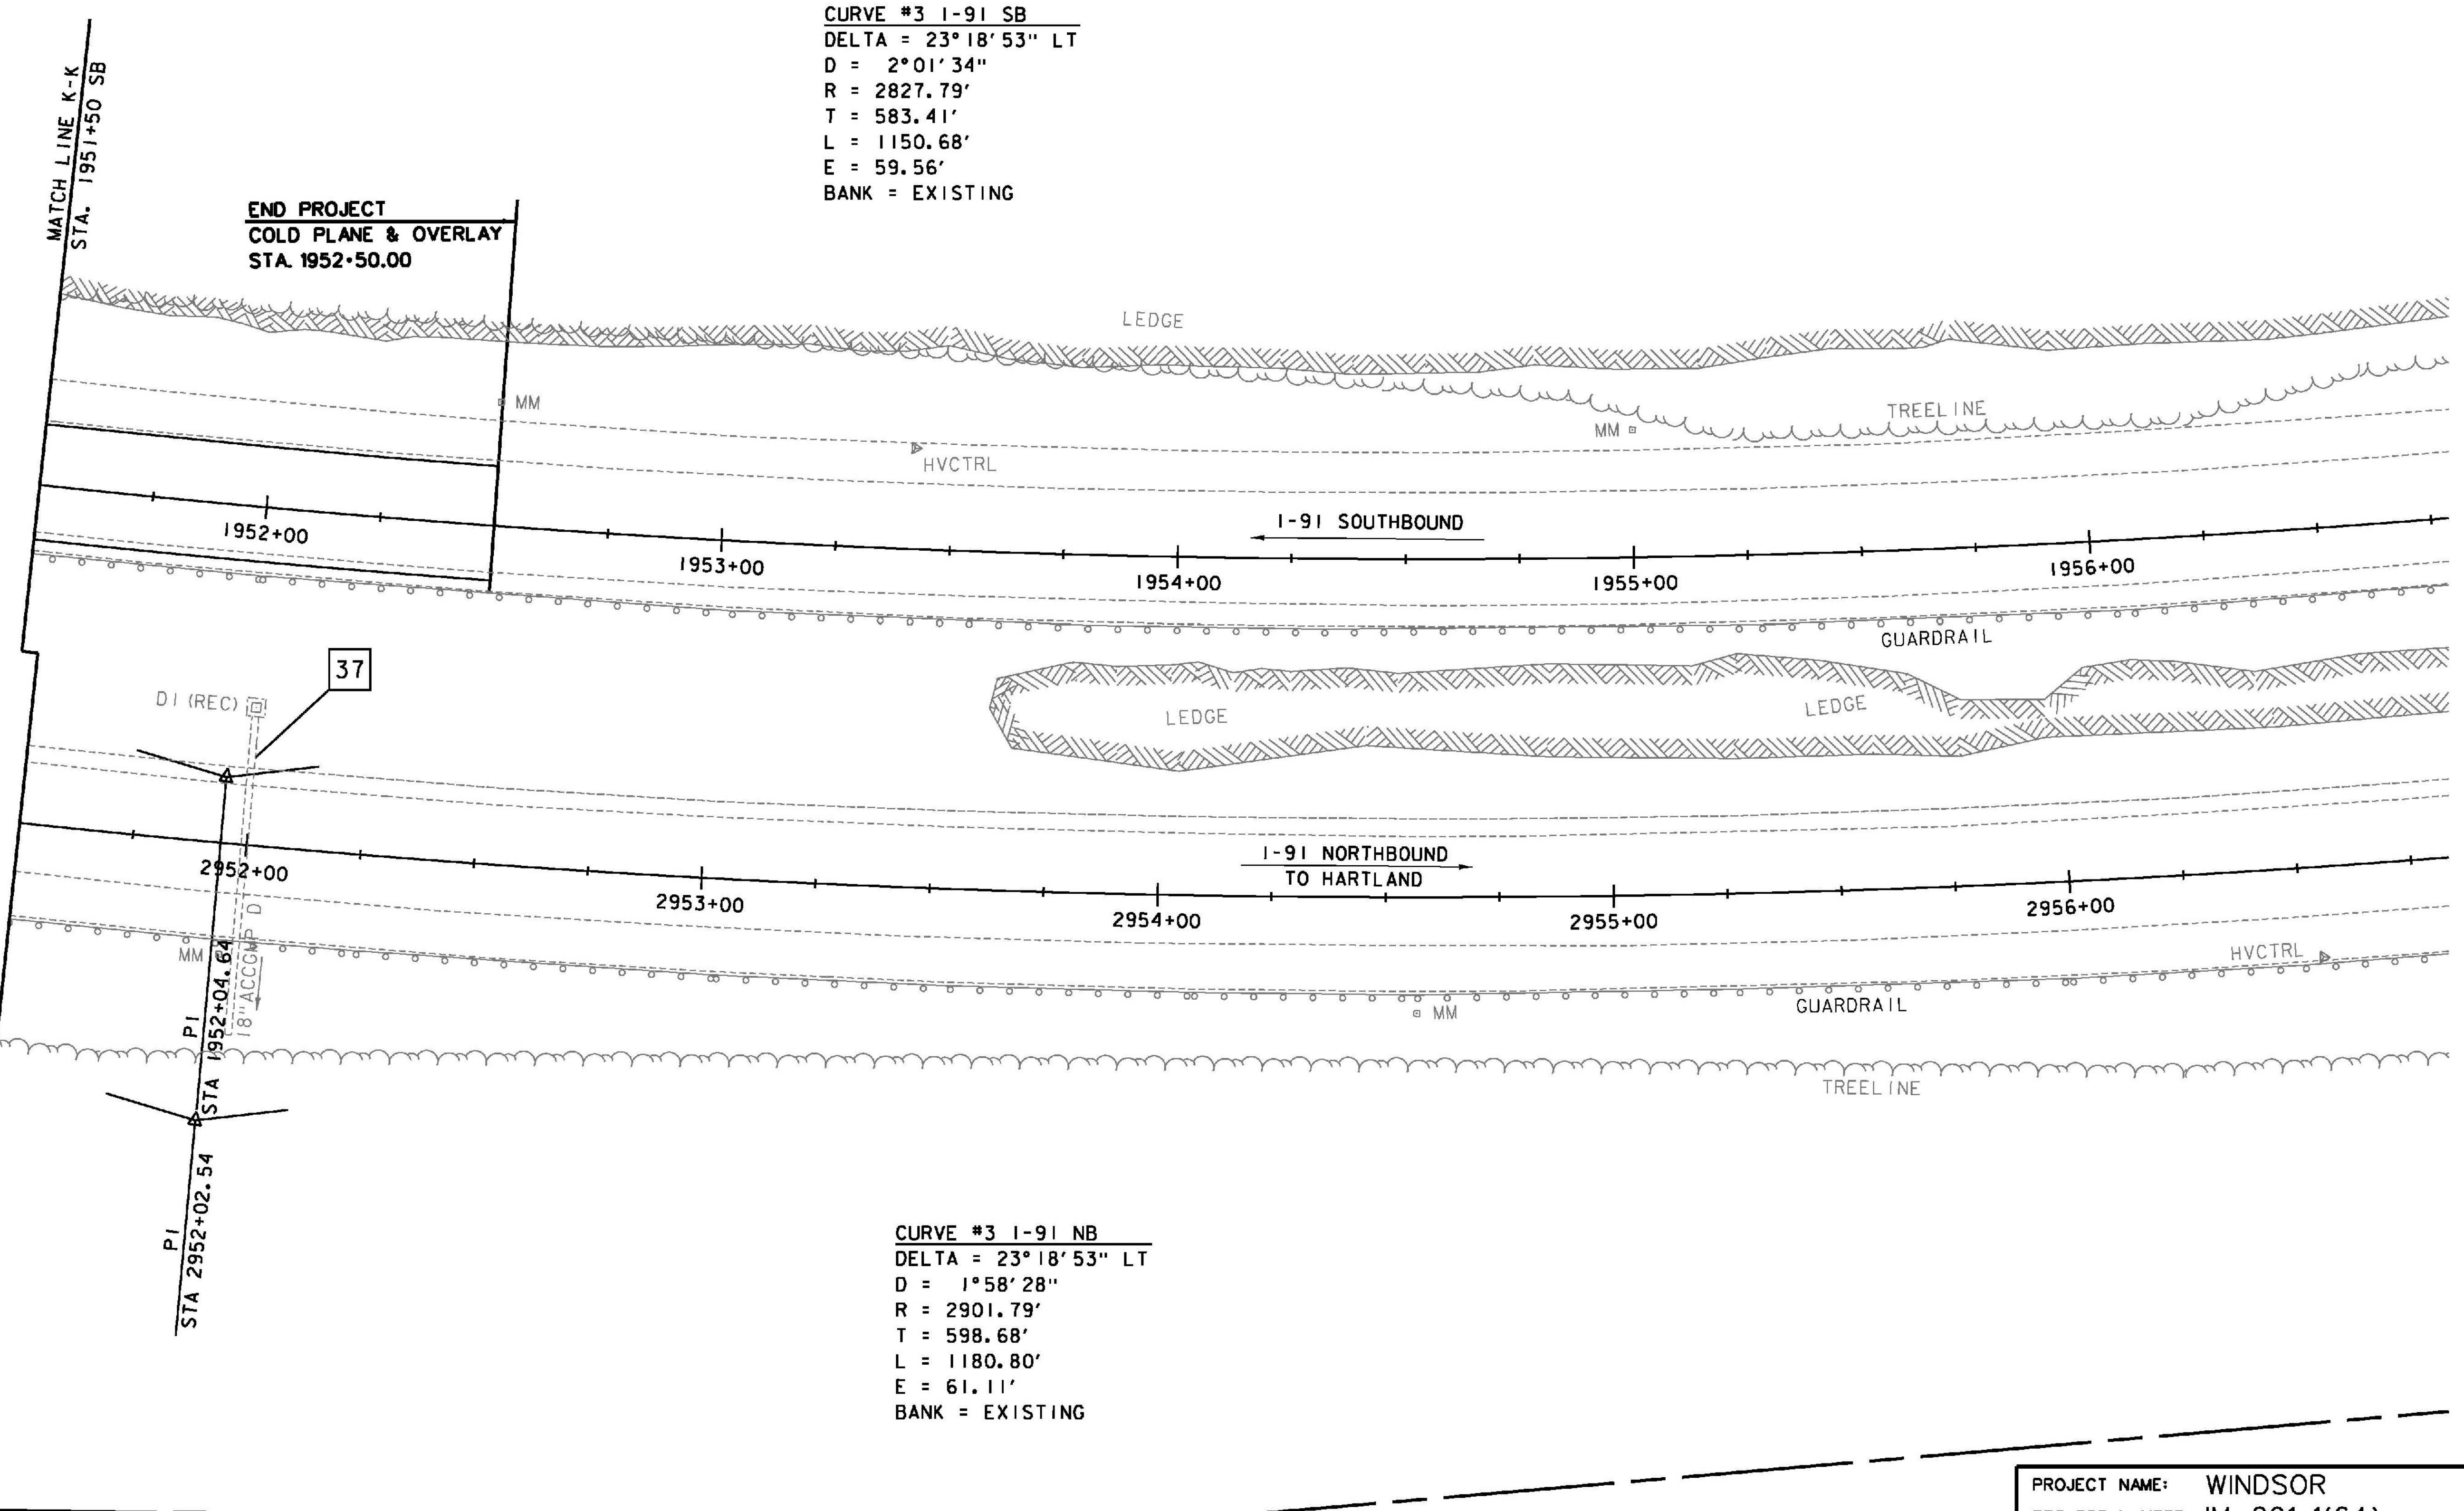

**CURVE #3 I-91 NB**  
 DELTA = 23°18'53" LT  
 D = 1°58'28"  
 R = 2901.79'  
 T = 598.68'  
 L = 1180.80'  
 E = 61.11'  
 BANK = EXISTING

DATUM  
 VERTICAL NAVD88  
 HORIZONTAL NAD 83 (07)

APPROXIMATE STATE RIGHT OF WAY

SCALE 1" = 20' - 0"  
 20 0 20

PROJECT NAME: WINDSOR  
 PROJECT NUMBER: IM 091-1(64)

FILE NAME: z10o188bdr.dgn  
 PROJECT LEADER: J. WILSON  
 DESIGNED BY: H. FULLER  
 LAYOUT SHEET 12

PLOT DATE: 7/30/2015  
 DRAWN BY: S. GUNN  
 CHECKED BY: T. MORIN  
 SHEET 25 OF 156