


PARTIAL FRAMING PLAN - BRIDGE 33N

SCALE 1" = 10'-0"

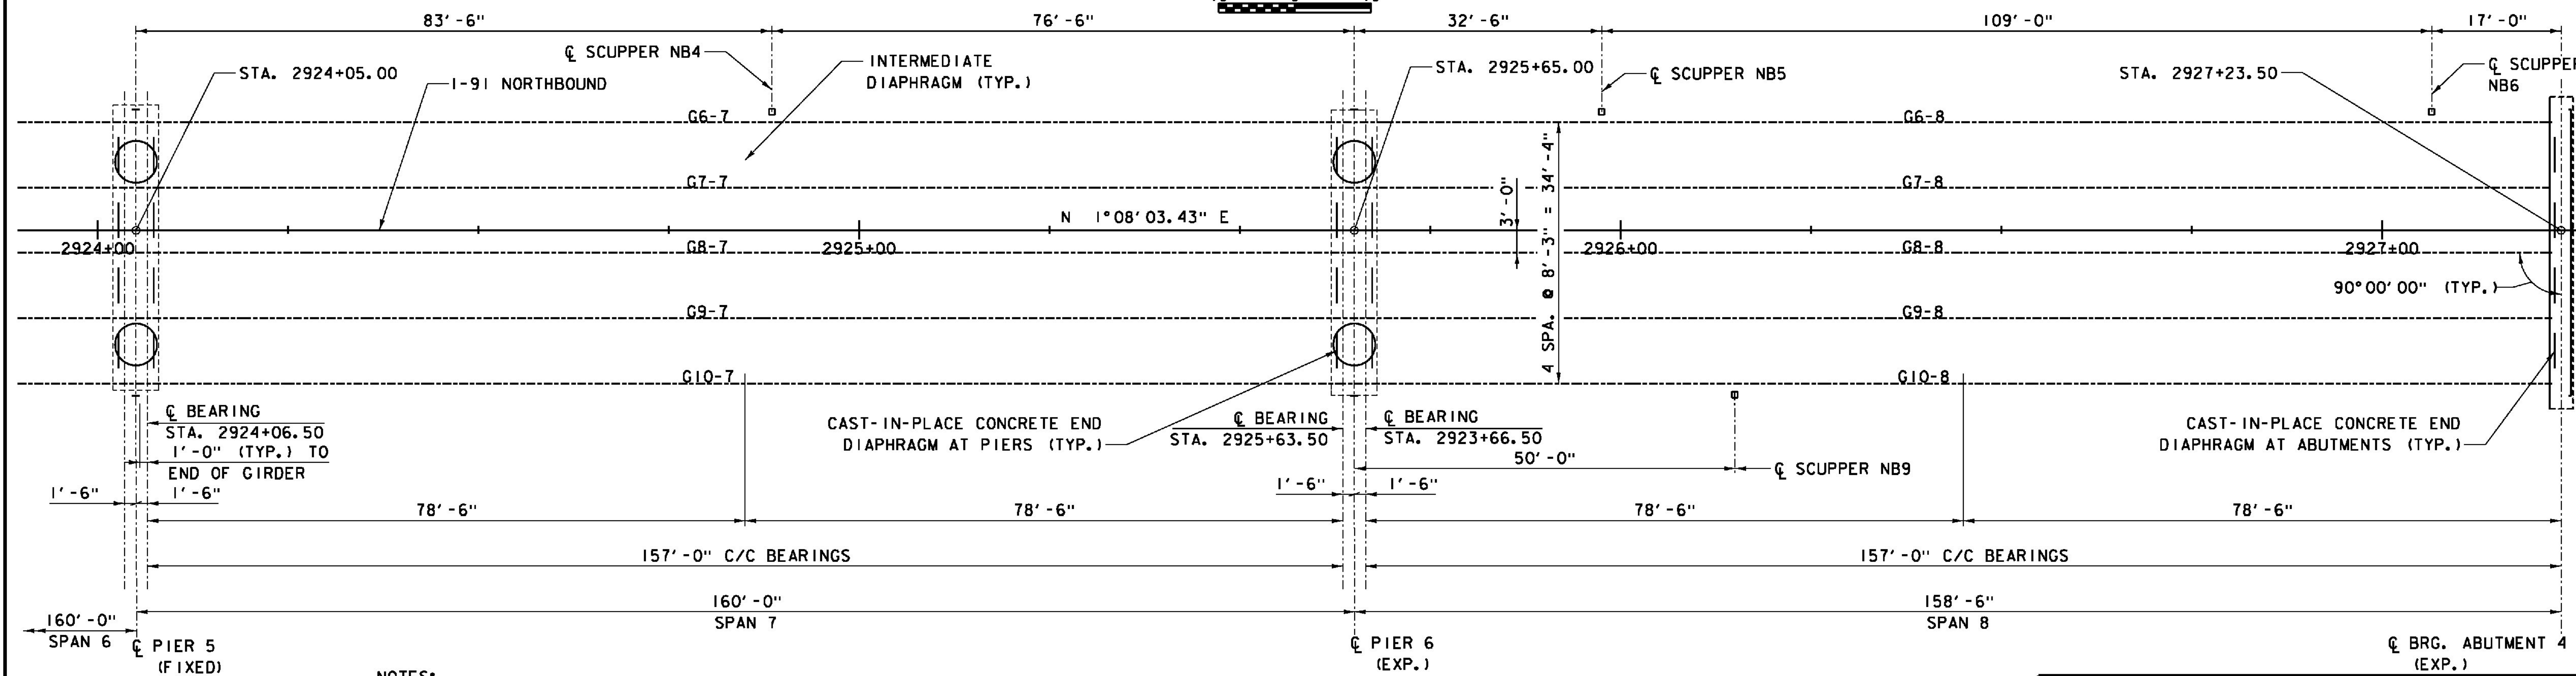

PARTIAL FRAMING PLAN - BRIDGE 33N

SCALE 1" = 10'-0"

- NOTES:
- NB 1 DENOTES SCUPPER LOCATION.
  - FOR SCUPPER DETAILS, SEE BRIDGE DRAINAGE SHEETS.
  - FOR DETAILS OF GIRDER FLANGE BLOCKOUT FOR SCUPPER DOWNSPOUT, SEE GIRDER DETAILS 6 SHEET.

PROJECT NAME: WINDSOR	
PROJECT NUMBER: IM 091-1(64)	
FILE NAME: z10o188BFR.dgn	PLOT DATE: 7/30/2015
PROJECT LEADER: J. WILSON	DRAWN BY: N. GARCIA III
DESIGNED BY: R. PEIN	CHECKED BY:
FRAMING PLAN - BRIDGE 33N	SHEET 65 OF 156