





REMOVE EXISTING PIER STRUCTURE TO A MINIMUM OF 2' BELOW FINISH GRADE

CL I-91 SB
N 01°08'03.43" E

| WORKING POINT CONTROL | | | |
|-----------------------|------------------------|-------------|--------------|
| LOCATION | STATION | NORTHING | EASTING |
| WP10 | 1925+41.00, 15.00' LT. | 347686.0439 | 1665078.6506 |
| WP11 | 1925+41.00, CL | 347685.7470 | 1665093.6476 |
| WP12 | 1925+41.00, 9.00' RT. | 347685.5688 | 1665102.6459 |

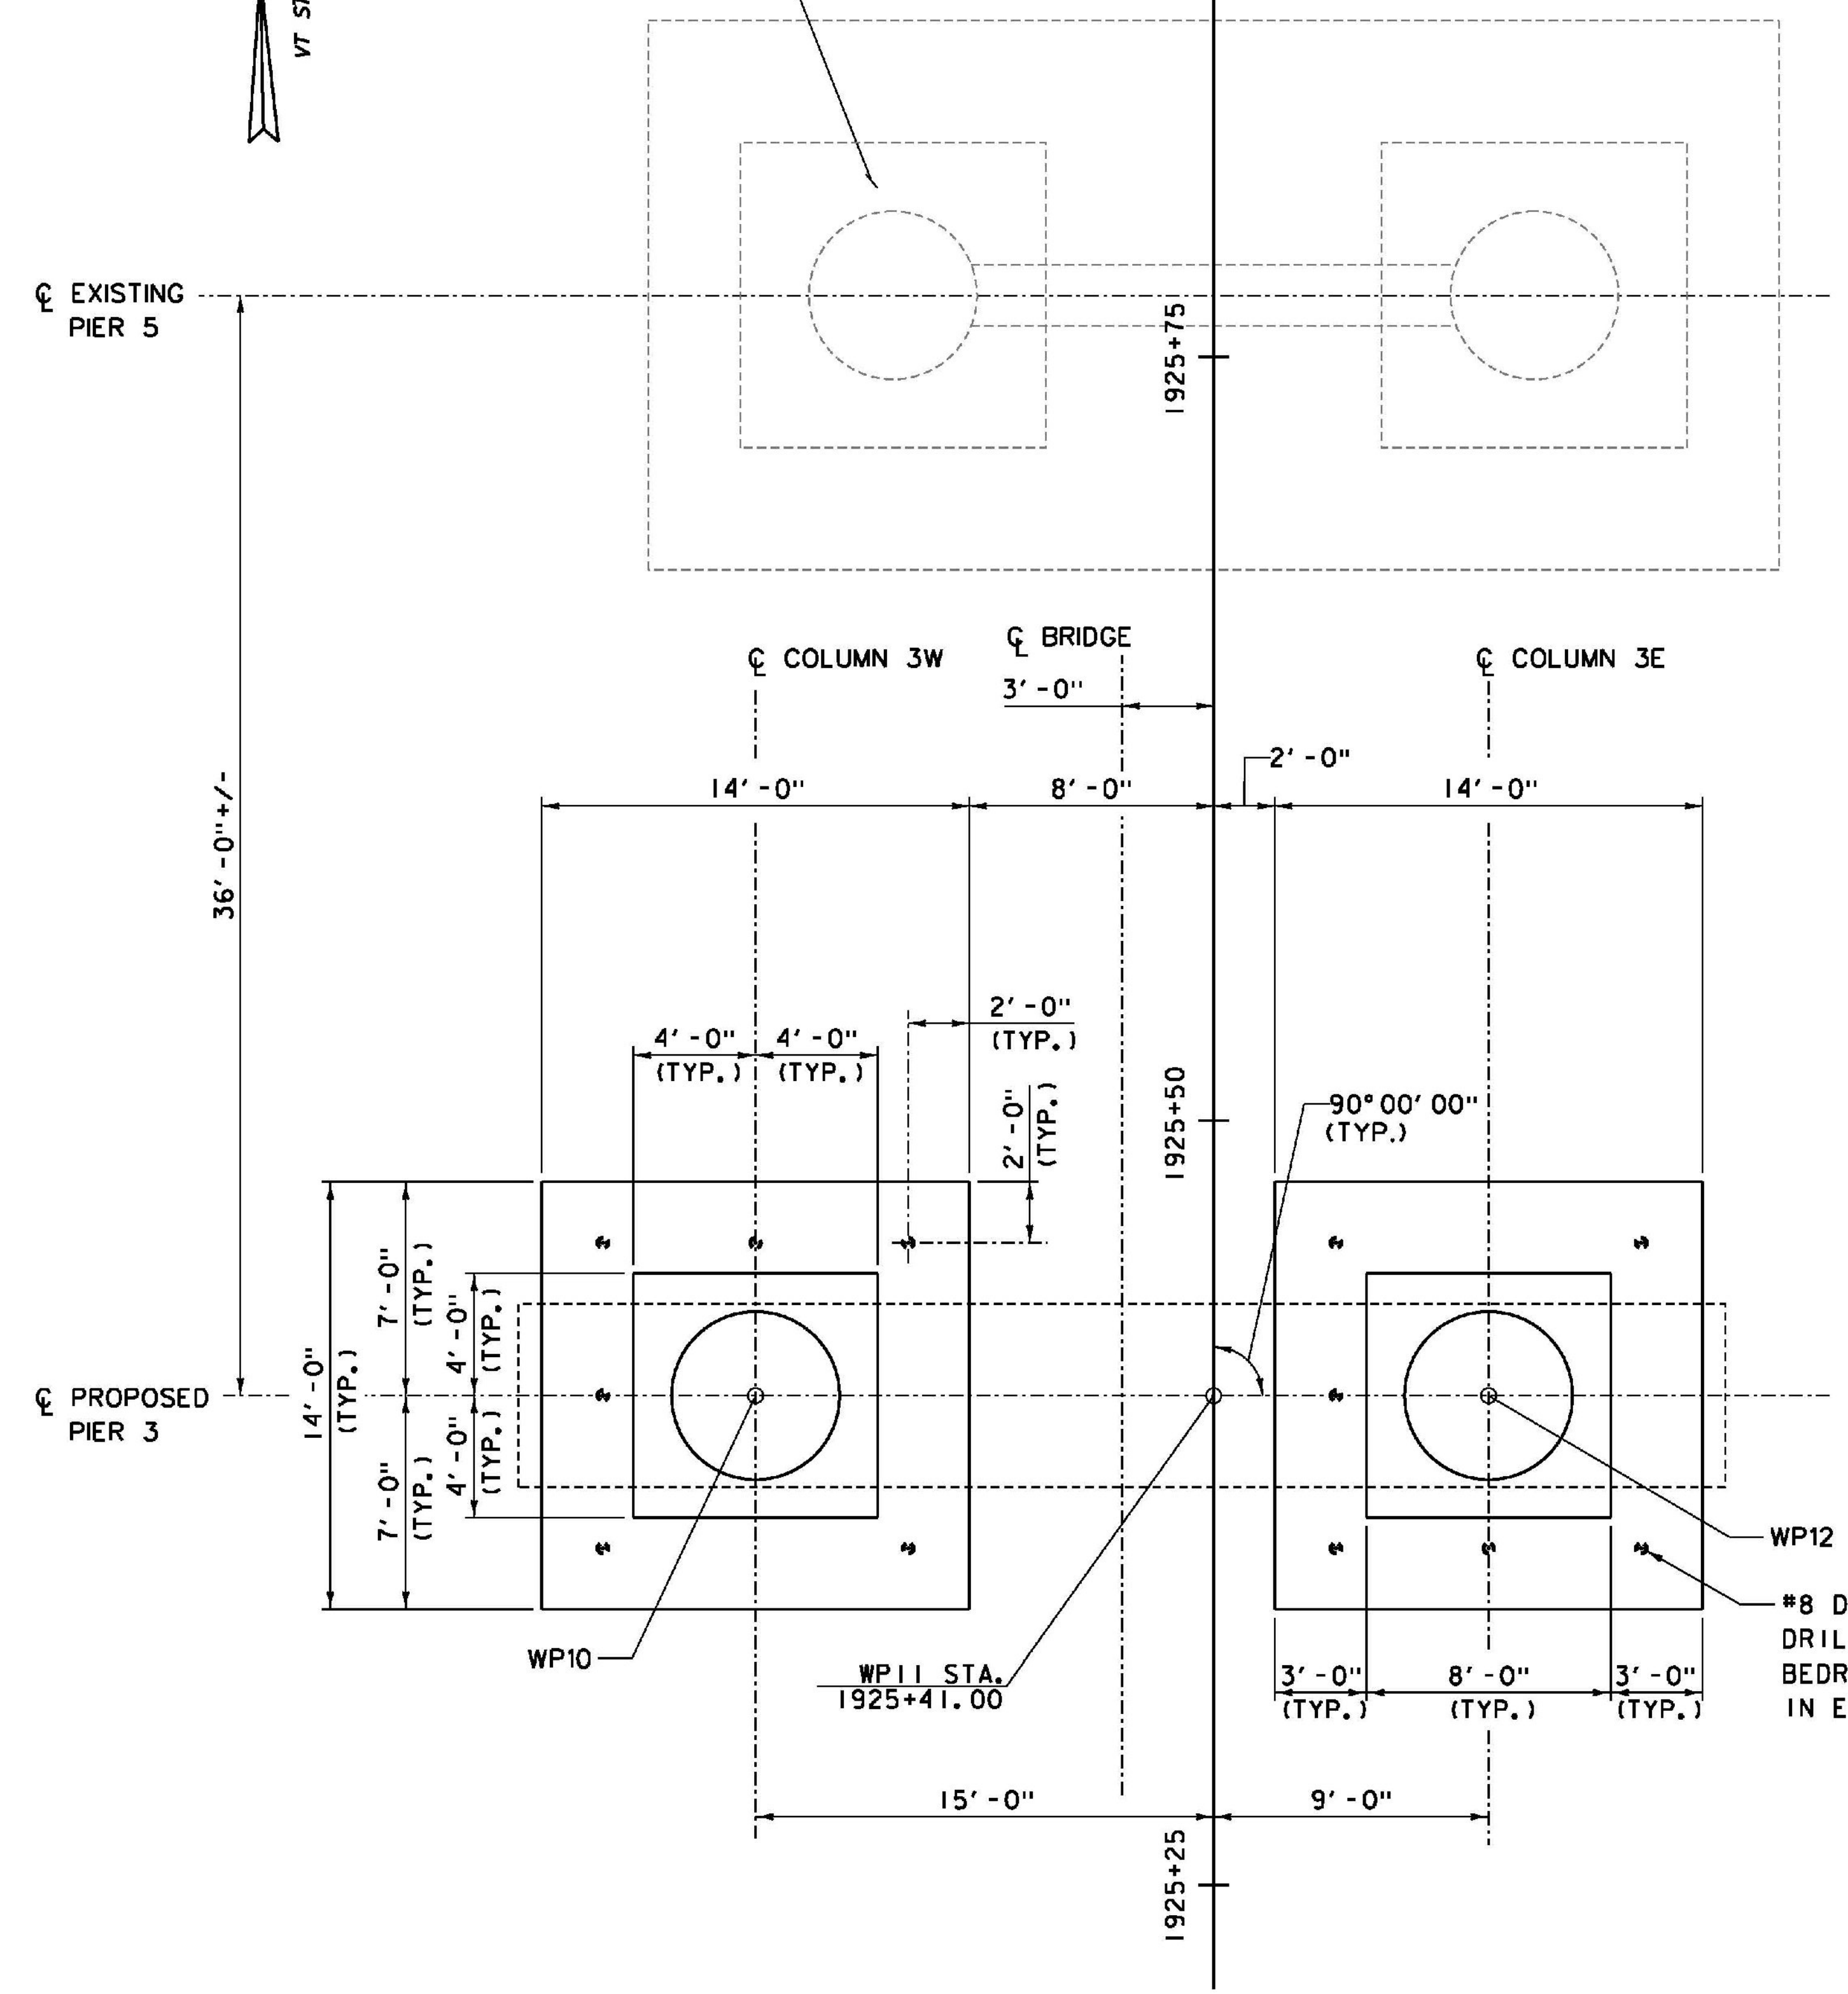

PIER 3 FOOTING PLAN
SCALE 1/4" = 1'-0"
1 0 2 4 6

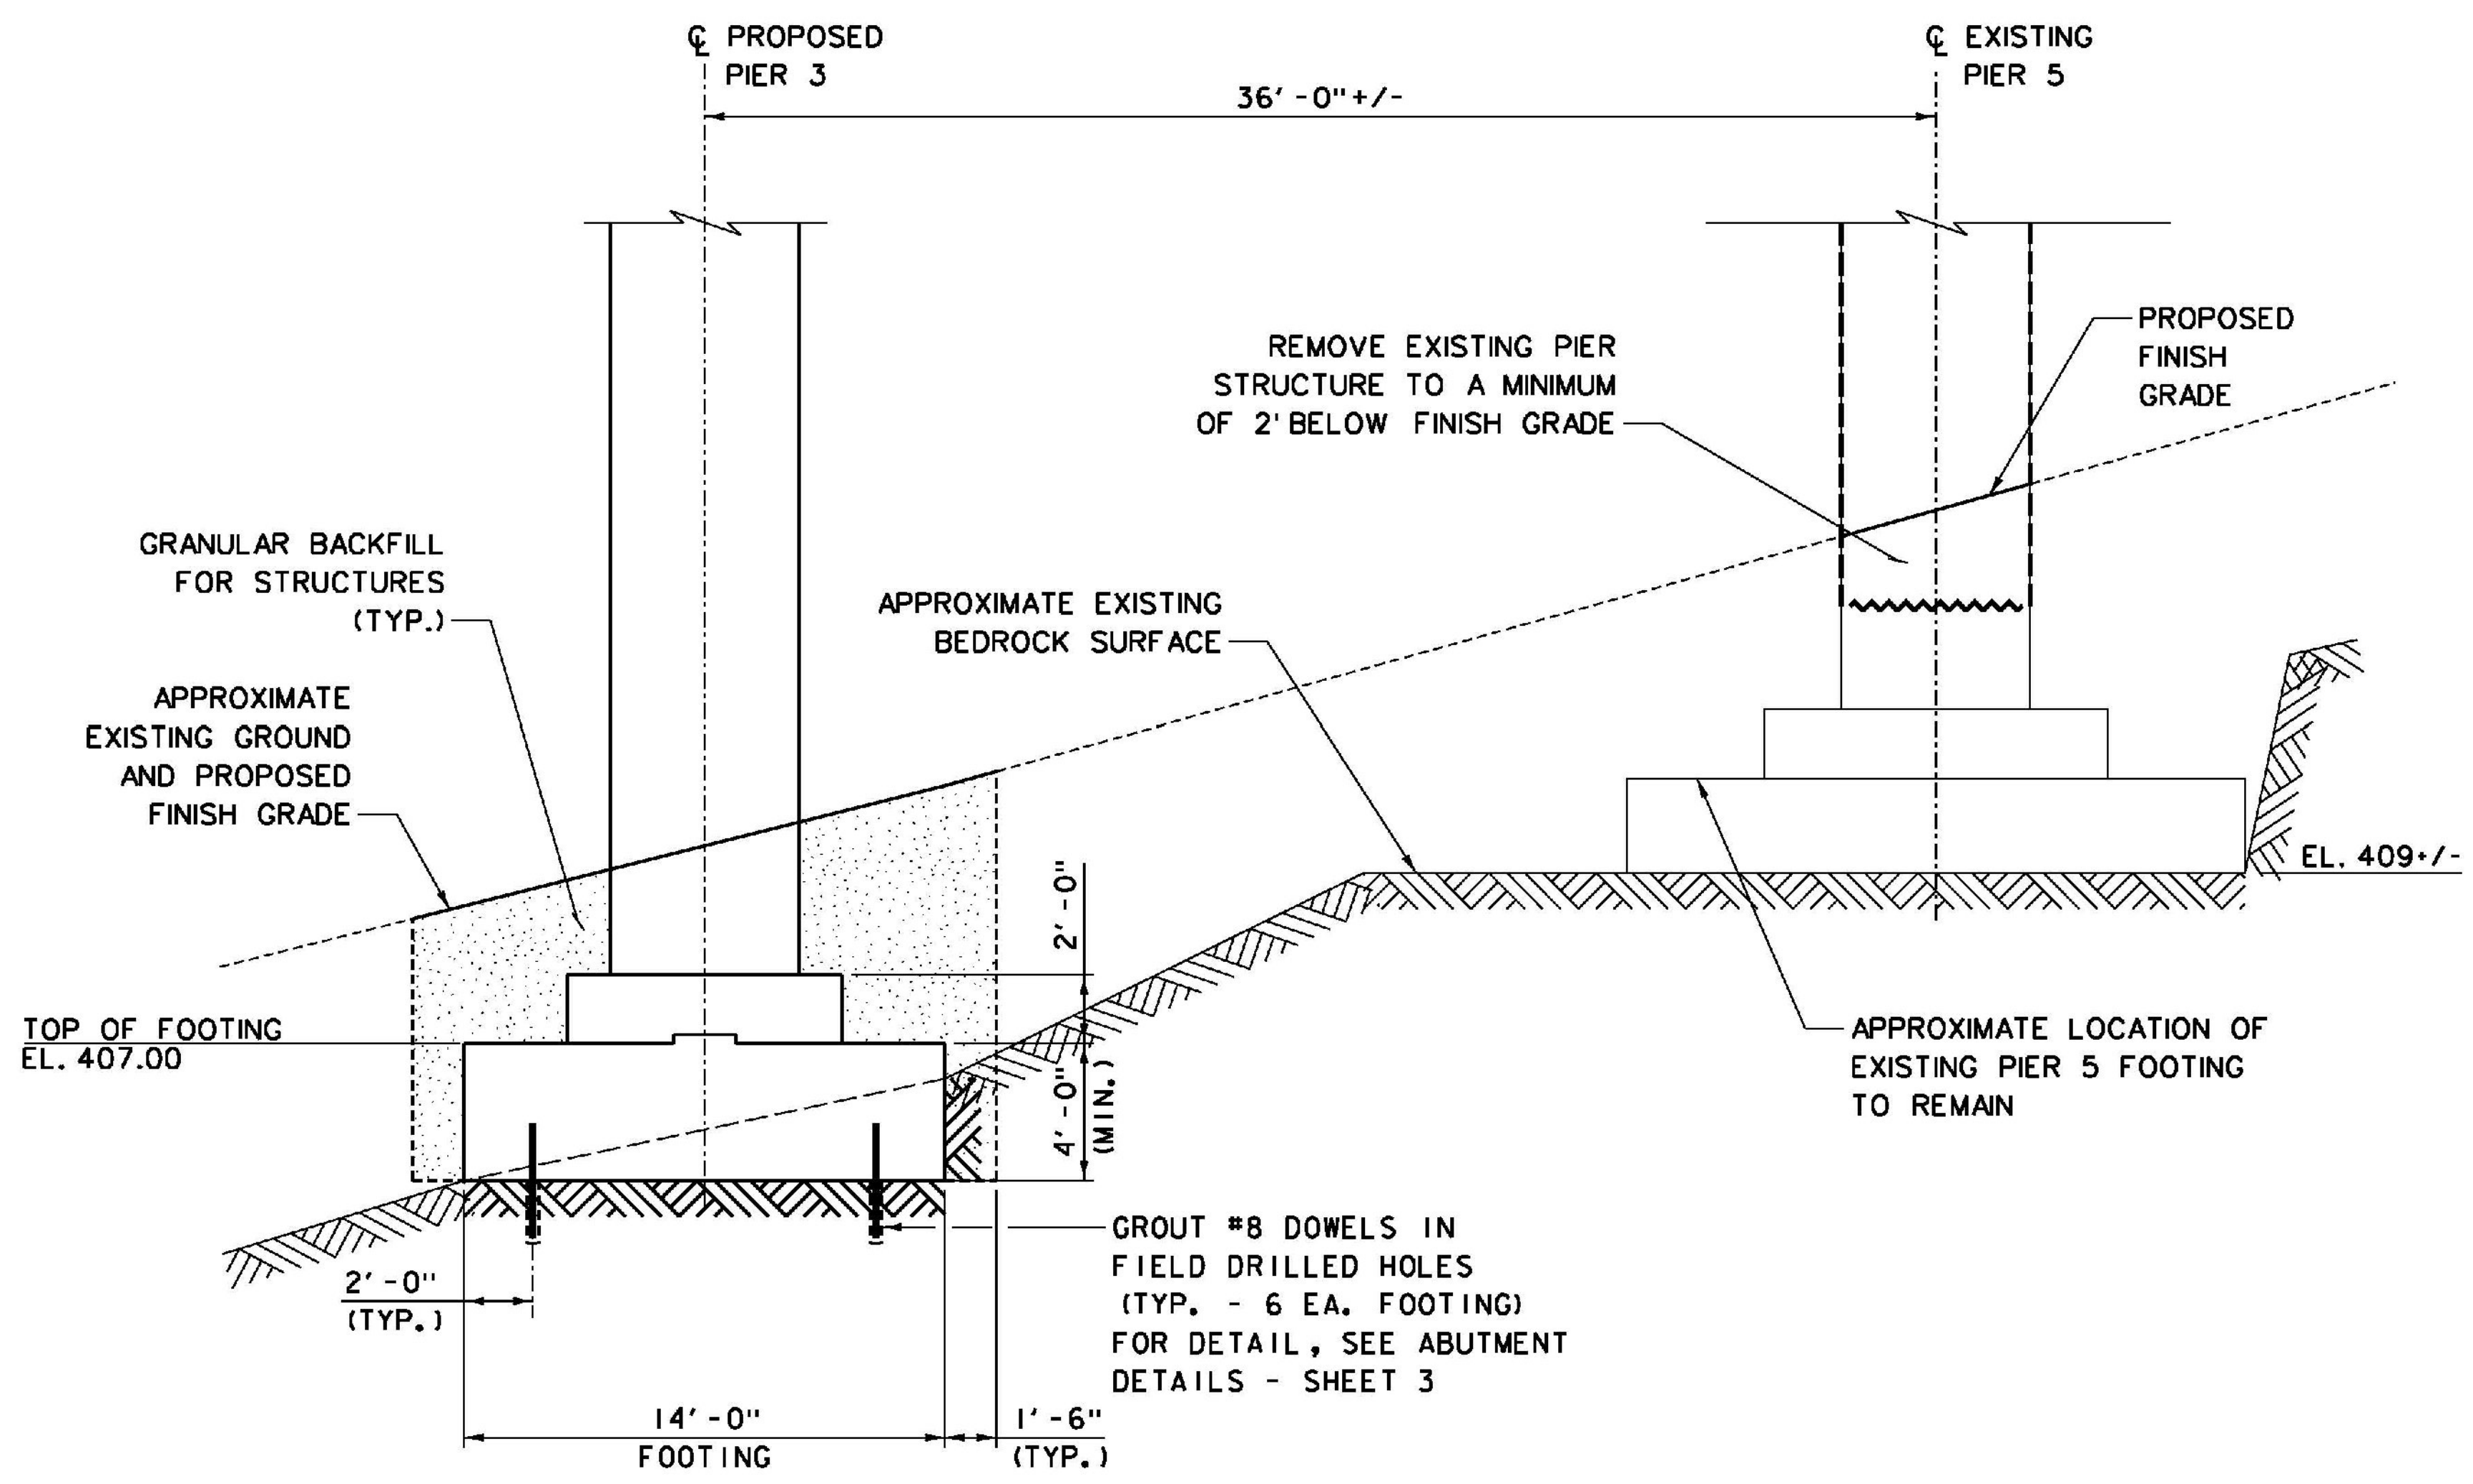

PIER 3 FOOTING SECTION (AT CL COLUMN 3E)

SCALE 1/4" = 1'-0"
1 0 2 4 6

| ITEMS USED ON THIS SHEET | |
|--------------------------|------------------------------------|
| ITEM NO. | DESCRIPTION |
| 204.25 | STRUCTURE EXCAVATION |
| 204.30 | GRANULAR BACKFILL FOR STRUCTURES |
| 501.34 | CONCRETE, HIGH PERFORMANCE CLASS B |
| 507.16 | DRILLING AND GROUTING DOWELS |
| 529.15 | REMOVAL OF STRUCTURE |
| 651.15 | SEED |
| 651.25 | HAY MULCH |
| 651.35 | TOPSOIL |

NOTE:
1. EMBANKMENT AREAS DISTURBED BY CONSTRUCTION SHALL BE RESTORED UPON COMPLETION OF THE WORK BY INSTALLING TOPSOIL, SEED AND HAY MULCH.

| | |
|------------------------------|-------------------------|
| PROJECT NAME: WINDSOR | PLOT DATE: 7/30/2015 |
| PROJECT NUMBER: IM 091-1(64) | DRAWN BY: S. GUNN |
| FILE NAME: z10o188Pier3P.dgn | CHECKED BY: S. HALLORAN |
| PROJECT LEADER: J. WILSON | SHEET 108 OF 156 |
| DESIGNED BY: S. BOYINGTON | |