




TYPICAL VERTICAL CONSTRUCTION JOINT

NOT TO SCALE

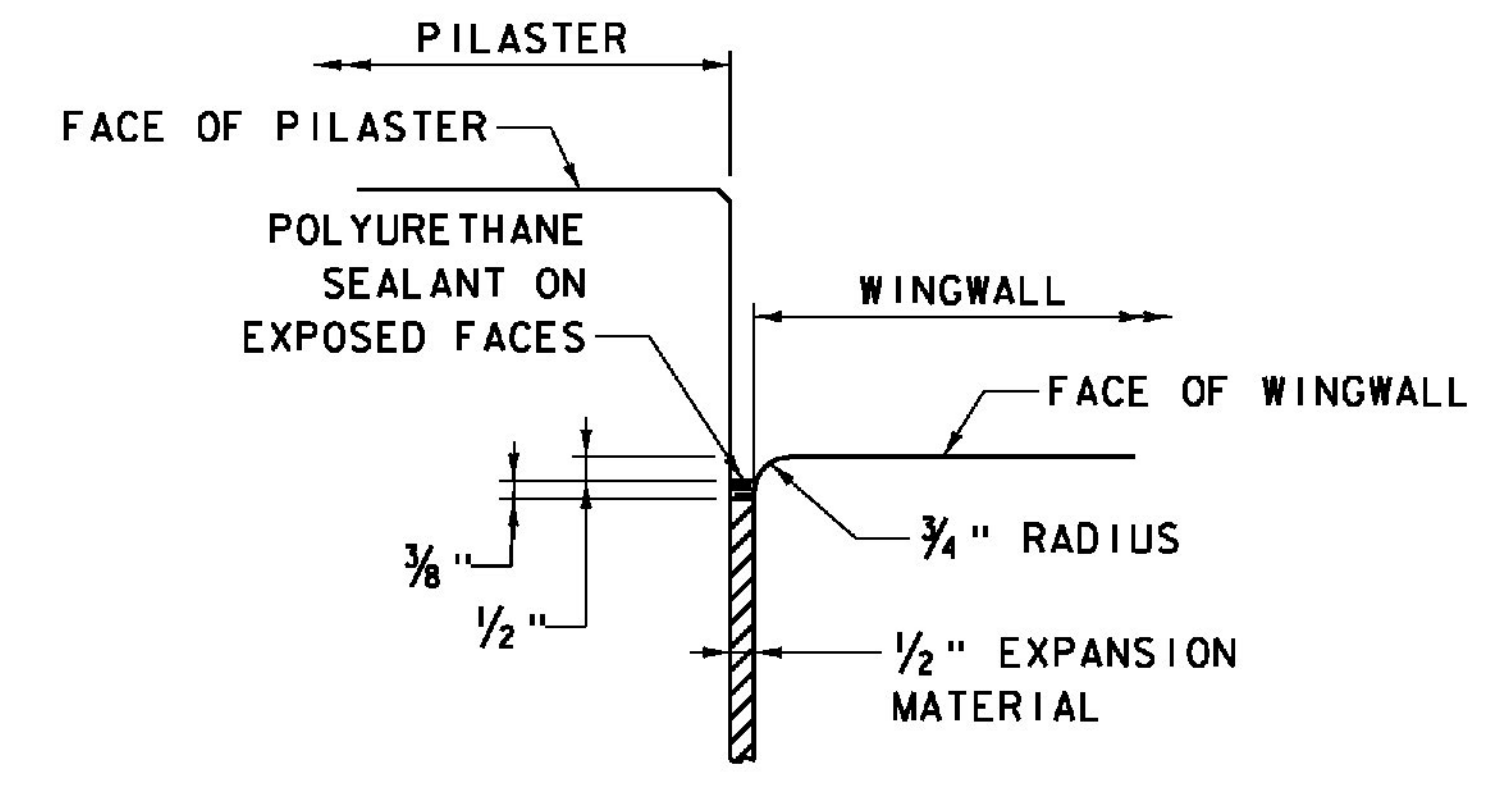

JOINT BETWEEN PILASTER AND WINGWALL


NOT TO SCALE

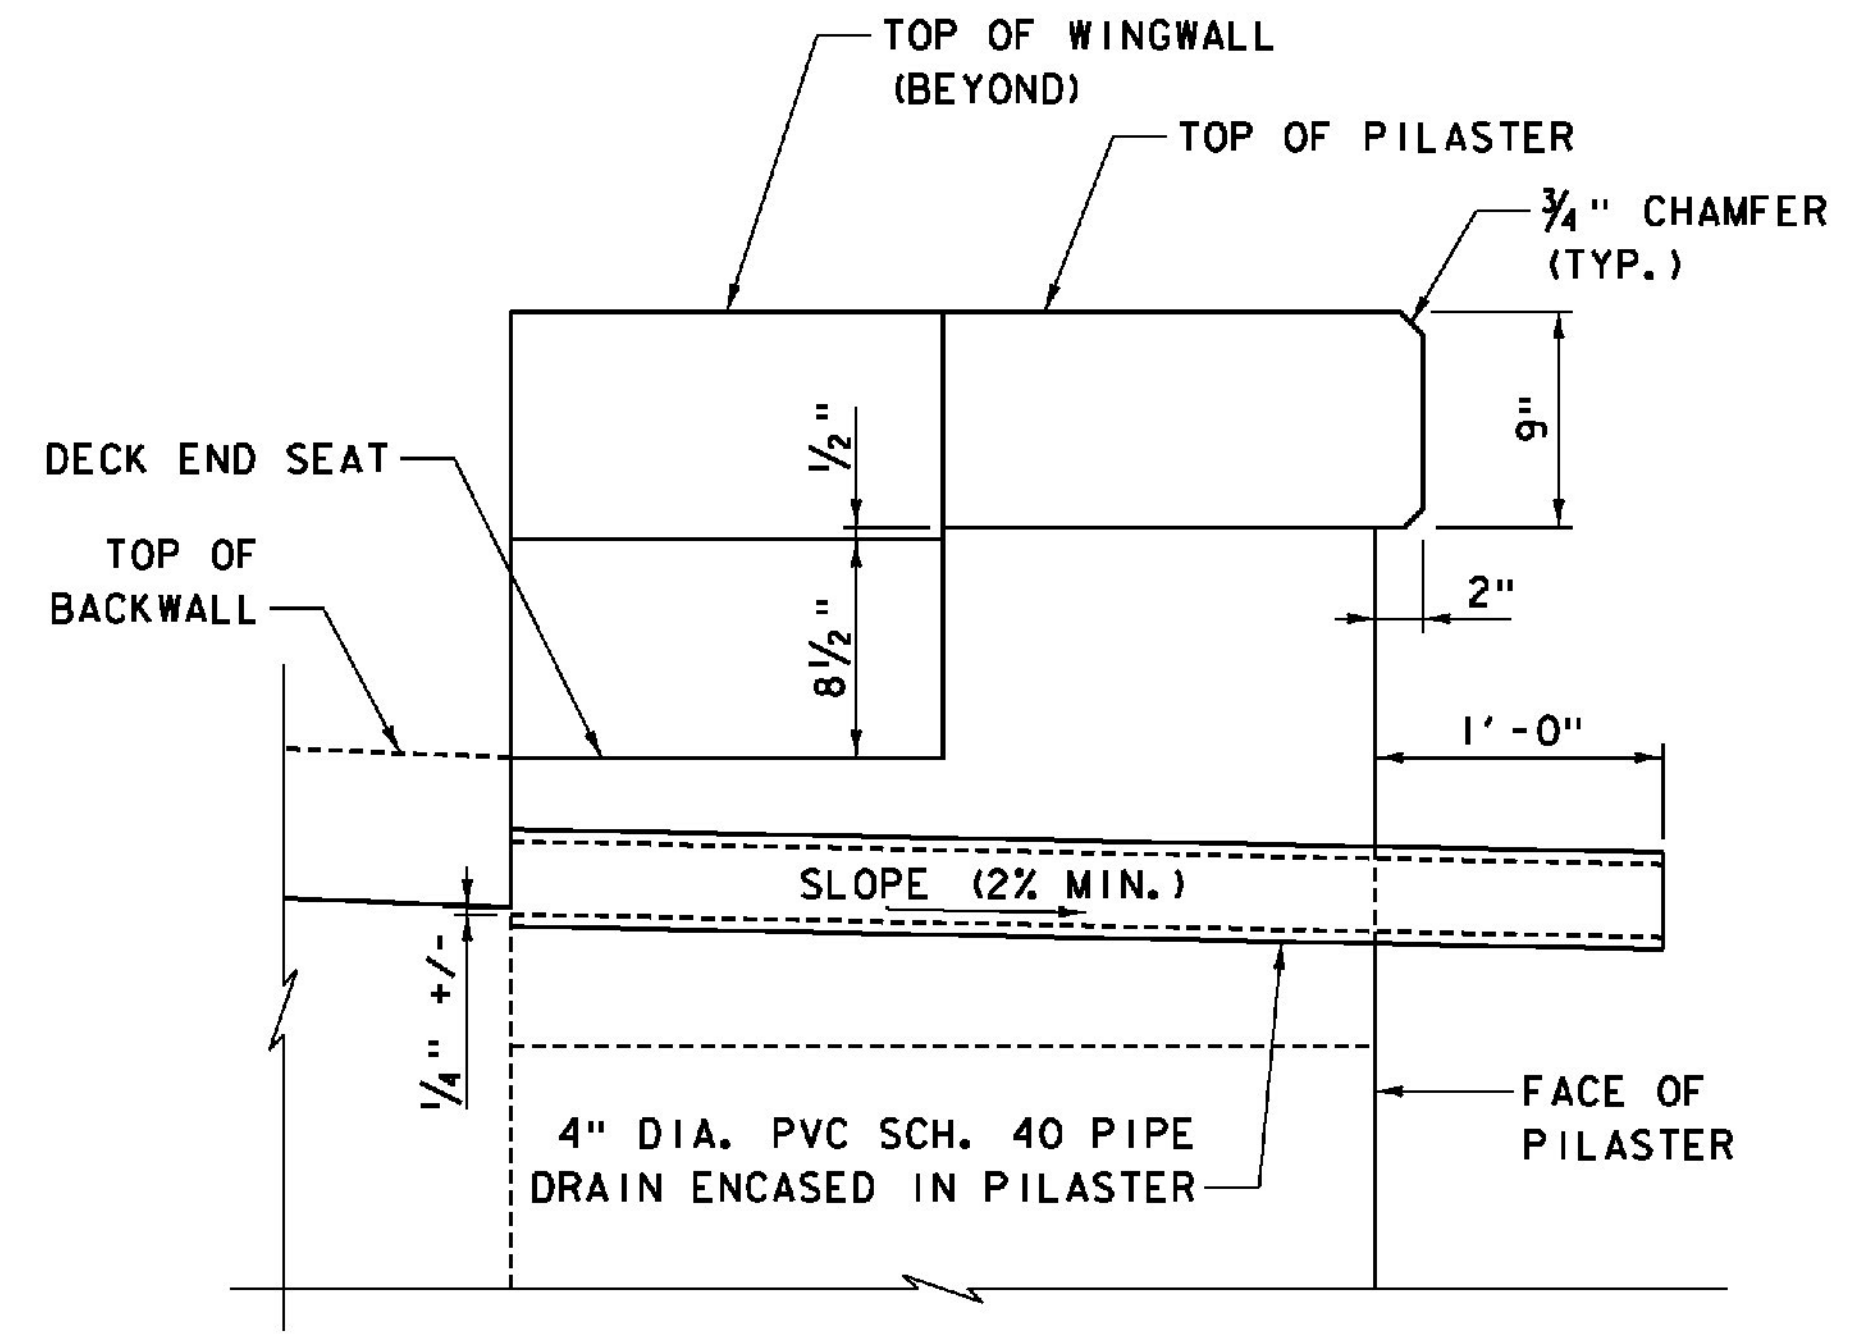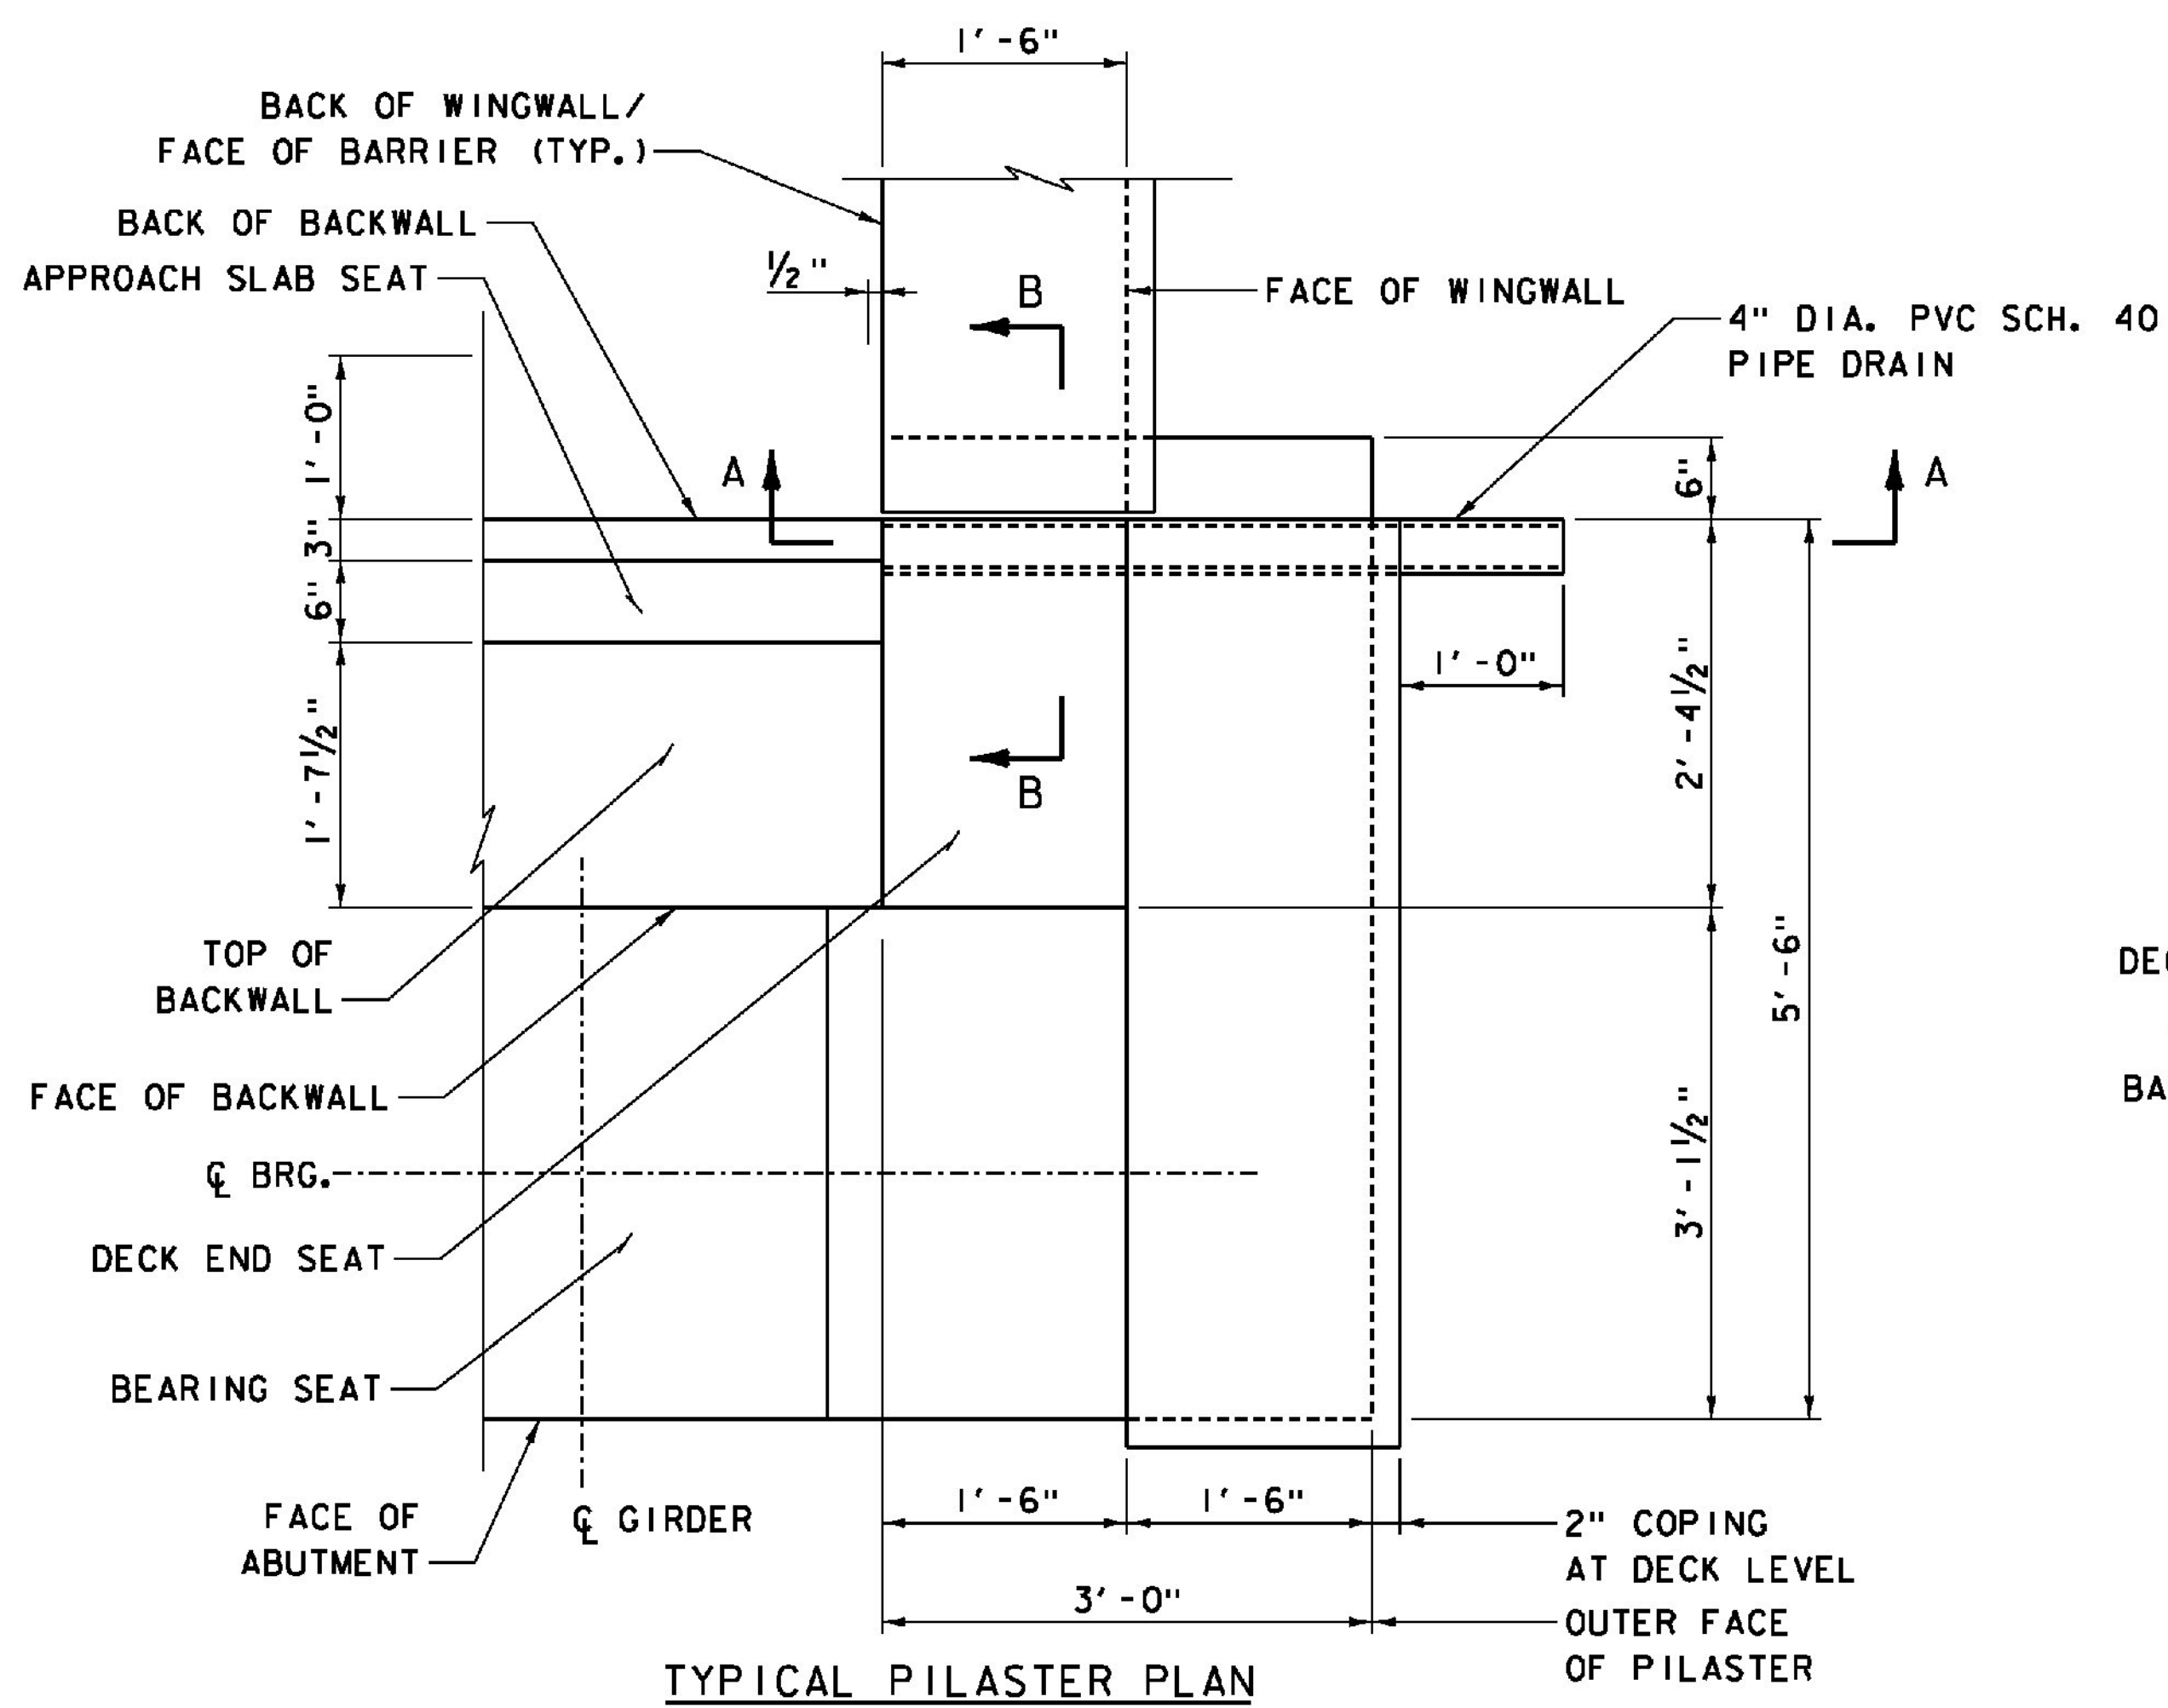

SECTION A-A

SCALE 1 1/2" = 1'-0"

1 9 6 3 0 1

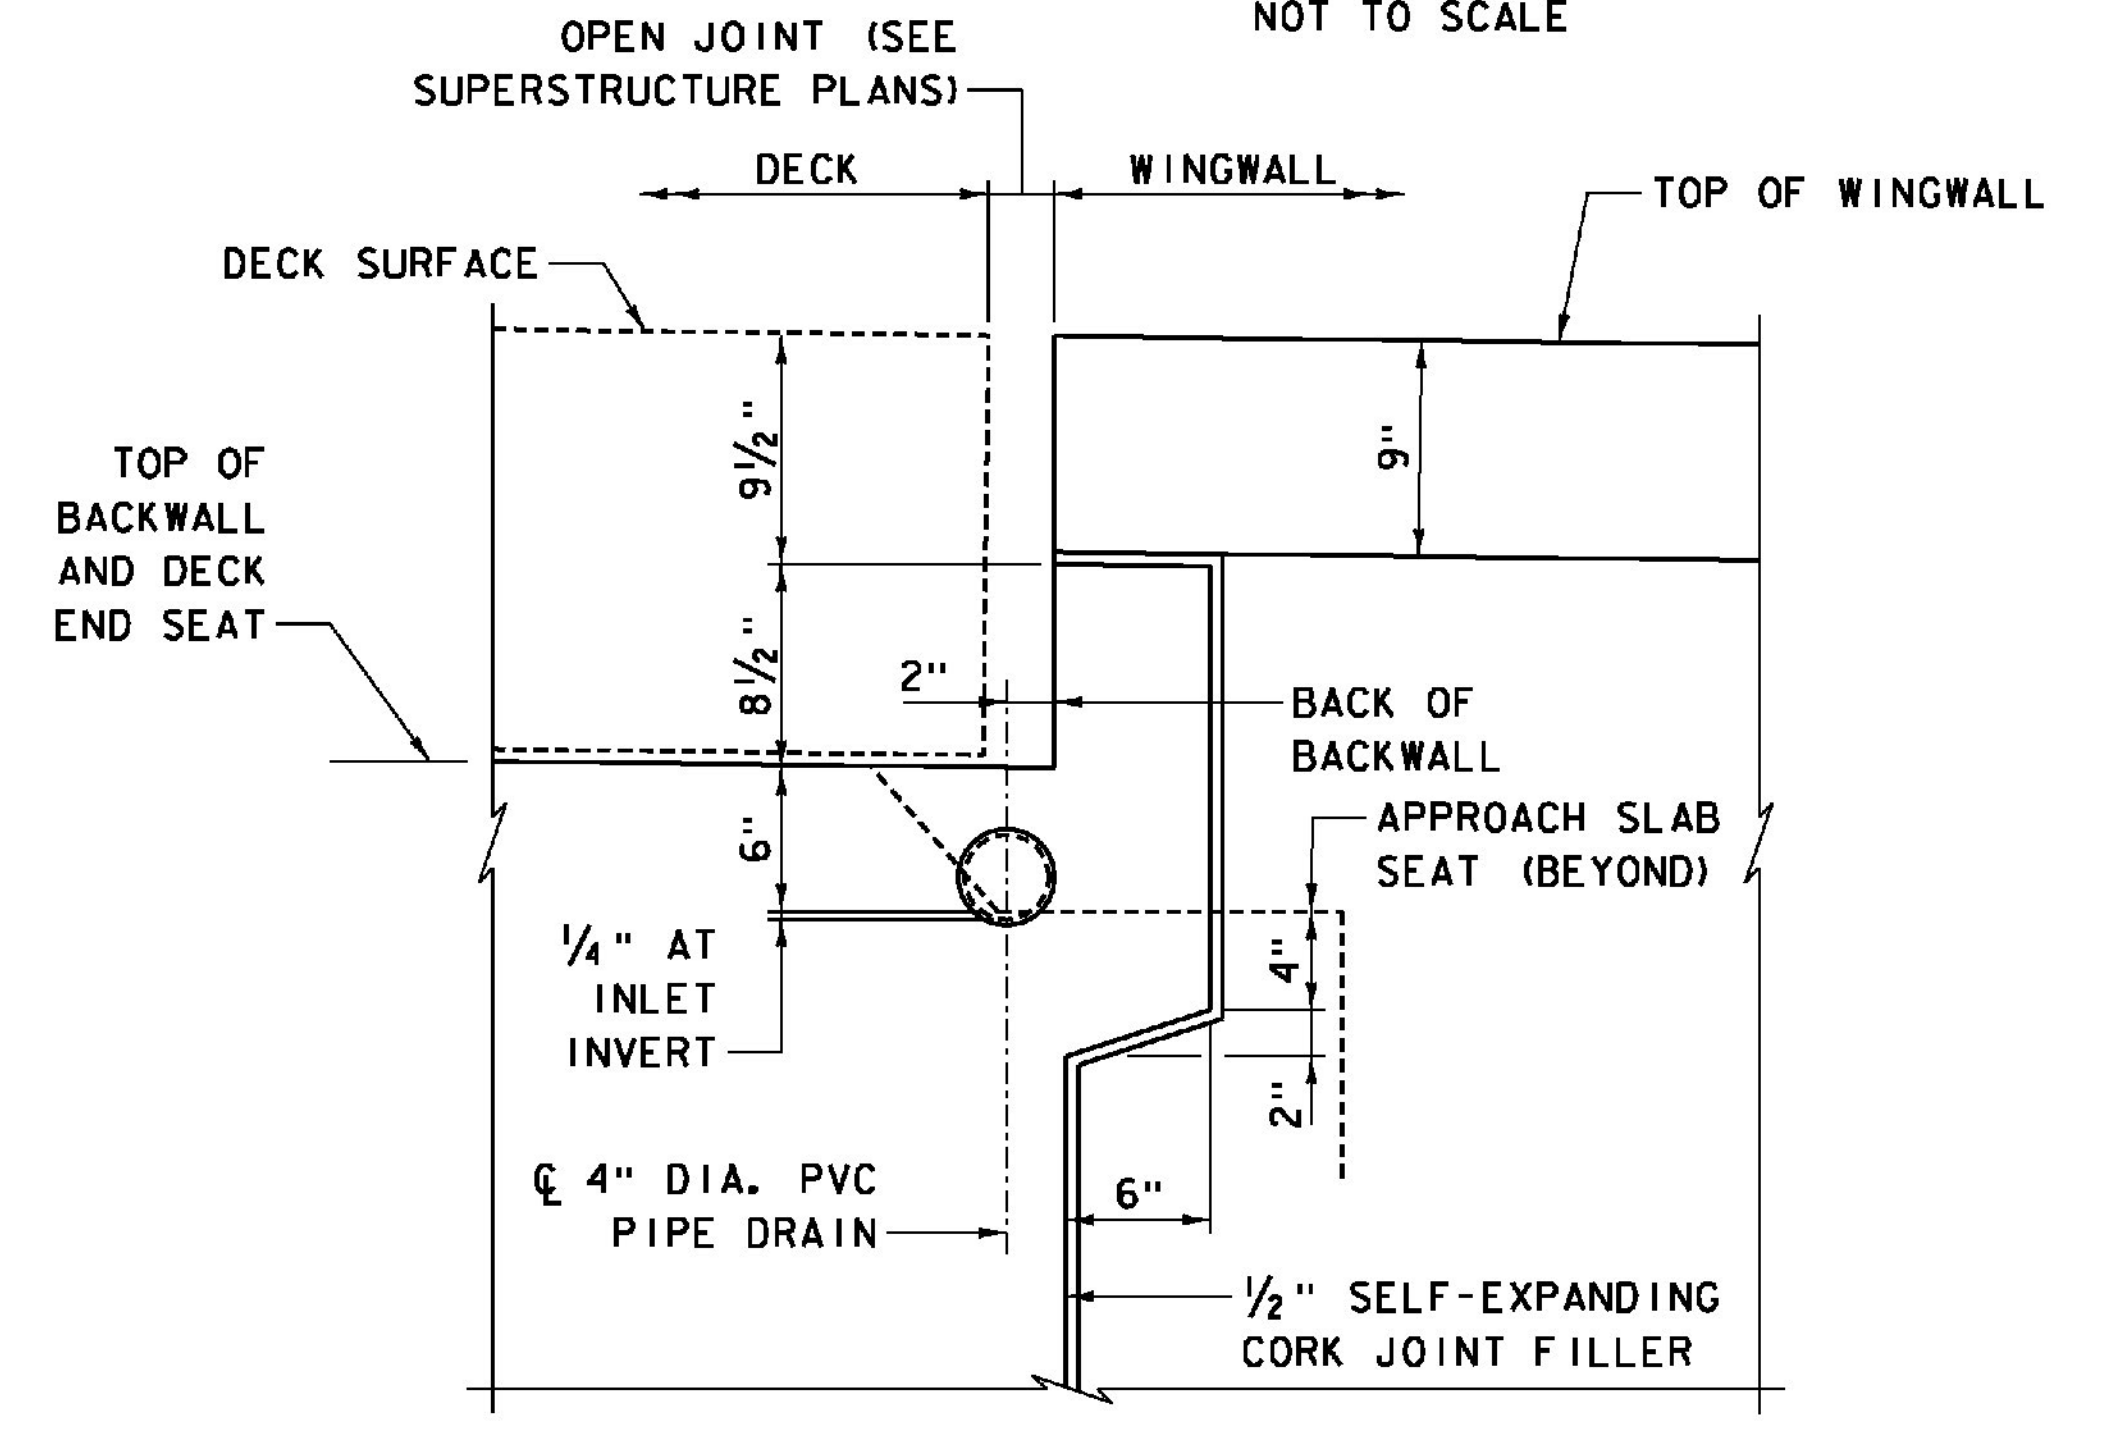

SECTION B-B

SCALE 1 1/2" = 1'-0"

1 9 6 3 0 1

| | | |
|------------------------------|-------------------------------|-------------------------|
| PROJECT NAME: WINDSOR | FILE NAME: z10o188AD1.dgn | PLOT DATE: 7/30/2015 |
| PROJECT NUMBER: IM 091-1(64) | PROJECT LEADER: J. WILSON | DRAWN BY: S. GUNN |
| | DESIGNED BY: S. BOYINGTON | CHECKED BY: S. HALLORAN |
| | SB ABUTMENT DETAILS - SHEET 1 | SHEET 111 OF 156 |