


ABUTMENT 4 PLAN  
SCALE 1/4" = 1'-0"  
1 0 2 4 6

ITEMS USED ON THIS SHEET	
ITEM NO.	DESCRIPTION
507.15	REINFORCING STEEL
507.17	EPOXY COATED REINFORCING STEEL
501.34	CONCRETE, HIGH PERFORMANCE CLASS B
507.16	DRILLING AND GROUTING DOWELS

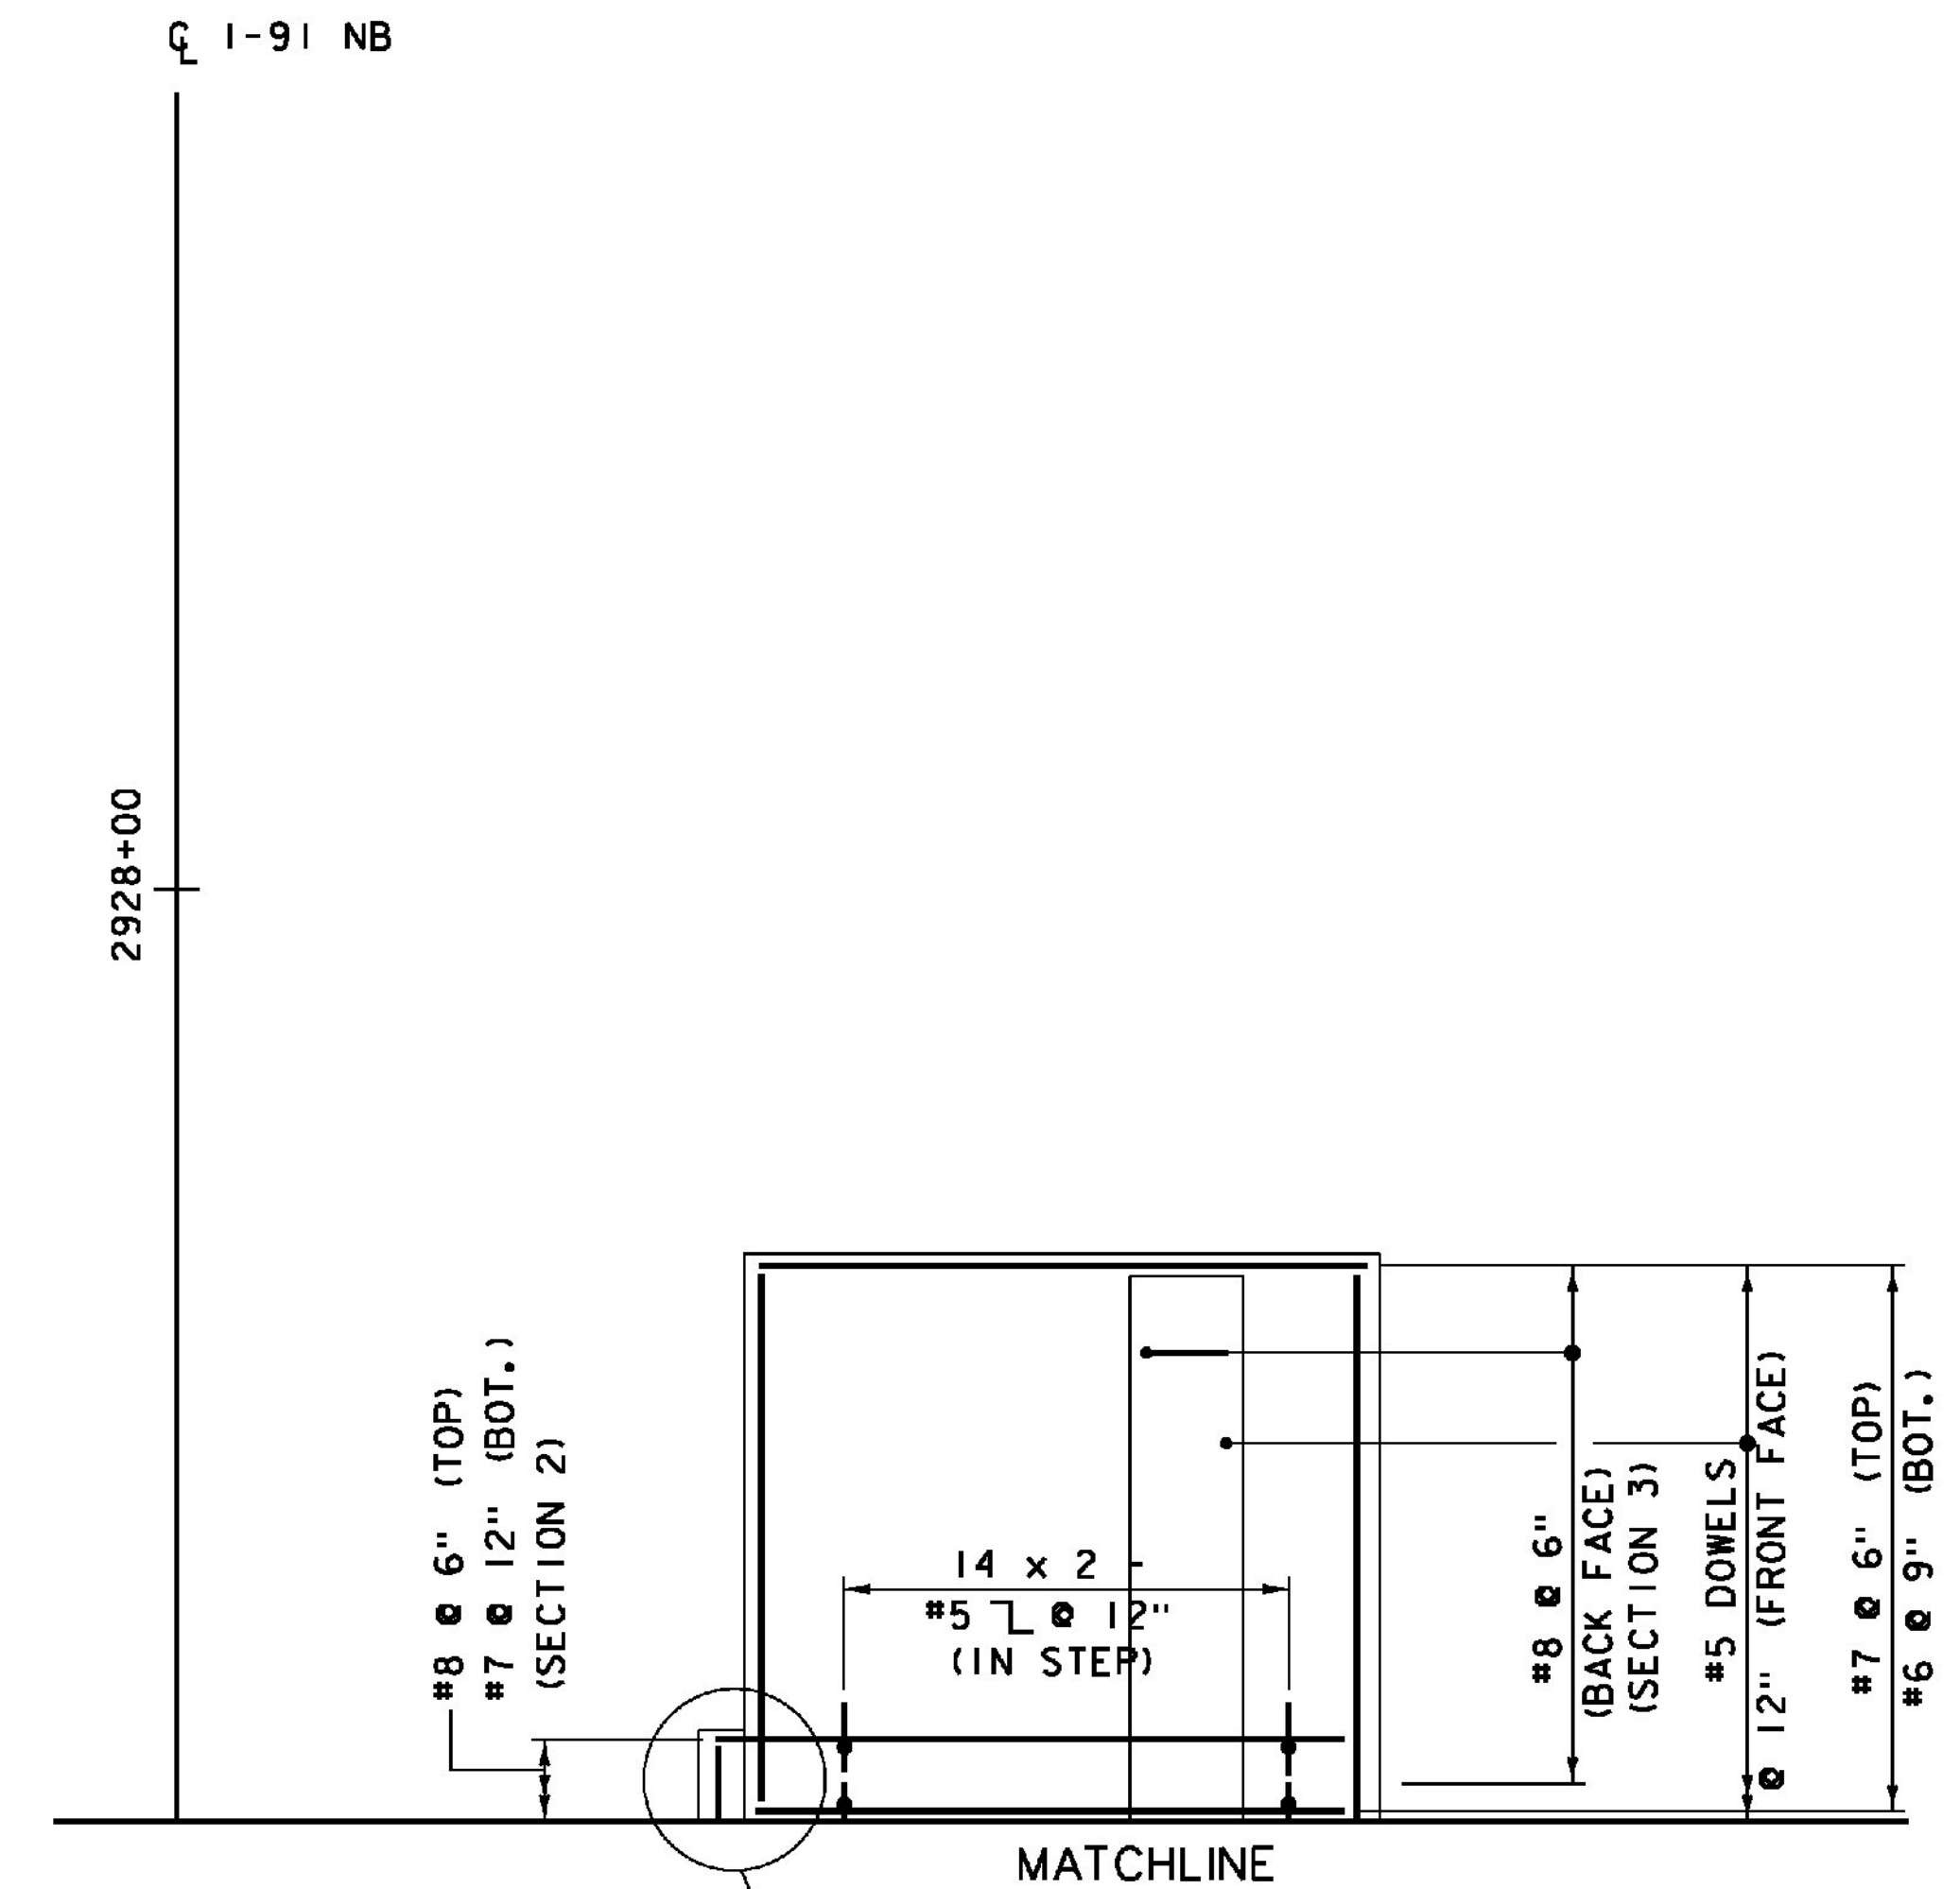

REMOVE SMALL AMOUNT OF LEDGE SO FOOTING SEGMENT 2 CAN BE PLACED FULL LENGTH WITH LEDGE EL. 465.00 OR LOWER

**NOTES:**

- DRILL AND GROUT #5 DOWELS IN PREPARED BEDROCK SURFACE SPACED AT 2'-0" AT FACE OF UNREINFORCED FOOTING CONCRETE WITH A DEPTH GREATER THAN 2'-0". SPLICE #5 L AS SHOWN ON ABUTMENT AND WINGWALL REINFORCING DETAILS.

PROJECT NAME: WINDSOR	FILE NAME: z10a188Abut4RP.dgn	PLOT DATE: 7/30/2015
PROJECT NUMBER: IM 091-1(64)	PROJECT LEADER: J. WILSON	DRAWN BY: S. GUNN
	DESIGNED BY: S. BOYINGTON	CHECKED BY: S. HALLORAN
	ABUT. 4 REINFORCEMENT - SHEET 1	SHEET 130 OF 156