
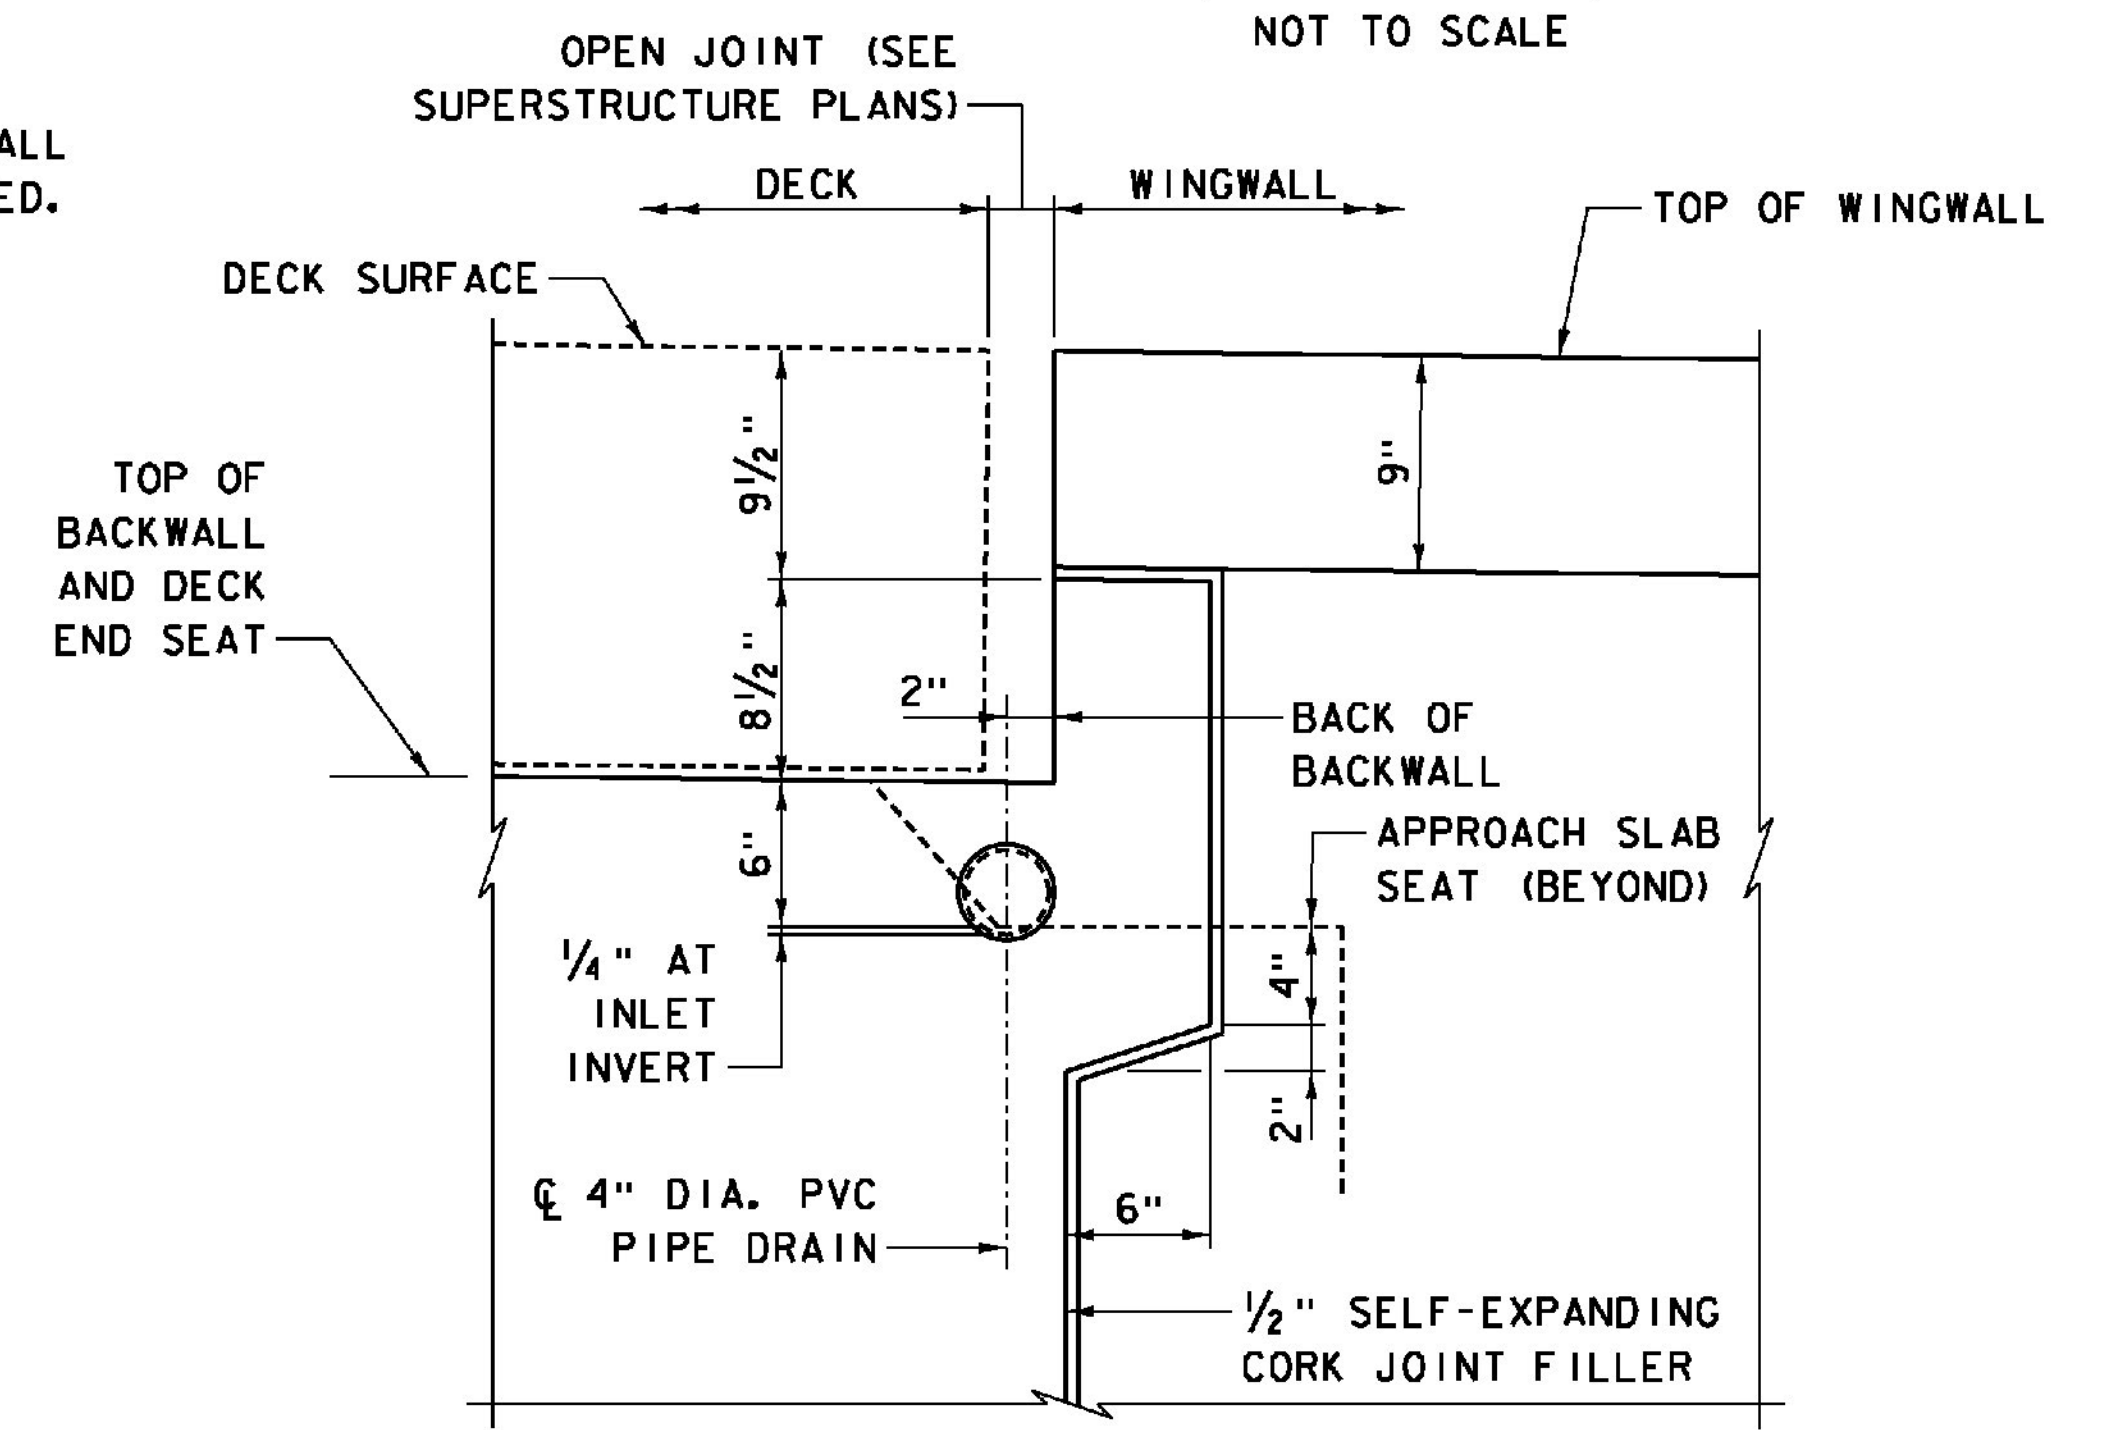
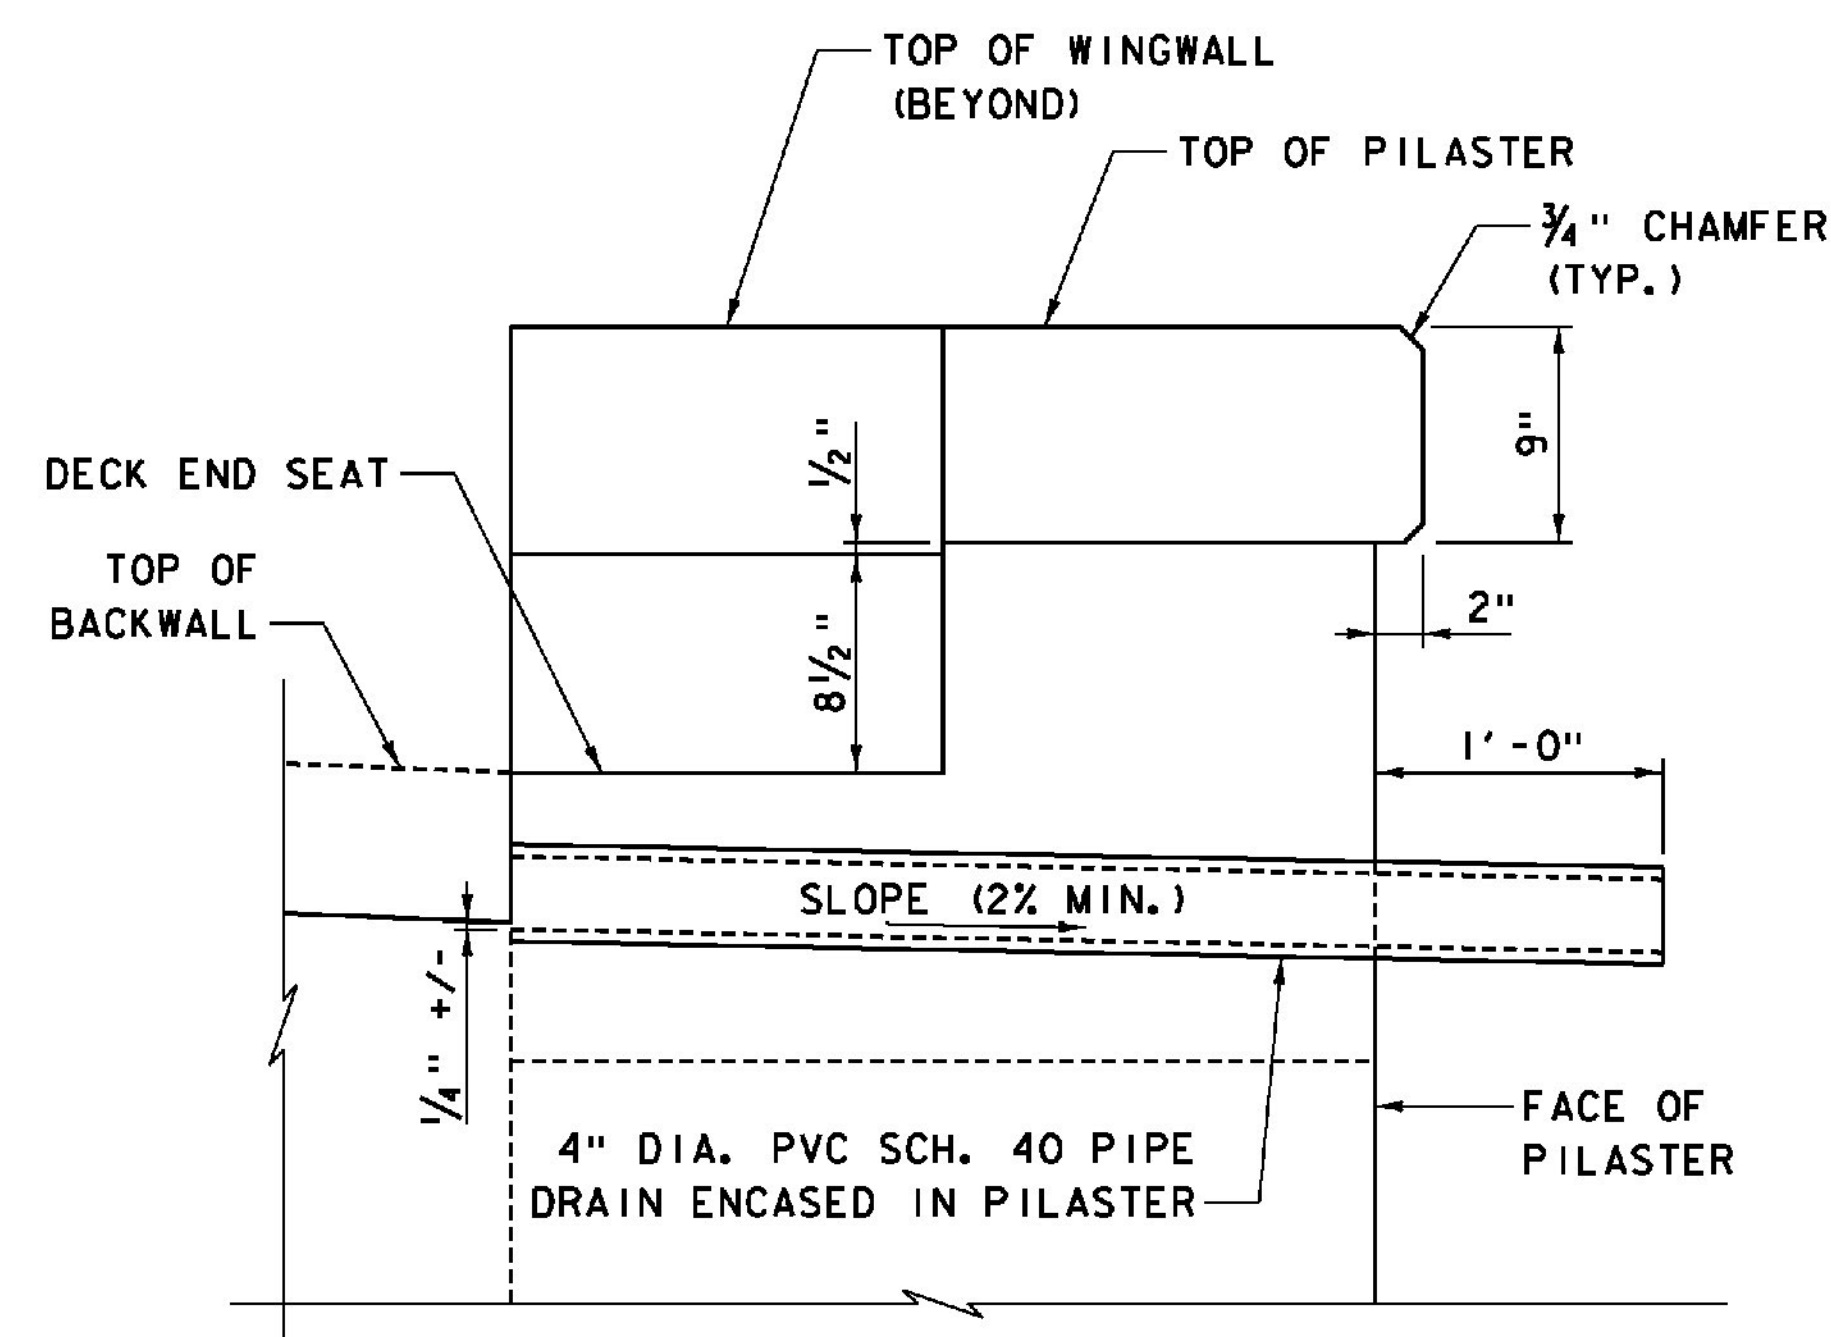


1. THE SURFACE OF THE CONCRETE CONSTRUCTION JOINTS SHALL BE CLEANED AND FREE OF LAITANCE.
2. IMMEDIATELY BEFORE NEW CONCRETE IS PLACED, ALL CONSTRUCTION JOINTS SHALL BE WETTED AND STANDING WATER REMOVED.

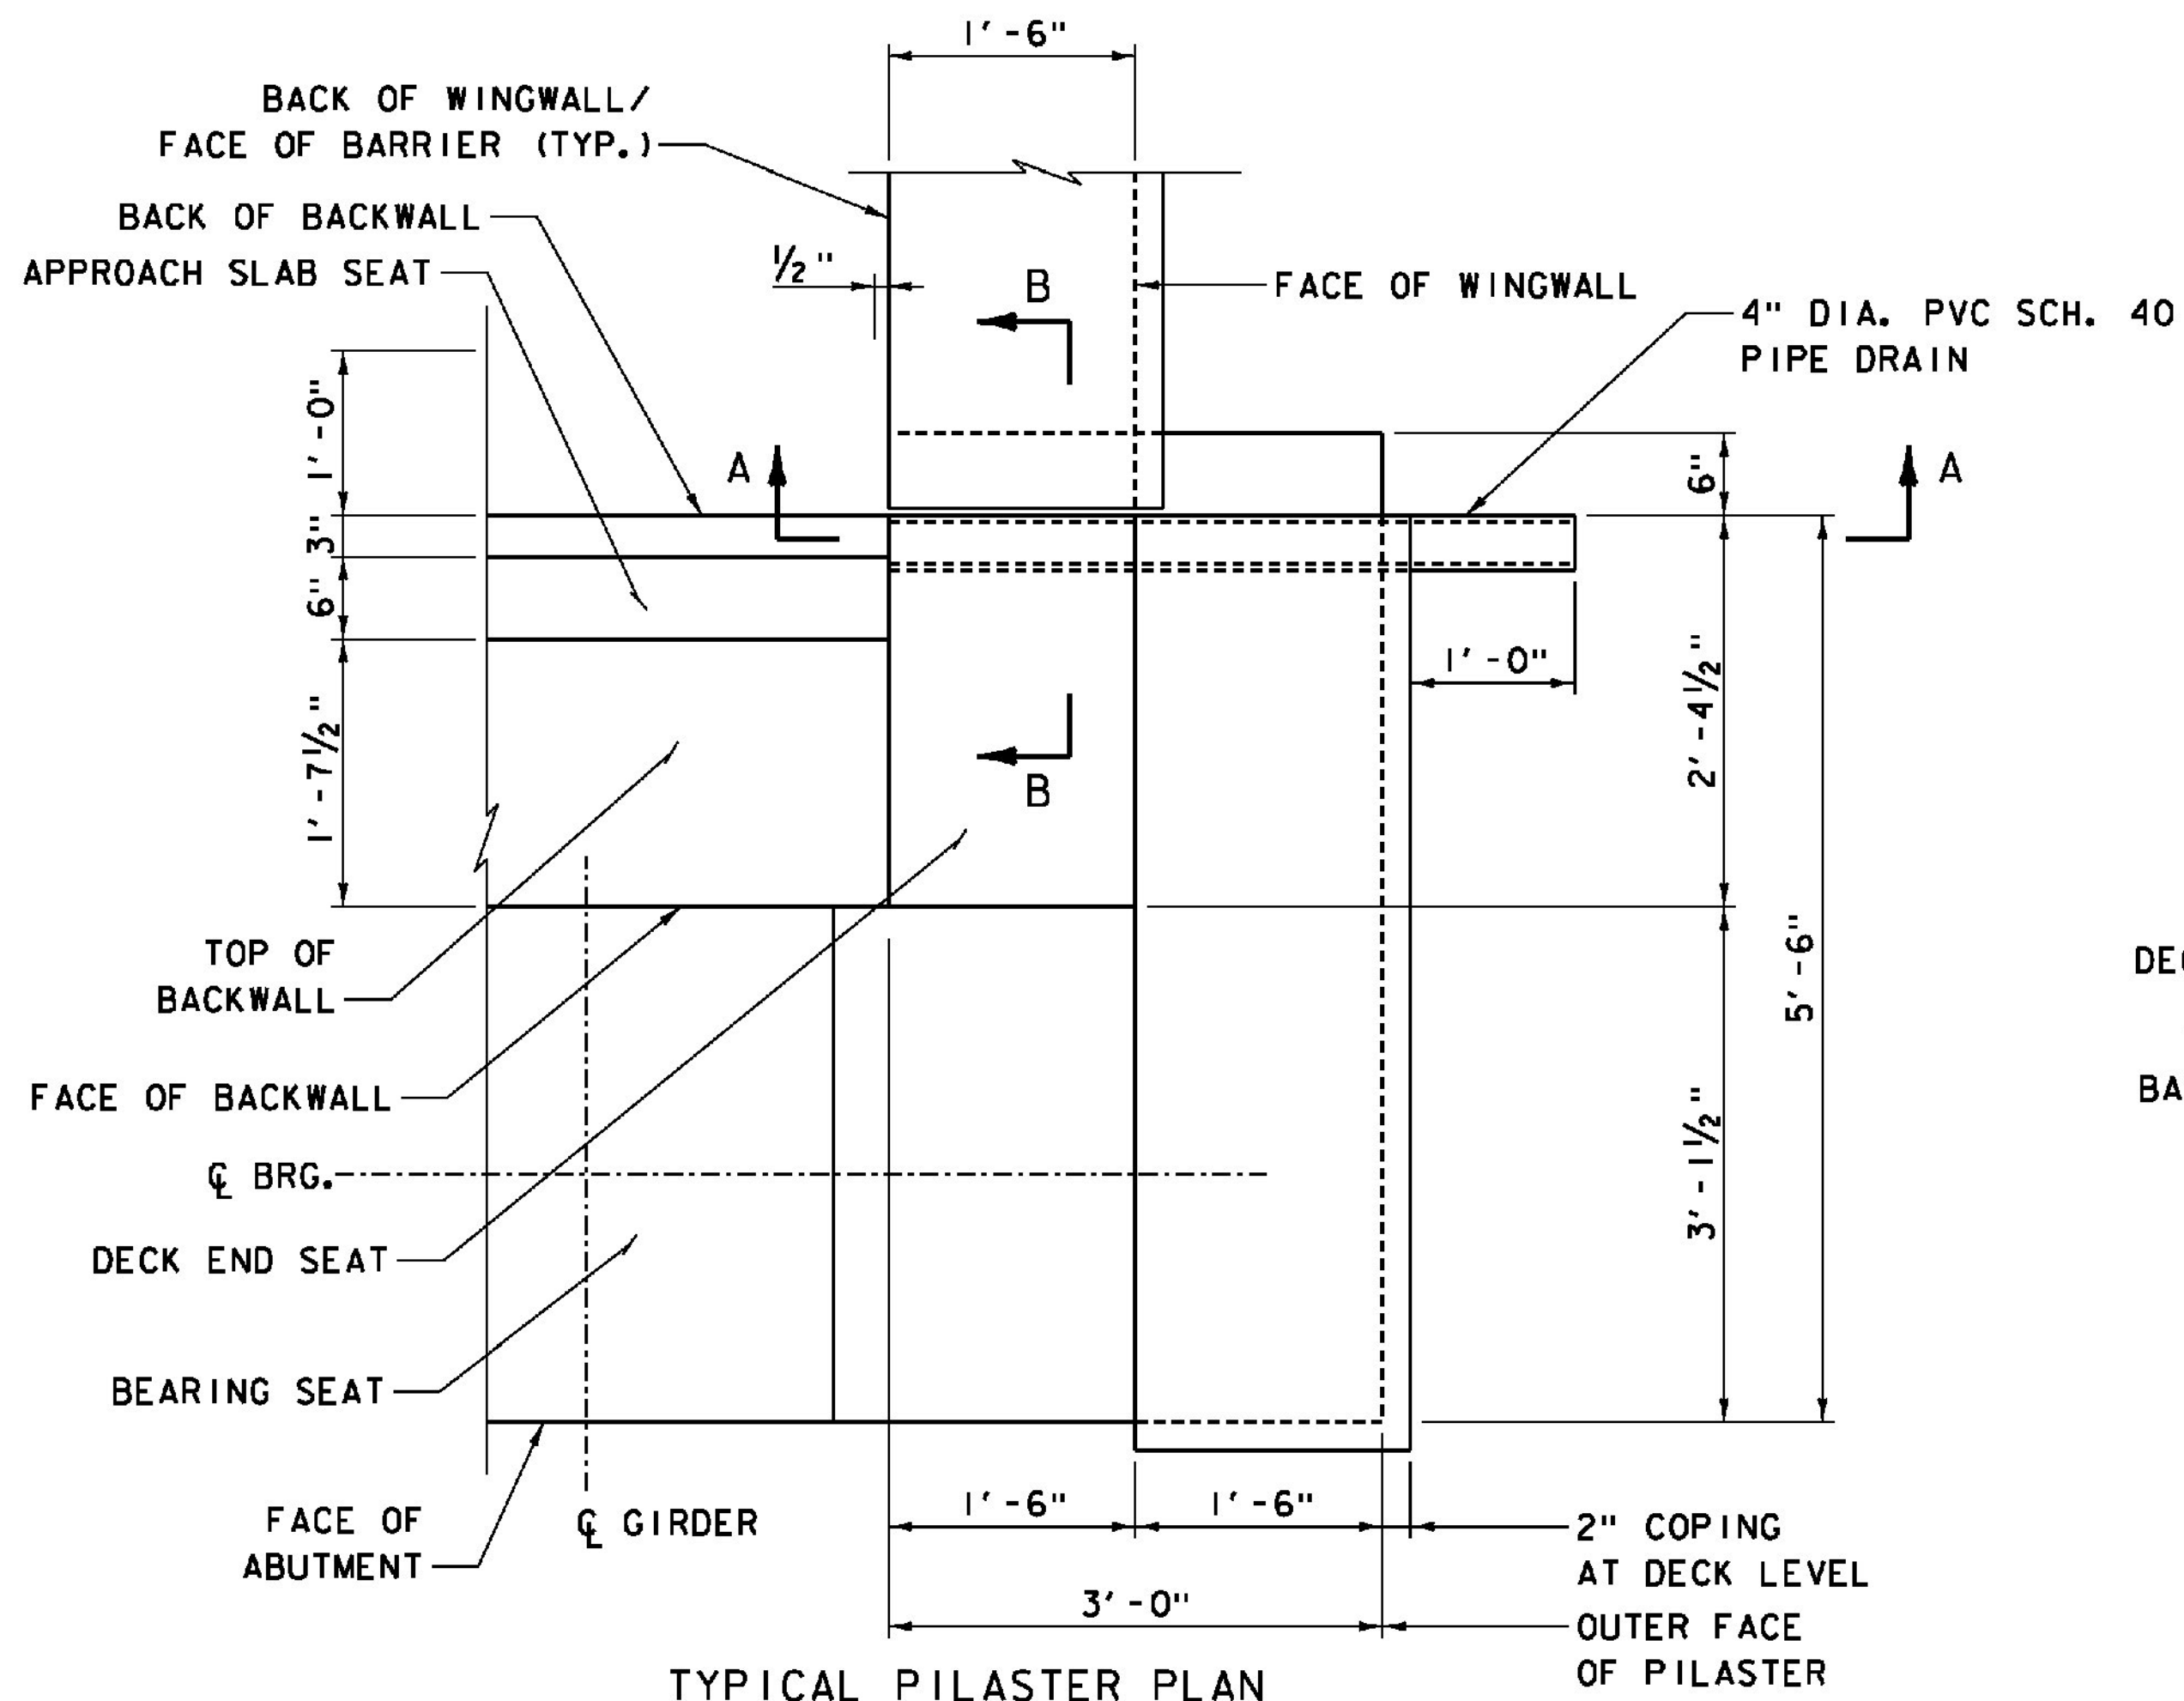

PROJECT NAME: WINDSOR	FILE NAME: z10o188AD1.dgn	PLOT DATE: 7/30/2015
PROJECT NUMBER: IM 091-1(64)	PROJECT LEADER: J. WILSON	DRAWN BY: S. GUNN
	DESIGNED BY: S. BOYINGTON	CHECKED BY: S. HALLORAN
	NB ABUTMENT DETAILS - SHEET 1	SHEET 143 OF 156