




1918+50

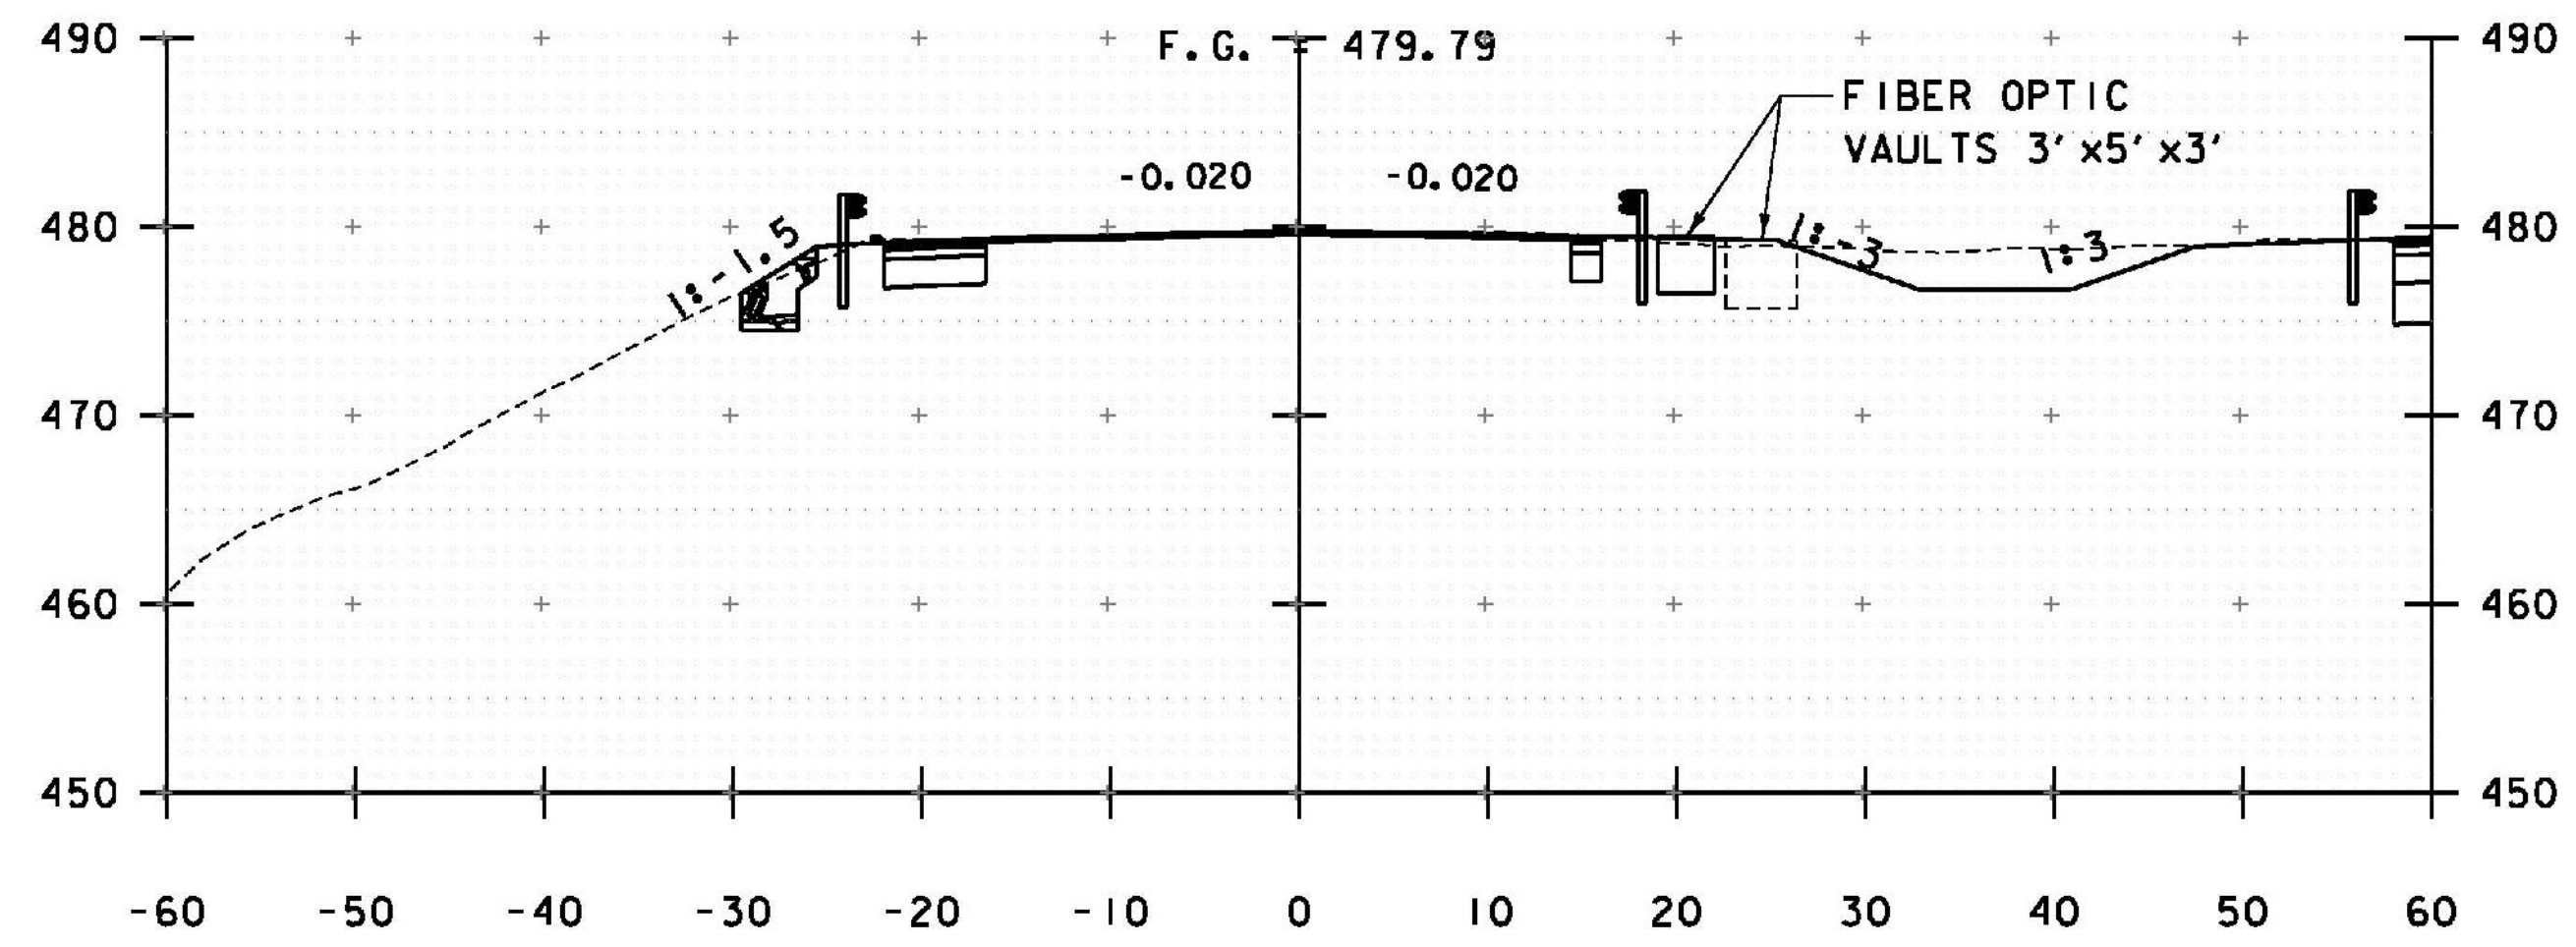


1920+00

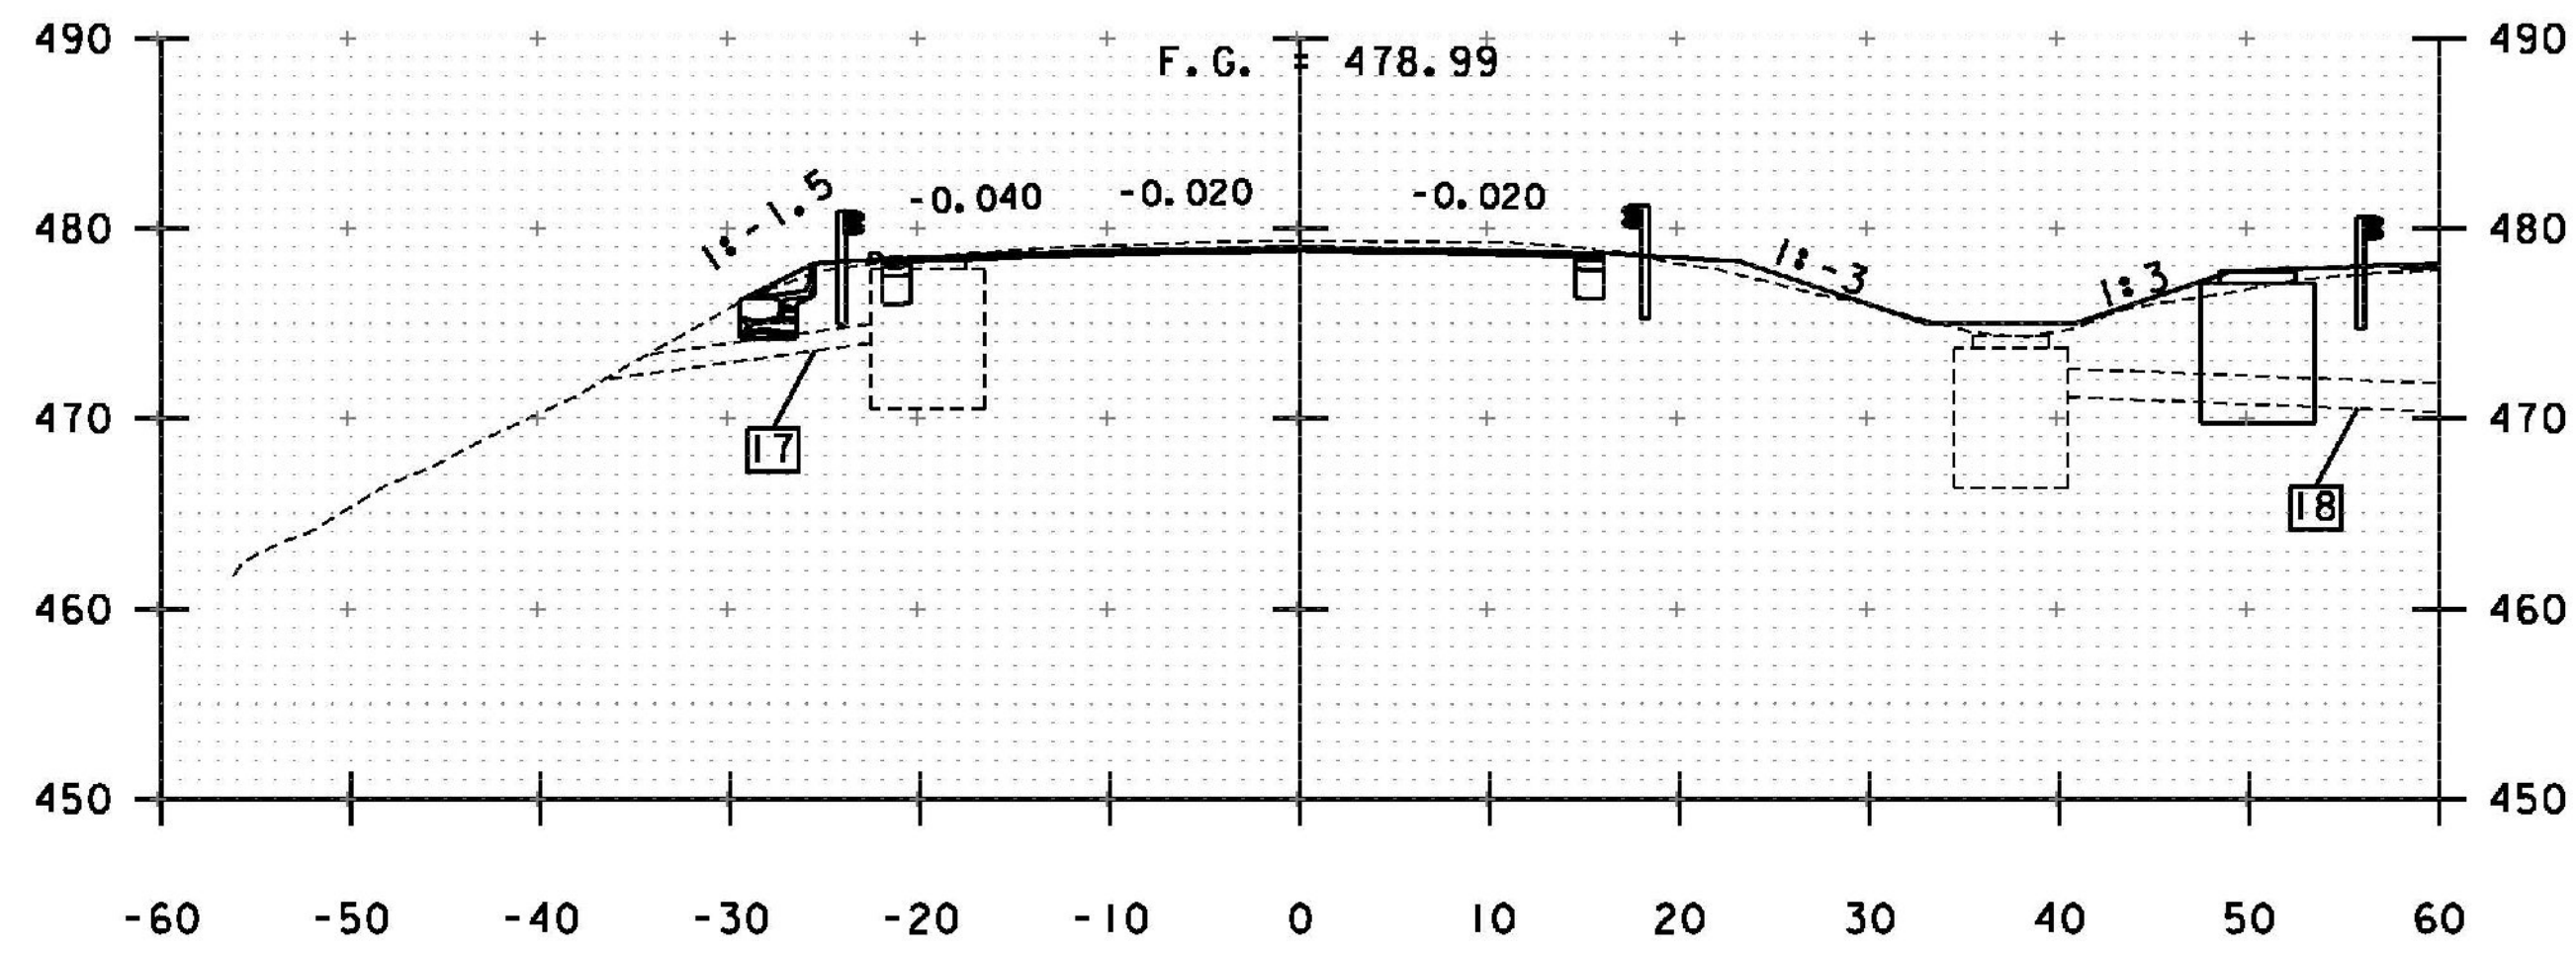


1918+20

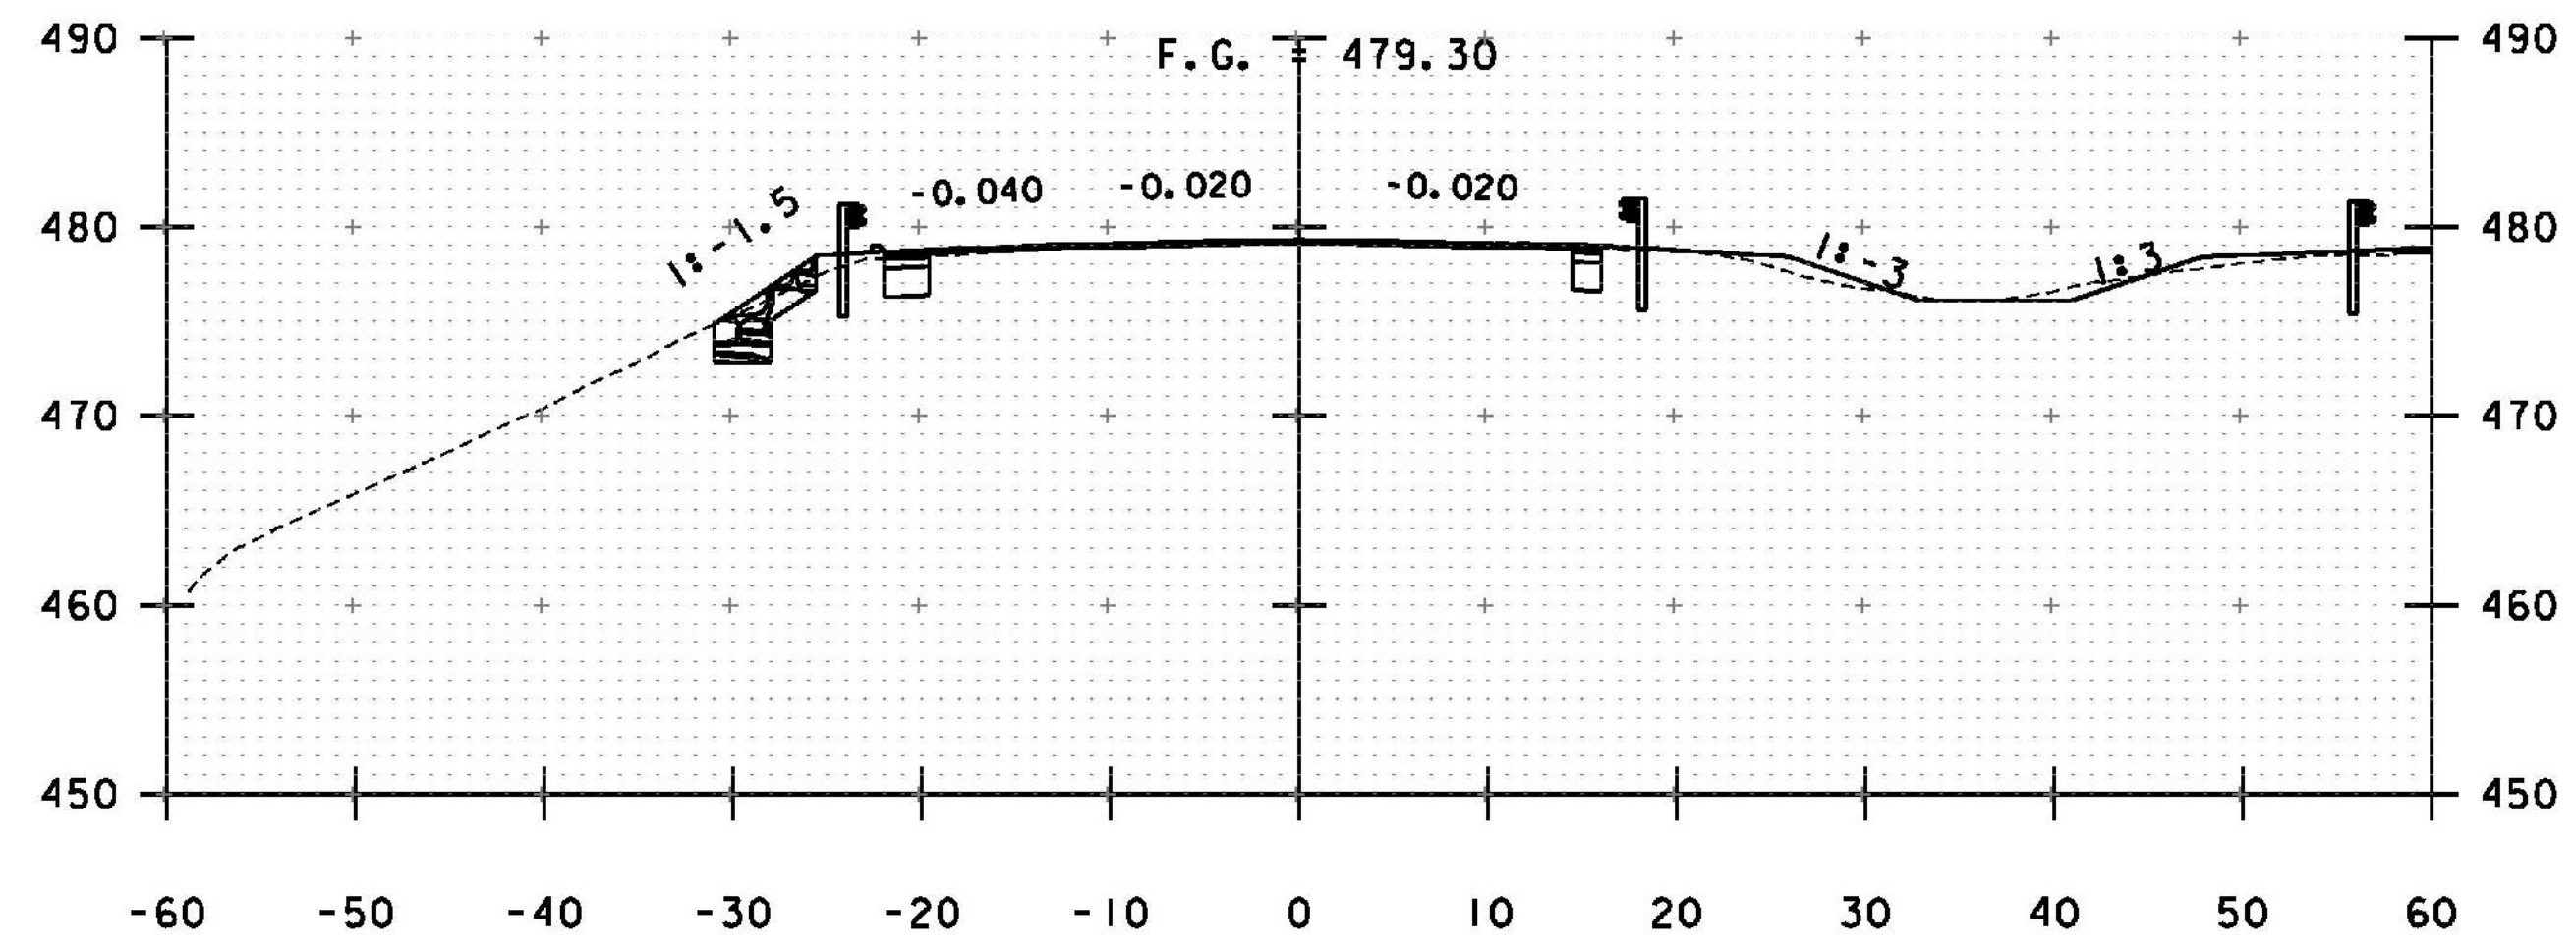

1919+50

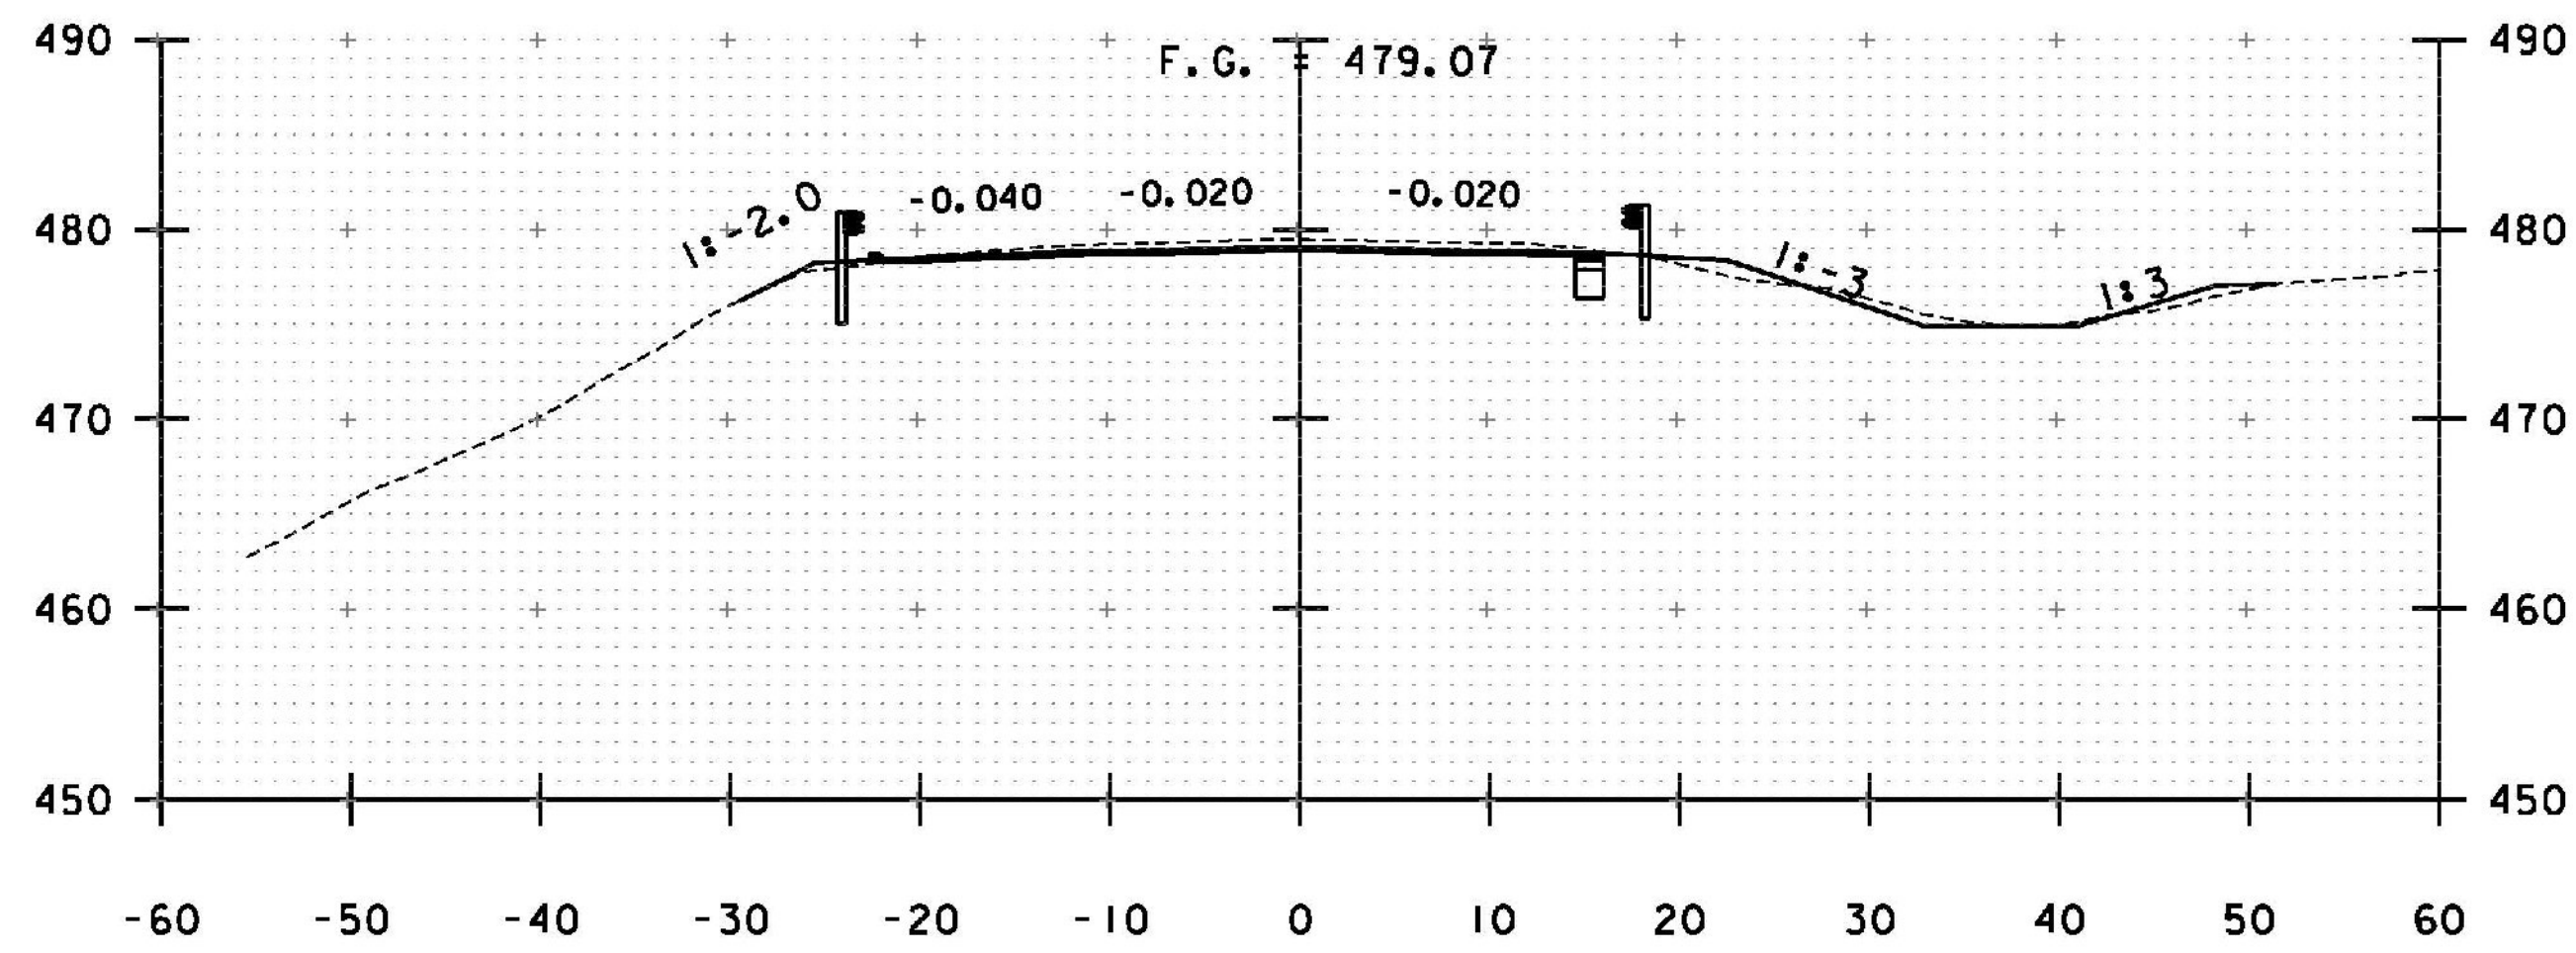

1918+00

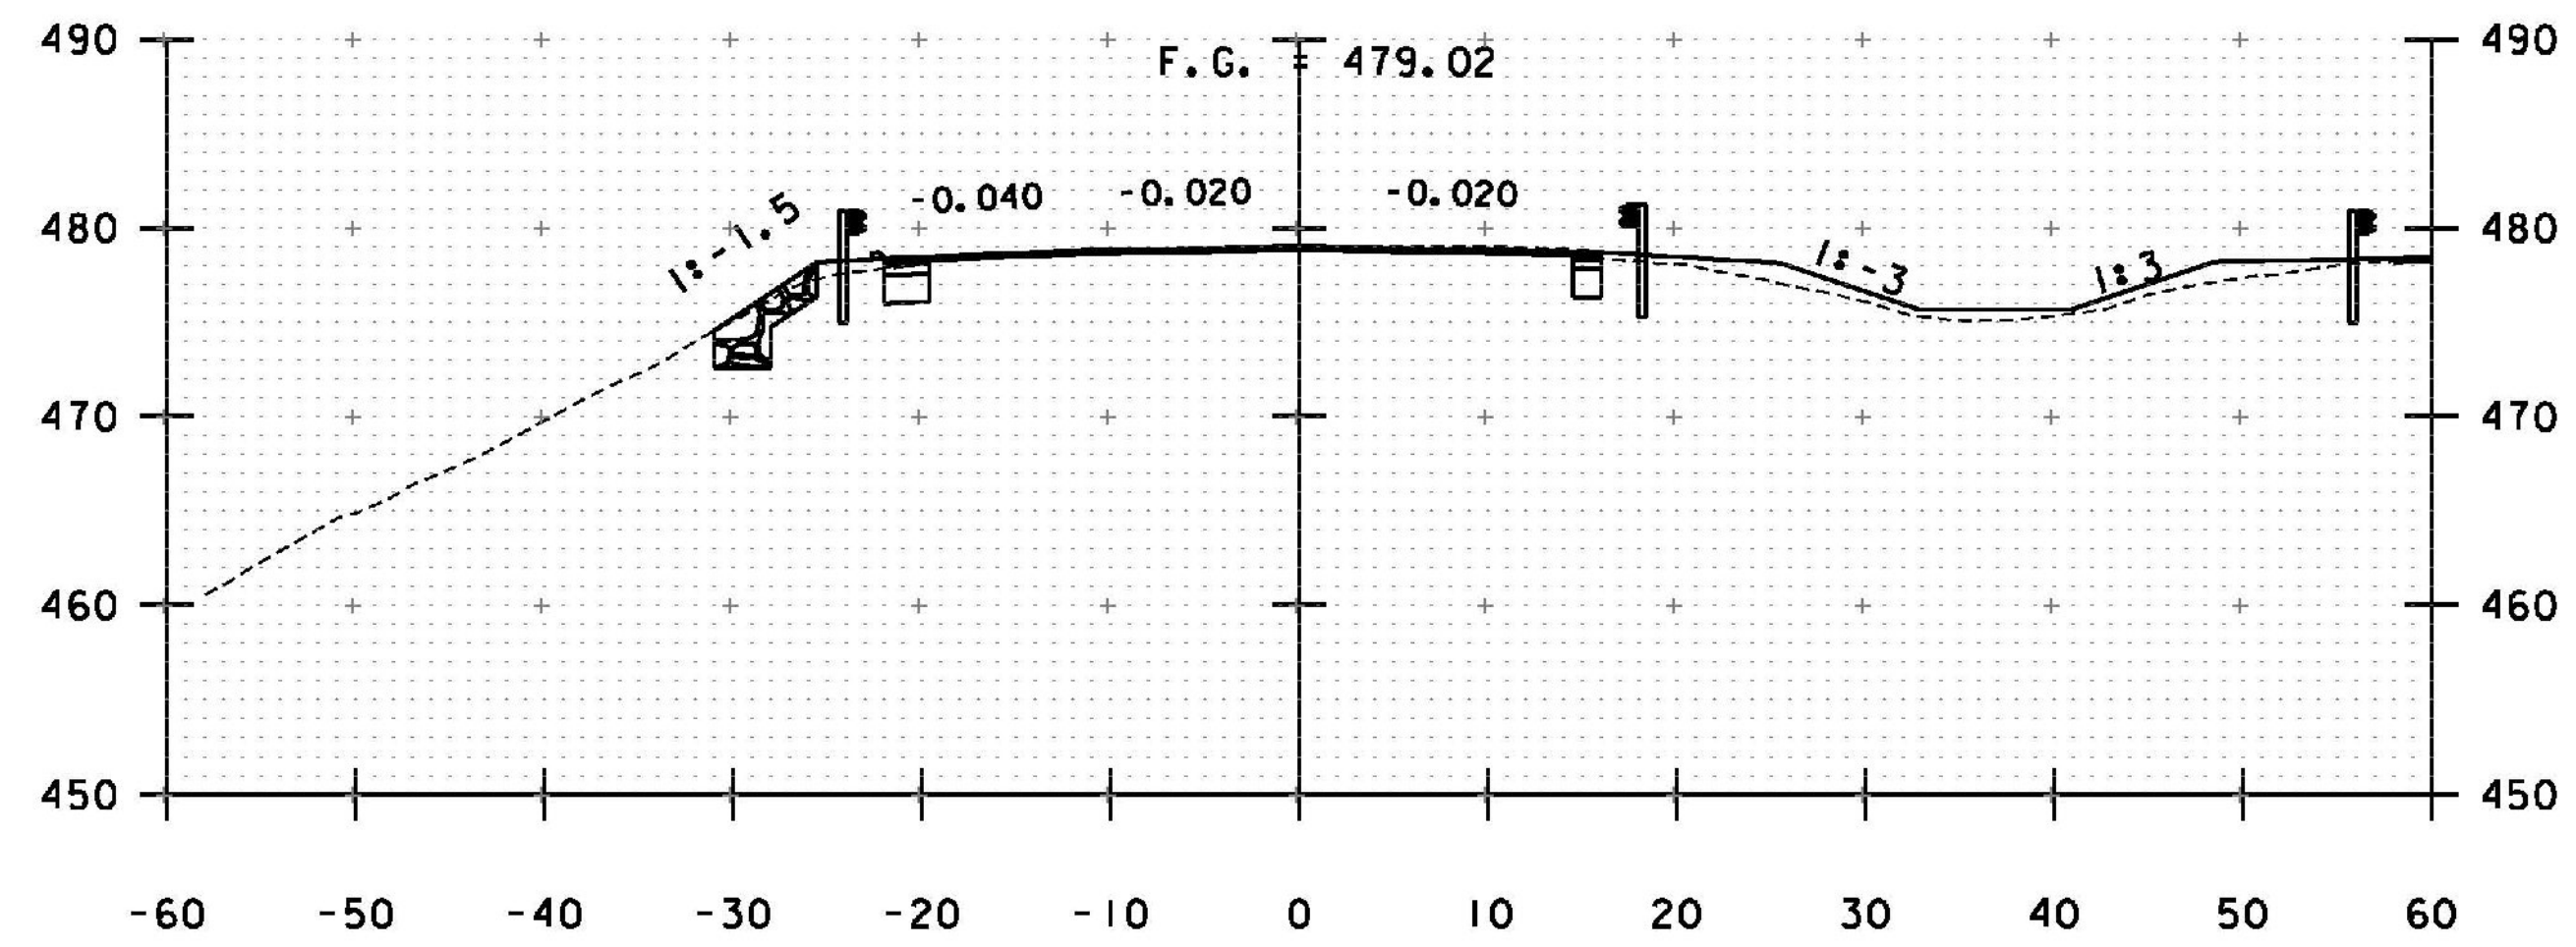

1919+00

STA. 1896+00 TO STA. 1918+00: COLD PLANE AND OVERLAY EXISTING ROADWAY
 STA. 1929+75 TO STA. 1952+50: COLD PLANE AND OVERLAY EXISTING ROADWAY

STA. 1918+00 TO STA. 1920+00

PROJECT NAME: WINDSOR
 PROJECT NUMBER: IM 091-1(64)

FILE NAME: z10o188XS SB.dgn
 PROJECT LEADER: J. WILSON
 DESIGNED BY: H. FULLER
 CROSS SECTIONS- 1-91 SOUTHBOUND 1

PLOT DATE: 7/30/2015
 DRAWN BY: S. GUNN
 CHECKED BY: T. MORIN
 SHEET 150 OF 156