




1929+00

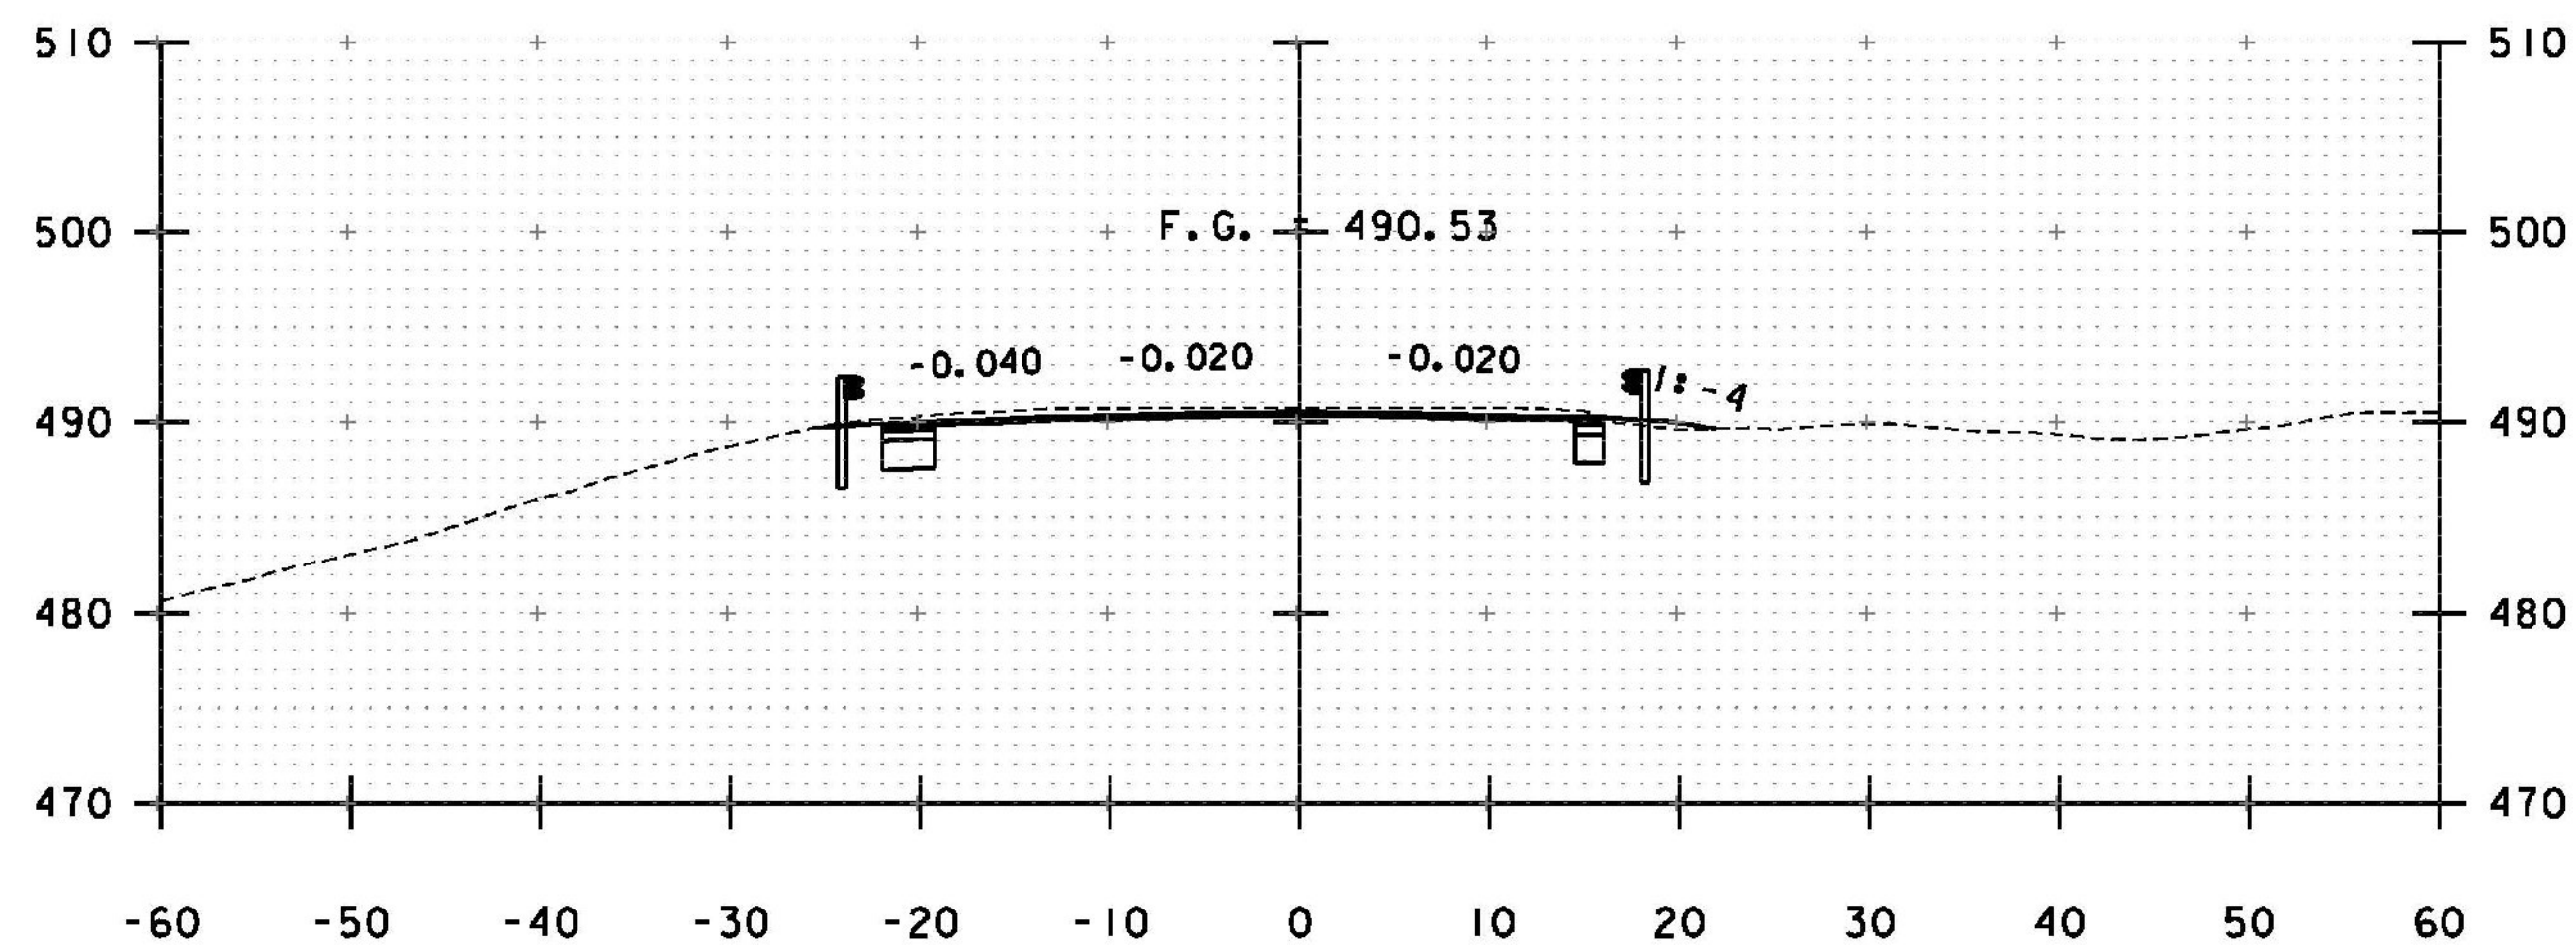


1928+50

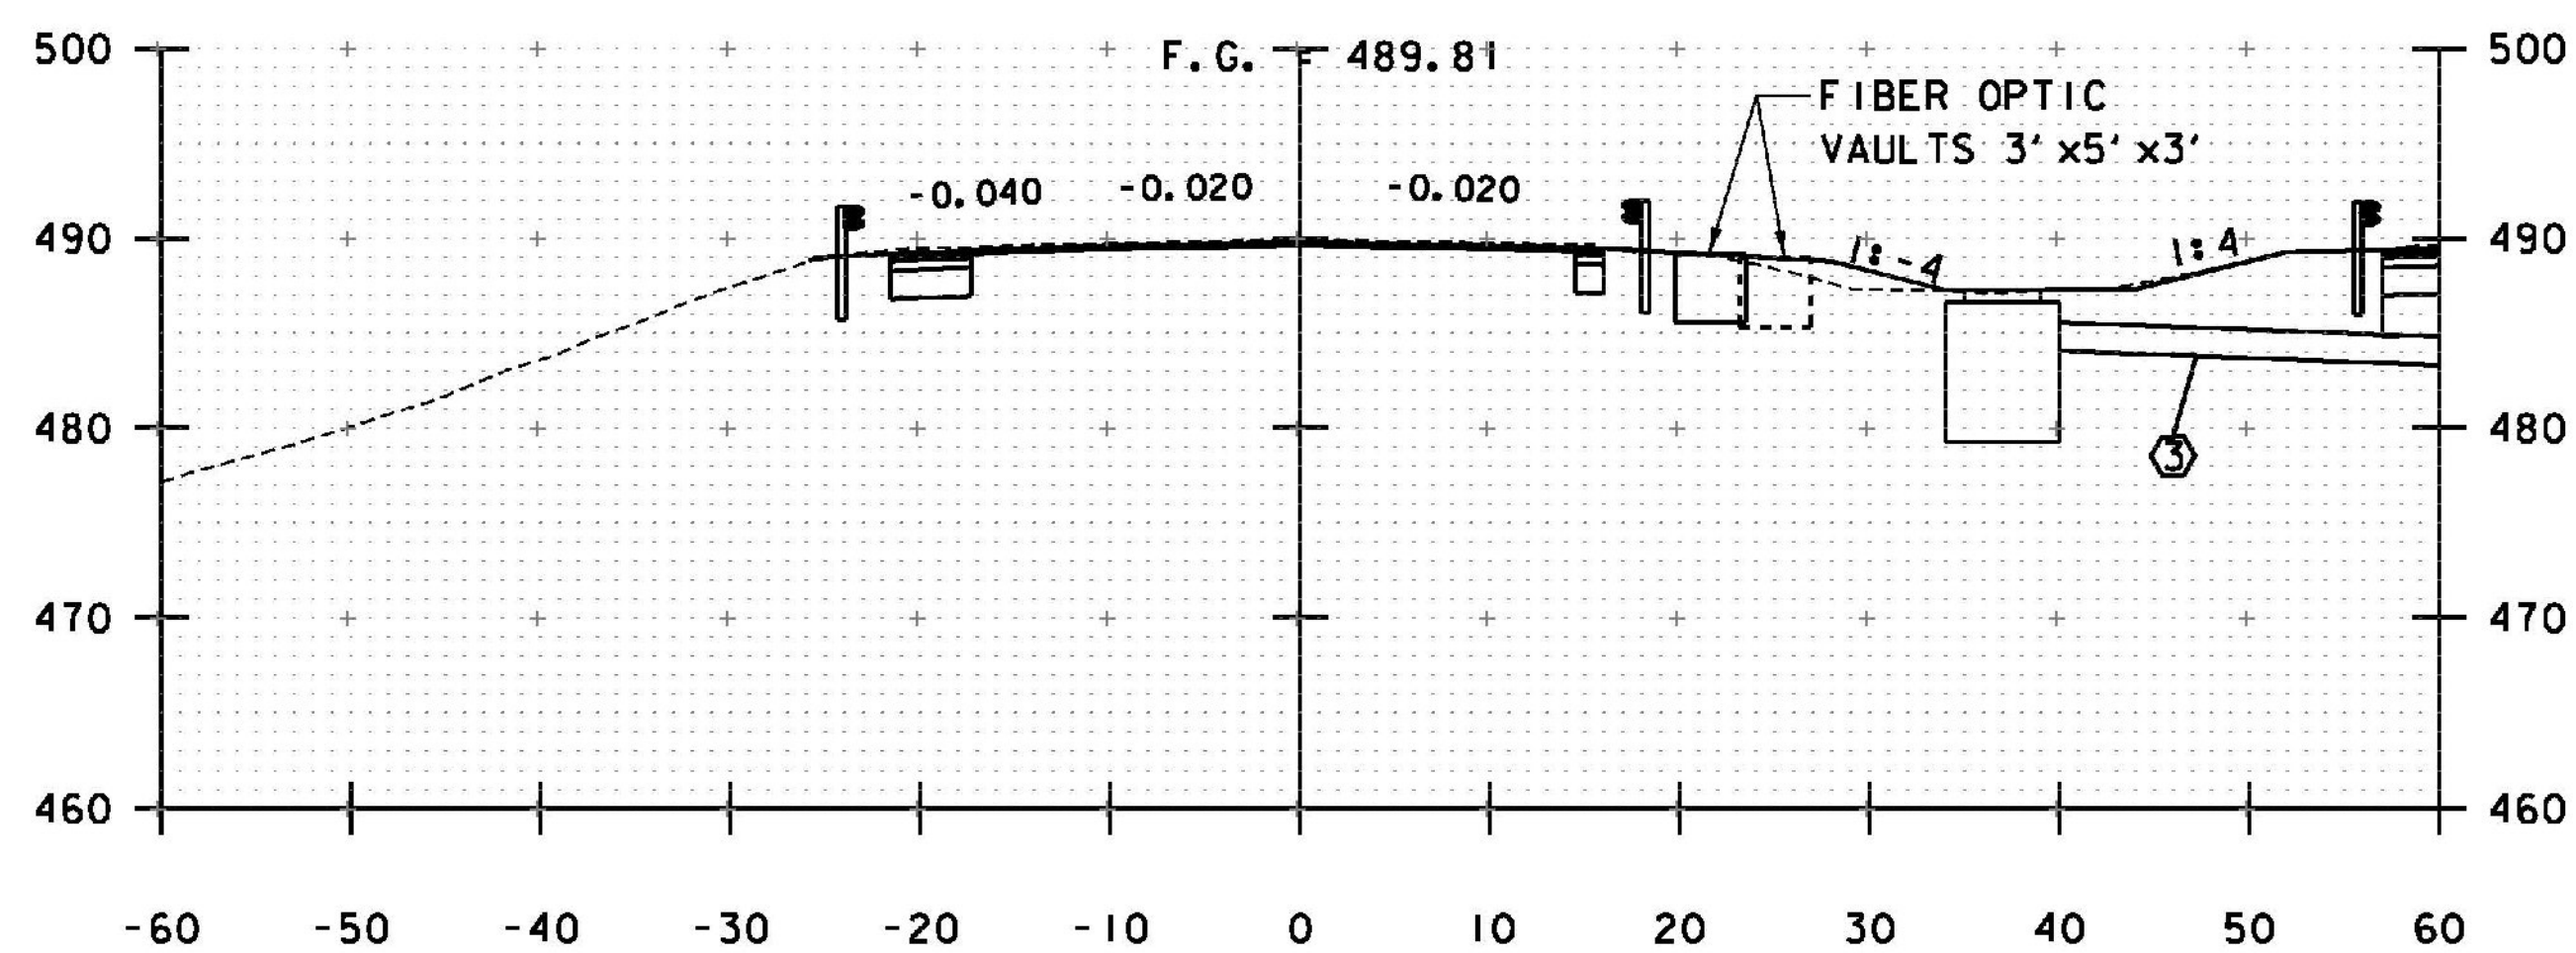

1928+00

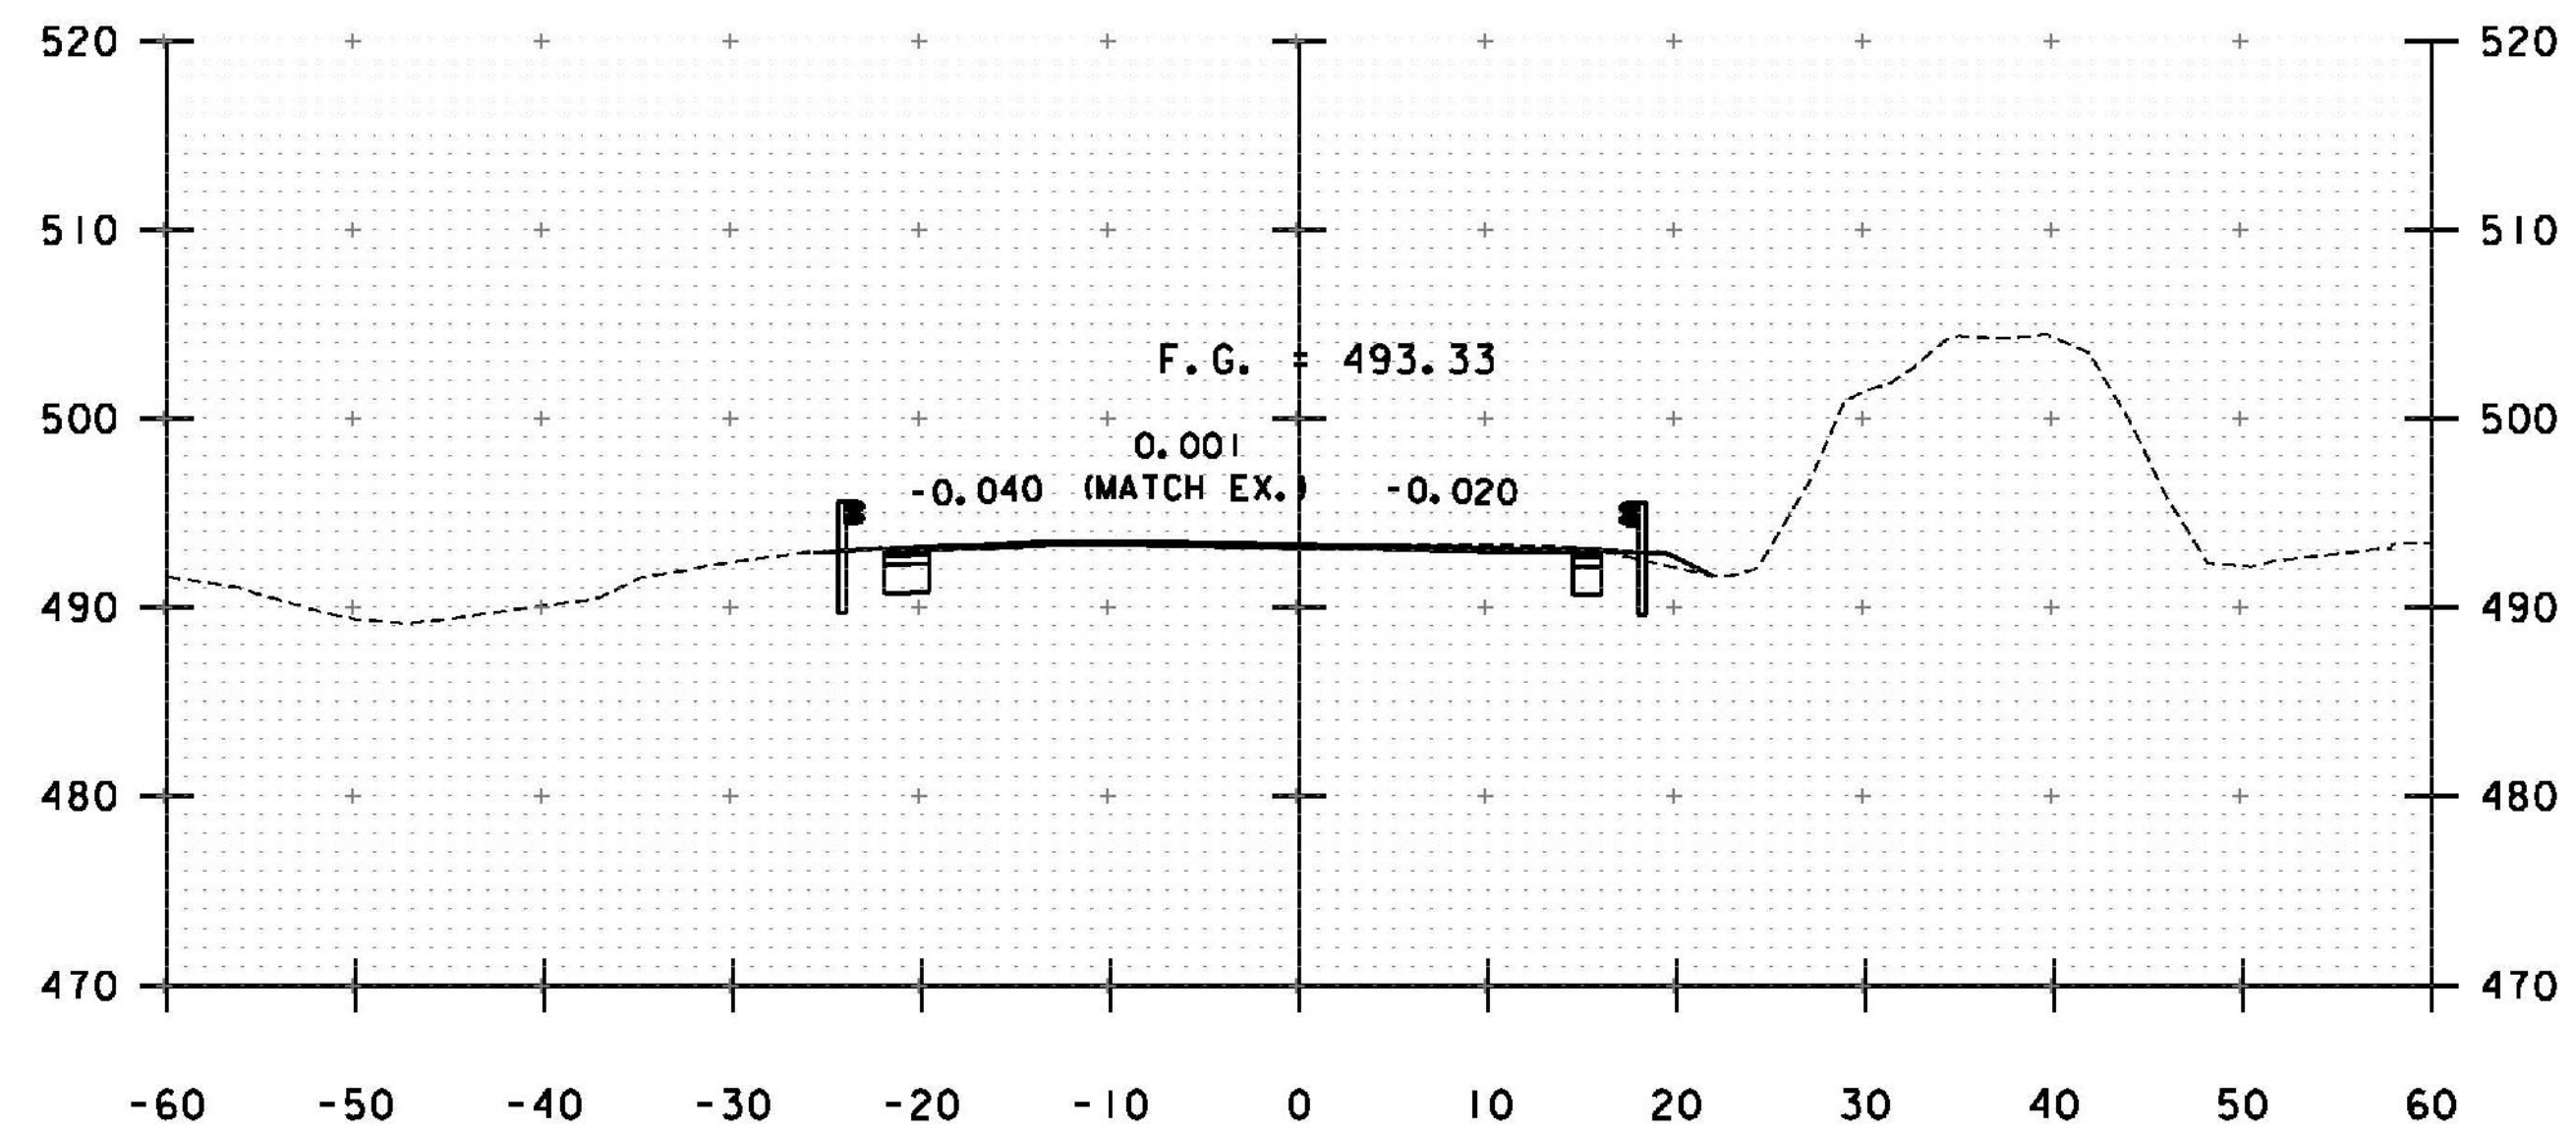

1929+75

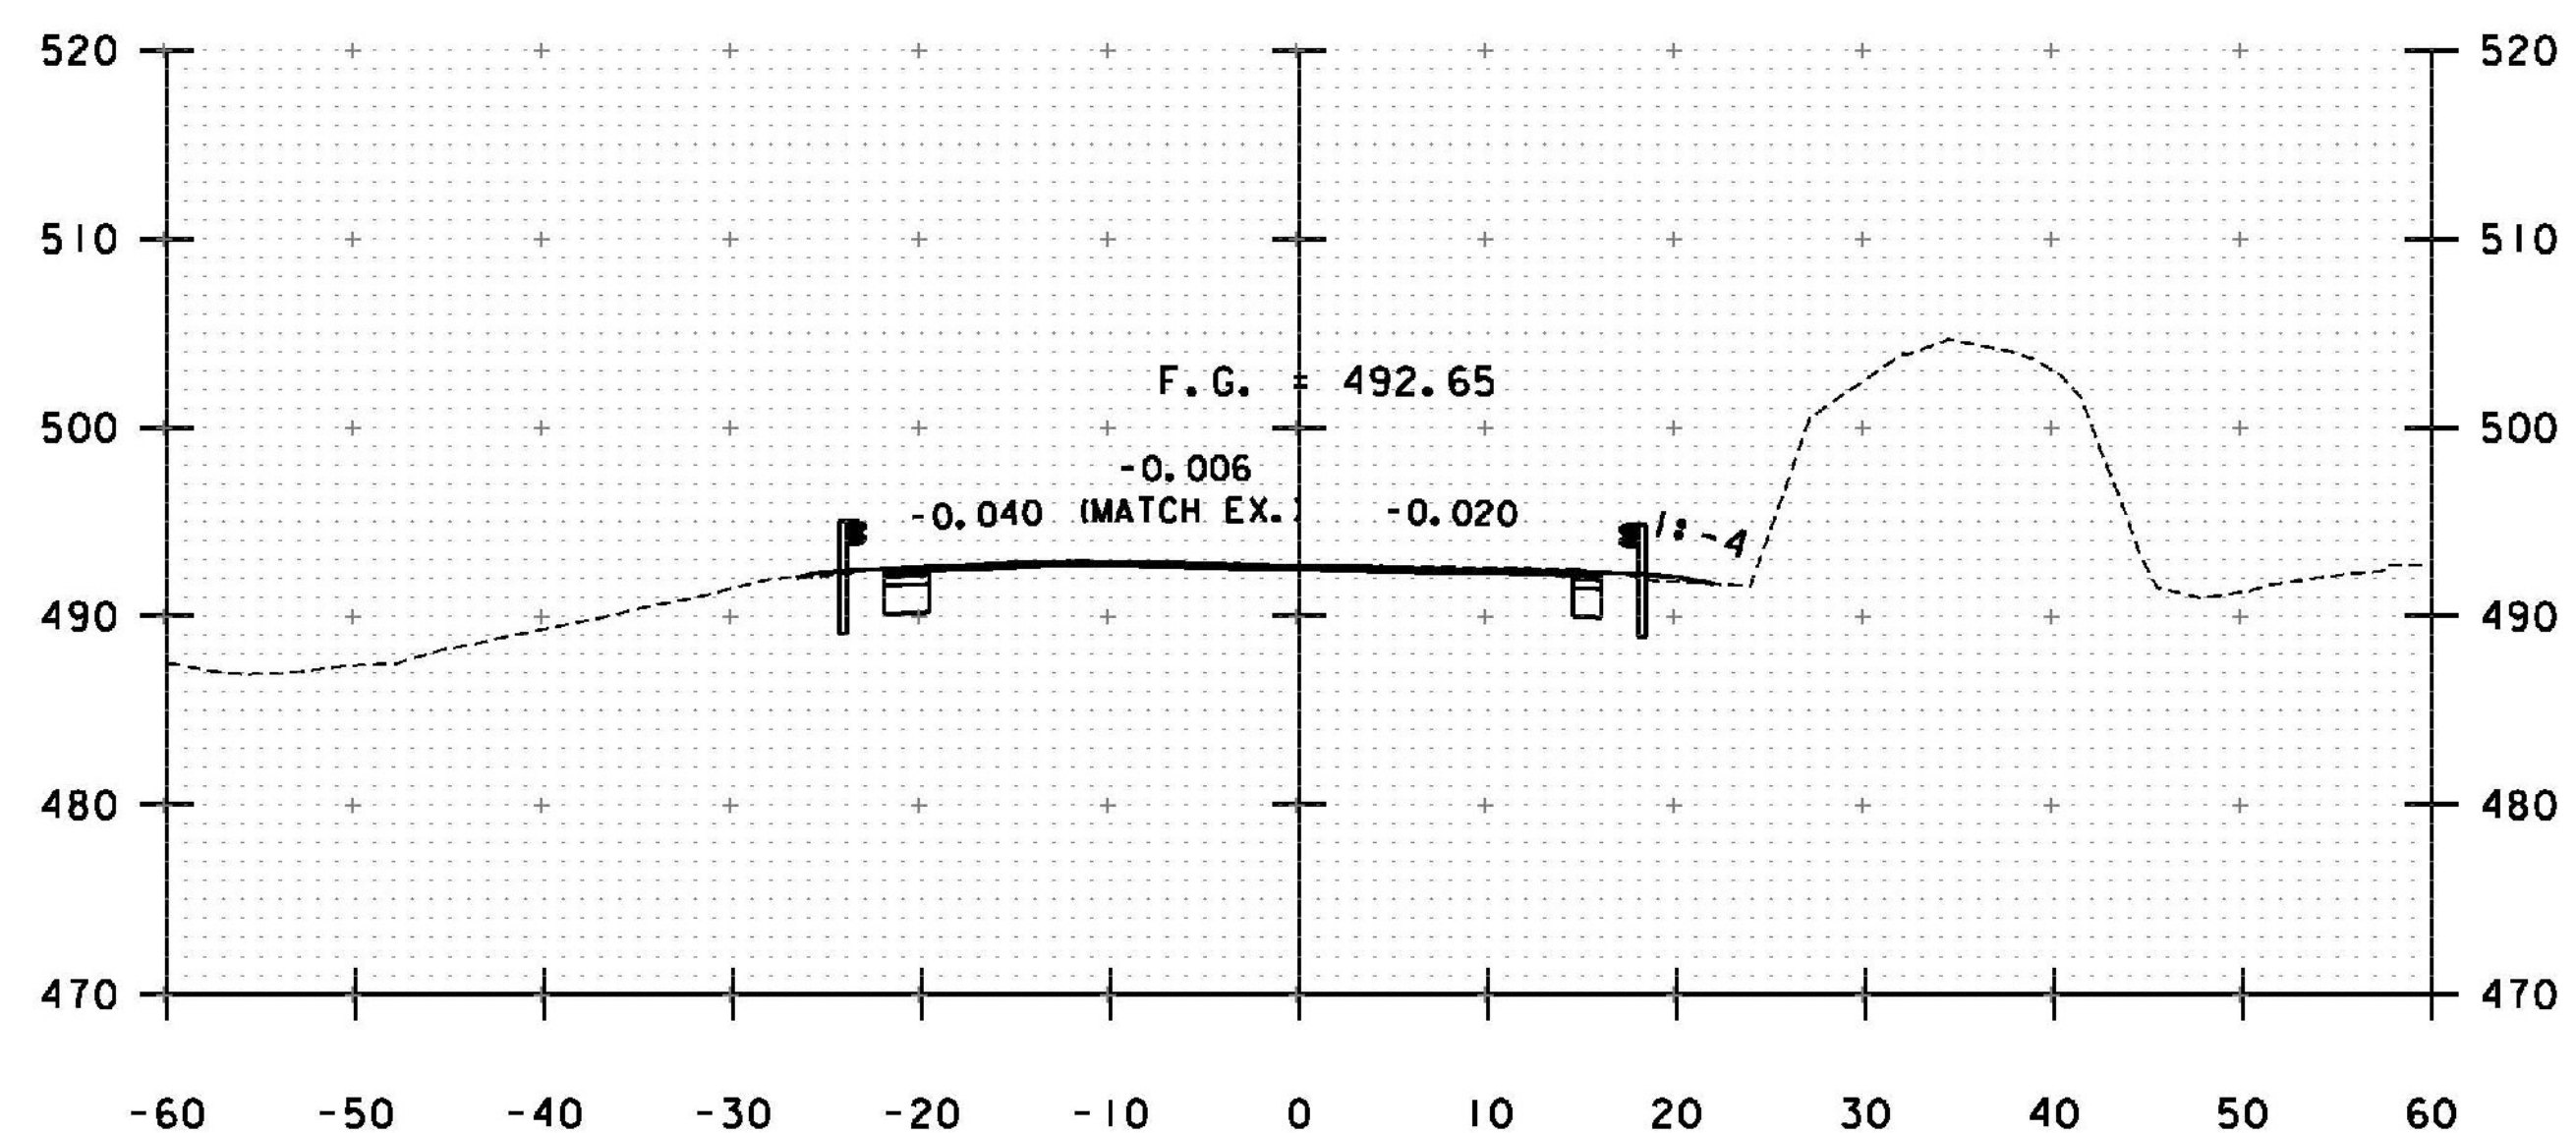

1929+50

PROJECT NAME: WINDSOR
PROJECT NUMBER: IM 091-1(64)

FILE NAME: z10o188XS SB.dgn
PROJECT LEADER: J. WILSON
DESIGNED BY: H. FULLER
CROSS SECTIONS- 1-91 SOUTHBOUND 3

PLOT DATE: 7/30/2015
DRAWN BY: S. GUNN
CHECKED BY: T. MORIN
SHEET 152 OF 156

STA. 1928+00 TO STA. 1929+75