




2918+50

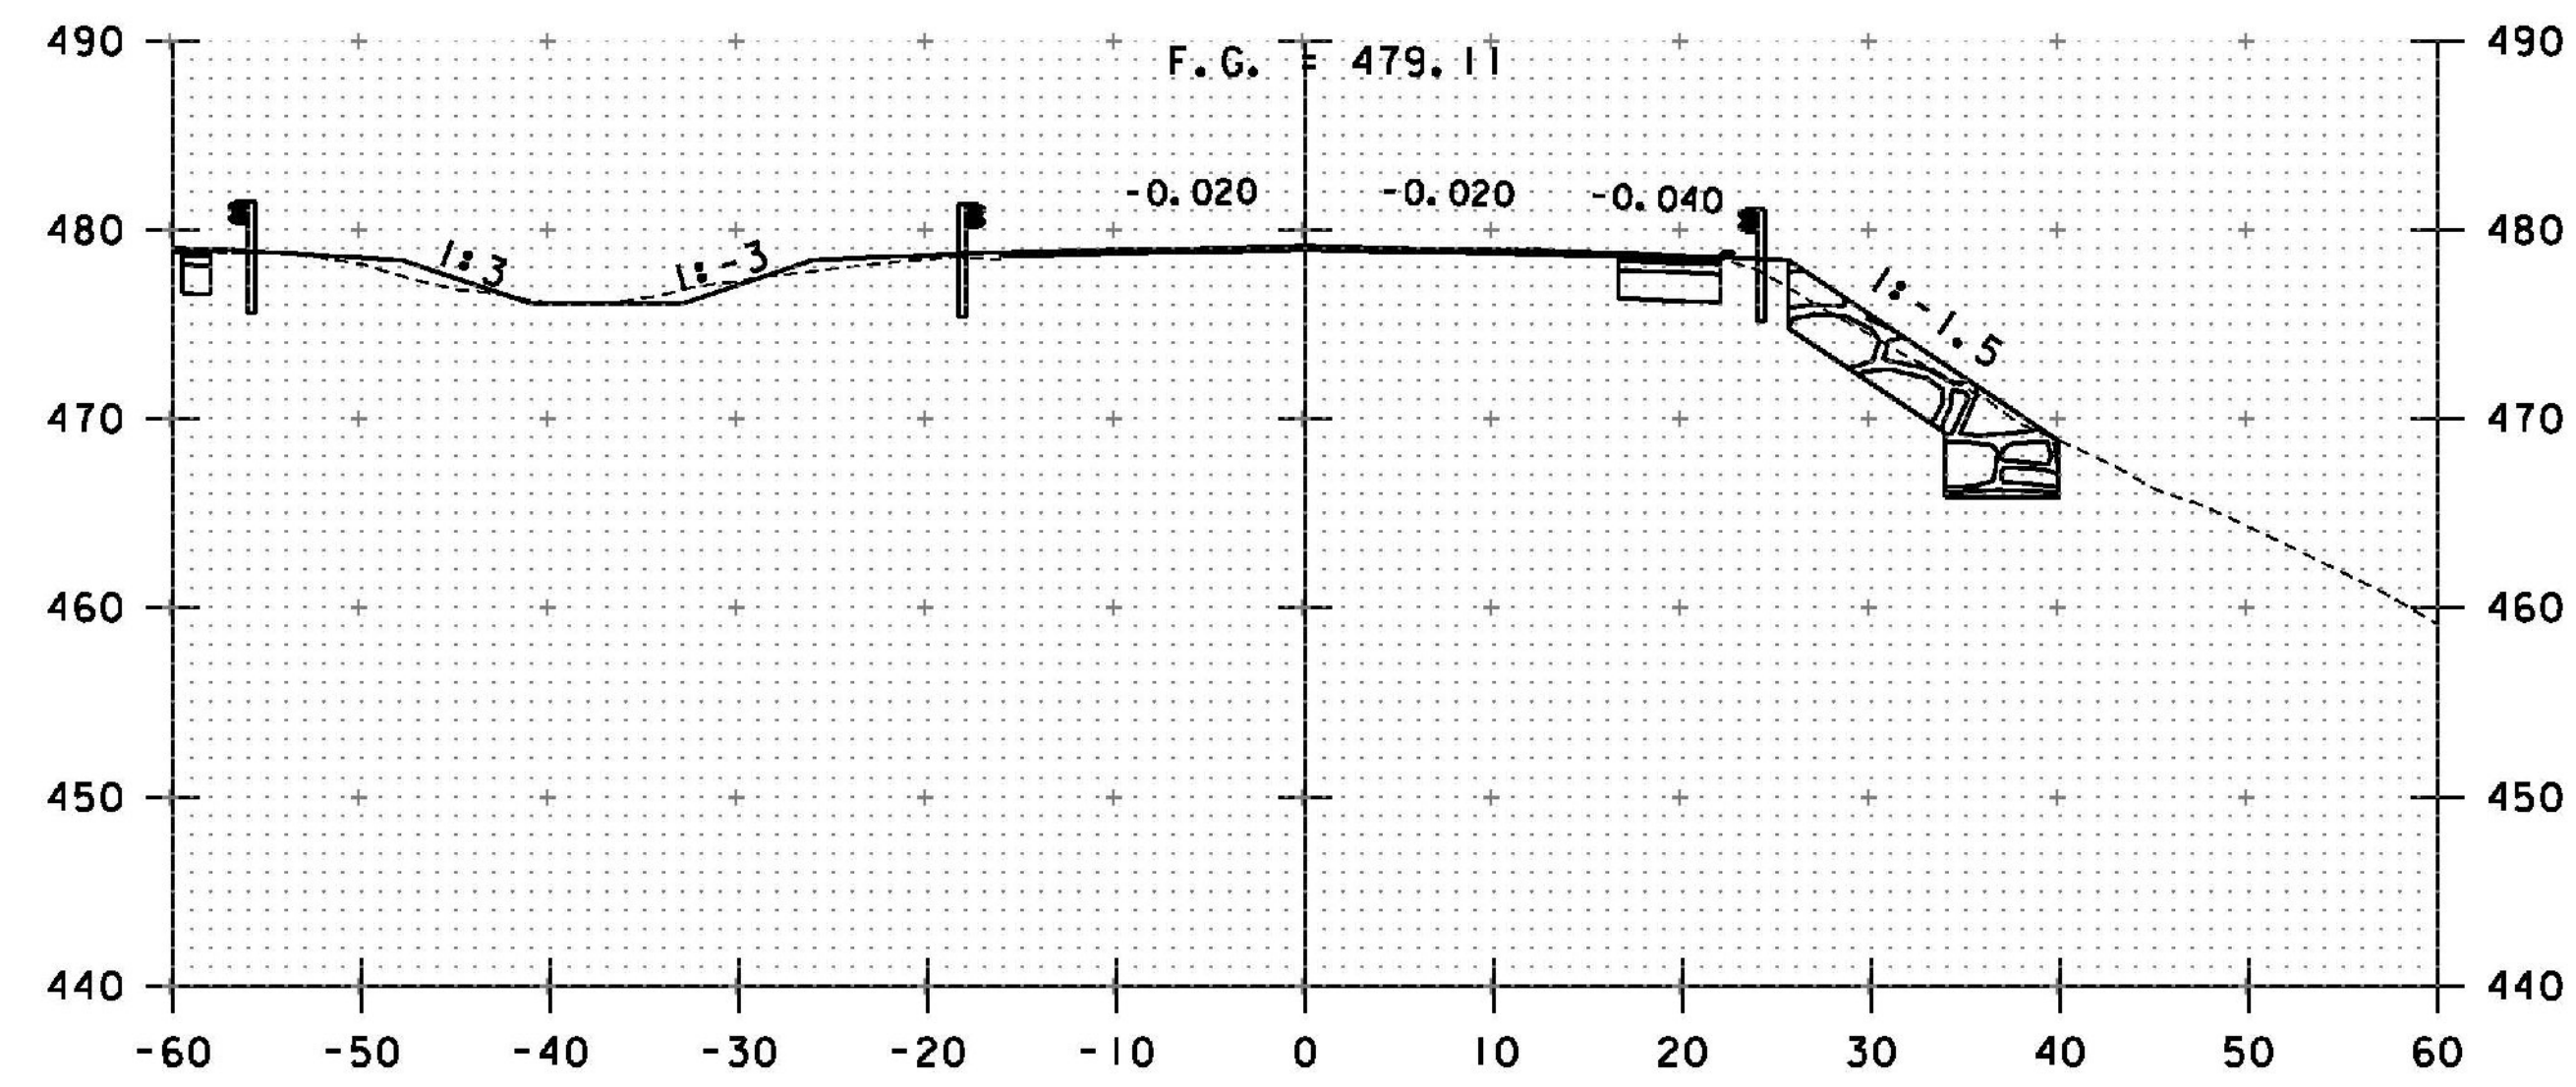

2919+50

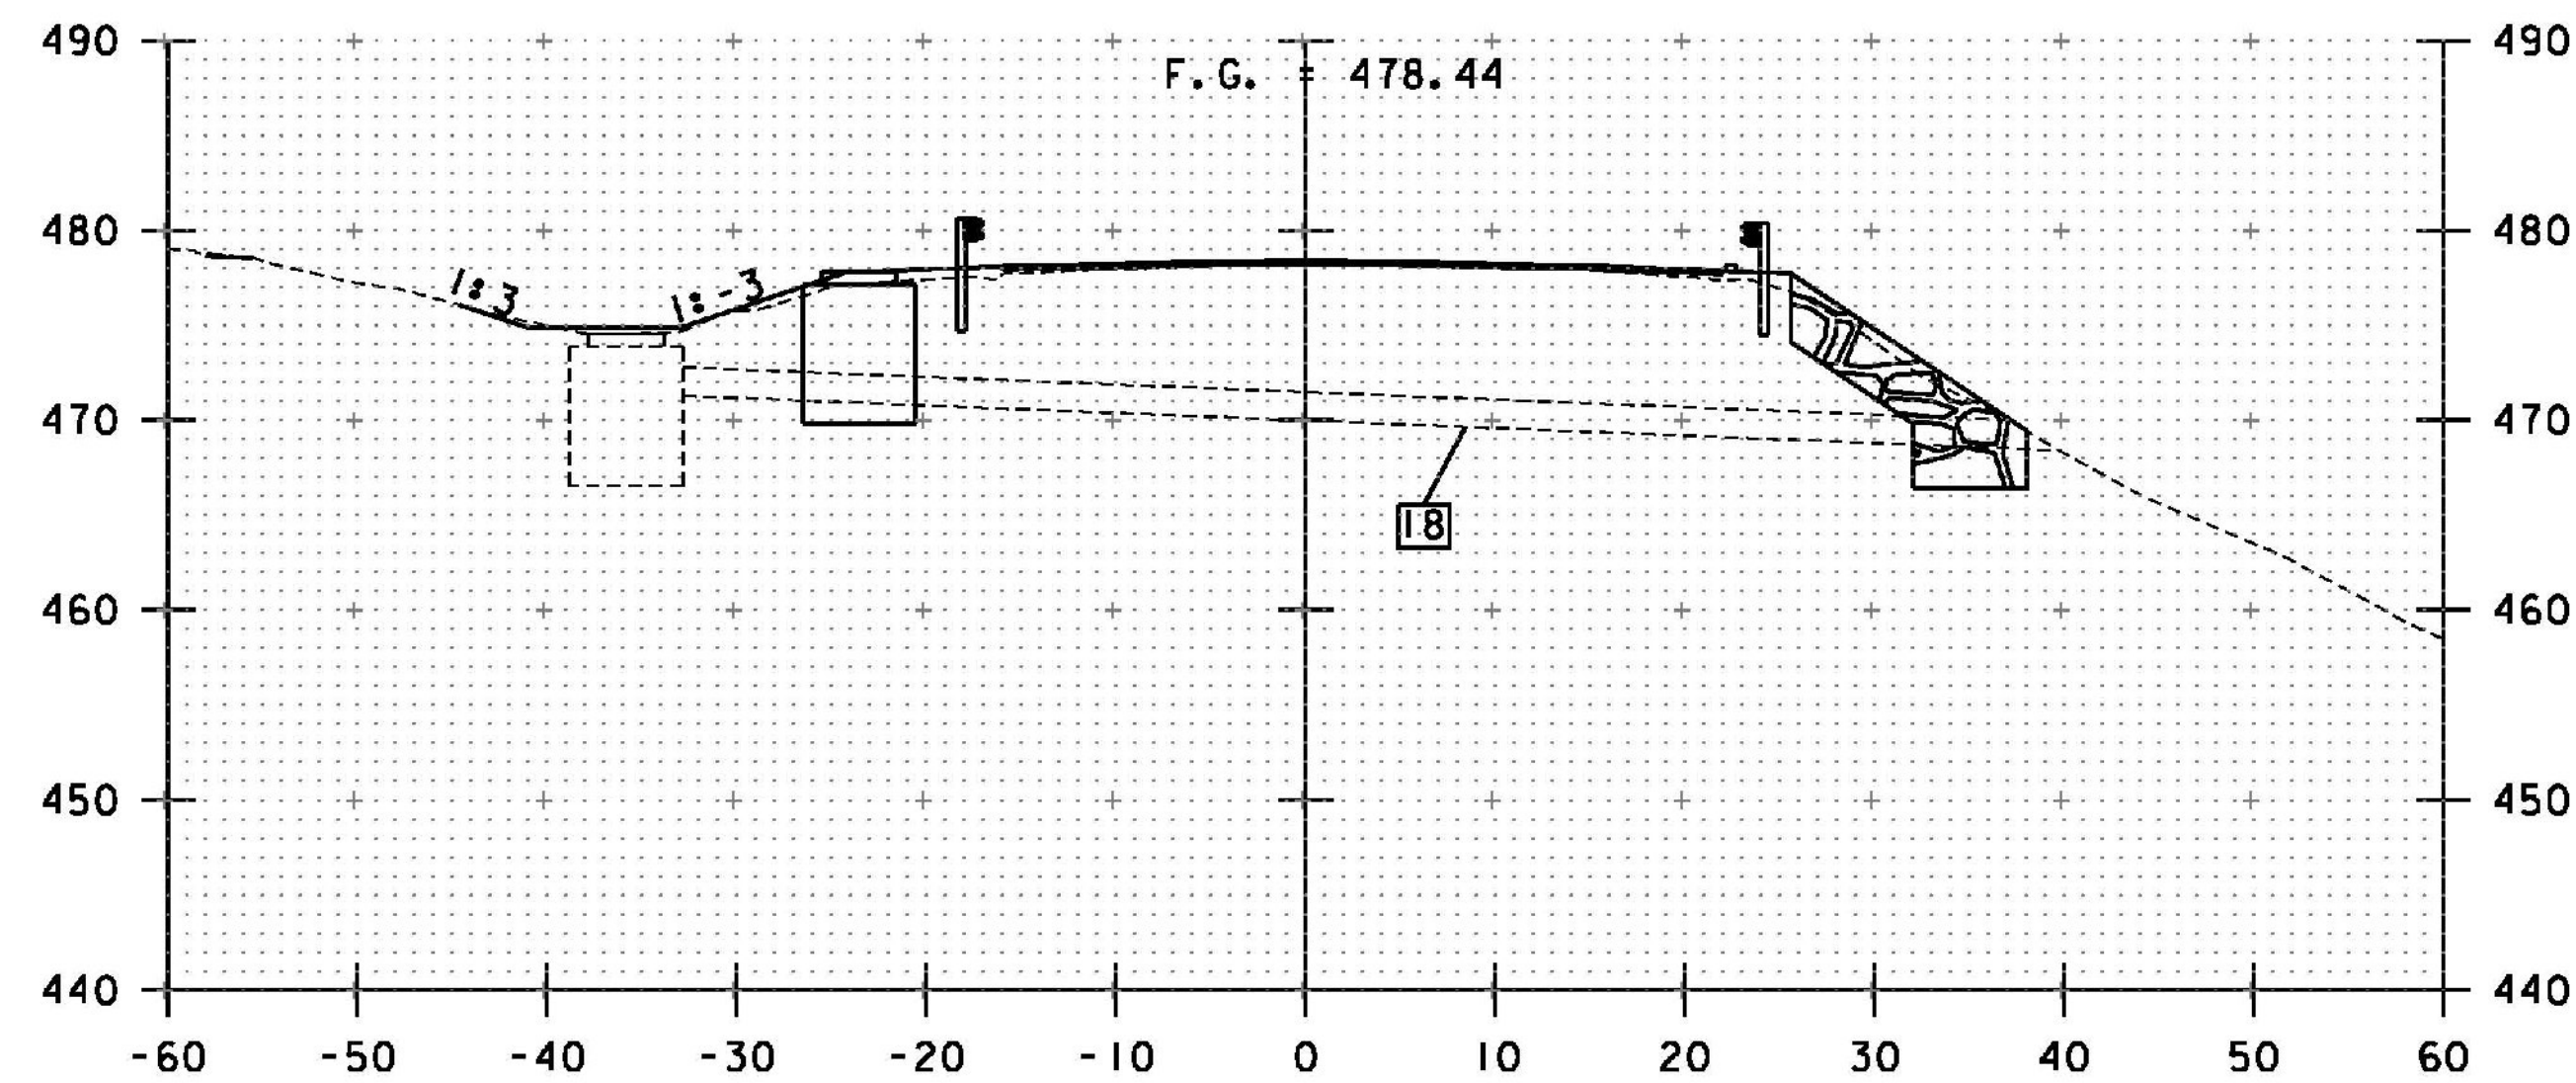

2918+25

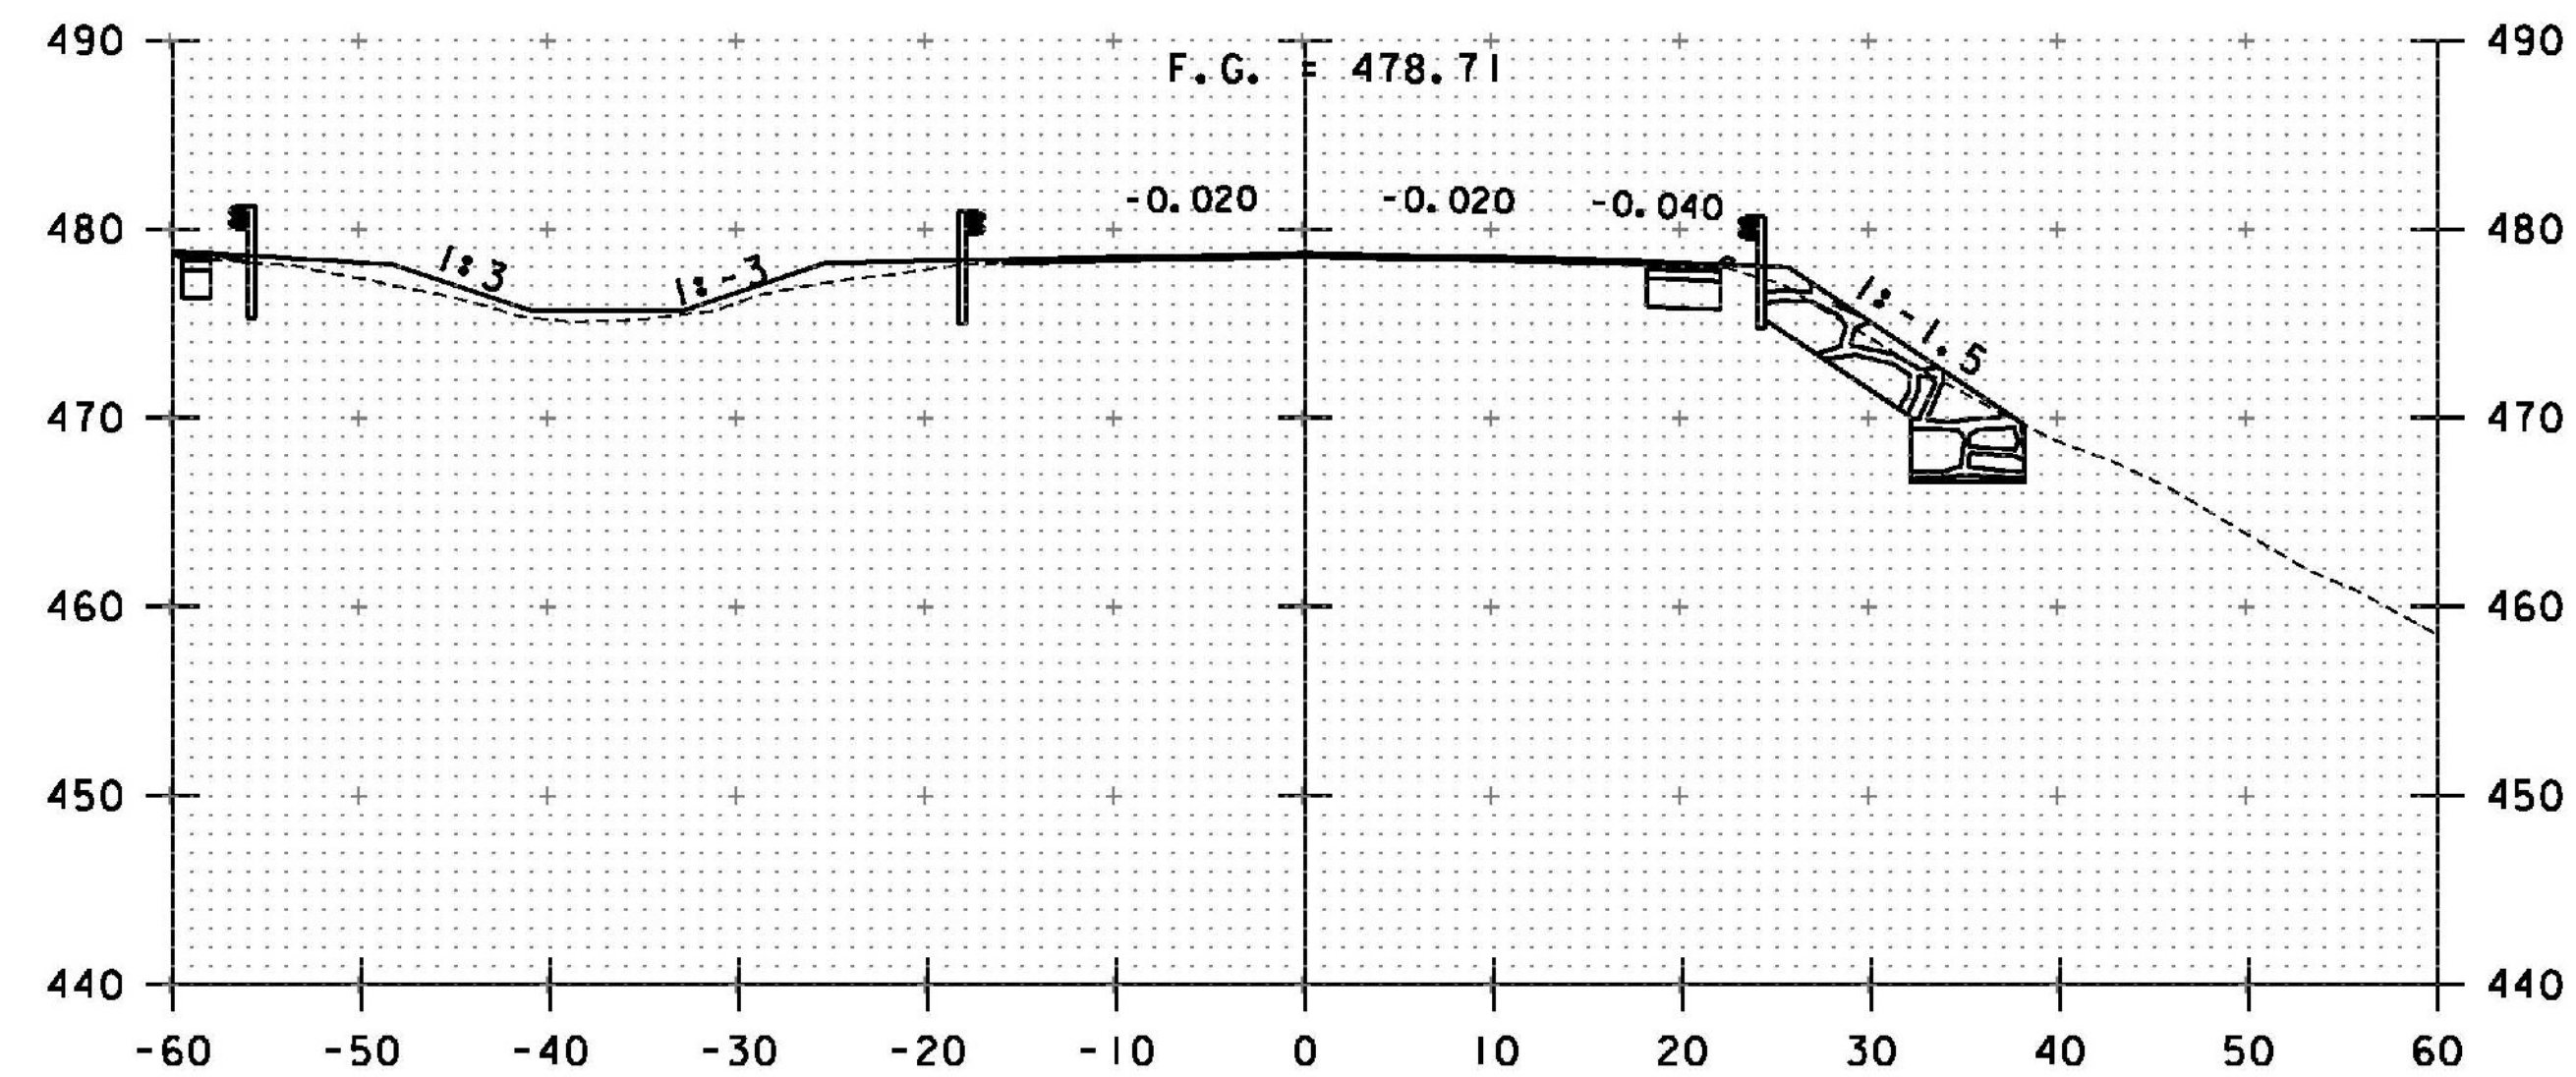

2919+00

STA. 2895+50 TO STA. 2918+25: COLD PLANE AND OVERLAY EXISTING ROADWAY
 STA. 2930+25 TO STA. 2943+25: COLD PLANE AND OVERLAY EXISTING ROADWAY

STA. 2918+25 TO STA. 2919+50

PROJECT NAME: WINDSOR
 PROJECT NUMBER: IM 091-1(64)

FILE NAME: z10o188XS1.dgn
 PROJECT LEADER: J. WILSON
 DESIGNED BY: H. FULLER
 CROSS SECTIONS- I-91 NORTHBOUND 1

PLOT DATE: 7/30/2015
 DRAWN BY: S. GUNN
 CHECKED BY: T. MORIN
 SHEET 153 OF 156