




2929+50

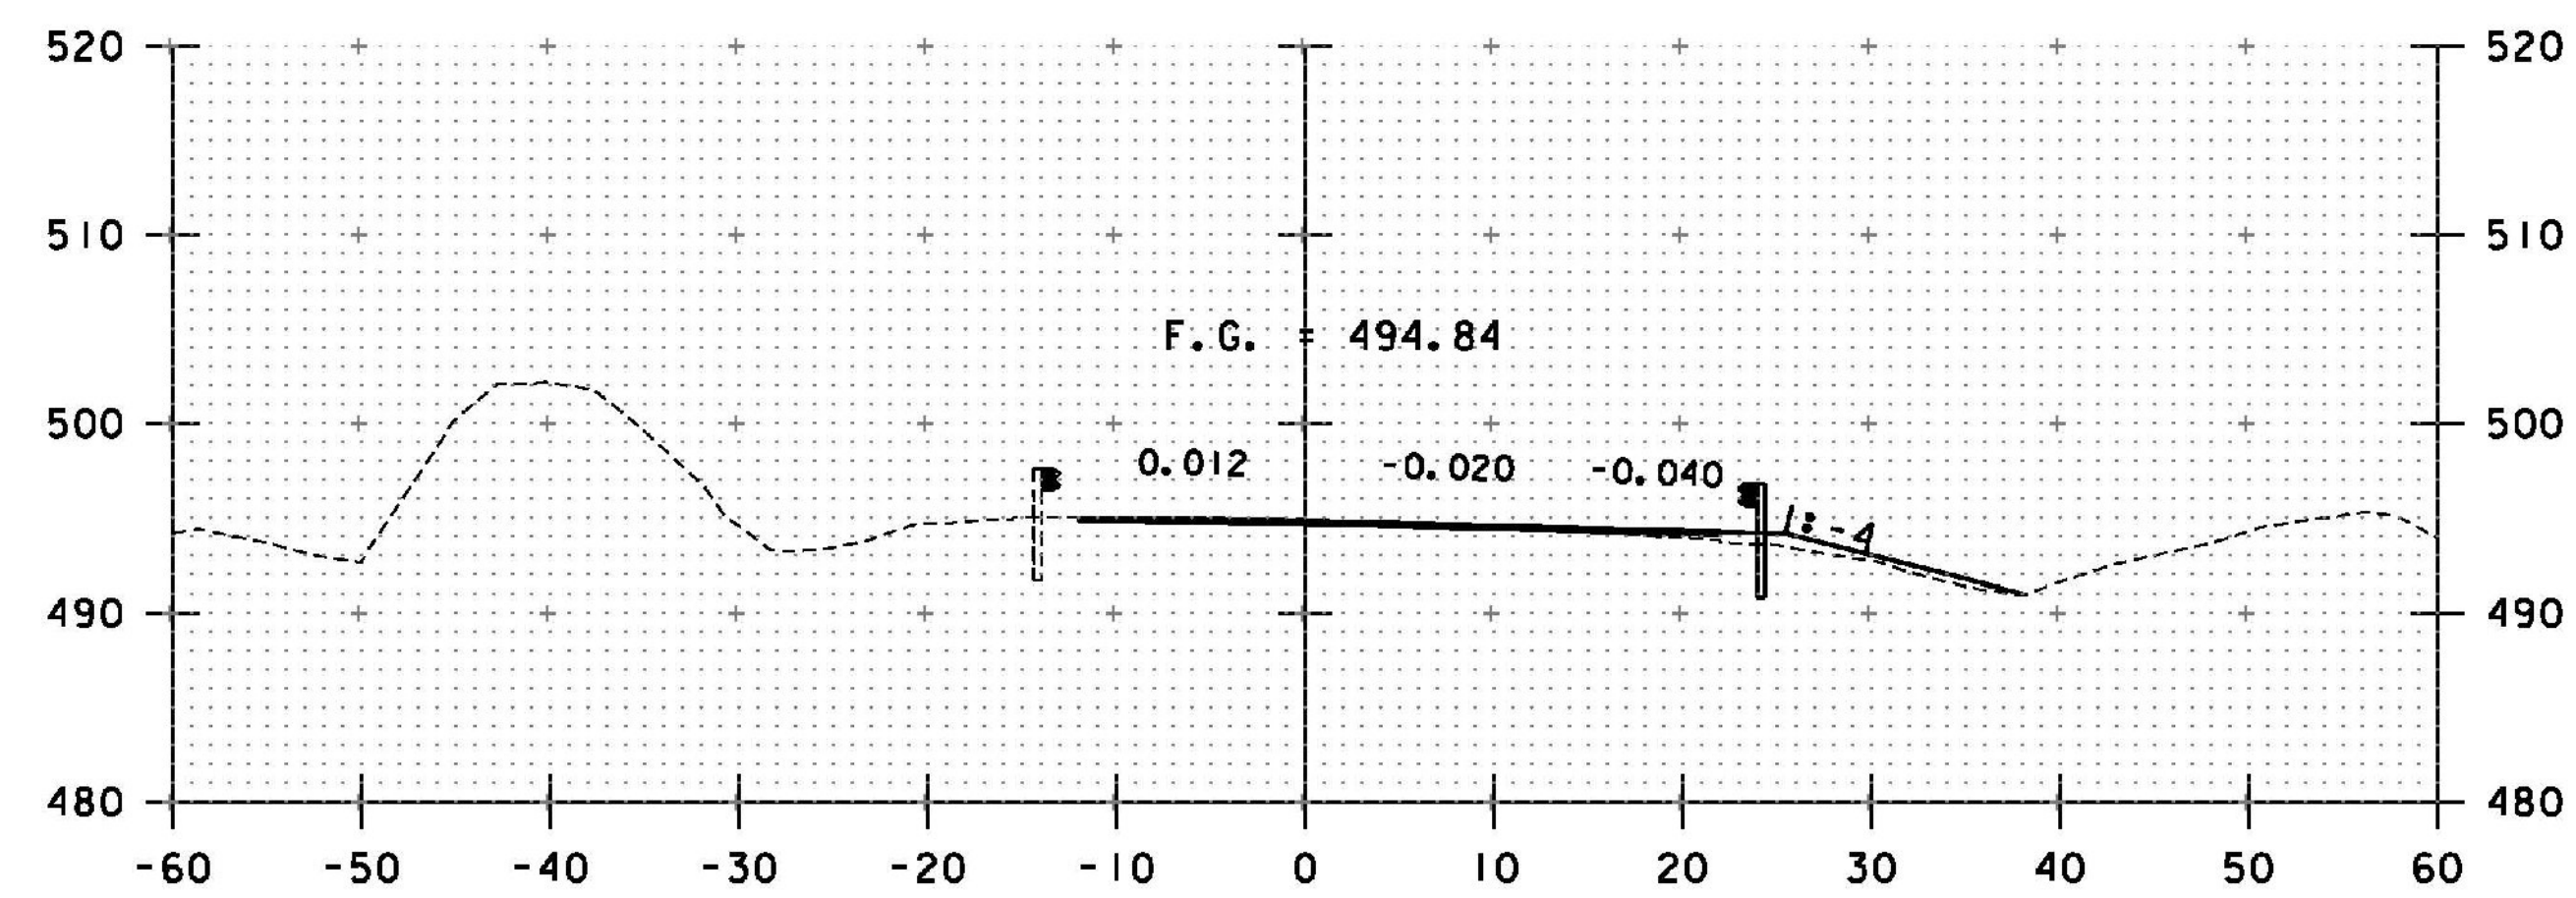

2930+25

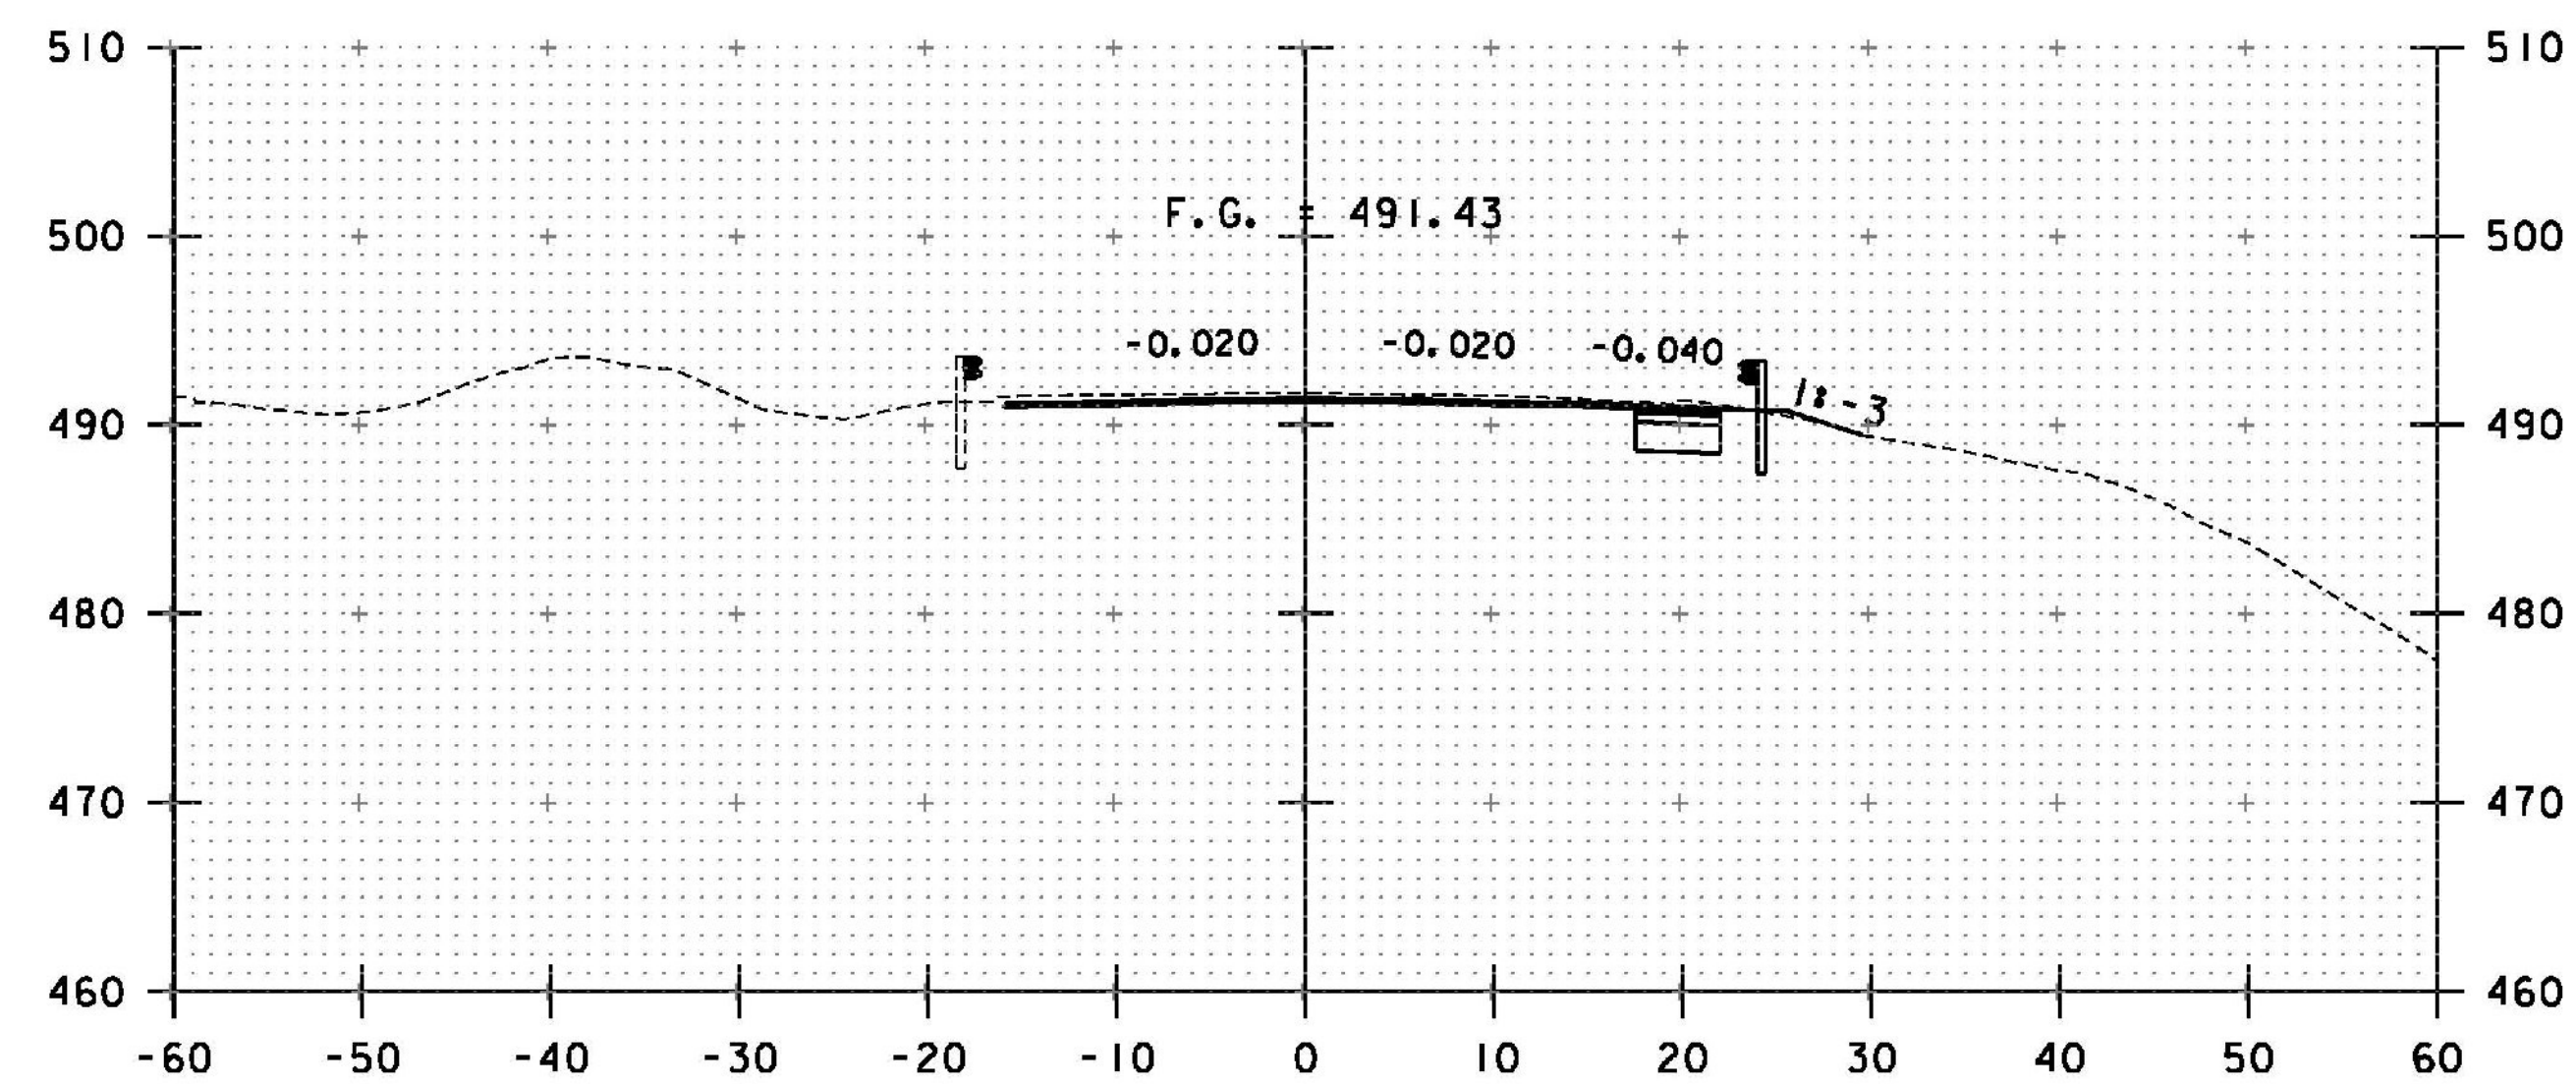

2929+00

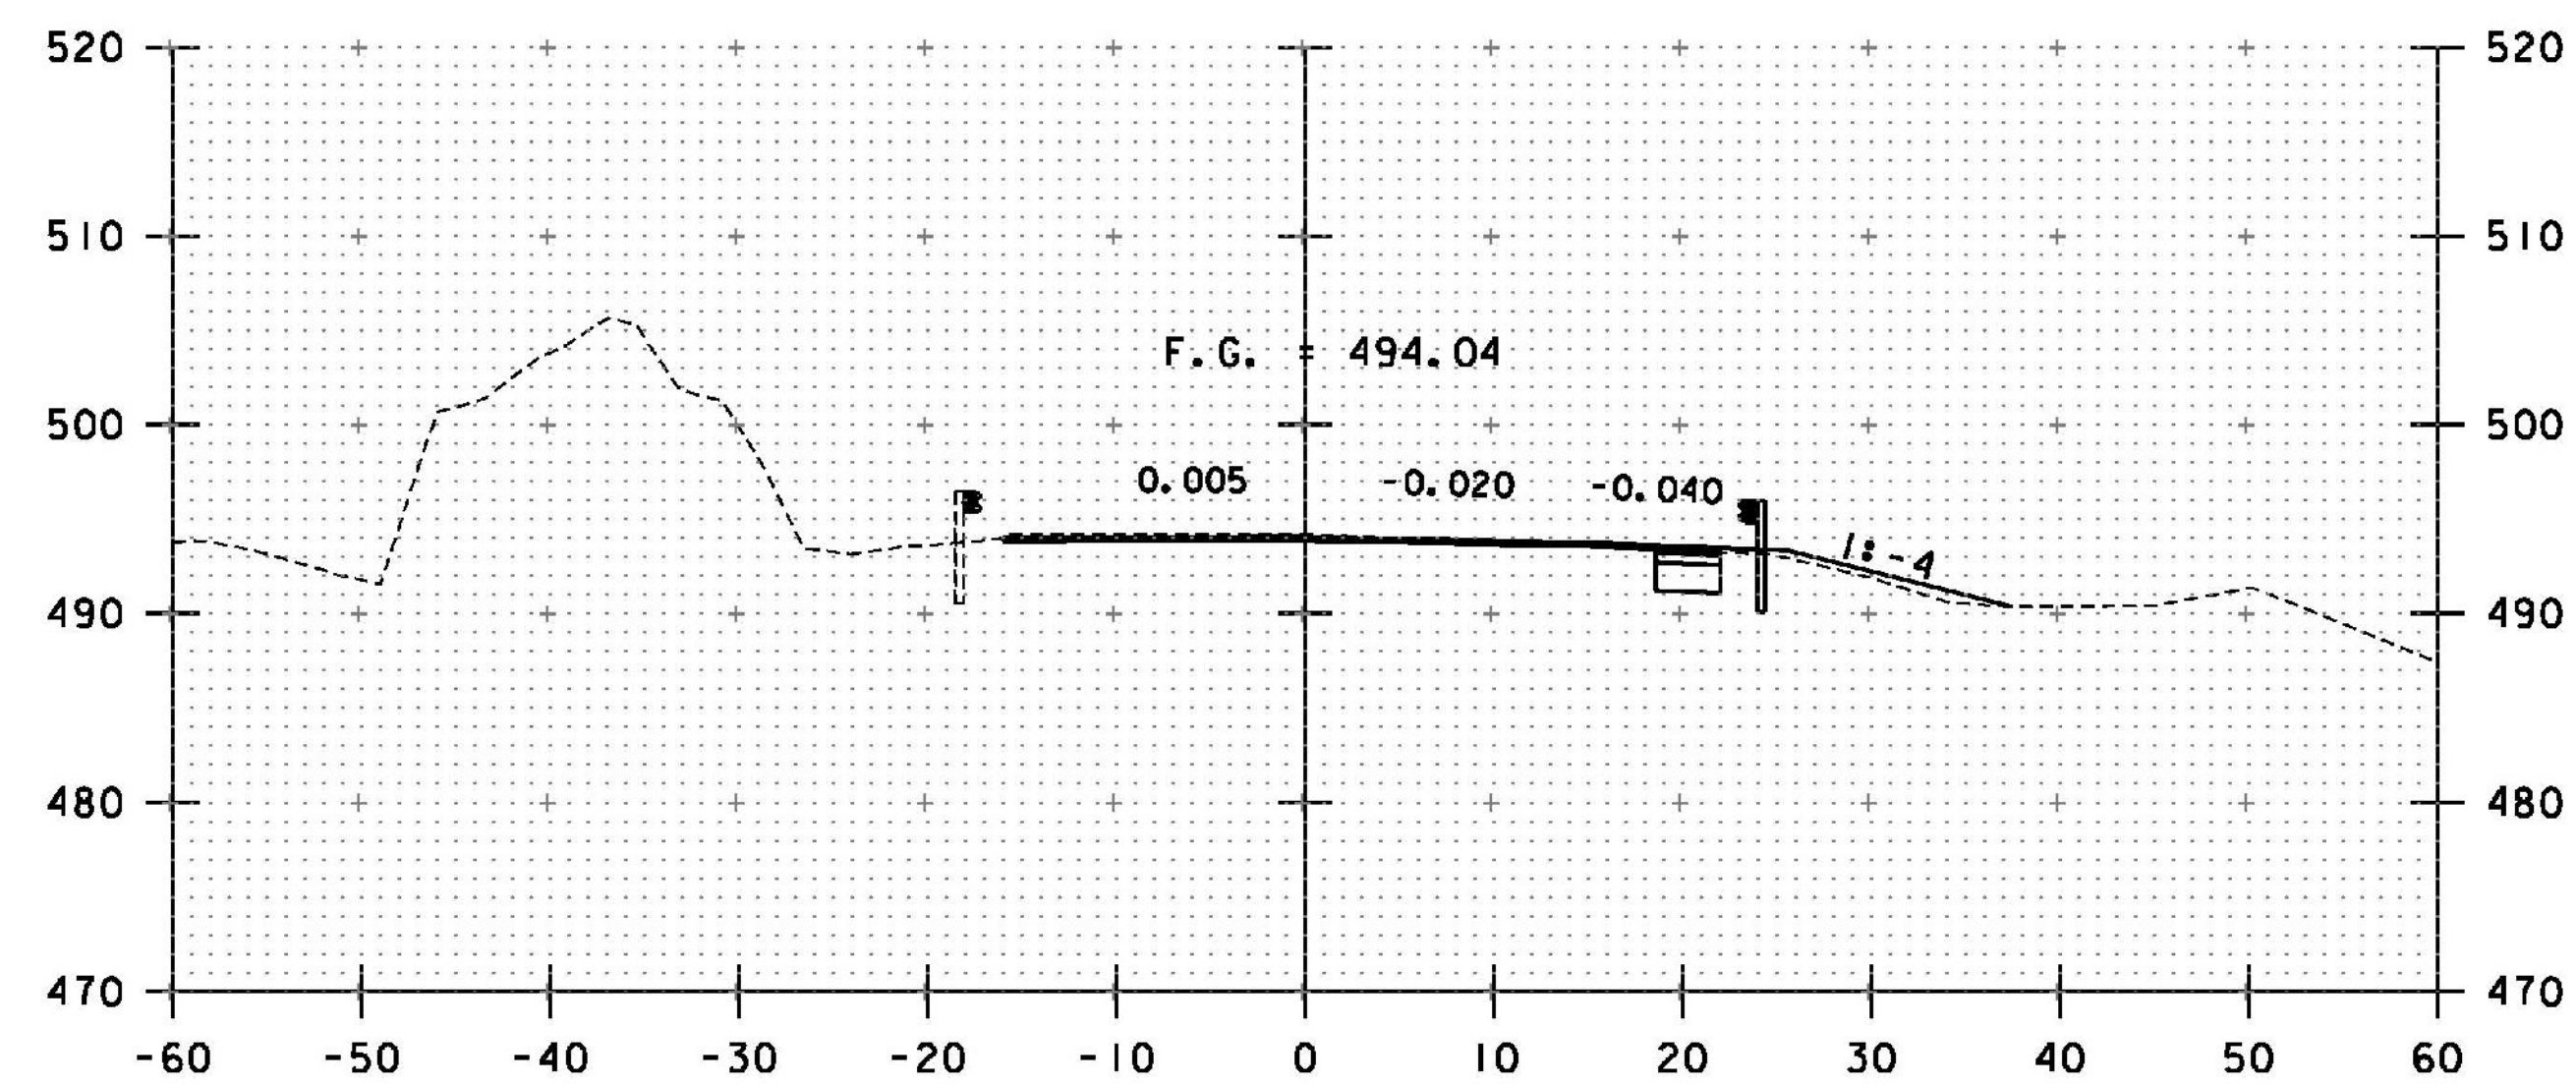

2930+00

STA. 2929+00 TO STA. 2930+25

PROJECT NAME: WINDSOR
 PROJECT NUMBER: IM 091-1(64)

FILE NAME: z10o188XS1.dgn PLOT DATE: 7/30/2015
 PROJECT LEADER: J. WILSON DRAWN BY: S. GUNN
 DESIGNED BY: H. FULLER CHECKED BY: T. MORIN
 CROSS SECTIONS- I-91 NORTHBOUND 4 SHEET 156 OF 156