




TYPICAL SECTION - PHASE I CONSTRUCTION BUILT AS DESIGNED
NOT TO SCALE

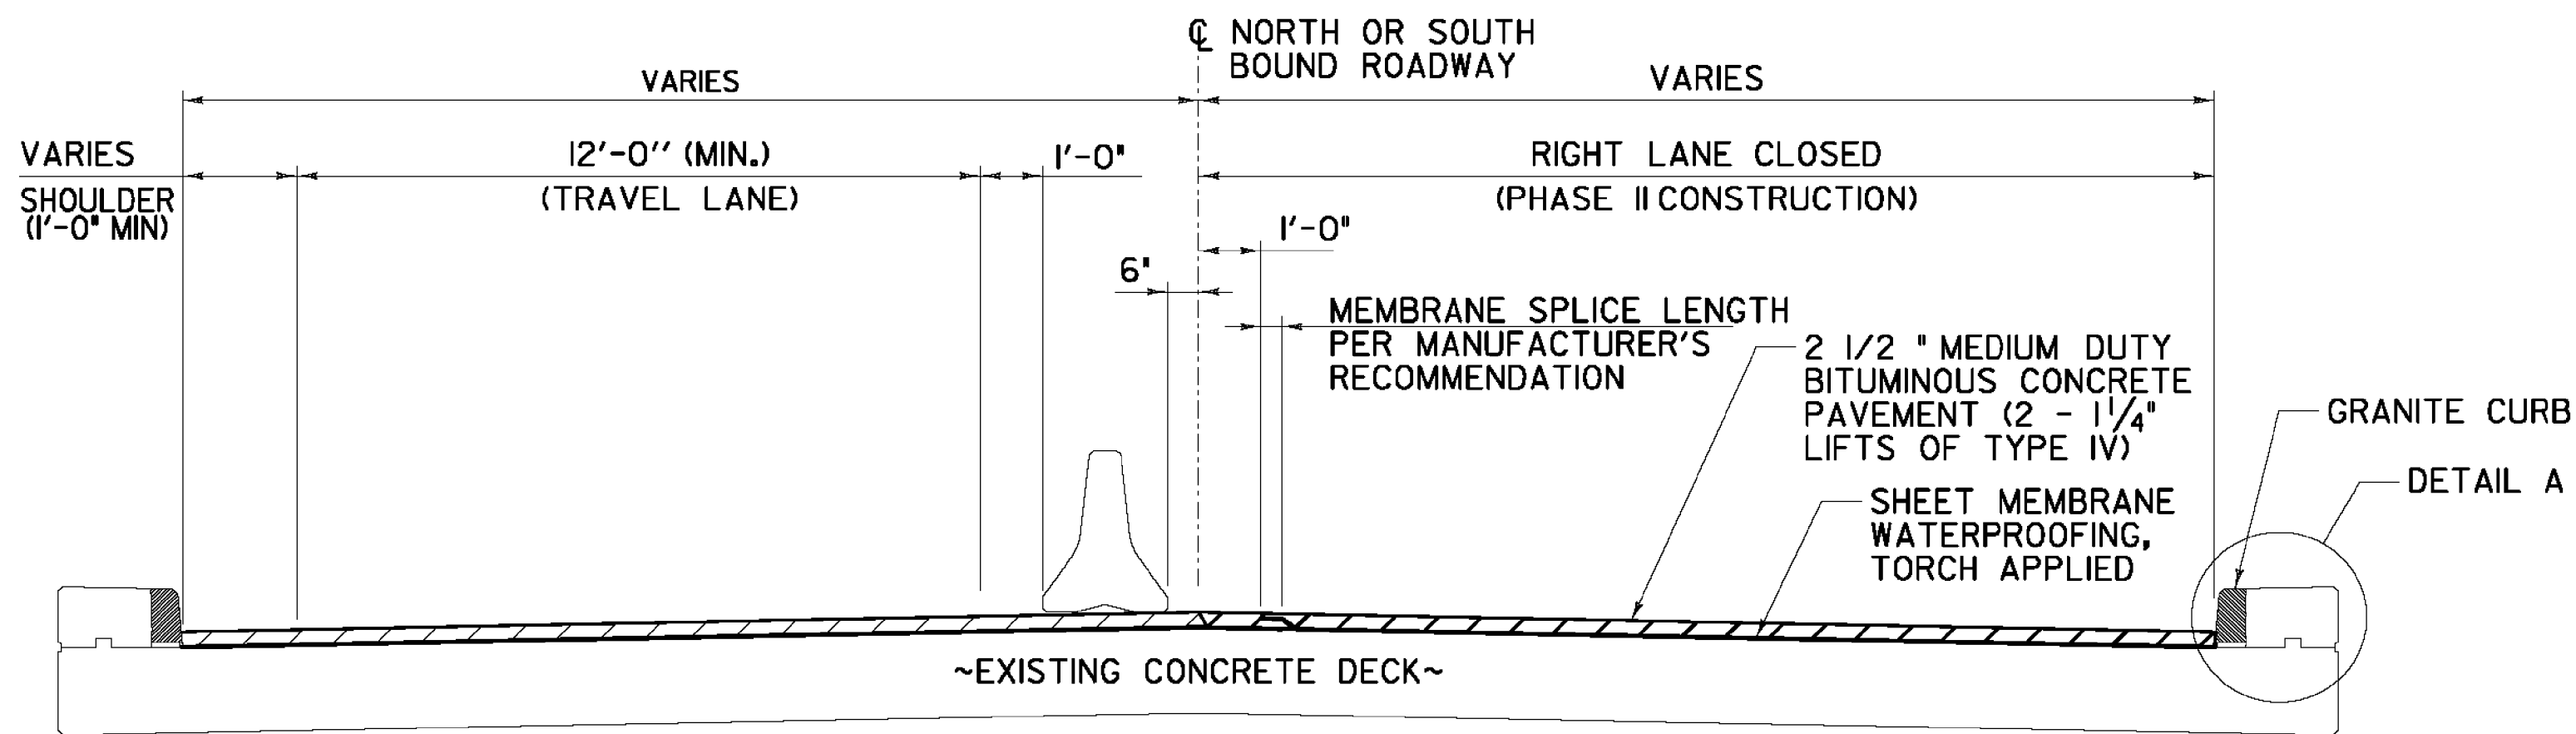

TYPICAL SECTION - PHASE II CONSTRUCTION
NOT TO SCALE

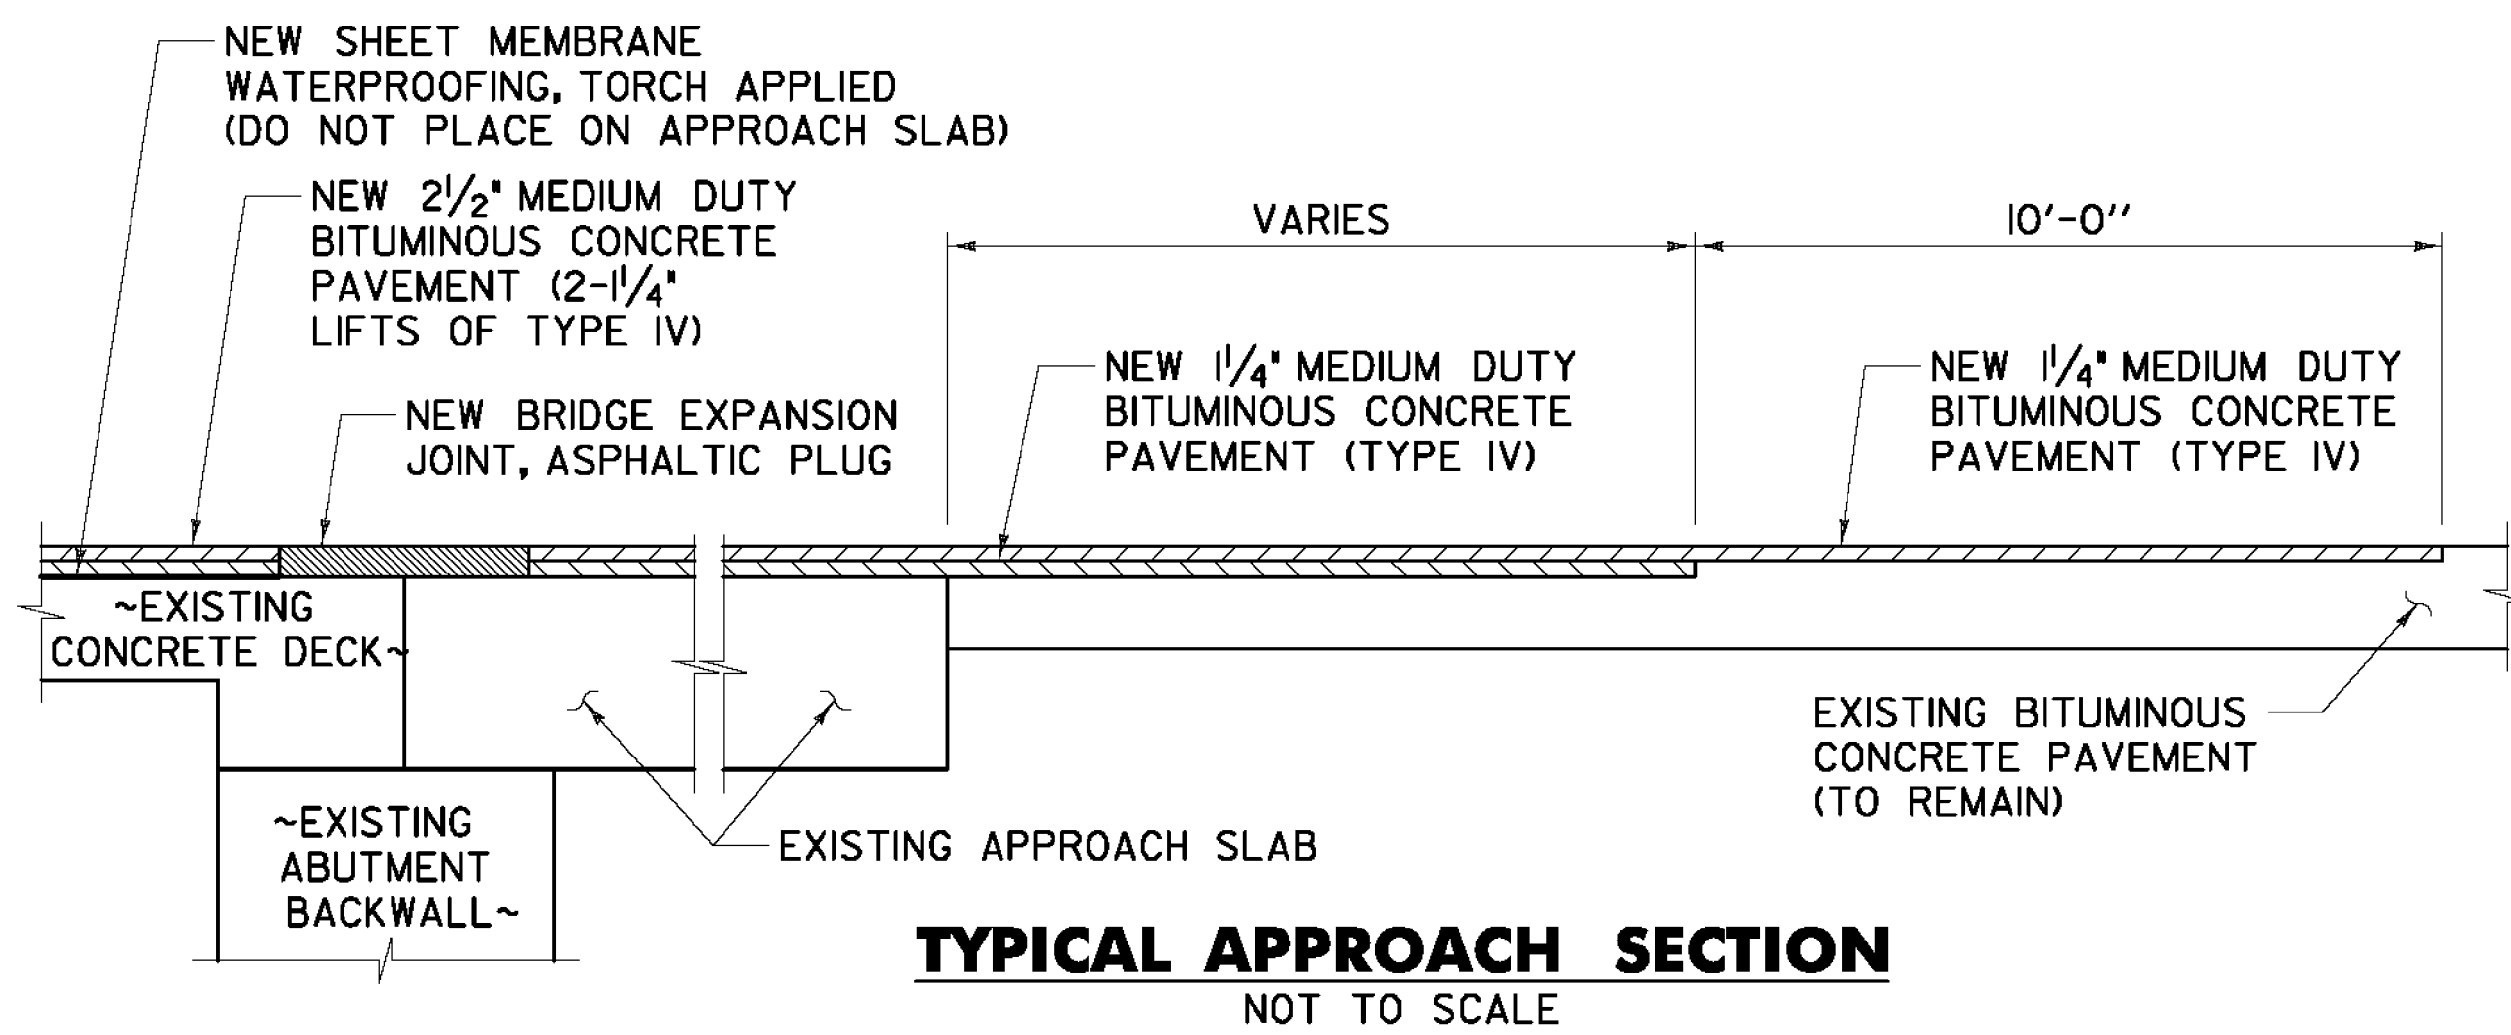

TYPICAL APPROACH SECTION
NOT TO SCALE

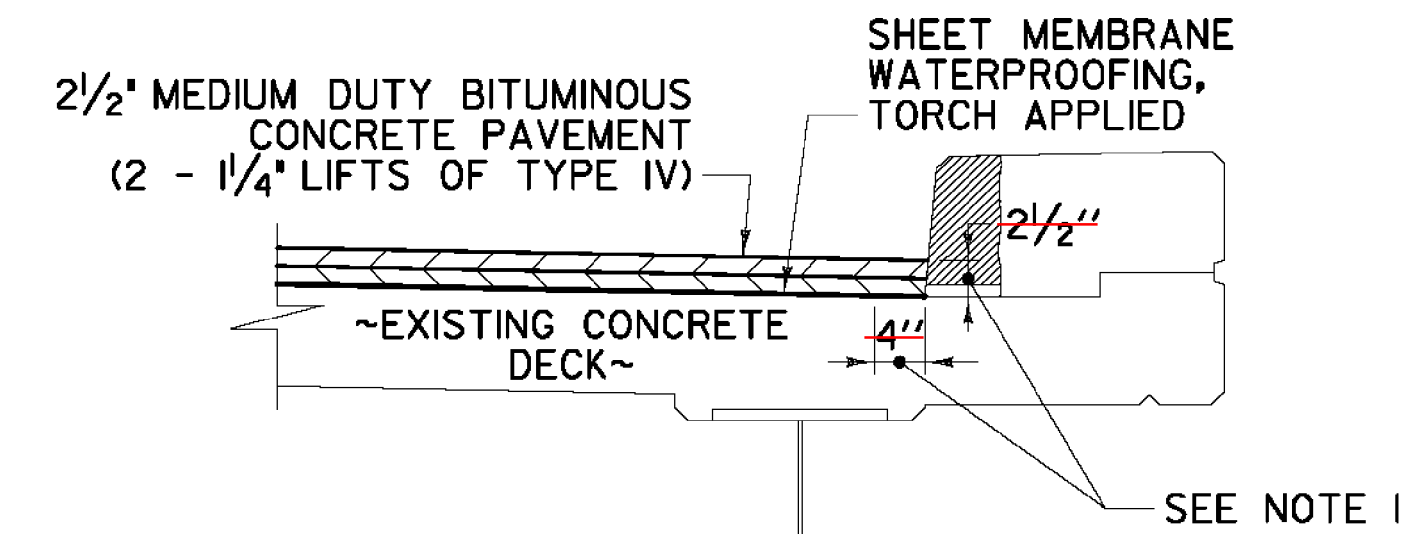

- DETAIL A NOTES:**
- INDICATES AREA ALONG DECK AND UP FACE OF CURB FOR PLACEMENT OF TWO COATS OF POLYURETHANE MEMBRANE.
 - POLYURETHANE MEMBRANE AND BLAST CLEANING SHALL BE INCLUDED IN THE UNIT PRICE BID FOR SHEET MEMBRANE WATERPROOFING, TORCH APPLIED.
 - SHEET MEMBRANE WATERPROOFING SHALL EXTEND TO FACE OF CURB AS SHOWN.
 - IN ADDITION TO THE REQUIREMENTS OF SUBSECTION 519.04, BLAST CLEAN 2 1/2" UP THE FACE OF CURB PRIOR TO PLACING THE MEMBRANE.

DETAIL A
NOT TO SCALE

BRIDGE LENGTH AND WIDTH (CURB TO CURB)

BRIDGE NO.	WIDTH (CURB TO CURB) (FEET)	LENGTH (FEET)
95S	39.33	150.18
96S	39.33	246.17
99S	39.33	136.98
100N	39.33	144.98
102S	39.33	180.29
105N	39.33	89.0
105S	39.33	89.0
107S	39.33	447.43

ASPHALTIC PLUG JOINT REPLACEMENT SCHEDULE

BRIDGE NO.	ABUT. 1	ABUT. 2
95S	43 LF	43 LF
96S	44 LF	44 LF
99S	59 LF	59 LF
100N	59 LF	59 LF
102S	-	41 LF
105N	42 LF	42 LF
105S	42 LF	42 LF
107S	54 LF	54 LF

PROJECT NAME: LYNDON - IRASBURG

PROJECT NUMBER: IM MEMB(29)

FILE NAME: z10a354B1+ConcDets.dgn
PROJECT LEADER: R. Hebert
DESIGNED BY: J. OLUND
BITUMINOUS CONCRETE DETAILS

PLOT DATE: 3/28/2011
DRAWN BY: S. A. Morgan
CHECKED BY: J. OLUND
SHEET 8 OF 55

TYLIN INTERNATIONAL