


651+50 650+50 HH#39 643+50 TRENCH 638+00 CAT PLOW HH#38S 621+00 CAT PLOW

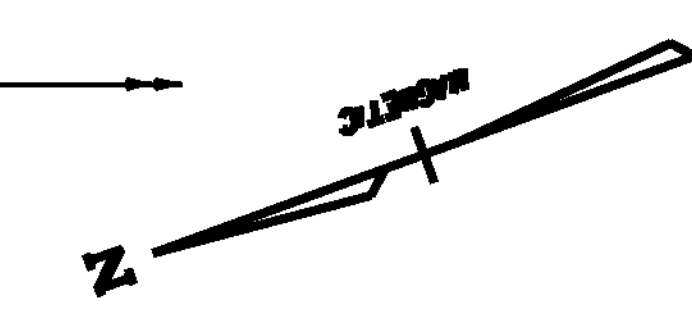

MATCH LINE L-L STA. 654+00

MATCH LINE K-K STA. 592+00

ROCK OUTCROPPING
STA. 638+50 TO STA. 643+00

MM 12
633+60

RUNNING LINE REMAINS IN
THE I-89 SB MEDIAN ROW

WHITE RIVER

VT. 14

LEGEND

	PROPOSED HANDHOLE		CONSTRUCTION NOTE
	PROPOSED SPLICE VAULT		ACTION ITEM
	PROPOSED COMMUNICATION CONDUIT		EXISTING MANHOLE
	EXISTING LIMIT OF WETLAND		

LAYOUT PLAN
SCALE 1" = 200'-0"
200 0 200

TABULATION OF CONSTRUCTION METHODOLOGY

CAT TRACTOR PLOW:	5468'
SPIDER PLOW:	0
TRENCH AND PLACE DUCT OR CONDUIT AS NOTED ON PLAN DRAWINGS:	623'
DIRECTIONAL BORE - 8" BSP CASING:	0
HANDHOLES - 2 AT EACH LOCATION:	2
DIG TEST HOLES - LOCATE FOREIGN STRUCTURES:	13
BRIDGE ATTACHMENT:	0
INSTALL CABLE MARKERS:	8
PULL FIBER OPTIC CABLE INTO DUCT:	6350'
SPLICE VAULT & HANDHOLE SETUP:	0

PROJECT NAME: HARTFORD SHARON	
PROJECT NUMBER: FITS503	
FILE NAME: z06e142L12.dgn	PLOT DATE: 9/15/2010
PROJECT LEADER: J. YOUNG	DRAWN BY: S. GUNN
DESIGNED BY: J. DURANTE	CHECKED BY: J. YOUNG
LAYOUT PLAN (SHEET 12 OF 14)	SHEET 22 OF 70