
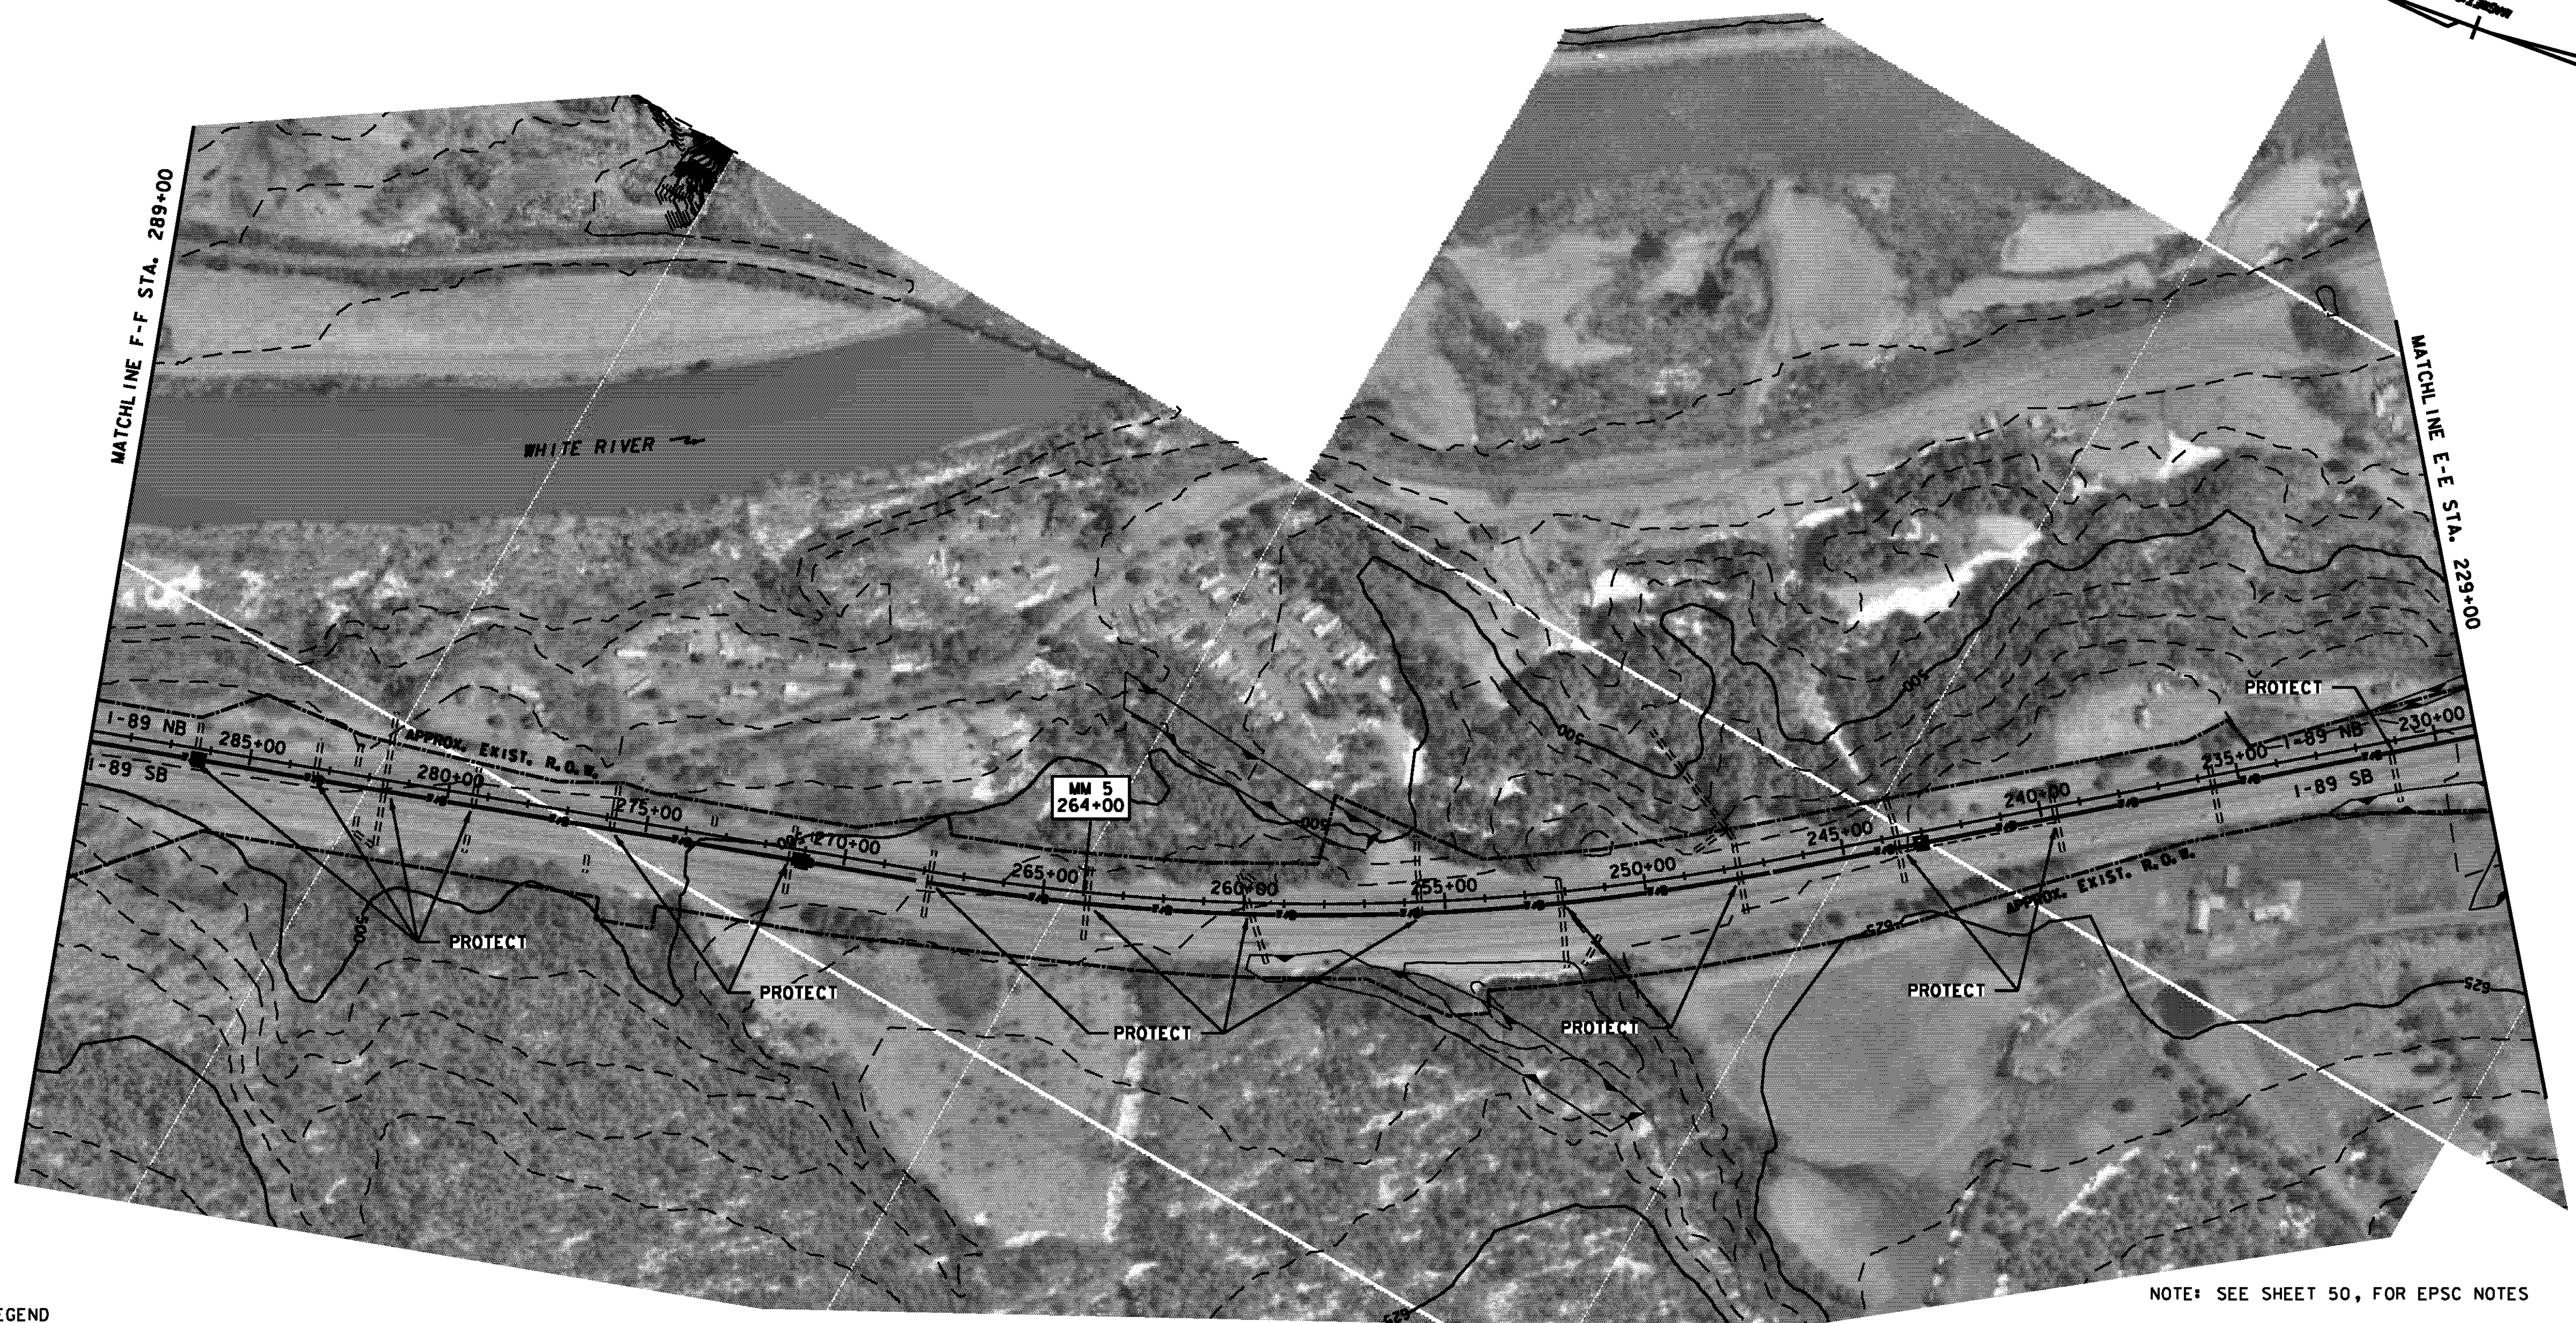


SHALLOW SLOPES
 PLACE MATTING ON DISTURBED AREAS & PROTECT ADJACENT CATCH BASINS/CULVERTS

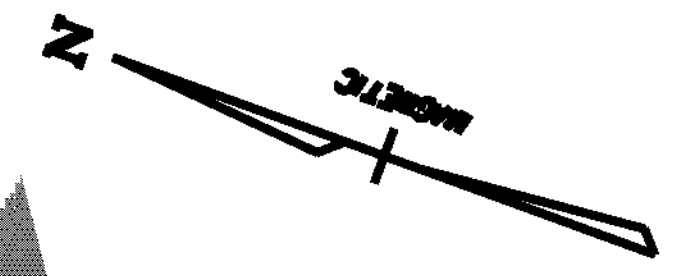

- LEGEND**
- EXISTING LIMIT OF WETLAND
 - EXISTING CULVERT OR DRAINAGE
 - PROPOSED HANDHOLE
 - PROPOSED SPLICE VAULT
 - PROPOSED COMMUNICATION CONDUIT
 - STABILIZED CONSTRUCTION ENTRANCE
 - PROPOSED SILT FENCE

EPSC PLAN
 SCALE 1" = 200'-0"

NOTE: SEE SHEET 50, FOR EPSC NOTES

AREA OF DISTURBANCE
 (THIS SHEET) = 862.5 SF (0.020 AC)

PROJECT NAME: HARTFORD SHARON	
PROJECT NUMBER: FITS503	
FILE NAME: z06e142ER06.dgn	PLOT DATE: 9/15/2010
PROJECT LEADER: J. YOUNG	DRAWN BY: S. GUNN
DESIGNED BY: A. SEAMAN	CHECKED BY: J. WILSON
EPSC PLAN (SHEET 6 OF 14)	SHEET 55 OF 70