
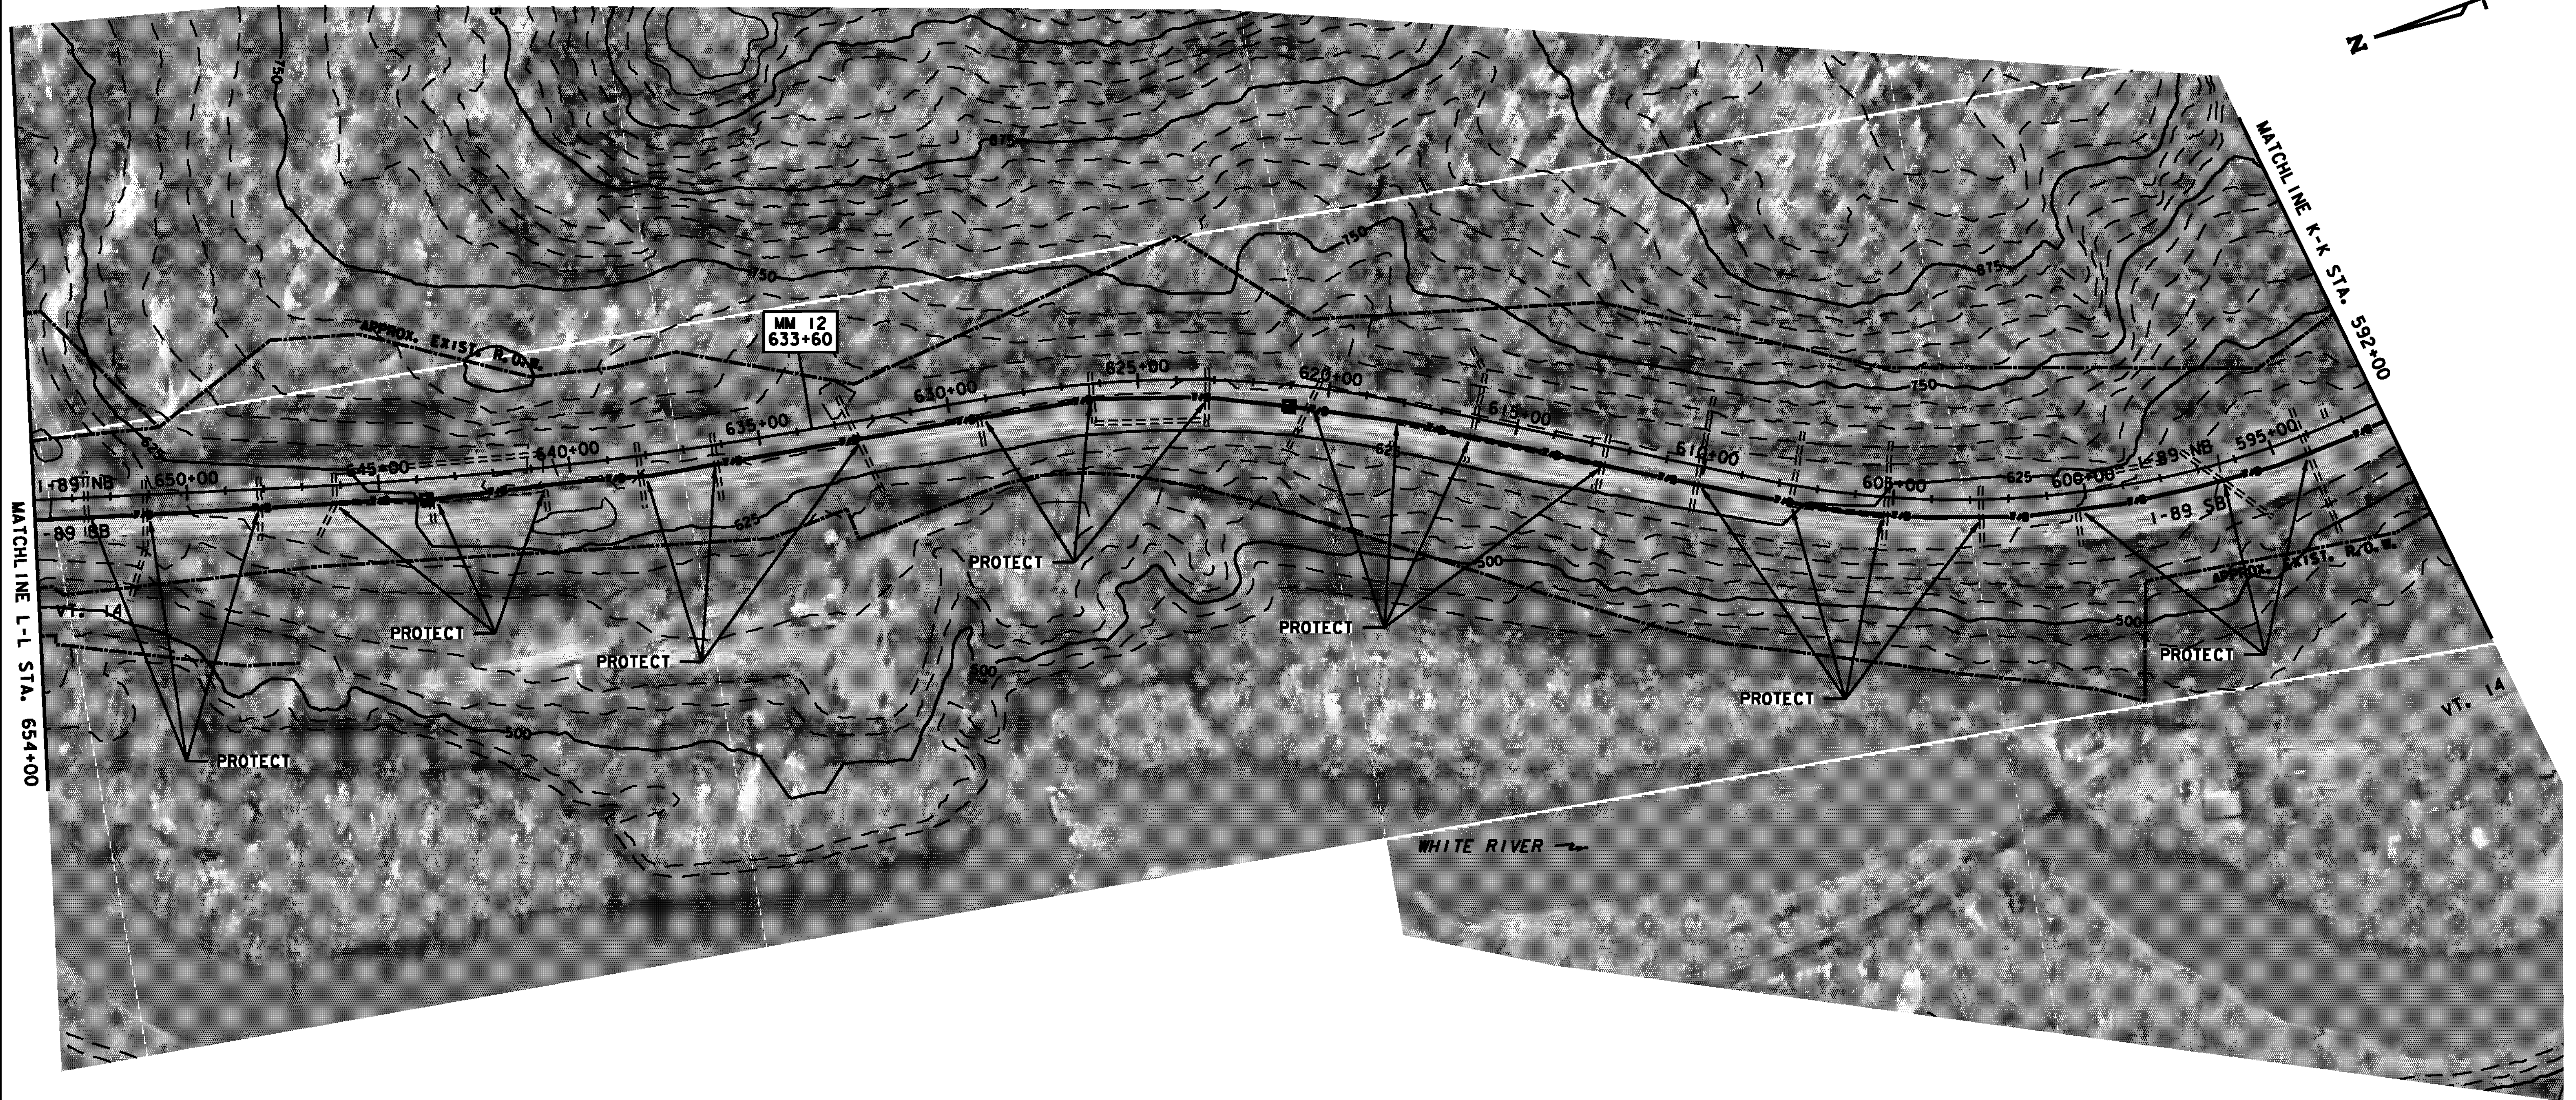


SHALLOW SLOPES
 PLACE MATTING ON DISTURBED AREAS & PROTECT ADJACENT CATCH BASINS/CULVERTS

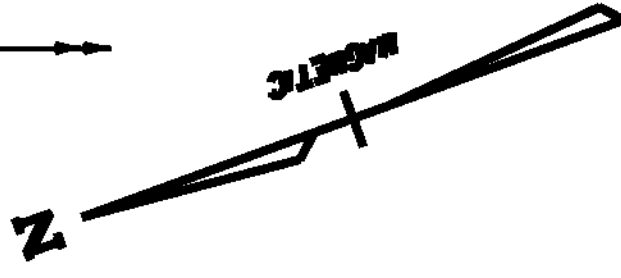

MATCH LINE L-L STA. 654+00

MATCH LINE K-K STA. 592+00

VT. 14

LEGEND

- EXISTING LIMIT OF WETLAND
- EXISTING CULVERT OR DRAINAGE
- PROPOSED HANDHOLE
- PROPOSED SPLICE VAULT
- PROPOSED COMMUNICATION CONDUIT
- STABILIZED CONSTRUCTION ENTRANCE
- PROPOSED SILT FENCE

EPSC PLAN

SCALE 1" = 200'-0"

NOTE: SEE SHEET 50, FOR EPSC NOTES

AREA OF DISTURBANCE
 (THIS SHEET) = 1,294.5 SF (0.030 AC)

PROJECT NAME: HARTFORD SHARON
 PROJECT NUMBER: FITS503

FILE NAME: z06e142ERO12.dgn
 PROJECT LEADER: J. YOUNG
 DESIGNED BY: A. SEAMAN
 EPSC PLAN (SHEET 12 OF 14)

PLOT DATE: 9/15/2010
 DRAWN BY: S. GUNN
 CHECKED BY: J. WILSON
 SHEET 61 OF 70