

INDEX OF SHEETS

- 1 TITLE SHEET
- 2 CRACK SEALING TYPICAL
- 3 QUANTITY SHEET
- 4 LOCATION LAYOUT
- 5 CRACK SEALING LOCATION DETAIL
- 6 - 12 INTERCHANGE DETAIL SHEETS


STANDARDS

E-100	CONSTRUCTION APPROACH SIGNS	01/02/04
E-101	CONSTRUCTION SIGN DETAIL	05/30/03
E-102A	CONSTRUCTION SIGN DETAIL	05/01/04
E-102	CONSTRUCTION SIGN DETAIL	06/30/03
E-103	MAINLINE TRAFFIC CONTROL, DIVIDED HIGHWAY	03/01/04
	ONE LANE CLOSED	
E-105	TRAFFIC CONTROL FOR CONSTRUCTION VEHICLE U-TURNS ON DIVIDED HIGHWAY	05/01/04
E-106	TRAFFIC CONTROL MISCELLANEOUS DETAILS	03/01/04
E-110	MAJOR MAINTENANCE OPERATION LANE CLOSURE	08/08/95

STATE OF VERMONT AGENCY OF TRANSPORTATION




PROPOSED IMPROVEMENT STATEWIDE CRACK SEALING

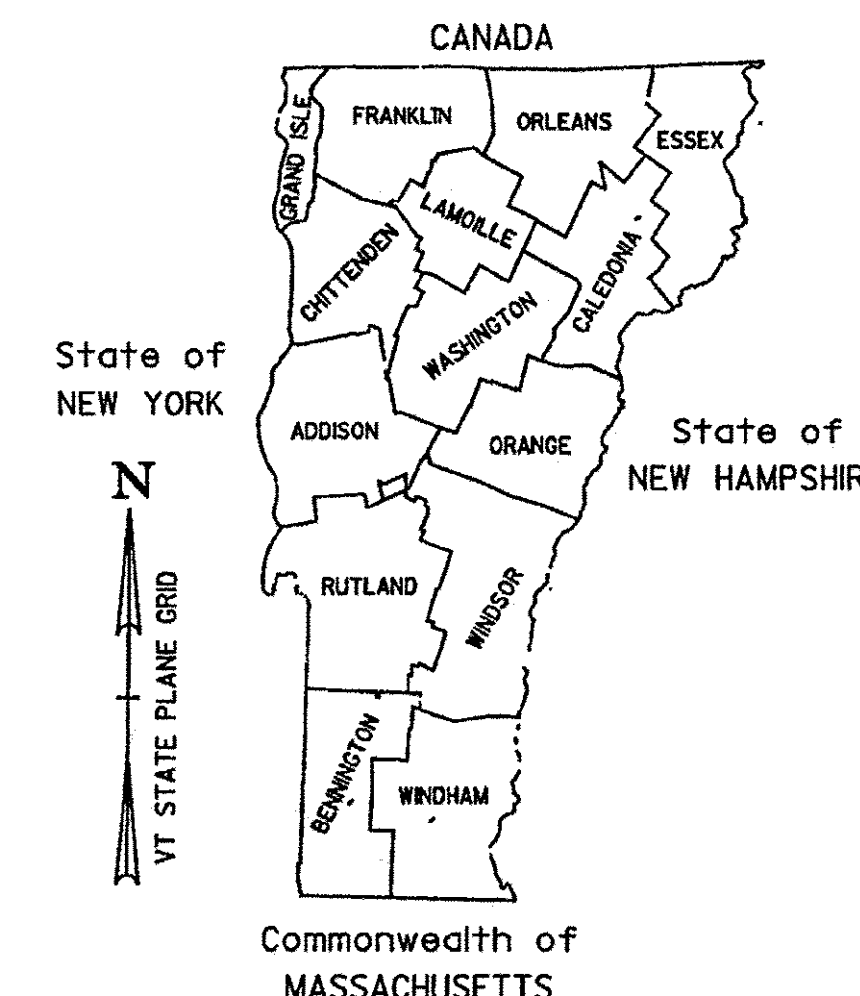


WORK TO BE PERFORMED UNDER THIS PROJECT INCLUDES THE ROUTING AND SEALING OF CRACKS IN BITUMINOUS CONCRETE PAVEMENT ON EXISTING STATE, U.S., AND INTERSTATE HIGHWAYS AND THE APPROPRIATE TRAFFIC CONTROL.

RECORD PLANS	
CONTRACTOR:	NICOM COATINGS CORP- BERLIN, VT
RESIDENT ENGINEER:	BRIGITTE CODLING
CONSTRUCTION BEGAN:	JULY 18, 2011
CONSTRUCTION COMPLETE:	OCTOBER 12, 2011
RECORD PLANS BY:	BRIGITTE CODLING & JENNAHYDE
I HEREBY CERTIFY THAT ALL THE CONSTRUCTION REQUIRED BY THIS SET OF DRAWINGS HAS BEEN ACCOMPLISHED AS INDICATED HEREIN.	
BY <i>Brigitte Codling</i>	RESIDENT ENGINEER
DATE <i>Sept 4, 2012</i>	
NOTE: Any further information concerning final quantities, amounts or other details relative to this project may be found at Central Files in the electronic archives.	

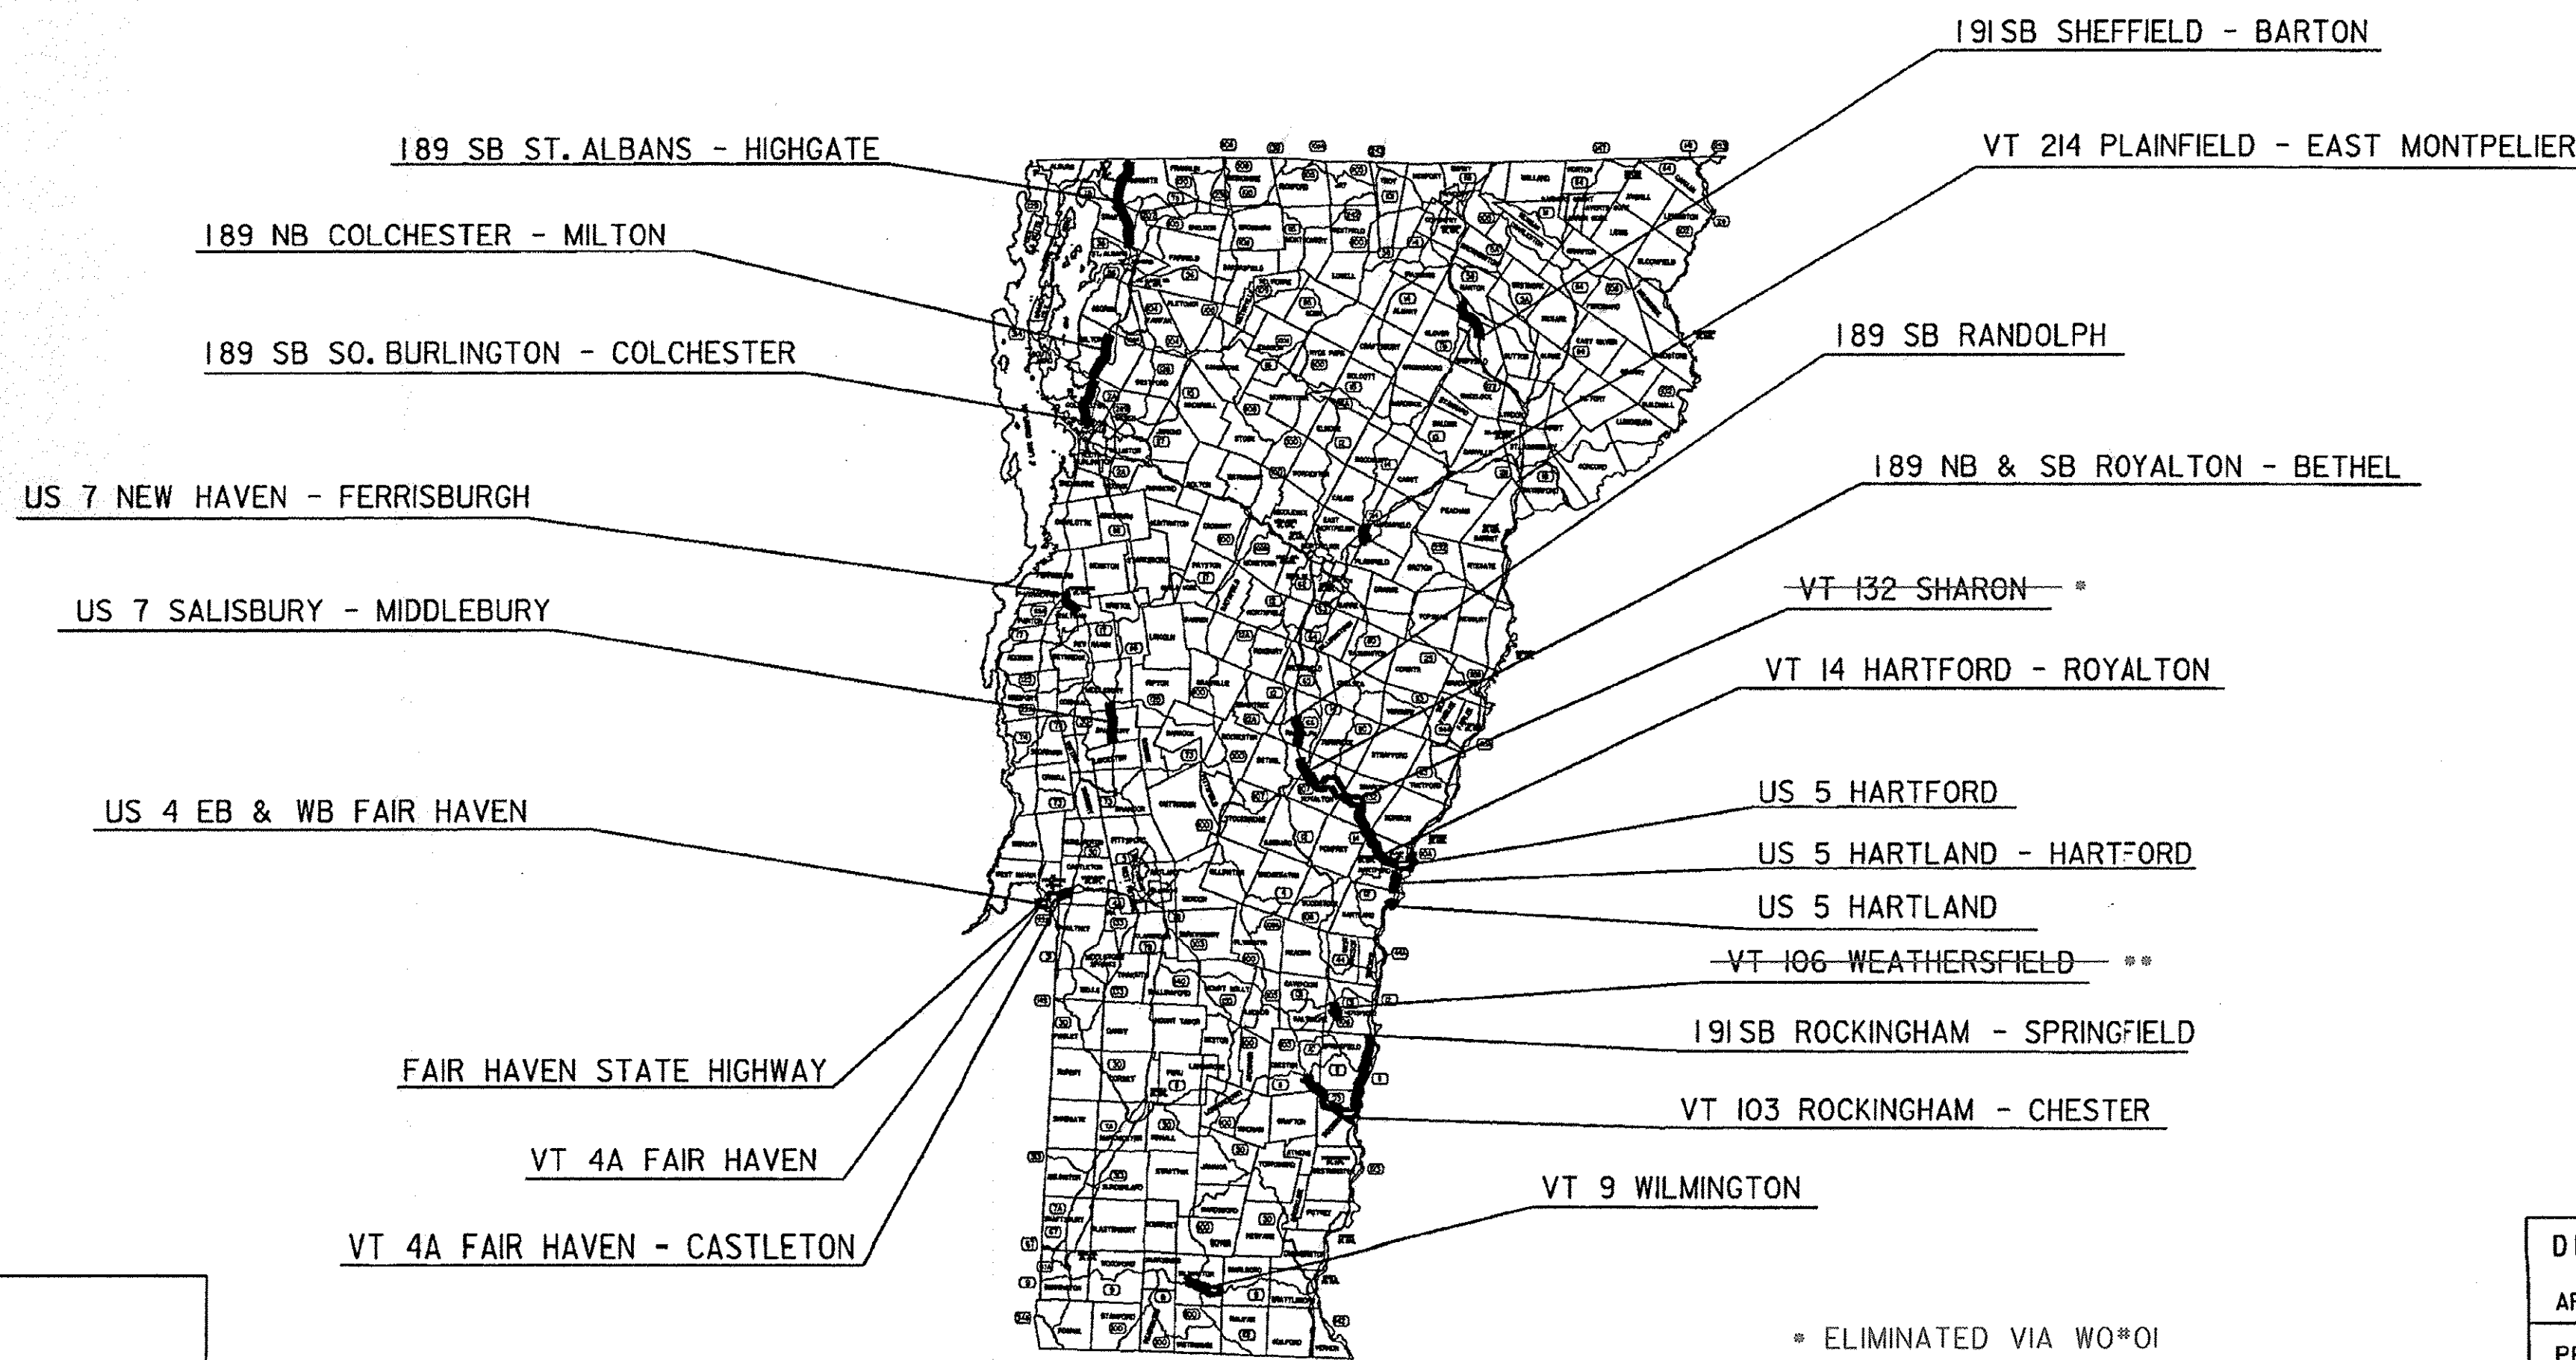

QUALITY ASSURANCE PROGRAM: LEVEL I

CONVENTIONAL SYMBOLS	
COUNTY LINE	
TOWN LINE	
LIMITS OF ACCESS	
POINT OF ACCESS	
FENCE LINE	
STONE WALL	
TRAVELED WAY	
GUARD RAIL	
RAILROAD	
SURVEY LINE	
CULVERT	
POWER POLE	
TELEPHONE POLE	
TREES	
CONTROL OF ACCESS	
PROPERTY LINE	
R.O.W. TAKING LINE	
SLOPE RIGHTS	
TOP OF CUT	
TOE OF SLOPE	

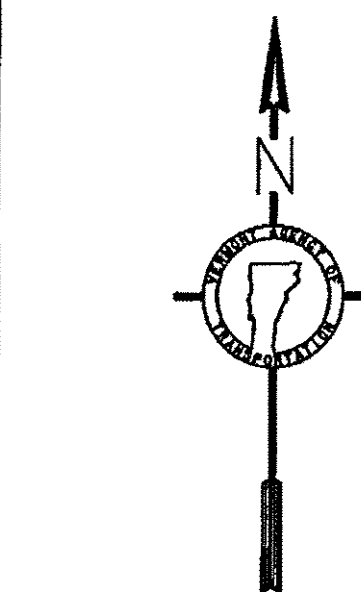

SURVEYED BY : N/A
 SURVEYED DATE : N/A
 DATUM
 VERTICAL N/A
 HORIZONTAL N/A

THESE PLANS ARE SUBJECT TO SUCH ENGINEERING CHANGES AS MAY BE REQUIRED BY THE FEDERAL HIGHWAY ADMINISTRATION OR THE DIRECTOR OF PROGRAM DEVELOPMENT.
 CONSTRUCTION IS TO BE CARRIED ON IN ACCORDANCE WITH THESE PLANS AND THE STANDARD SPECIFICATIONS FOR CONSTRUCTION DATED 2006, AS APPROVED BY THE FEDERAL HIGHWAY ADMINISTRATION ON JUNE 15, 2006 FOR USE ON THIS PROJECT, INCLUDING ALL SUBSEQUENT REVISIONS AND SUCH REVISED SPECIFICATIONS AND SPECIAL PROVISIONS AS ARE INCORPORATED IN THESE PLANS.

DIRECTOR OF PROGRAM DEVELOPMENT	
APPROVED <i>[Signature]</i>	DATE 5-3-11
PROJECT MANAGER : MIKE FOWLER	
PROJECT NAME : STATEWIDE	
PROJECT NUMBER : STP CRAK (29)	
SHEET 1 OF 12 SHEETS	

* ELIMINATED VIA WO*01
 ** ELIMINATED VIA WO*04