

191 SB SHEFFIELD - BARTON

189 SB ST. ALBANS - HIGHGATE

VT 214 PLAINFIELD - EAST MONTPELIER

189 NB COLCHESTER - MILTON

189 SB SO. BURLINGTON - COLCHESTER

189 SB RANDOLPH

189 NB & SB ROYALTON - BETHEL

~~VT 132 SHARON *~~

VT 14 HARTFORD - ROYALTON

US 5 HARTFORD

US 5 HARTLAND - HARTFORD

US 5 HARTLAND

~~VT 106 WEATHERSFIELD **~~

191 SB ROCKINGHAM - SPRINGFIELD

VT 103 ROCKINGHAM - CHESTER

VT 9 WILMINGTON

US 7 NEW HAVEN - FERRISBURGH


US 7 SALISBURY - MIDDLEBURY

US 4 EB & WB FAIR HAVEN

FAIR HAVEN STATE HIGHWAY

VT 4A FAIR HAVEN

VT 4A FAIR HAVEN - CASTLETON

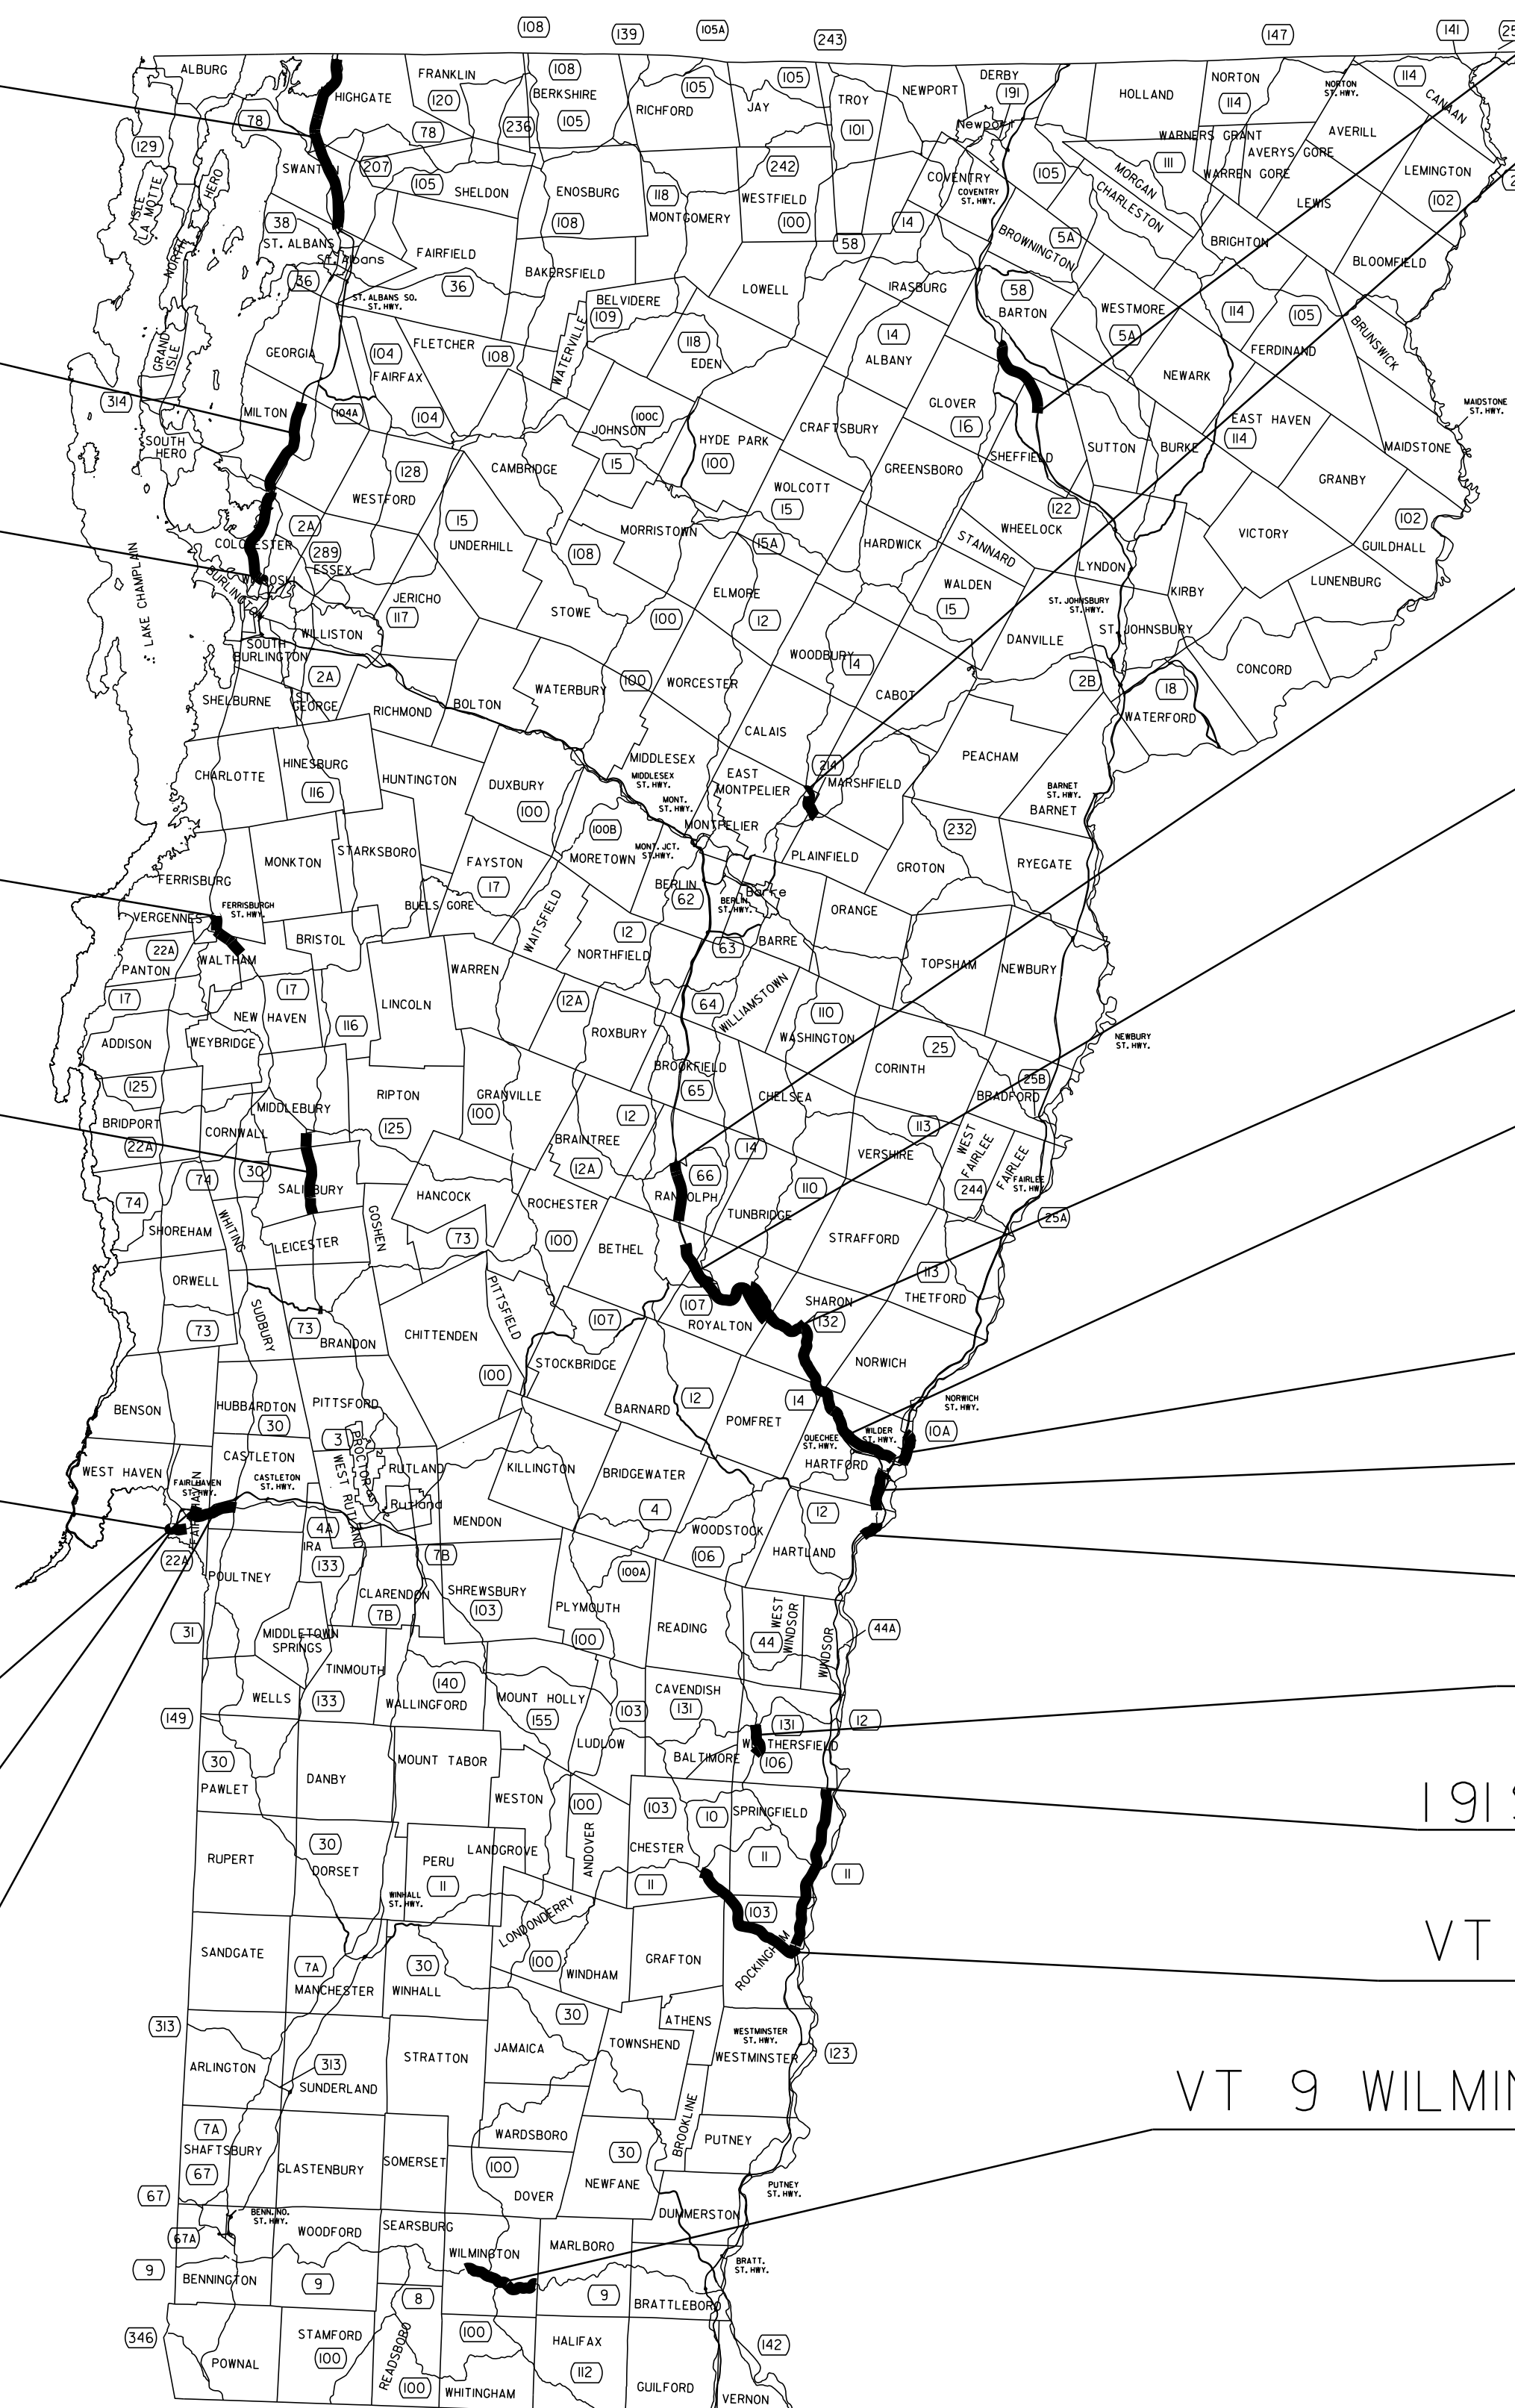

* ELIMINATED VIA WO#01
** ELIMINATED VIA WO#04

**LOCATION
LAYOUT**

PROJECT NAME: STATEWIDE
PROJECT NUMBER: STP CRAK(29)

FILE NAME: p10k430.dgn
PROJECT LEADER: FOWLER
DESIGNED BY: LOCKE
p10k430i01.i

PLOT DATE: 28-SEP-2012 13:55
DRAWN BY: LOCKE
CHECKED BY: PAVT MGMT
SHEET 4 OF 12