




END CRACK SEALING AT  
EXISTING PAVING  
JOINT

RAMPS REQUIRING CRACK SEALING

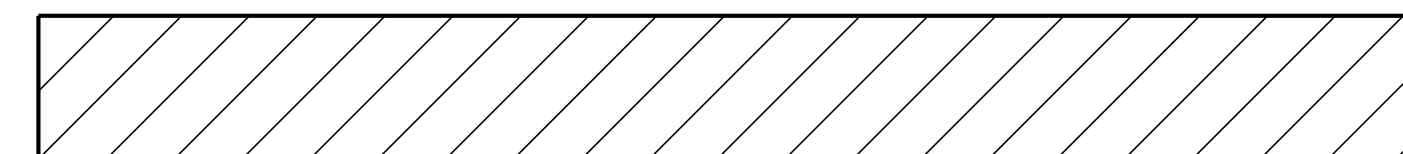

# BURLINGTON INTERCHANGE #14

## I-89

NOT TO SCALE

<b>INTERCHANGE DETAIL SHEET # 1</b>	PROJECT NAME: STATEWIDE	PLOT DATE: 28-SEP-2012 13:50
	PROJECT NUMBER: STP CRAK(29)	DRAWN BY: LOCKE
	FILE NAME: pi0k430.dgn PROJECT LEADER: FOWLER DESIGNED BY: LOCKE pi0k430Int1.i	CHECKED BY: PAVT MGMT SHEET 6 OF 12