


RAMPS REQUIRING CRACK SEALING

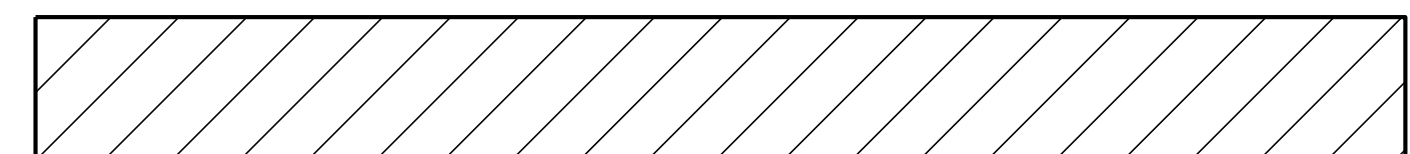

BETHEL INTERCHANGE # 3
I-89

NOT TO SCALE

INTERCHANGE
DETAIL
SHEET # 2

PROJECT NAME: STATEWIDE
PROJECT NUMBER: STP CRAK(29)

FILE NAME: pi0k430.dgn
PROJECT LEADER: FOWLER
DESIGNED BY: LOCKE
pi0k430in+2.i

PLOT DATE: 28-SEP-2012 13:51
DRAWN BY: LOCKE
CHECKED BY: PAVT MGMT
SHEET 7 OF 12