

VT ROUTE 78


← INTERSTATE 89 NORTHBOUND

INTERSTATE 89 SOUTHBOUND →

RAMP "C"

RAMP "D"

RAMPS REQUIRING CRACK SEALING

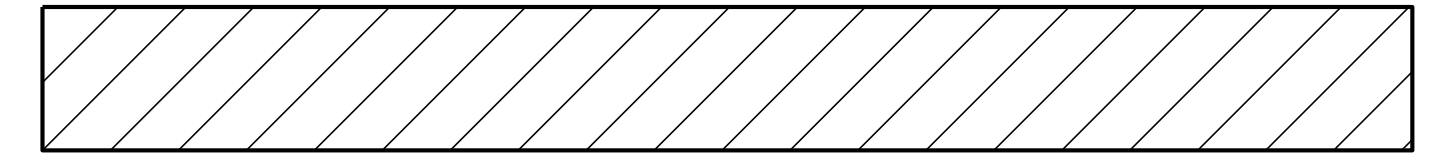

# SWANTON INTERCHANGE # 21 I-89

NOT TO SCALE

**INTERCHANGE  
DETAIL  
SHEET # 4**

PROJECT NAME: STATEWIDE  
PROJECT NUMBER: STP CRAK(29)

FILE NAME: p10k430.dgn  
PROJECT LEADER: FOWLER  
DESIGNED BY: LOCKE  
p10k430in+4.i

PLOT DATE: 28-SEP-2012 13:51  
DRAWN BY: LOCKE  
CHECKED BY: PAVT MGMT  
SHEET 9 OF 12