


SPRINGFIELD INTERCHANGE #7
I-91

RAMPS REQUIRING CRACK SEALING

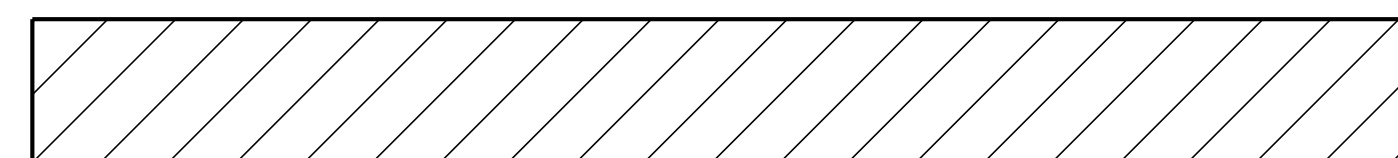

NOT TO SCALE

| | | | |
|---|------------------------------|------------------------|------------------------------|
| INTERCHANGE DETAIL SHEET # 7 | PROJECT NAME: STATEWIDE | FILE NAME: p10k430.dgn | PLOT DATE: 28-SEP-2012 13:51 |
| | PROJECT NUMBER: STP CRAK(29) | PROJECT LEADER: FOWLER | DRAWN BY: LOCKE |
| | DESIGNED BY: LOCKE | DESIGNED BY: LOCKE | CHECKED BY: PAVT MGMT |
| | | p10k430in+7.i | SHEET 12 OF 12 |