




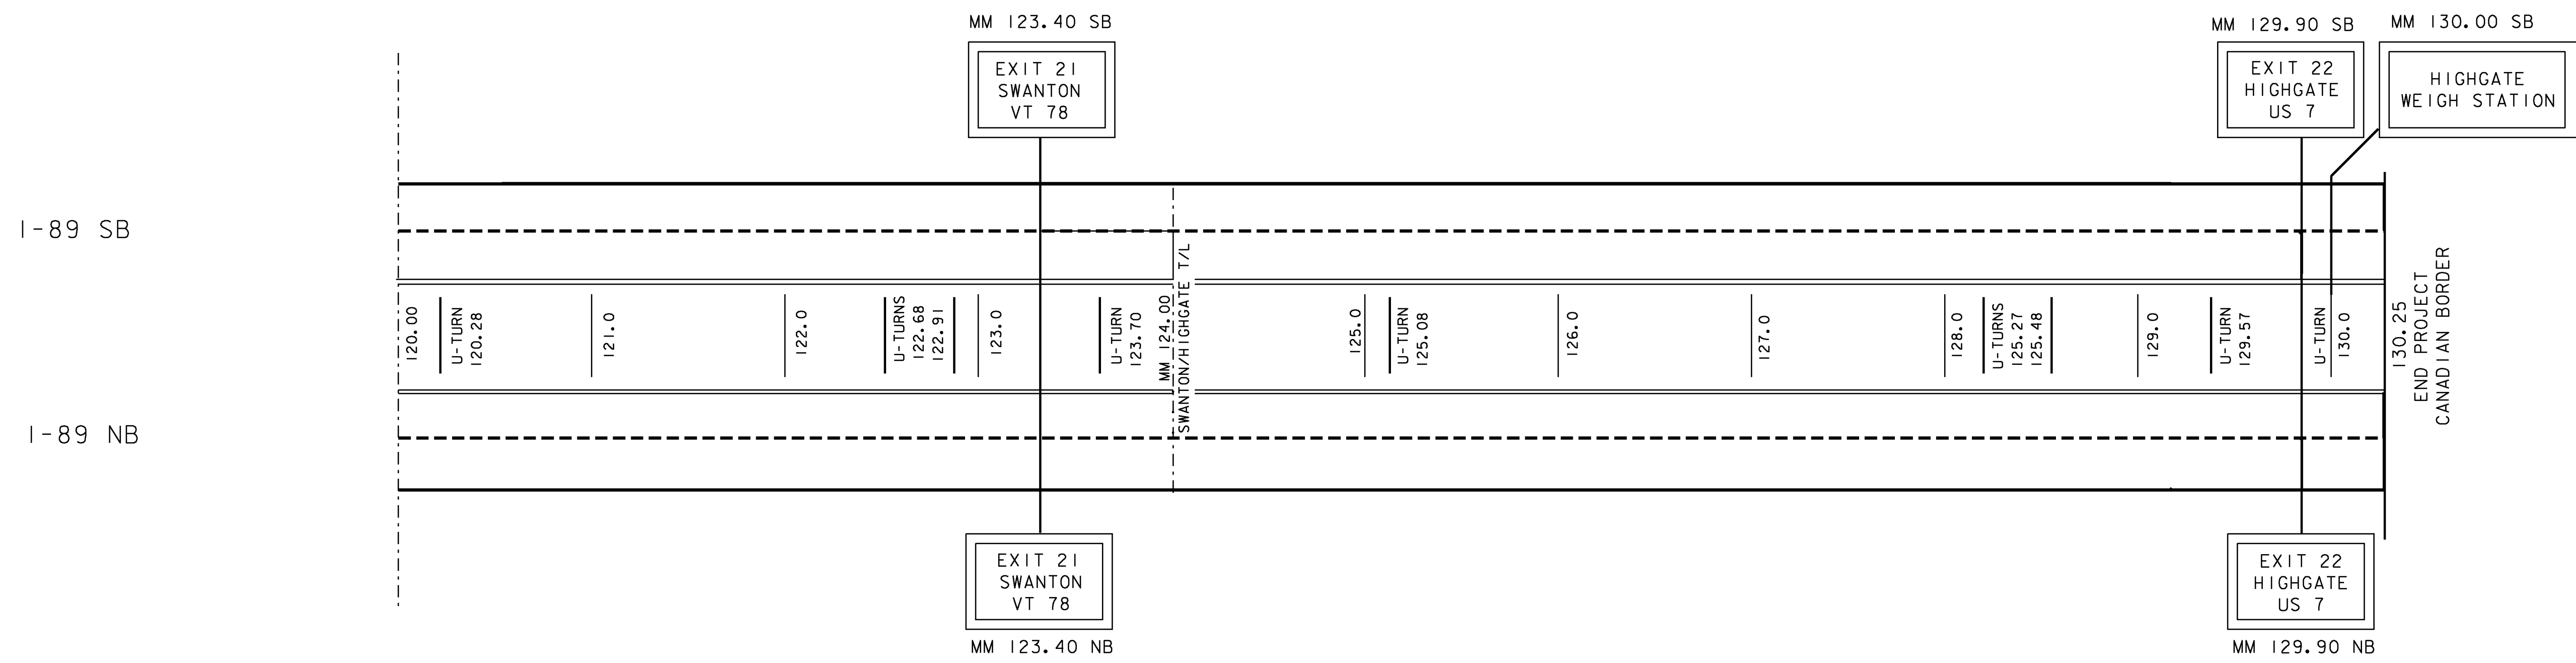


INTERSTATE 89 MAINLINE TREATMENT SCHEMATIC

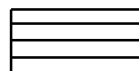

- LEGEND**
-  = AREA NOT TO BE PAINTED
 -  = AREA TO BE DONE AT NIGHT
 -  = 6' SOLID WHITE LINE
 -  = 6' DASHED WHITE LINE
 -  = 6' SOLID YELLOW LINE

NOT TO SCALE

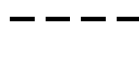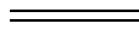I-89 MAINLINE TREATMENT SCHEMATIC SHEET 5	PROJECT NAME: STATEWIDE	
	PROJECT NUMBER: IMG MARK(111)	
	DESIGN FILE NAME: Ila008.dgn	PLOT DATE: 10-MAR-2011
	PROJECT MANAGER: A GAMBLE	DRAWN BY: KAS
	IPARM FILE NAME: Ila008ms5.1	SHEET: 19 OF 29