


INTERSTATE 91 MAINLINE TREATMENT SCHEMATIC

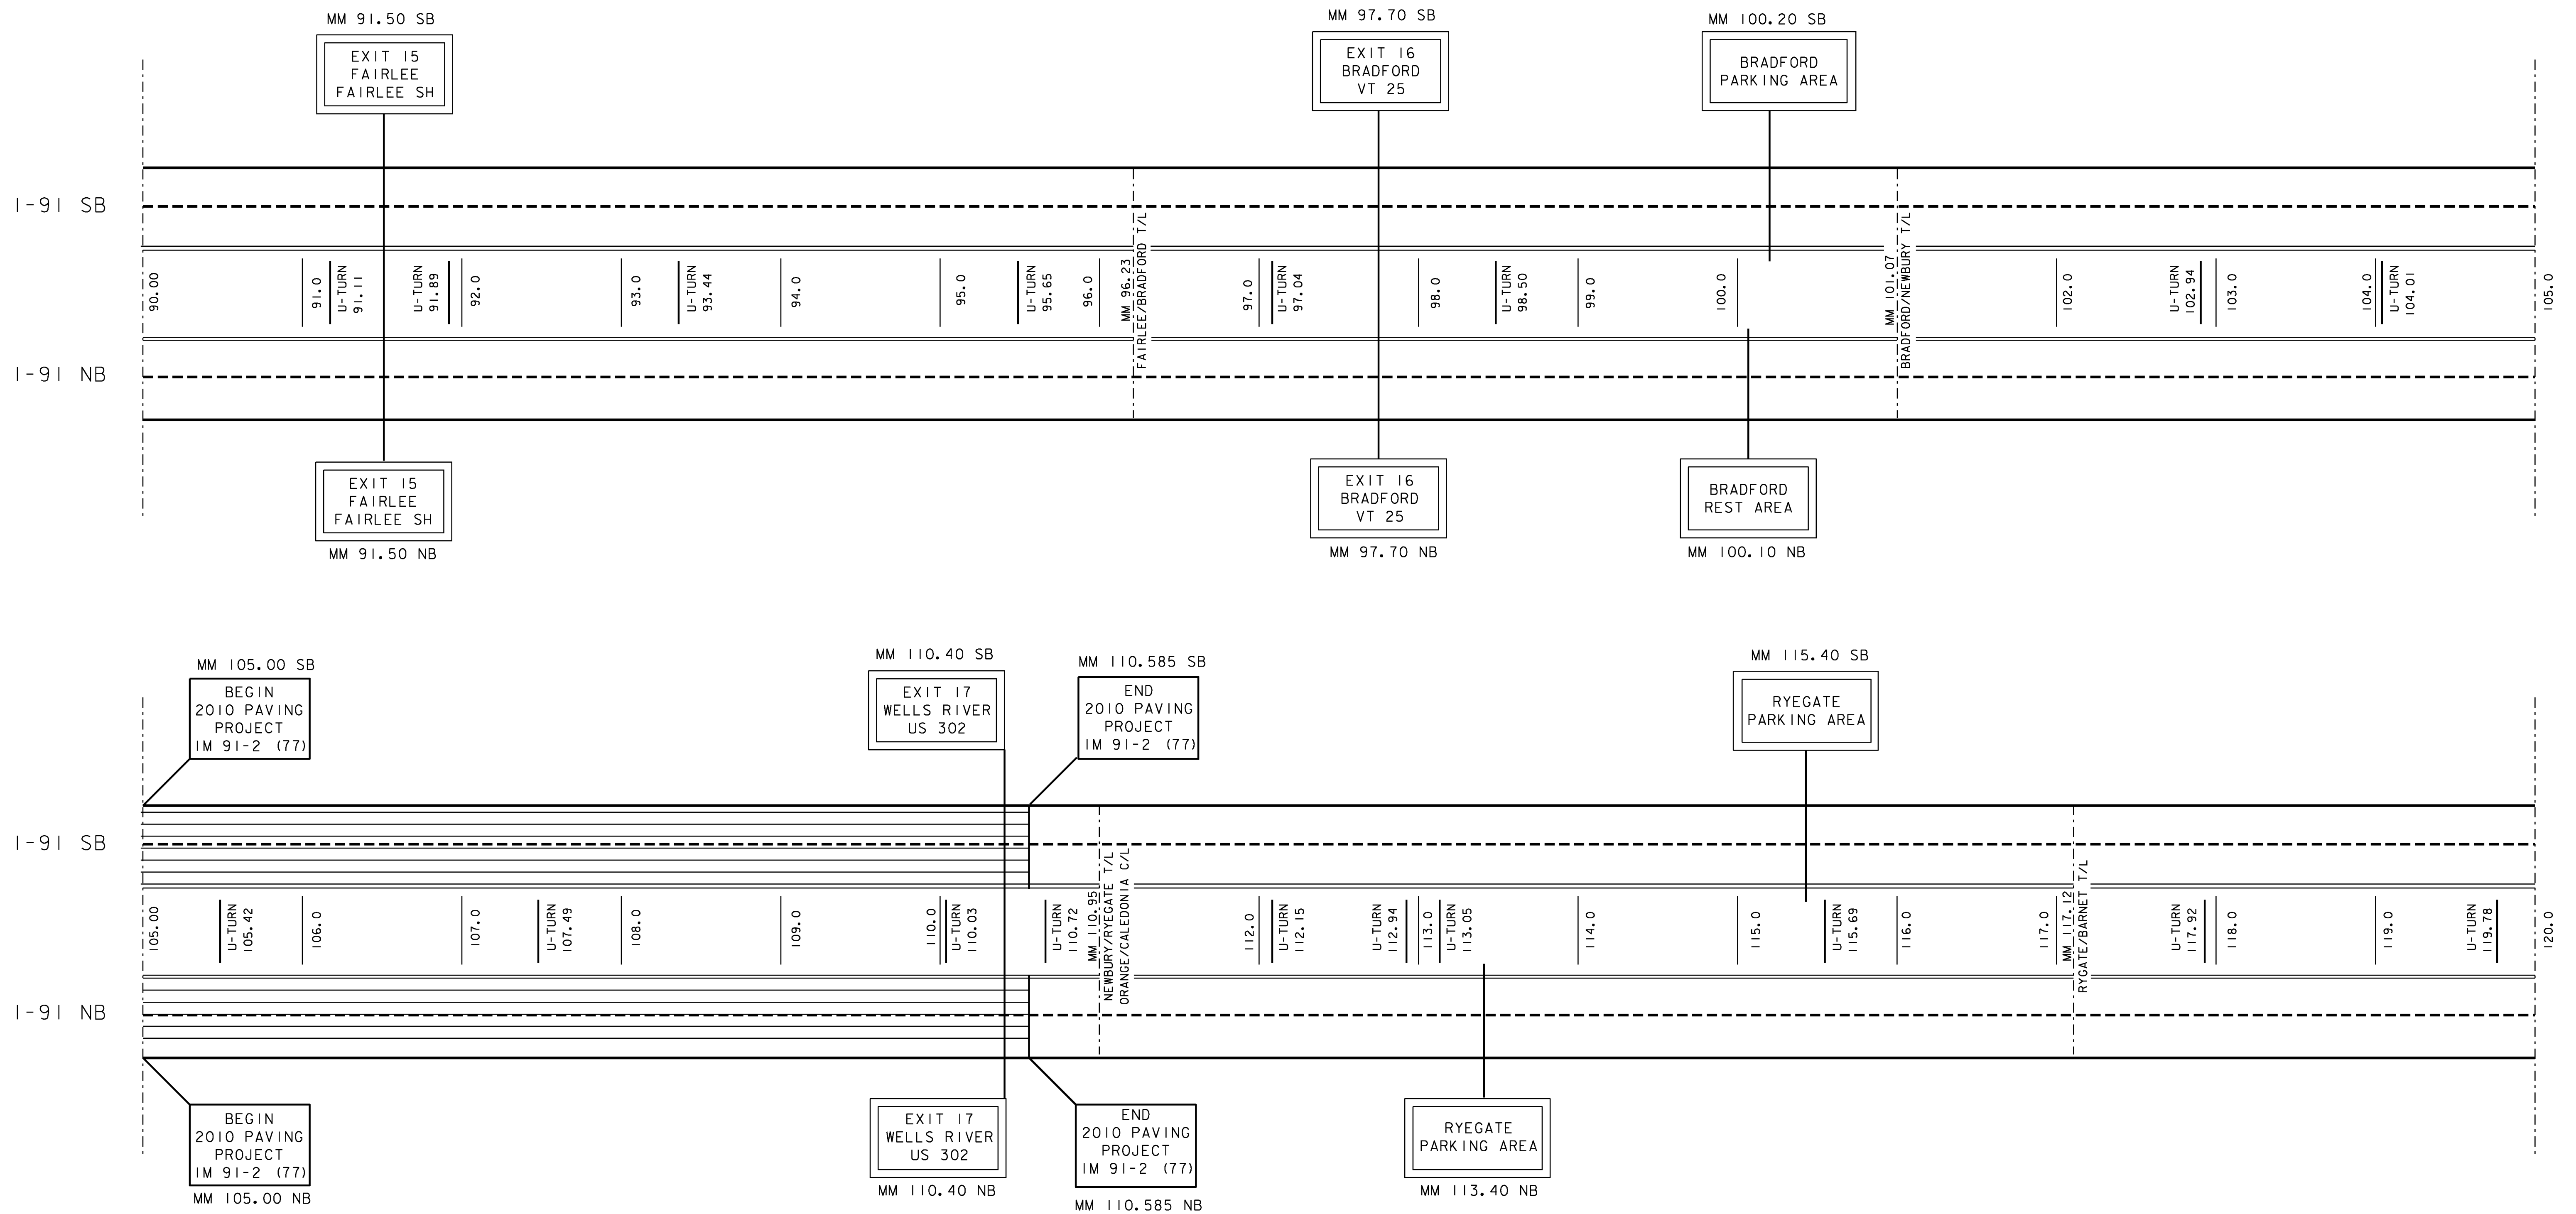

NOT TO SCALE

I-91 MAINLINE TREATMENT SCHEMATIC SHEET 4	PROJECT NAME: STATEWIDE	
	PROJECT NUMBER: IMG MARK(111)	
	DESIGN FILE NAME: Ila008.dgn	PLOT DATE: 10-MAR-2011
PROJECT MANAGER: A GAMBLE	DRAWN BY: KAS	
IPARM FILE NAME: Ila008ms9.1	SHEET: 24 OF 29	