


**INDEX OF SHEETS**

SEE SHEET 2


RECORD PLANS	
CONTRACTOR:	COLD RIVER BRIDGES, LLC- KEENE, NH
RESIDENT ENGINEER:	GERALD "BUTCH" COLBY
CONSTRUCTION BEGAN:	APRIL 2, 2012
CONSTRUCTION COMPLETE:	SEPTEMBER 10, 2012
RECORD PLANS BY:	GERALD BUTCH COLBY & JENNA HYDE
I HEREBY CERTIFY THAT ALL THE CONSTRUCTION REQUIRED BY THIS SET OF DRAWINGS HAS BEEN ACCOMPLISHED AS INDICATED HEREIN.	
BY:	<i>[Signature]</i> RESIDENT ENGINEER
DATE:	8/10/13
NOTE: Any further information concerning final quantities, amounts or other details relative to this project may be found at Central Files in the electronic archives.	

STATE OF VERMONT  
AGENCY OF TRANSPORTATION

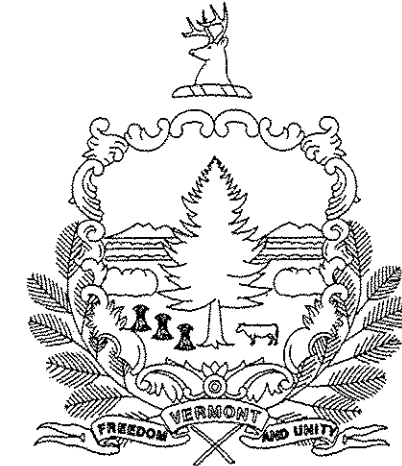

PROPOSED IMPROVEMENT  
BRIDGE PROJECT

TOWNS OF WESTMINSTER, WEATHERSFIELD, & NORWICH  
COUNTIES OF WINDHAM & WINDSOR  
PROJECT IM MEMB(30)

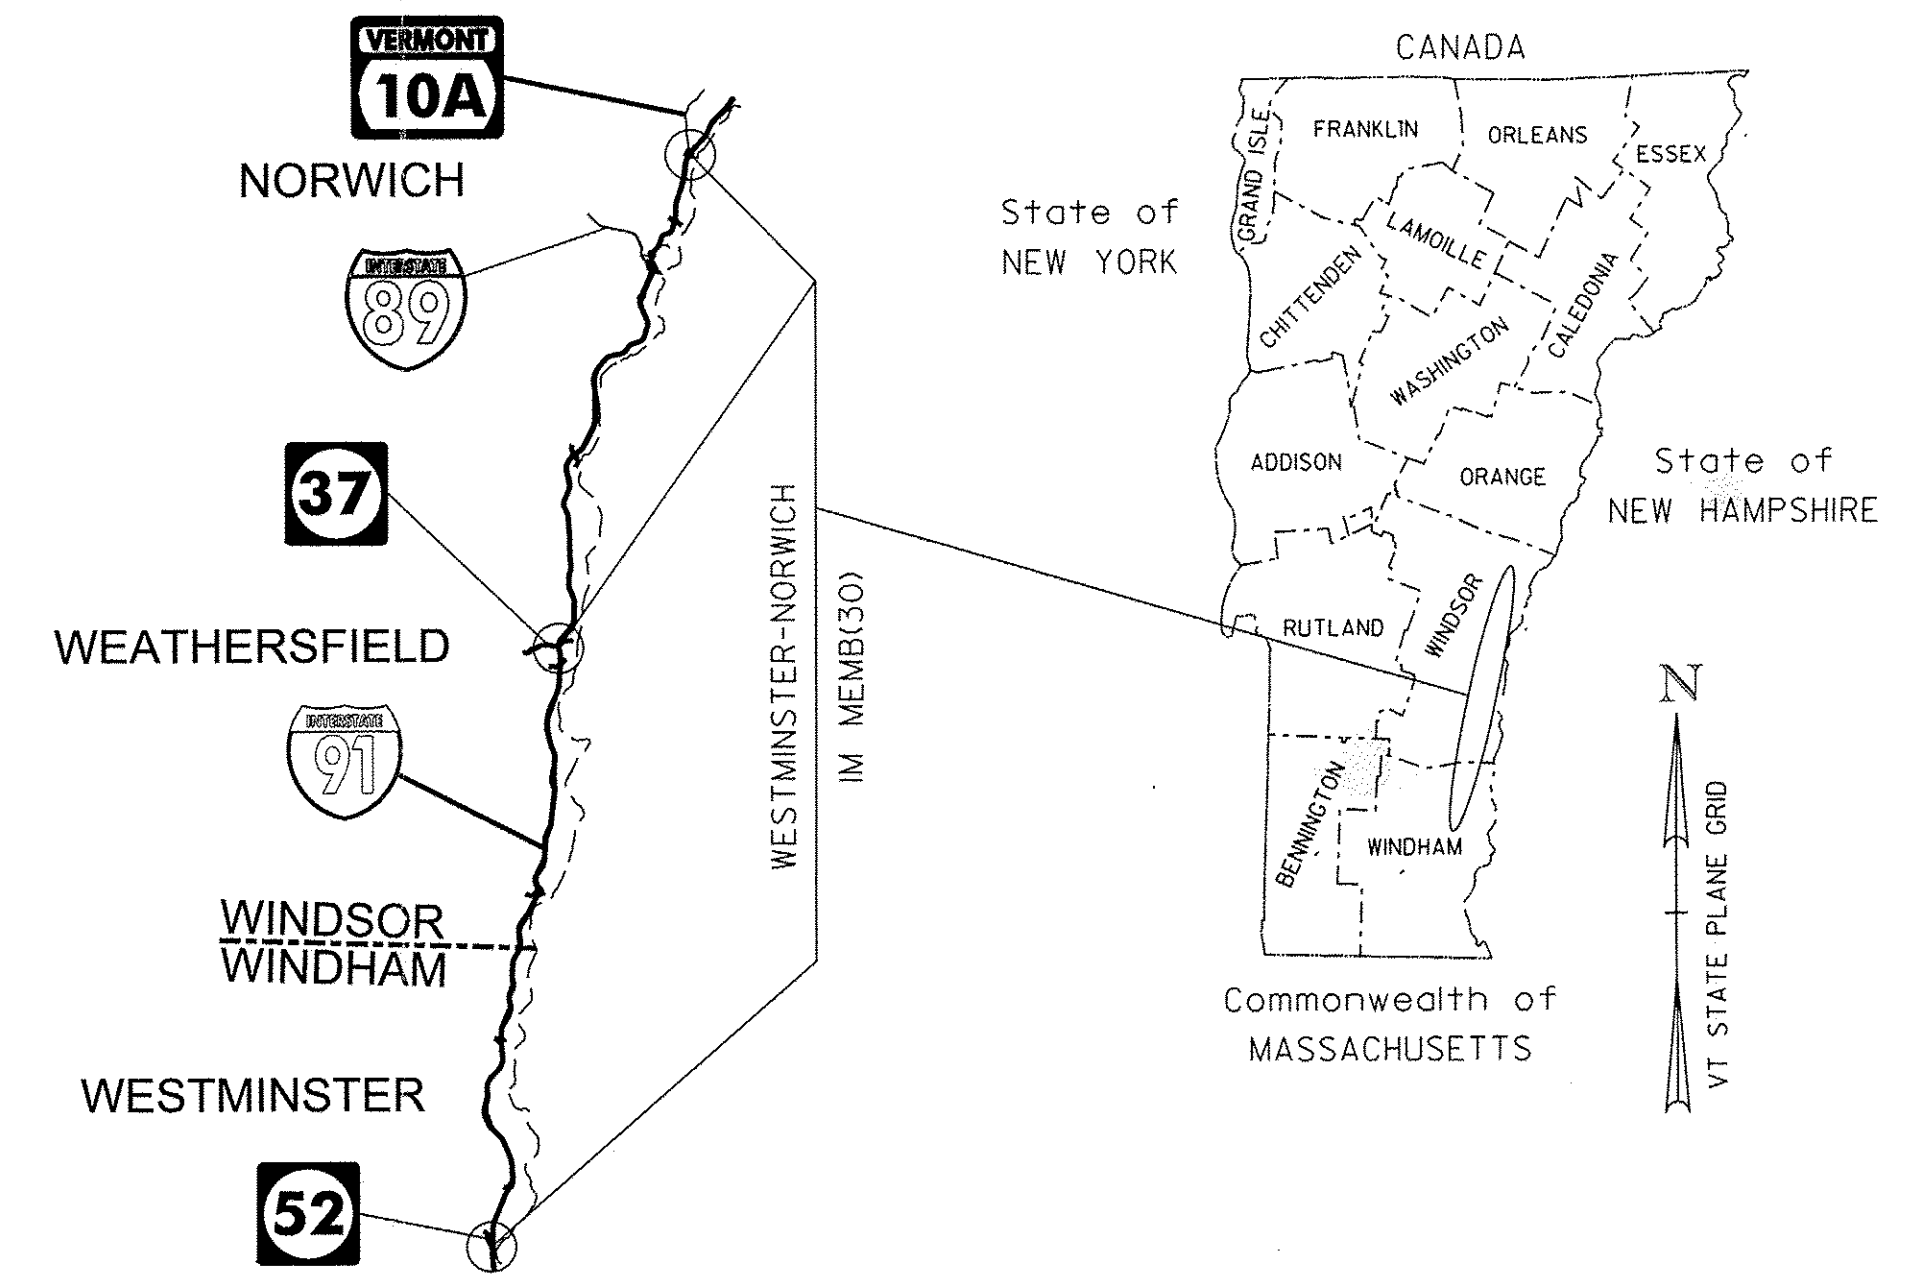

LOCATION MAP  
NOT TO SCALE

ROUTE NO.: WESTMINSTER - INTERSTATE I-91  
WEATHERSFIELD - TH NO. 37 (THRASHER ROAD)  
NORWICH - INTERSTATE I-91

BRIDGE NO.: 18N&S, 31, 48N&S

PROJECT LOCATION: WESTMINSTER - BR 18N&S OVER TH NO. 52 (PIGGERY ROAD)(MM 25.621)  
WEATHERSFIELD - BR 31 OVER I-91 (MM 52.172)  
NORWICH - BR 48N&S OVER VT 10A (WEST WHEELOCK STREET)(MM 74.834)

PROJECT DESCRIPTION: THIS PROJECT INVOLVES REMOVING AND REPLACING THE SHEET MEMBRANE WATERPROOFING AND BITUMINOUS CONCRETE PAVEMENT ON THE BRIDGE AND ITS APPROACHES ALONG WITH MINOR RELATED WORK.

LENGTH OF STRUCTURES: BR 18N 132.72'  
BR 18S 135.26'  
BR 31 251.00'  
BR 48N 225.13'  
BR 48S 225.34'

TOTAL LENGTH OF STRUCTURES: 969.45'


QUALITY ASSURANCE PROGRAM: LEVEL 1

SURVEYED BY : N/A  
SURVEYED DATE : N/A

DATUM  
VERTICAL N/A  
HORIZONTAL N/A

**CONVENTIONAL SYMBOLS**

COUNTY LINE	
TOWN LINE	
LIMITS OF ACCESS	
POINT OF ACCESS	
FENCE LINE	
STONE WALL	
TRAVELED WAY	
GUARD RAIL	
RAILROAD	
SURVEY LINE	
CULVERT	
POWER POLE	
TELEPHONE POLE	
TREES	
CONTROL OF ACCESS	
PROPERTY LINE	
R.O.W. TAKING LINE	
SLOPE RIGHTS	
TOP OF CUT	
TOE OF SLOPE	

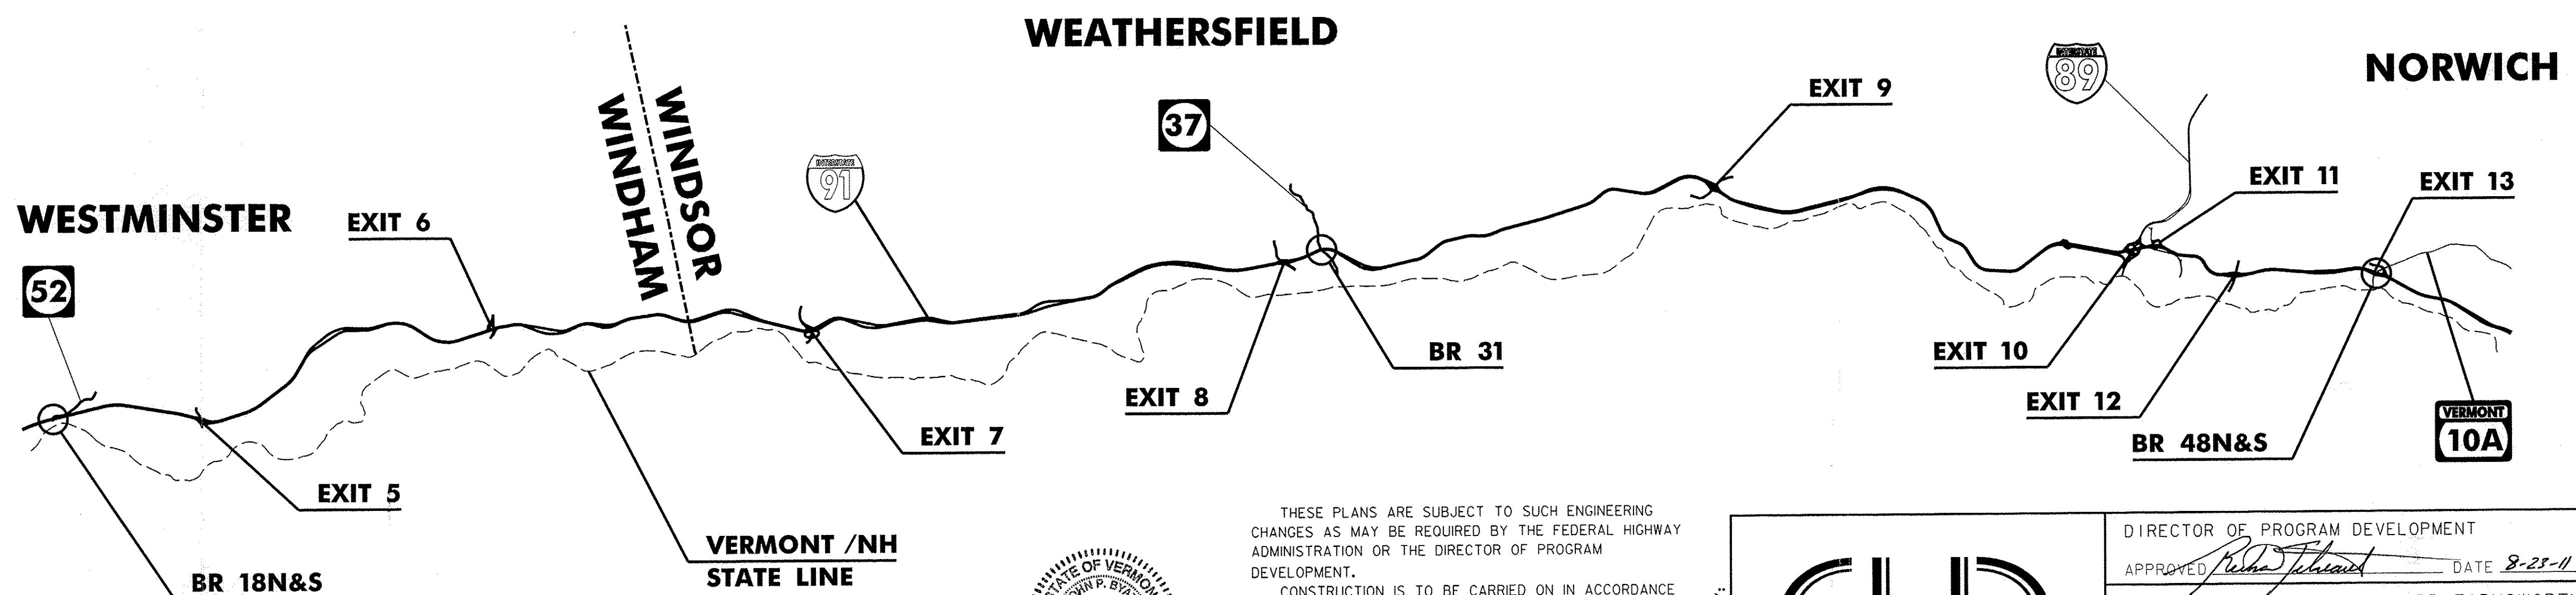

THESE PLANS ARE SUBJECT TO SUCH ENGINEERING CHANGES AS MAY BE REQUIRED BY THE FEDERAL HIGHWAY ADMINISTRATION OR THE DIRECTOR OF PROGRAM DEVELOPMENT.  
CONSTRUCTION IS TO BE CARRIED ON IN ACCORDANCE WITH THESE PLANS AND THE STANDARD SPECIFICATIONS FOR CONSTRUCTION DATED 2006, AS APPROVED BY THE FEDERAL HIGHWAY ADMINISTRATION ON JUNE 15, 2006 FOR USE ON THIS PROJECT, INCLUDING ALL SUBSEQUENT REVISIONS AND SUCH REVISED SPECIFICATIONS AND SPECIAL PROVISIONS AS ARE INCORPORATED IN THESE PLANS.

PLANS PREPARED BY:



DIRECTOR OF PROGRAM DEVELOPMENT  
APPROVED: *[Signature]* DATE 8-25-11  
PROJECT MANAGER : SHERWARD FARNSWORTH  
PROJECT NAME : WESTMINSTER - NORWICH  
PROJECT NUMBER : IM MEMB(30)  
SHEET 1 OF 38 SHEETS