


S.P.N.	STATE	PROJECT NO.	SHEET NO.	TOTAL SHEETS
1	VT	7-91-11131	102	153

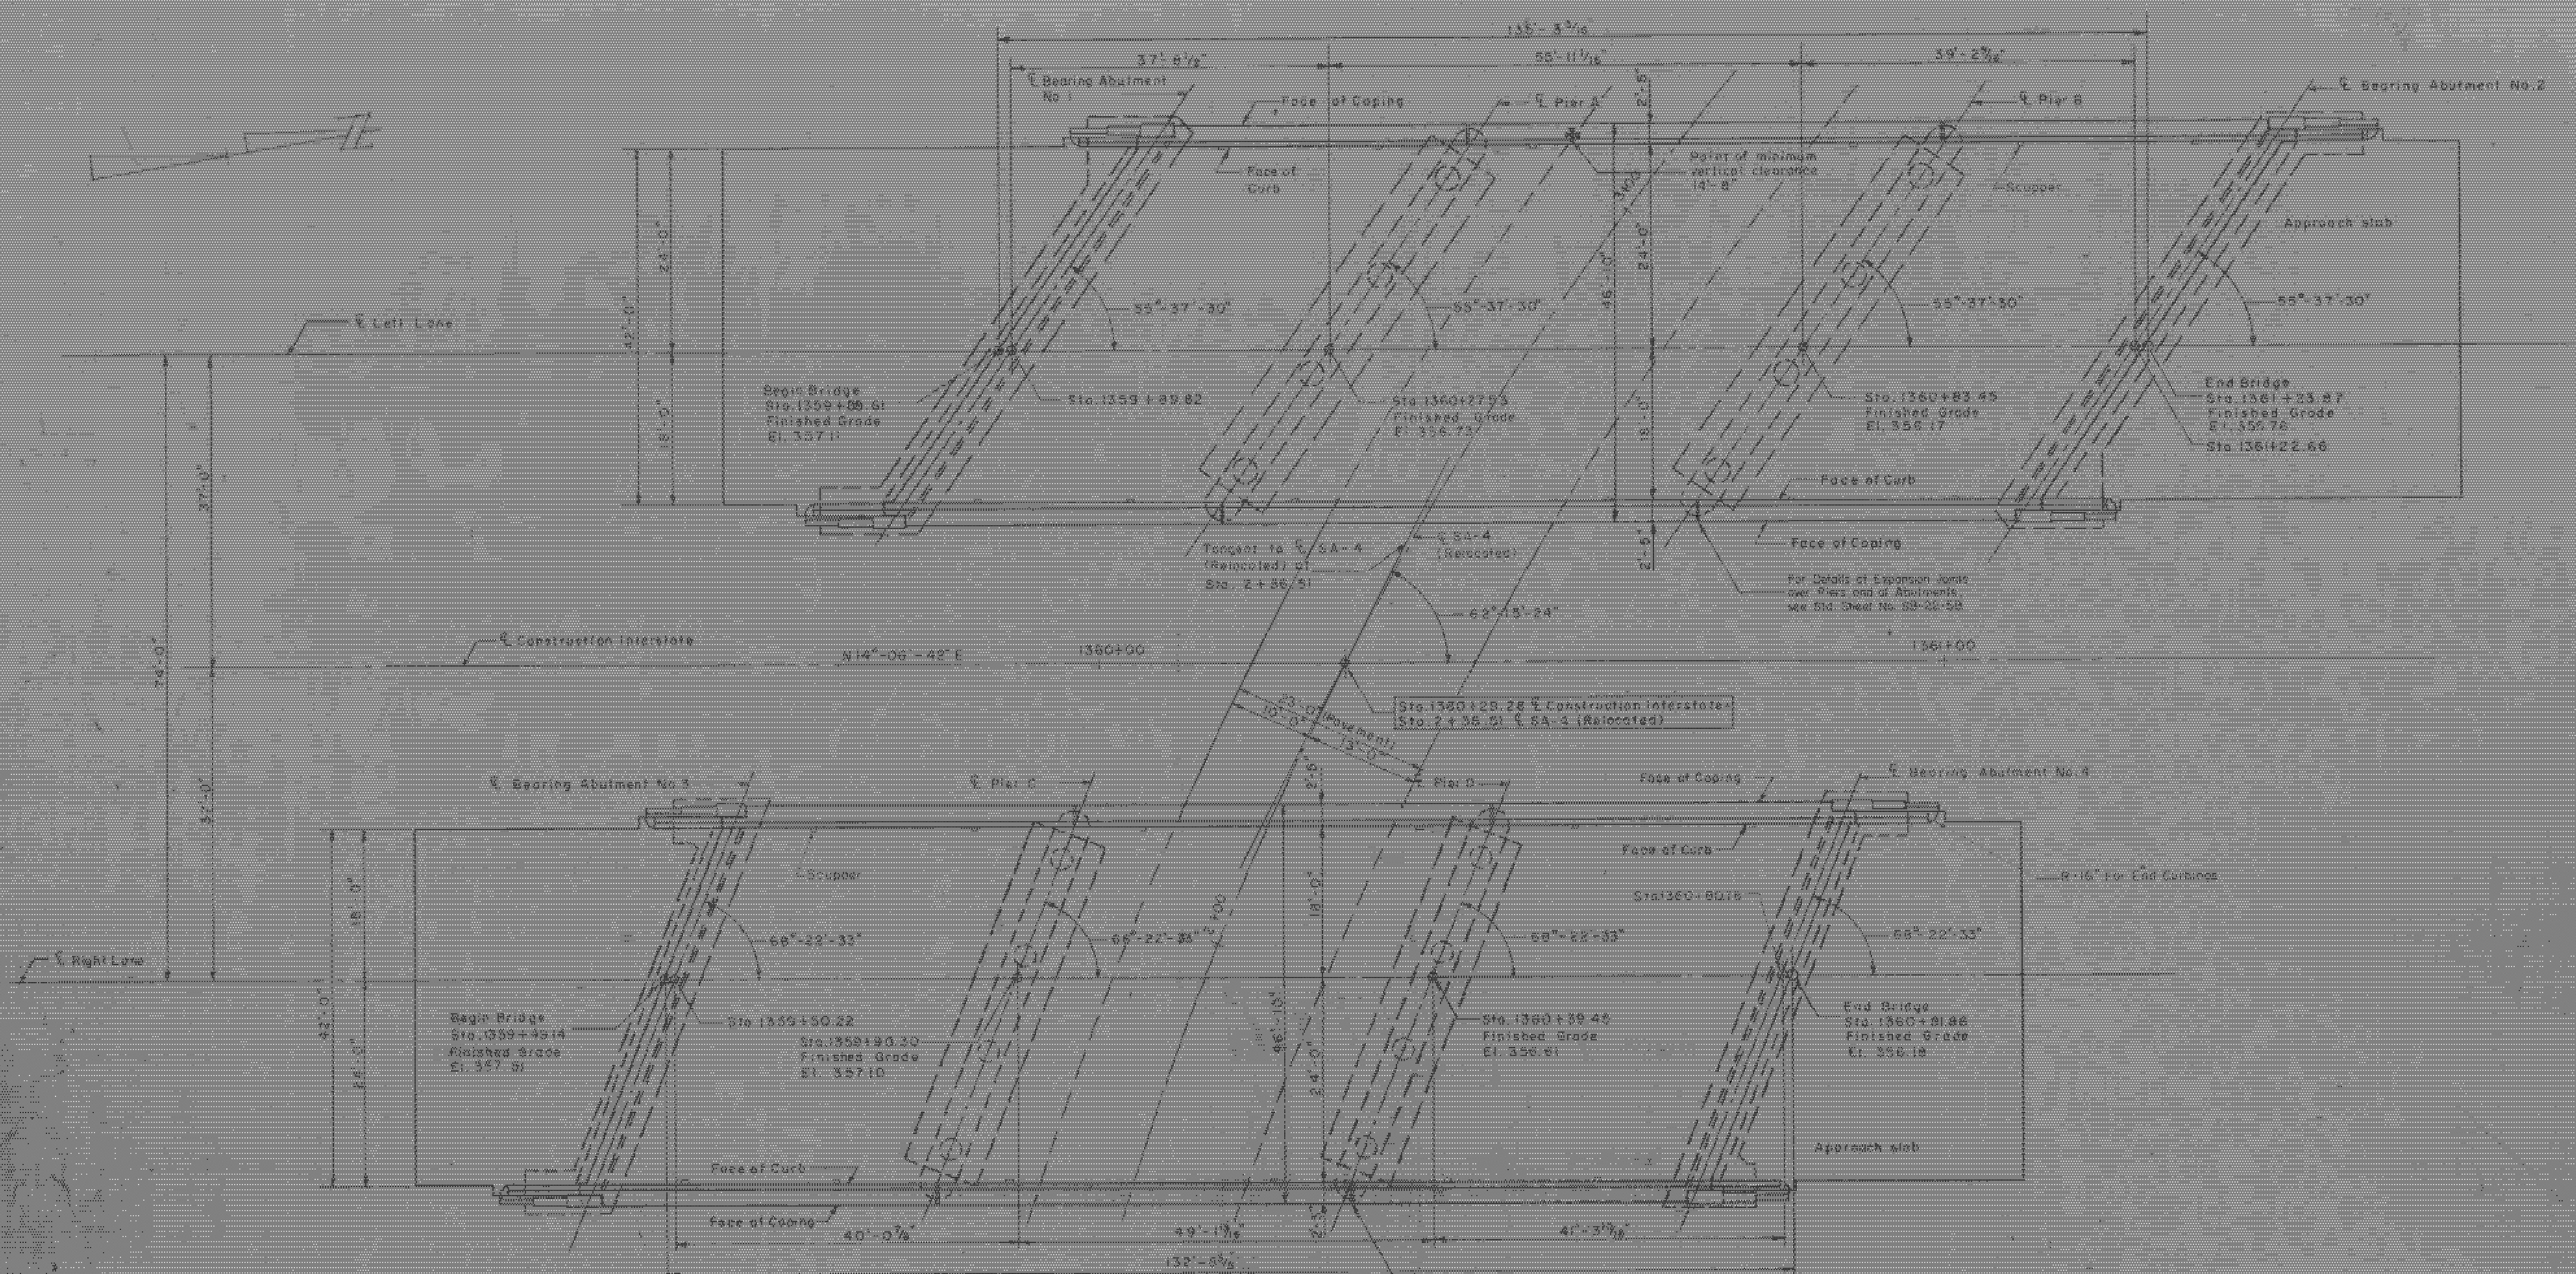


**PLAN**  
Scale:  $\frac{1}{32}'' = 1'-0''$

**RAILING POST SPACING SCHEDULE**

	A	B	C	D
LEFT LANE	7'-2 1/2"	16'-0 7/8" (16'-8 1/2")	7'-2 1/2"	12'-8 1/2"
RIGHT LANE	4'-4 1/2"	16'-0 7/8" (16'-0")	4'-4 1/2"	12'-8 1/2"

- Notes:
1. Railing posts to be set normal to grade over top of base of sign and of railing post of adjacent abutment over pier.
  2. All stationing refers to a Construction Interstate existing stationing along SA-41 (Relocated).
  3. For scupper layout see Framing Plan Sheet No. 199.
  4. For railing details see standard Sheet SB-90-97 (10/2).
  5. All dimensions are horizontal dimensions.
  6. For Bridge Marker See Drawing SB-20-56 (Detail a).

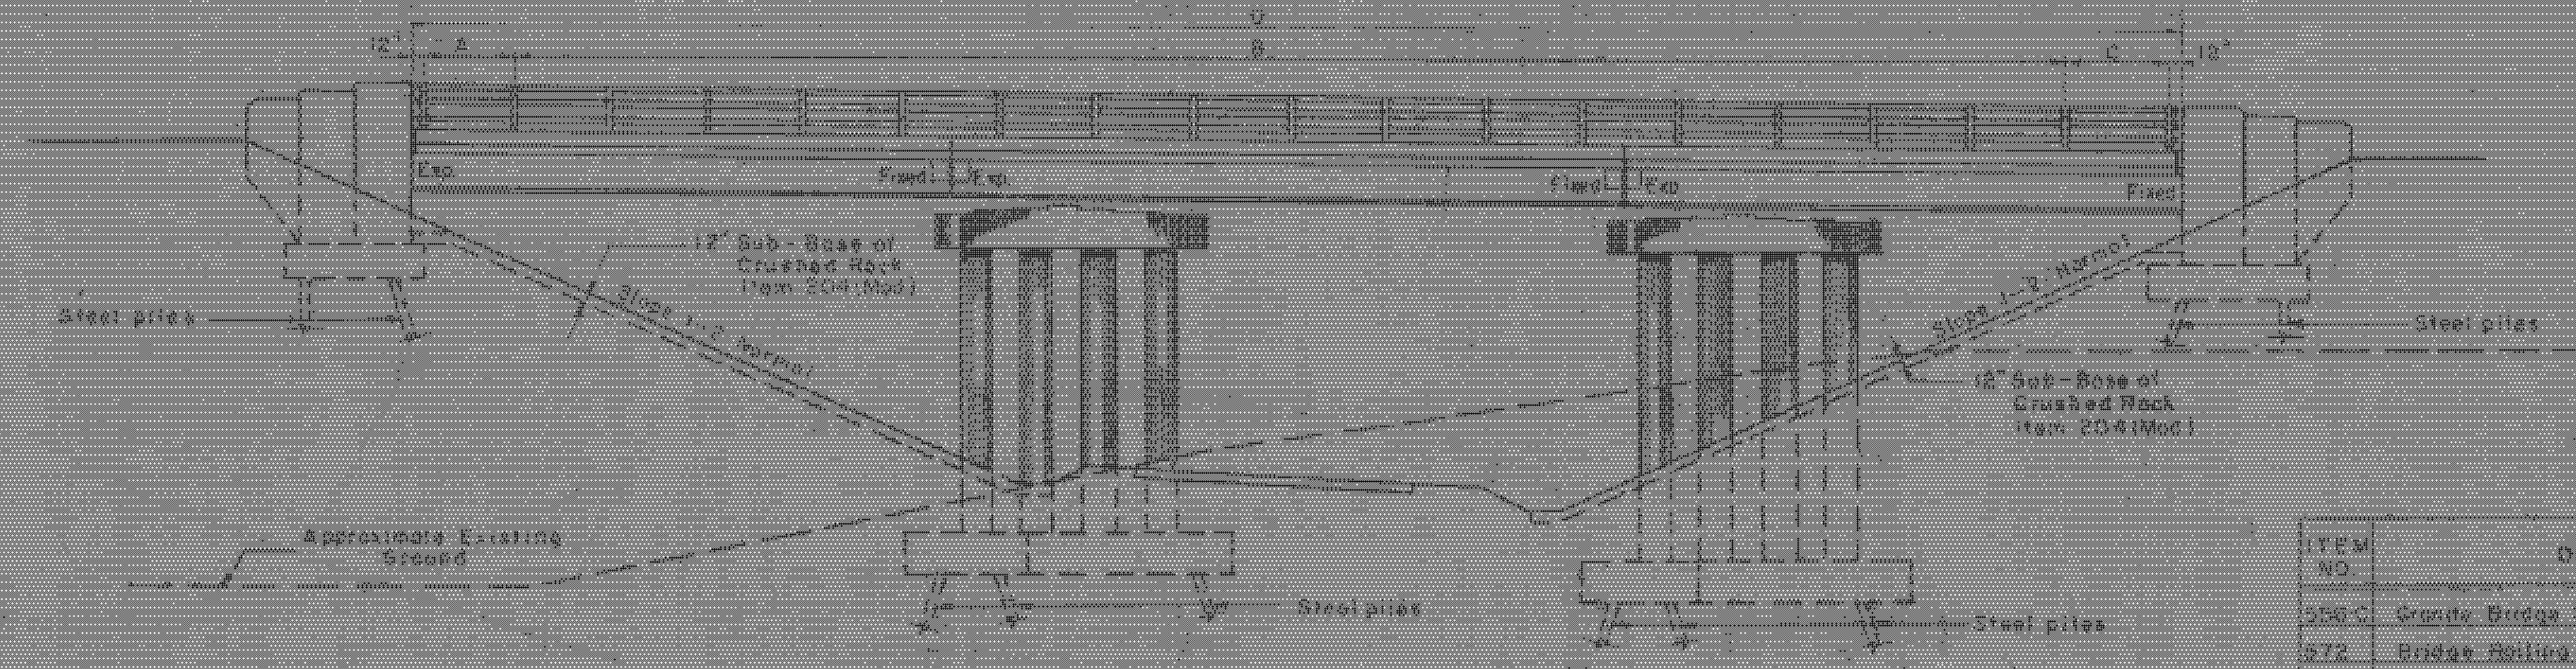

**EASTERLY ELEVATION**  
**WESTERLY ELEVATION (SIMILAR)**

Scale:  $\frac{1}{32}'' = 1'-0''$

**ESTIMATED QUANTITIES**

ITEM NO.	DESCRIPTION	UNIT	NET	OVER-RUN TOTAL	FINAL
550-C	Granite Bridge Curb-Type 1-Left Lane	L.F.	300	300	300
572	Bridge Railing-Left Lane	L.F.	300	300	300
550-C	Granite Bridge Curb-Type 1-Right Lane	L.F.	300	300	300
572	Bridge Railing-Right Lane	L.F.	300	300	300

WESTMINSTER - NORWICH  
IM MEMB(30)  
SHEET 14 OF 38  
FOR REFERENCE ONLY

**IR-DECK(26)**  
**BR18N4S**  
**THIS SHEET FOR**  
**INFORMATION ONLY**

**PLAN AND ELEVATION**  
STATE OF VERMONT  
DEPARTMENT OF HIGHWAYS  
INTERSTATE PROJECT in the town of  
**WESTMINSTER**  
INTERSTATE OVER STA. 1360+28.26  
SA-41 (RELOCATED) STA. 2+38.01  
THE MAPPERON ENGINEERING CO.  
DARTMOUTH COLLEGE  
BOSTON  
DESIGNED BY: [Signature]  
CHECKED BY: [Signature]  
PROJECT NO. 7-91-11131 DRAWING NO. SB-20-56