
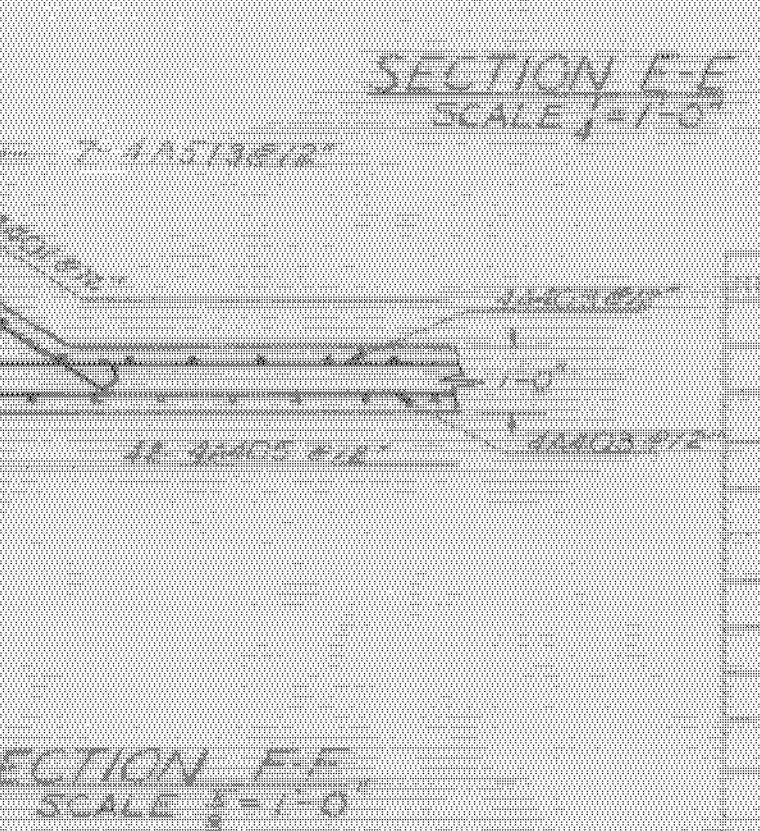


For notes
concerning Abutments
see Br. 215

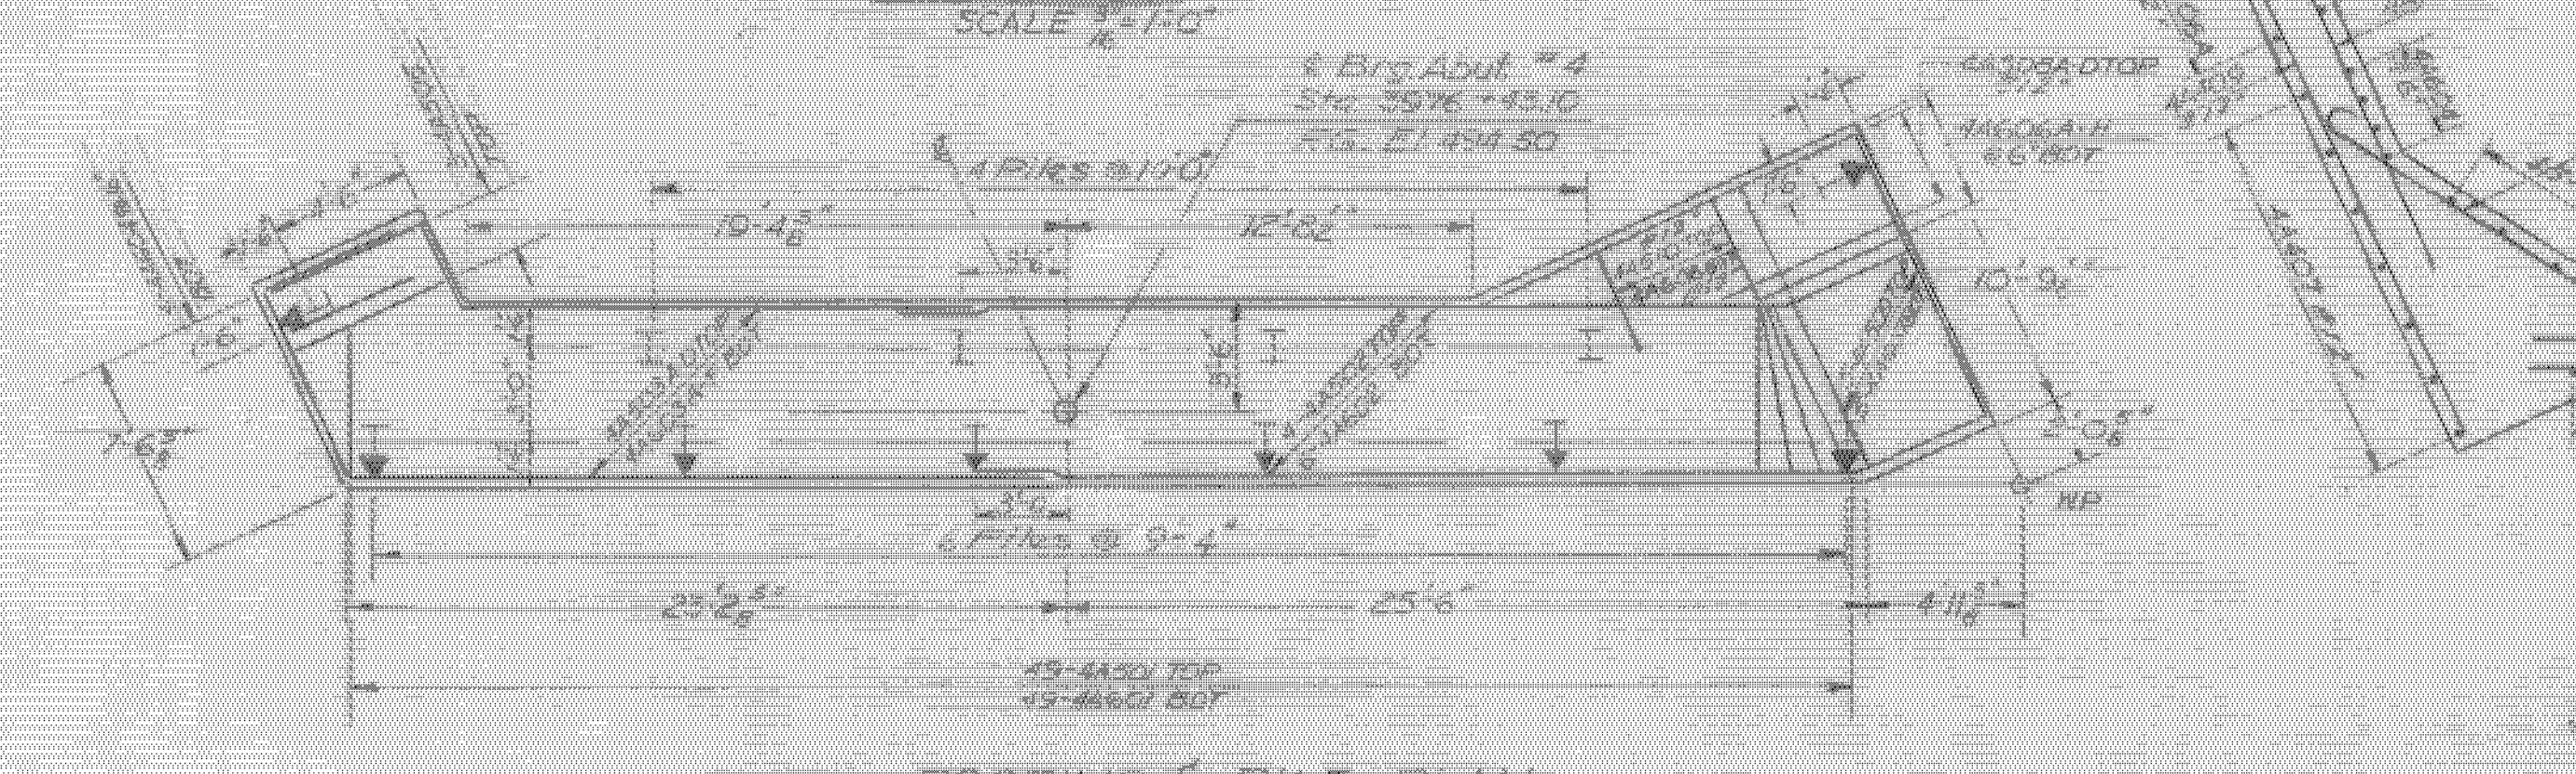

Note: Estimated length of 12 BPS3
Steel H piles 75 FT

QTY	ITEM	UNIT	NET	TOTAL	FINAL
	CRAN. EXCAV. OF EARTH	C.Y.			
	CRAN. EXCAV. OF ROCK	C.Y.			
	UNCLASS. CRAN. EXCAV.	C.Y.			
	STRUCK EXCAV.	C.Y.			
	CONC. CLASS. IN. (BODY)	C.Y.			
	CONC. CLASS. B. (BODY)	C.Y.			
	REINFC. STEEL	LBS.			
	WATERPROOFING COATING	S.F.			
	TREATED TIMBER PILING	L.F.			
	BRACES FOR SHIELD PILES	WR			
	STEEL PILES	L.F.			
	UNTREATED TIMBER PILING	L.F.			

STATE OF WESTMINSTER - NORWICH
DEPARTMENT OF HIGHWAYS
PROJECT: I 91 over Vt 10-A
TOWN OF Norwich
ROUTE No. I-91
STA 3975+50'
SHEET 38 OF 38
FOR REFERENCE ONLY