

**INDEX OF SHEETS**

1	TITLE SHEET
2-4	QUANTITY SHEETS
5	PROJECT NOTES
6	STD. DETAILS AND PROJECT NOTES
7-10	TRAFFIC CONTROL PLANS
11-24	REFERENCE SHEETS - BRIDGES 102N&S
25-35	REFERENCE SHEETS - BRIDGES 103N&S
36-46	REFERENCE SHEETS - BRIDGES 105N&S
47-55	REFERENCE SHEETS - BRIDGES 106N&S
56-74	REFERENCE SHEETS - BRIDGE 107S
75-84	REFERENCE SHEETS - BRIDGES 108N&S


**STANDARD SHEETS**

E-100	CONSTRUCTION APPROACH SIGNS	1/2/2004
E-100A	SIDE ROAD CONSTRUCTION APPROACH SIGNS	1/2/2004
E-101	CONSTRUCTION SIGN DETAILS	5/30/2003
E-102	CONSTRUCTION SIGN DETAILS	6/30/2003
E-102A	CONSTRUCTION SIGN DETAILS	5/1/2004
E-103	MAINLINE TRAFFIC CONTROL DIVIDED HIGHWAY ONE LANE CLOSED	3/1/2004
E-106	TRAFFIC CONTROL MISCELLANEOUS	3/1/2004
E-121	STANDARD SIGN PLACEMENT CONVENTIONAL ROAD	8/8/1995
E-140	REGULATORY SIGN DETAILS	8/30/1996
E-171A	TRAFFIC CONTROL SIGNALS GENERAL NOTES & DETAILS	8/9/1995
E-172	VEHICLE DETECTOR LOOP DETAILS	1/9/1995

**STATE OF VERMONT  
AGENCY OF TRANSPORTATION**



**PROPOSED IMPROVEMENT  
BRIDGE PROJECT  
TOWNS OF BARTON, IRASBURG & COVENTRY  
COUNTY OF ORLEANS  
BRIDGES NO. 102 N&S, 103 N&S, 105 N&S, 106 N&S, 107S AND 108 N&S**

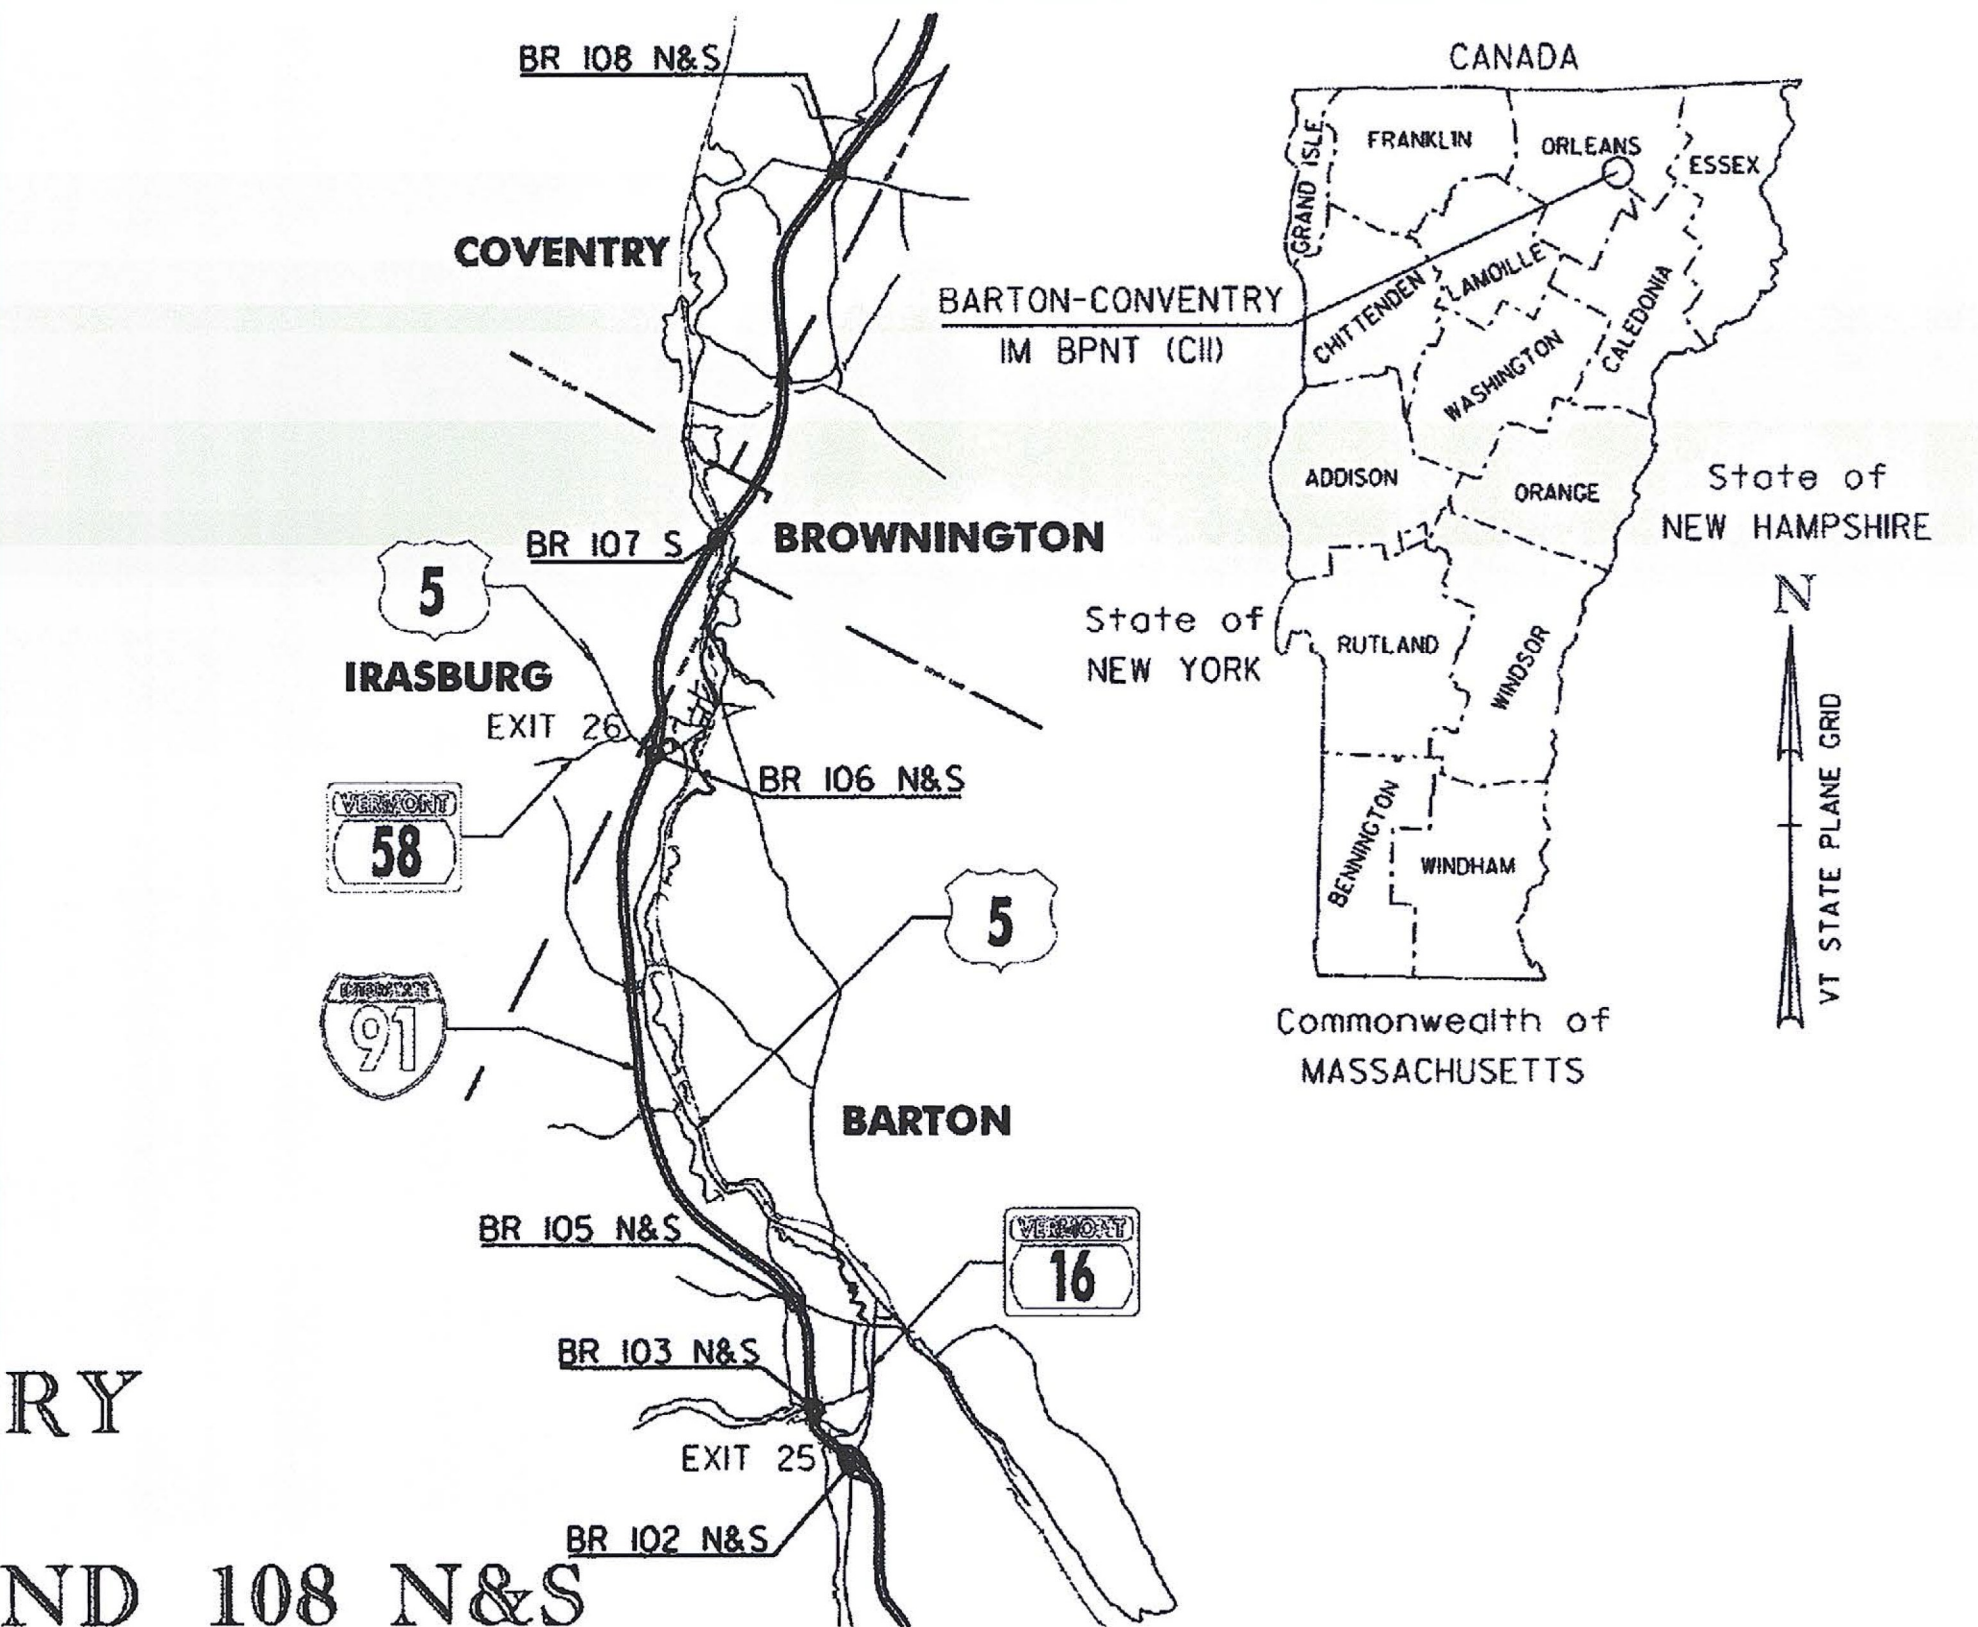

**RECORD PLANS**

CONTRACTOR:	MODERN PROTECTIVE COATINGS - HUDSON, NH
RESIDENT ENGINEER:	CHRIS CRAIG
CONSTRUCTION BEGAN:	JUNE 10, 2013
CONSTRUCTION COMPLETE:	JULY 7, 2014
RECORD PLANS BY:	CHRIS CRAIG & CRAIG PIERCE

I HEREBY CERTIFY THAT ALL THE CONSTRUCTION REQUIRED BY THIS SET OF DRAWINGS HAS BEEN ACCOMPLISHED AS INDICATED HEREIN.

BY Chris Craig RESIDENT ENGINEER  
DATE 2-13-15

NOTE: Any further information concerning final quantities, amounts or other details relative to this project may be found at Central Files in the electronic archives.

QUALITY ASSURANCE PROGRAM: **LEVEL 1**

**CONVENTIONAL SYMBOLS**


COUNTY LINE	
TOWN LINE	
LIMITS OF ACCESS	
POINT OF ACCESS	
FENCE LINE	
STONE WALL	
TRAVELED WAY	
GUARD RAIL	
RAILROAD	
SURVEY LINE	
CULVERT	
POWER POLE	
TELEPHONE POLE	
TREES	
CONTROL OF ACCESS	
PROPERTY LINE	
R.O.W. TAKING LINE	
SLOPE RIGHTS	
TOP OF CUT	
TOE OF SLOPE	

**DATUM**


VERTICAL	N/A
HORIZONTAL	N/A

PROJECT LOCATION: M.M. 155.948 BRIDGES NO. 102 N&S LOCATED ON I-91 OVER VT16  
M.M. 156.381 BRIDGES NO. 103 N&S LOCATED ON I-91 OVER ROARING BROOK RD.  
M.M. 159.793 BRIDGES NO. 105 N&S LOCATED ON I-91 OVER ELM ST. LAKE REGION RD.  
M.M. 161.414 BRIDGES NO. 106 N&S LOCATED ON I-91 OVER US 5  
M.M. 163.071 BRIDGE NO. 107 S LOCATED ON I-91 OVER RIVER RD & WASHINGTON COUNTY RR  
M.M. 165.795 BRIDGES NO. 108N&S LOCATED ON COVENTRY STATION RD. OVER I-91


PROJECT DESCRIPTION: THIS PROJECT INVOLVES CLEANING AND REPAINTING THE EXISTING STEEL SUPERSTRUCTURE MEMBERS AND MINOR ASSOCIATED WORK.

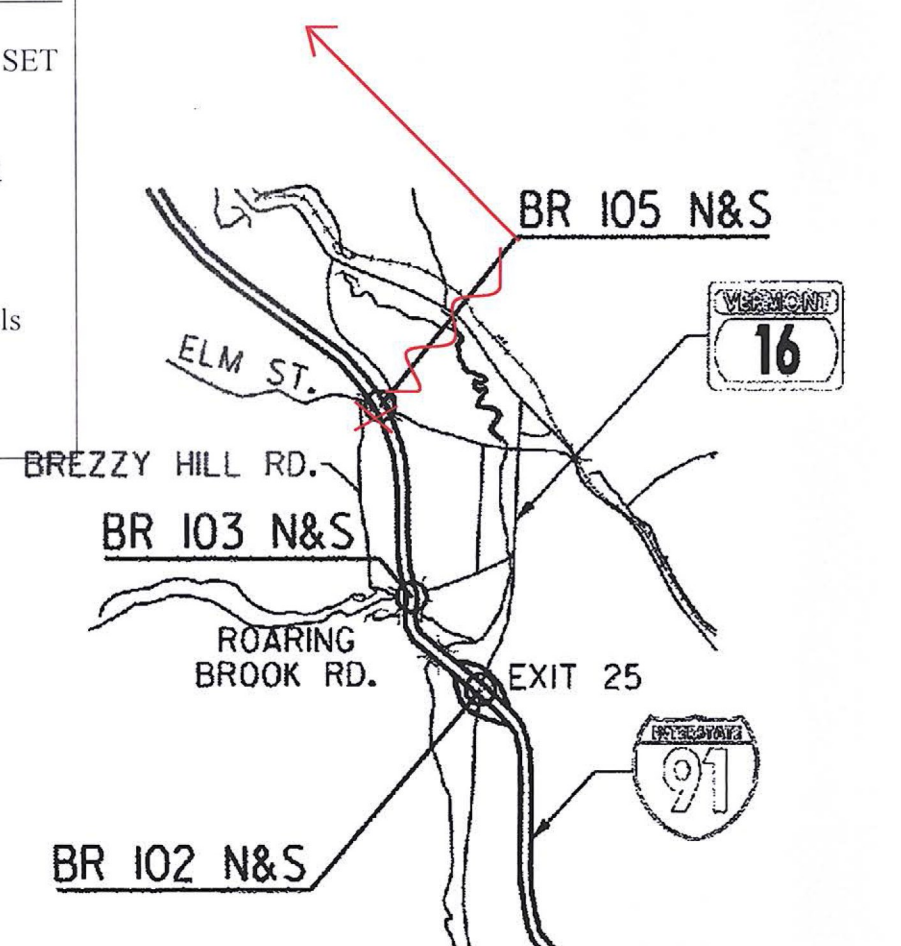


**BRIDGES 102 N&S,  
103 N&S & 105 N&S**  
BARTON  
NOT TO SCALE

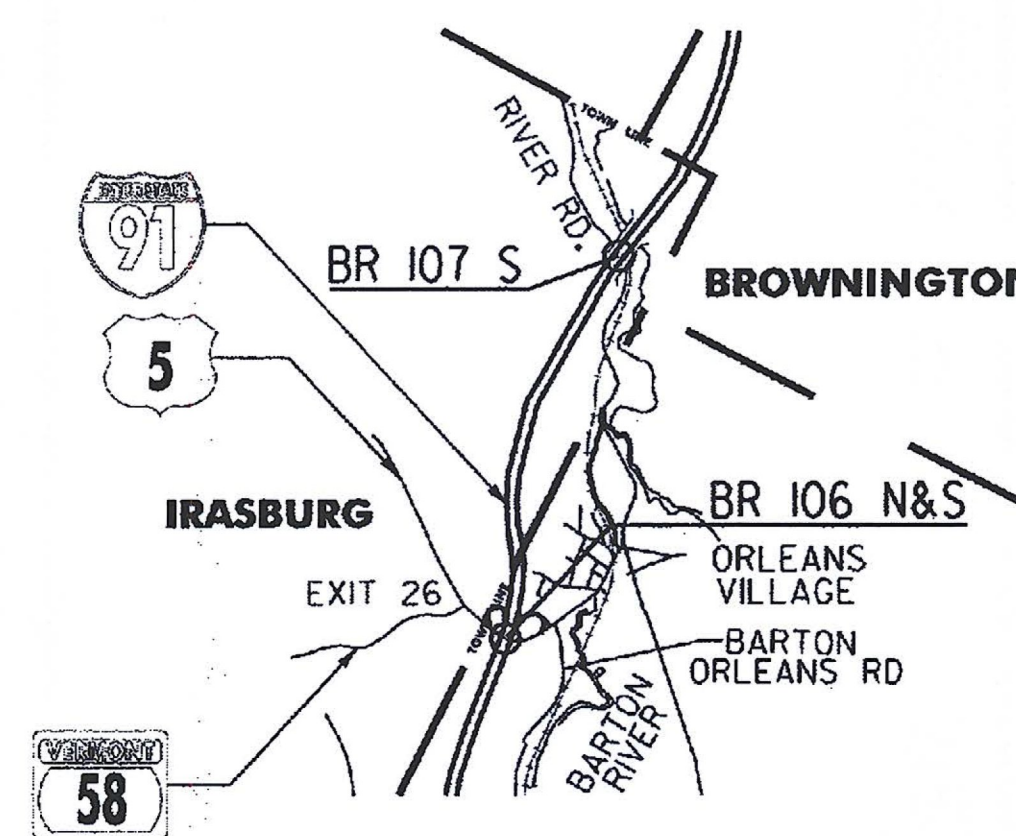

**BRIDGES 106 N&S  
& 107 S**  
BARTON & IRASBURG  
NOT TO SCALE

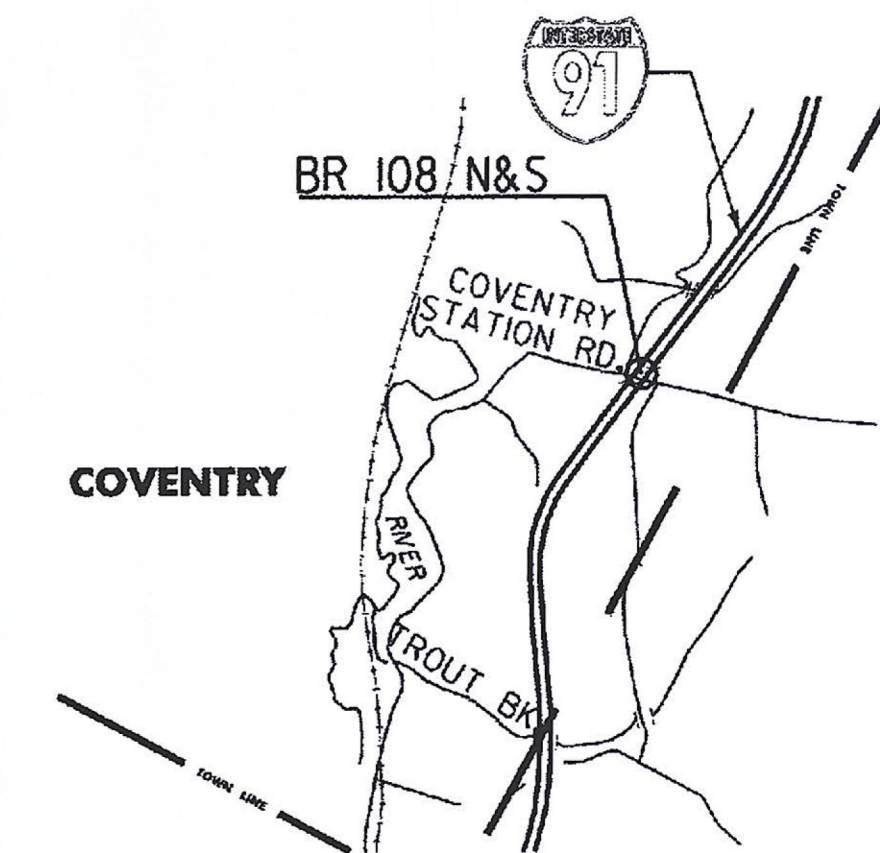

**BRIDGES 108 N&S**  
COVENTRY  
NOT TO SCALE

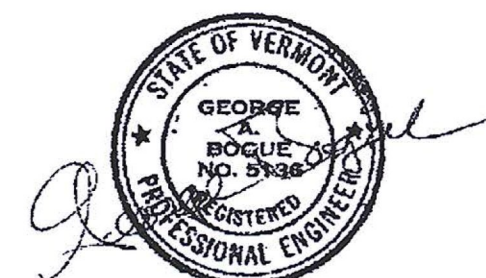

10/31/12



THESE PLANS ARE SUBJECT TO SUCH ENGINEERING CHANGES AS MAY BE REQUIRED BY THE FEDERAL HIGHWAY ADMINISTRATION OR THE DIRECTOR OF PROGRAM DEVELOPMENT.

CONSTRUCTION IS TO BE CARRIED ON IN ACCORDANCE WITH THESE PLANS AND THE STANDARD SPECIFICATIONS FOR CONSTRUCTION DATED 2011, AS APPROVED BY THE FEDERAL HIGHWAY ADMINISTRATION ON JULY 20, 2011 FOR USE ON THIS PROJECT, INCLUDING ALL SUBSEQUENT REVISIONS AND SUCH REVISED SPECIFICATIONS AND SPECIAL PROVISIONS AS ARE INCORPORATED IN THESE PLANS.

DIRECTOR OF PROGRAM DEVELOPMENT	APPROVED <u>George A. Bogie</u> DATE <u>11-7-12</u>
PROJECT MANAGER :	MARK SARGENT
PROJECT NAME :	BARTON-COVENTRY
PROJECT NUMBER :	1M BPNT (11)
SHEET 1 OF 84 SHEETS	