



ELEVATION
CURTAIN WALL #3

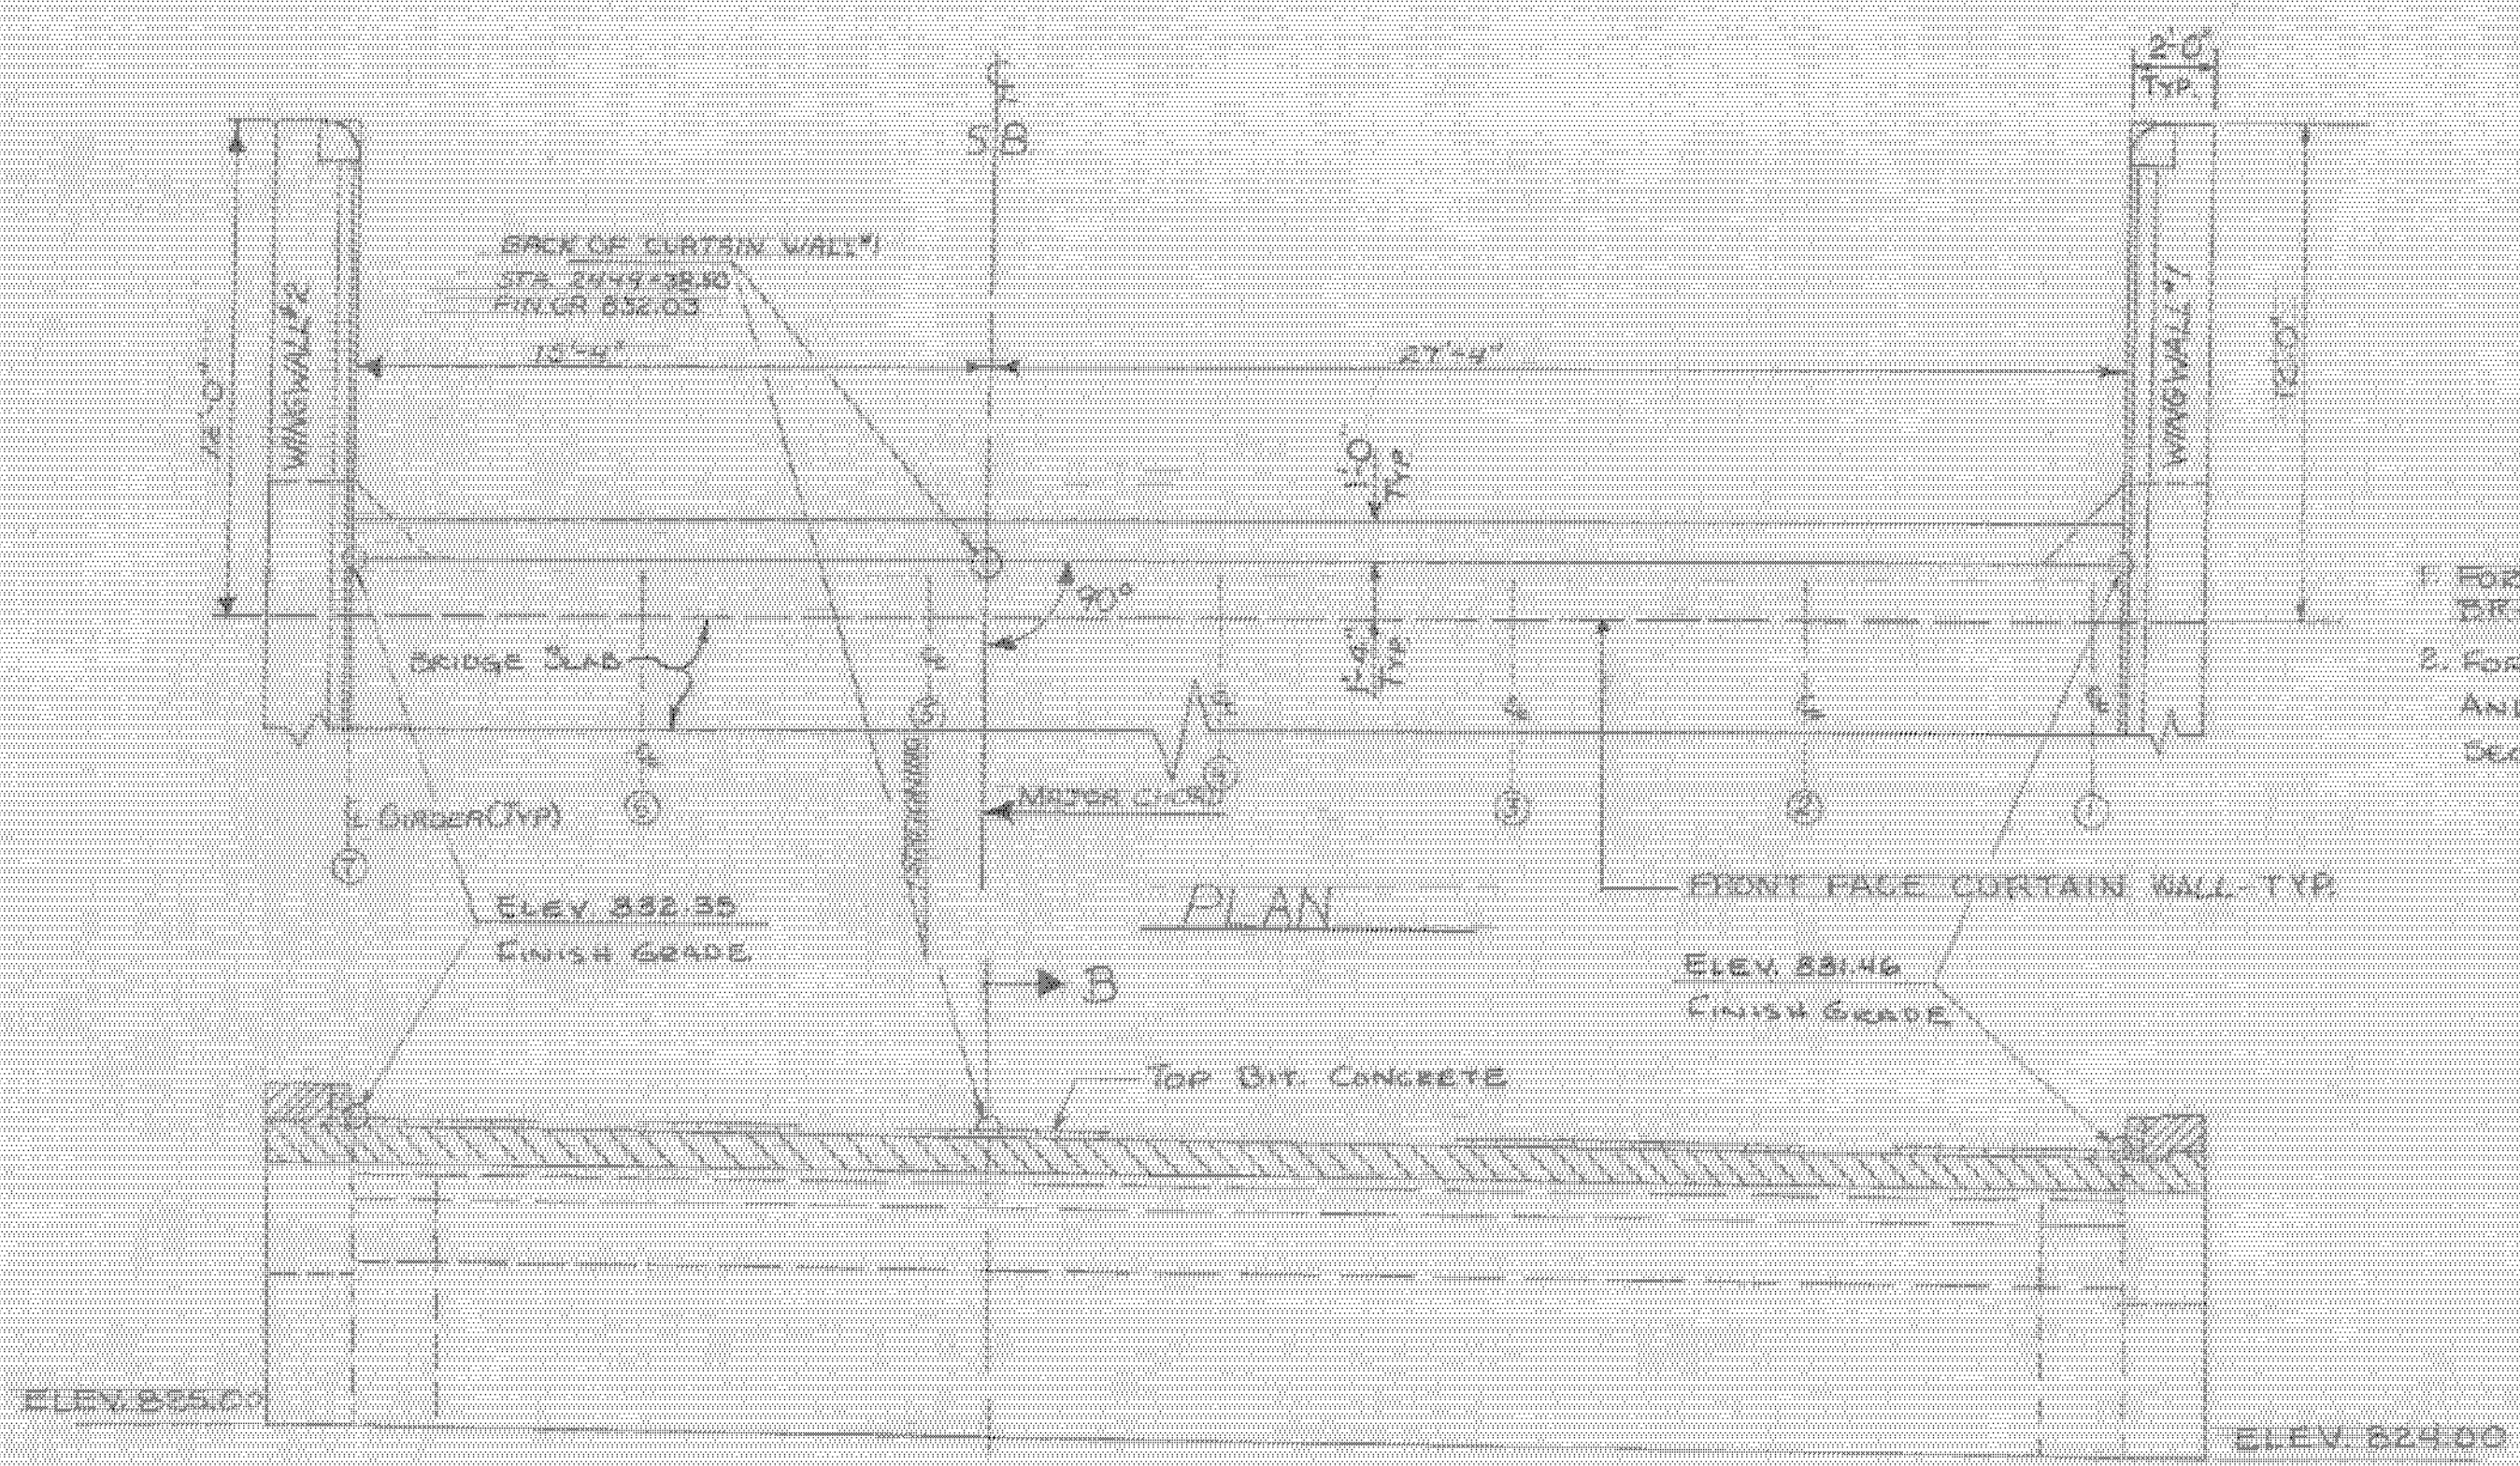


ELEVATION
CURTAIN WALL #1

NOTES
1. FOR GENERAL NOTES SEE SHEET BR-101 PLAN AND ELEVATION.
2. FOR ADDITIONAL CURTAIN WALL AND WINGWALL DETAILS AND SECTIONS SEE SHEET BR-110.

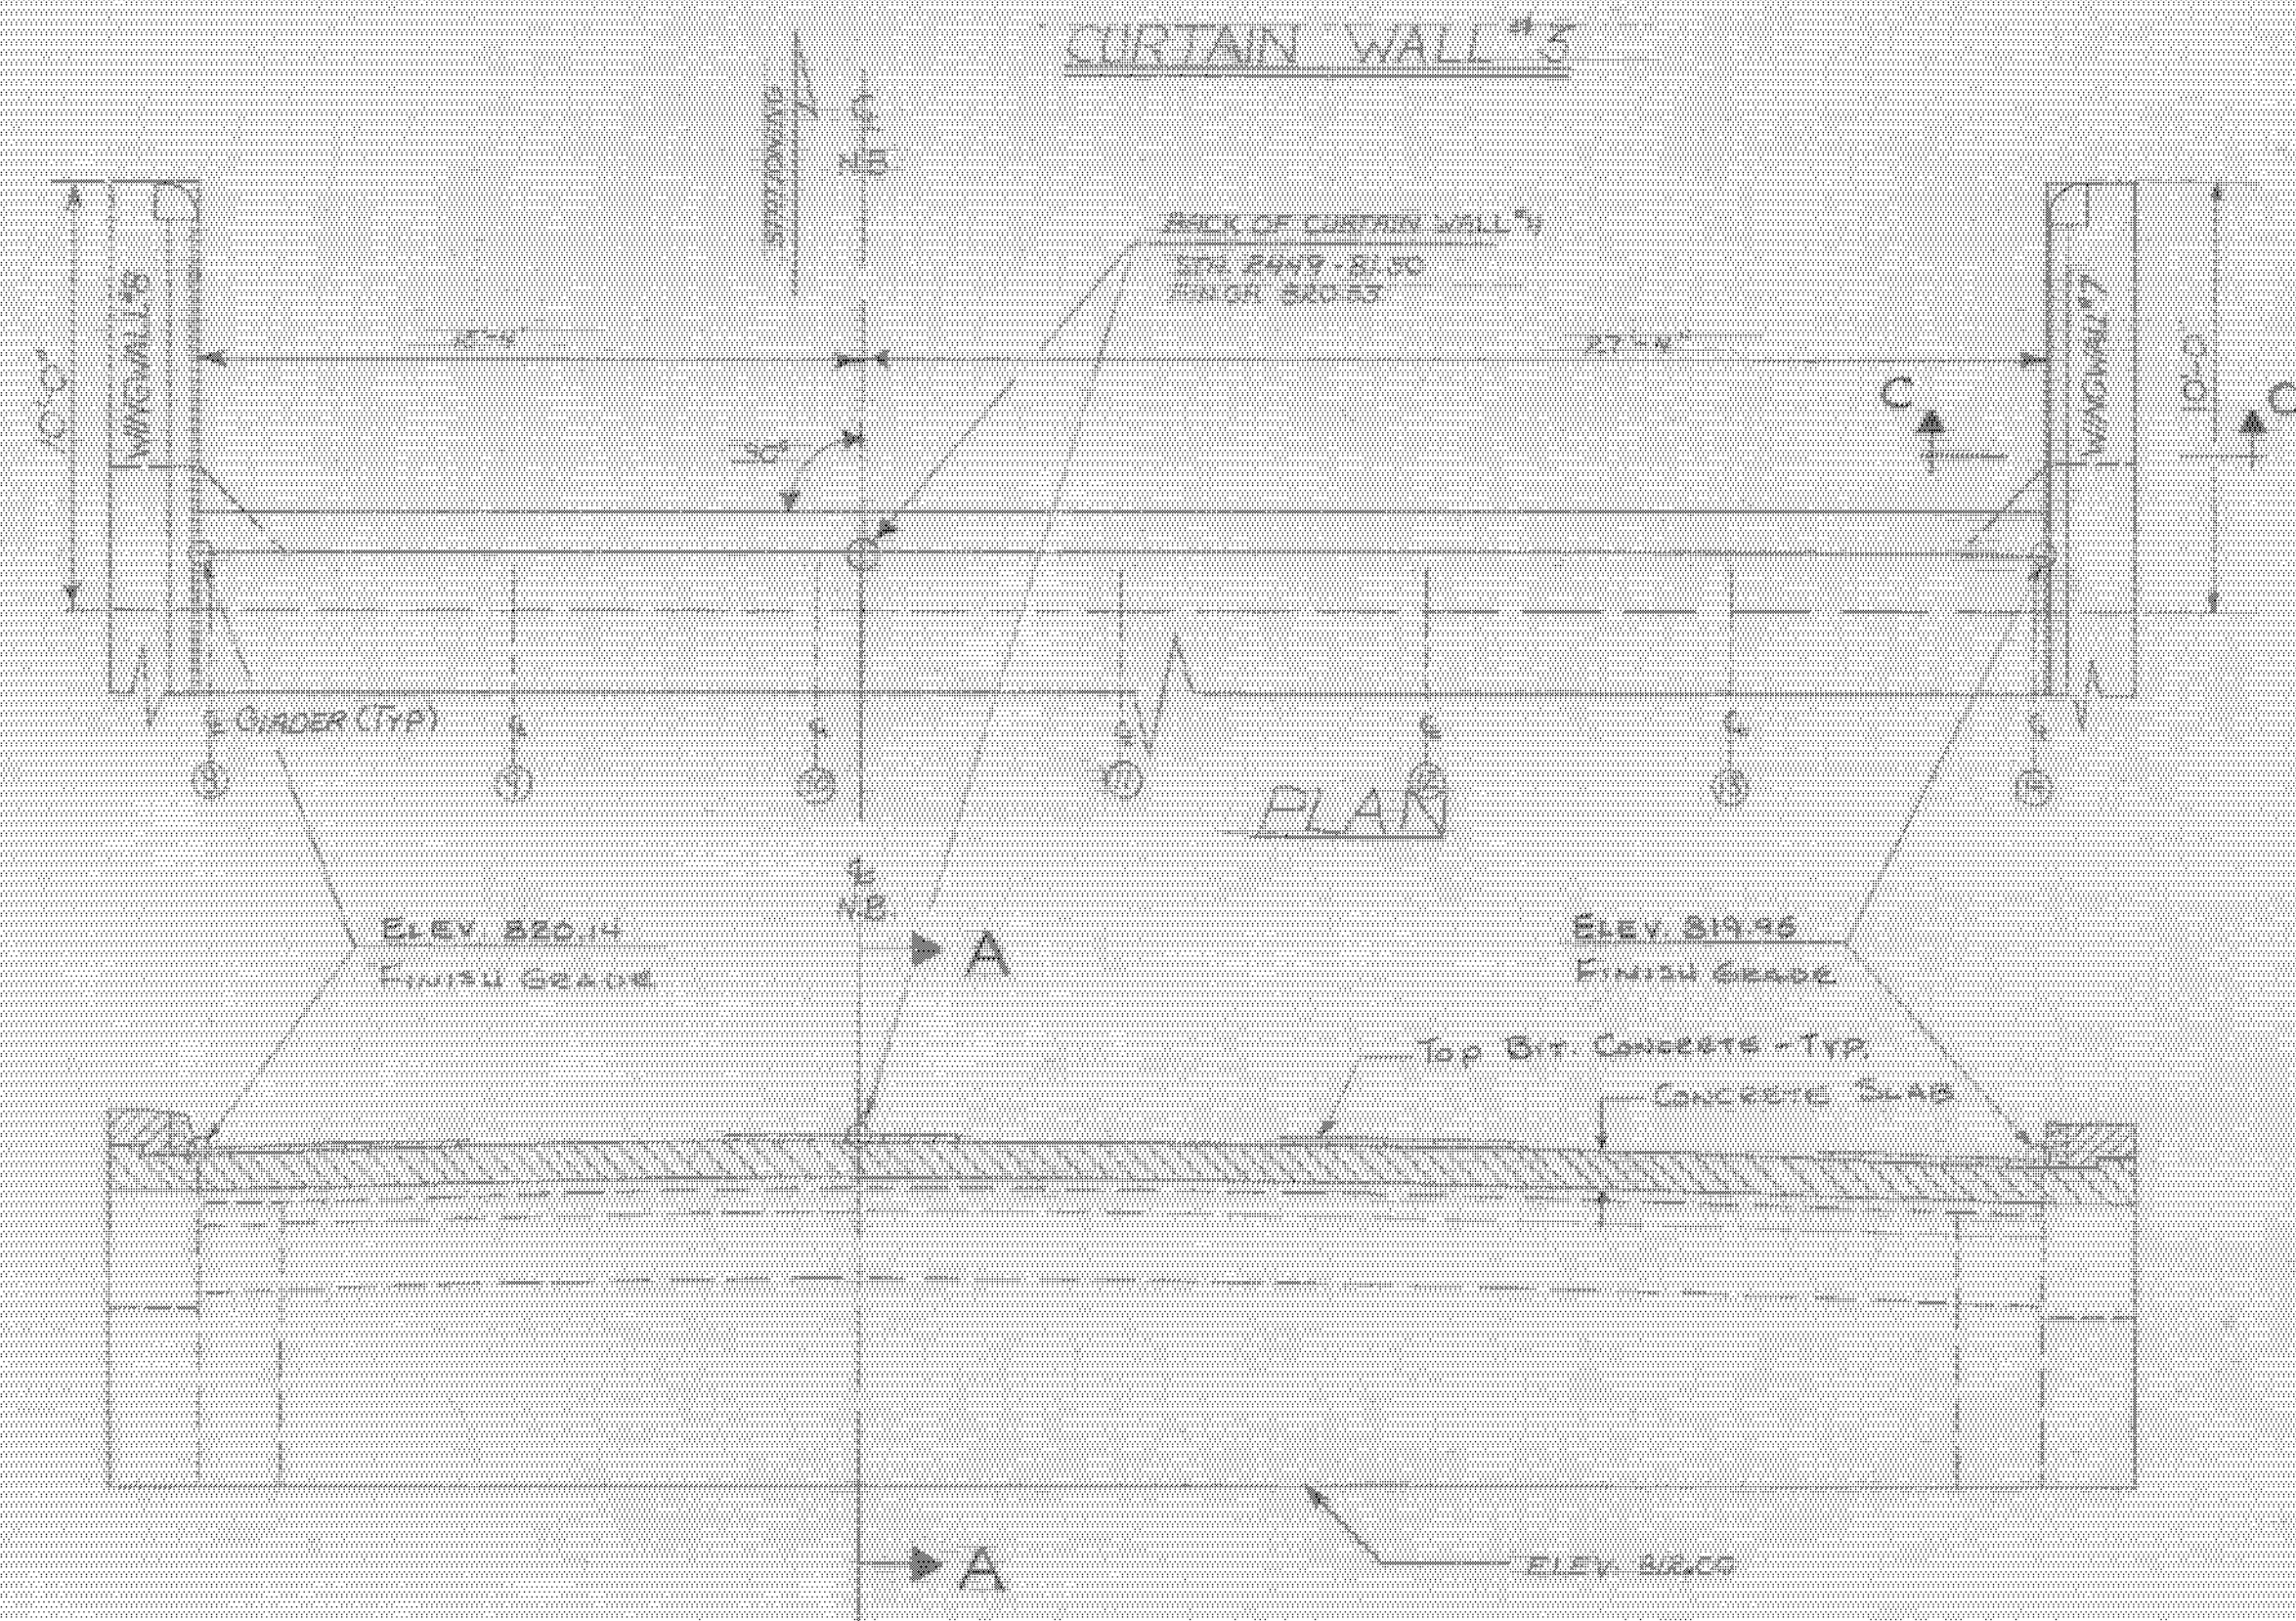

ELEVATION
CURTAIN WALL #4

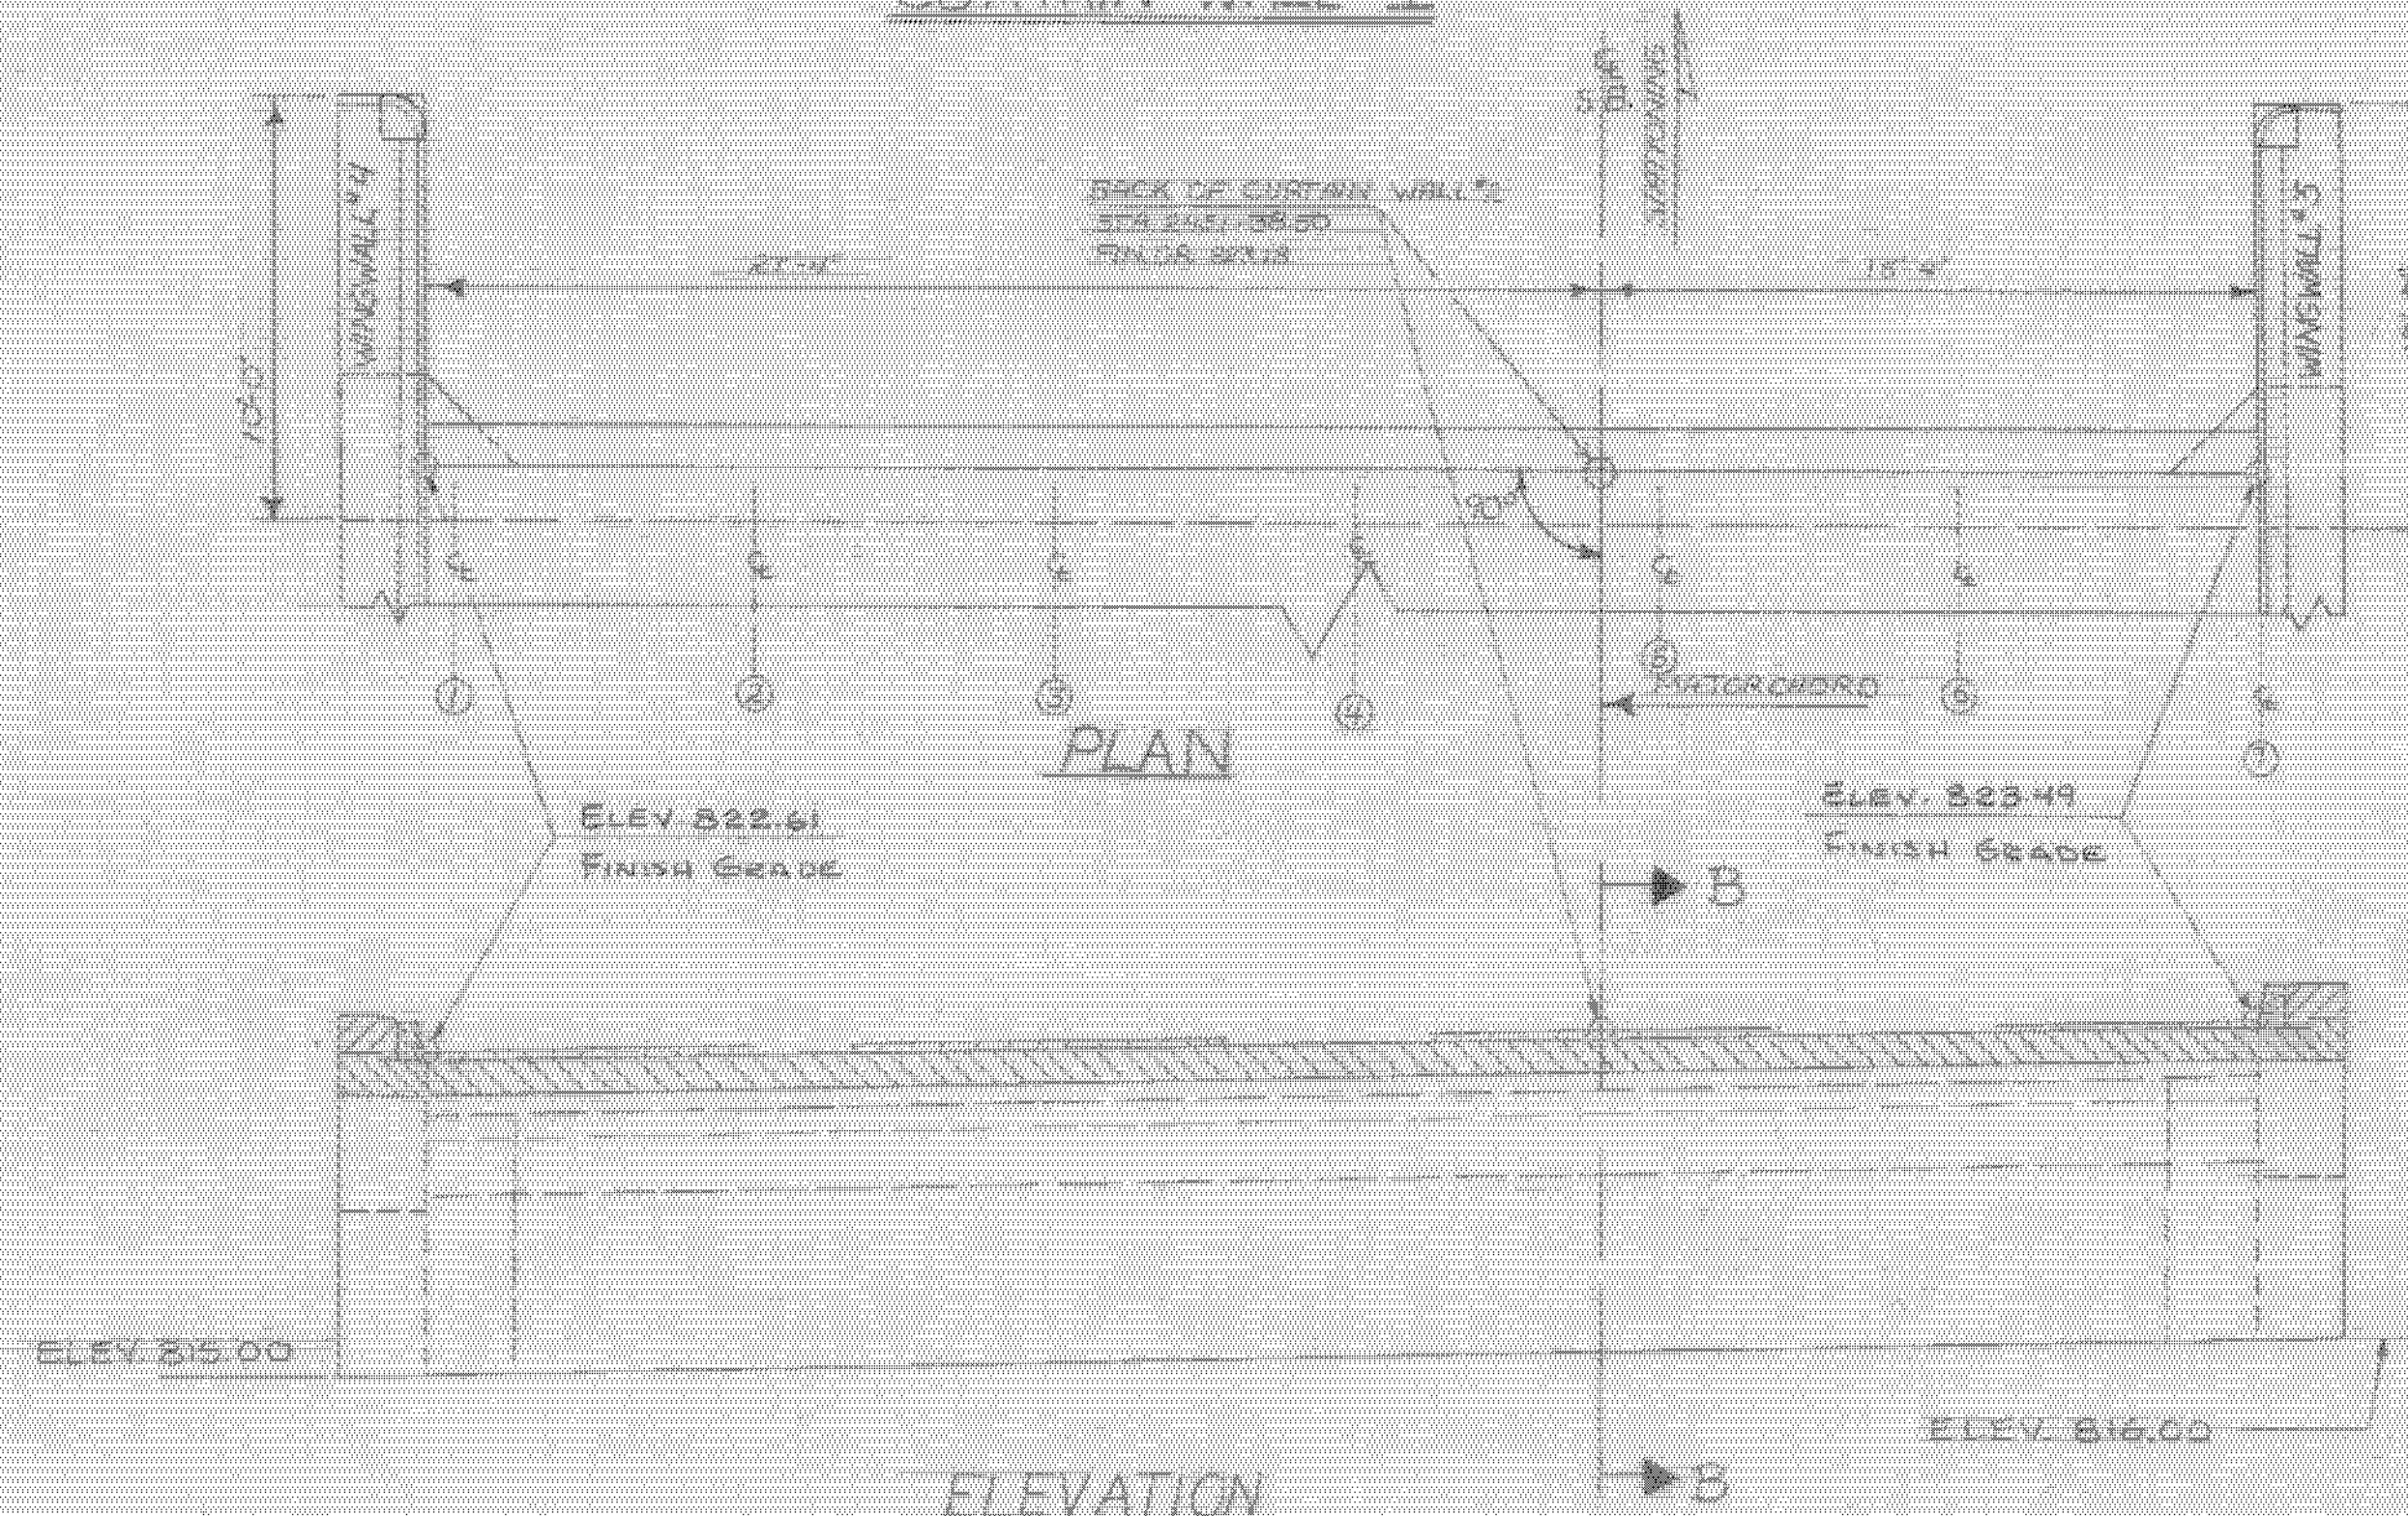

ELEVATION
CURTAIN WALL #2

BARTON-COVENTRY
IM BPNT (11)
SHEET 52 OF 84
BRIDGES 106N&S
FOR REFERENCE ONLY

Stage 1 Construction

STATE OF VERMONT
DEPARTMENT OF HIGHWAYS
PROJECT: Barton-Ingalls
TOWN OF: Barton BR# 106
ROUTE NO. 291 IN STA. 2450+
I-91 OVER US 5
CURTAIN WALL & WING WALL DETAILS,
SCALE 1/4" = 1'-0" Sheet #1
SECTION SUPERVISOR: R. W. Bolkm - 8/69
DRAWN BY: J. J. [unclear] CHECKED BY: OUELLETTE
PROJECT NO. I-91-3(26) 8/69
SHEET 42 OF 115 BR109