


PLAN

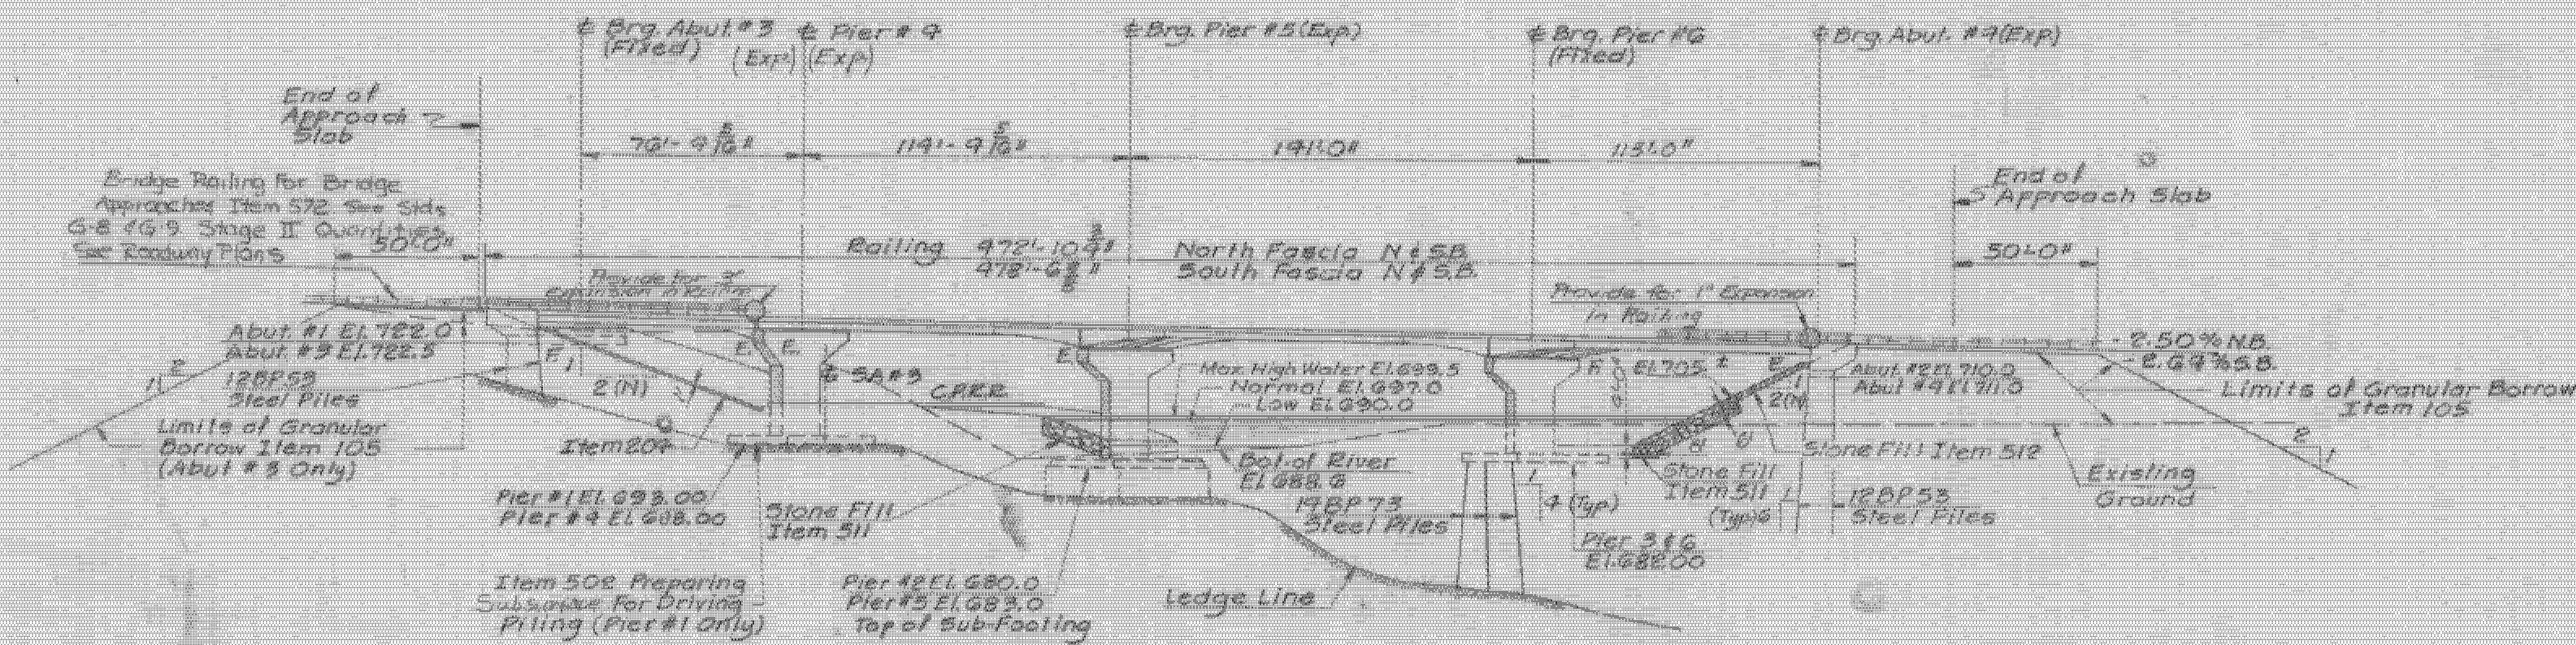

ELEVATION

LIST OF SHEETS

- Br100 Plan & Elevation
- Br101-102 Bridge Quantity Sheets
- Br103 Preliminary Information Sheet
- Br104-106 Boring Logs
- Br107 Framing Plan & Girder Details
- Br108 Girder Elevation & Conn. Details
- Br109 Deck Section & Splice
- Br110 Expansion Dam & Scupper Details
- Br111 Rocker Bearings
- Br112 Abutment #1
- Br113 Abutment #2
- Br114 Abutment #3
- Br115 Abutment #4
- Br116 Abutment #2 & #4 Details
- Br117 Abutment #1 & #3 Approach Slab
- Br118 Abutment #2 & #4 Approach Slab
- Br119 Pier #1
- Br120 Pier #2
- Br121 Pier #3
- Br122 Pier #4
- Br123 Pier #5
- Br124 Pier #6
- Br125-128 Reinforcing Schedules
- Br129 Channel Sections

STANDARD SHEETS REQUIRED

- SCB D1 67 General Notes & Information Jan 24, 68
- SCB D2 67 Detail A'18'PC Jan 24, 68
- SCB D3 67 Drain Trough Details Jan 24, 68
- SCB D4 67 Reinforcing at Abutments Dec 17, 68
- SCB D6 67 Detail A'18'PC May 23, 1969A
- SCB D7 67 Intermediate Diaphragm Jan 24, 68
- SCB D8 67 Bearing Devices Jan 24, 68
- SCB D9 67 Detail A'18'PC Jan 24, 68
- SB R1 67 Aluminum Flooring (2 Sheets) Sheet for 2 Dec 14, 1968A - 2 of 2 Nov 6, 68 R
- SB R2 65 Steel Bridge Flooring - Max 8, 68 R

NOTE:

The channel excavation and stone fill shall be done between July 1 and October 1 so as not to interfere with the Rainbow Trout runs. Precautions shall be taken during construction to prevent siltation or pollution of the river.

BARTON-COVENTRY
IM BPNT (11)
SHEET 57 OF 84
BRIDGE 107S
FOR REFERENCE ONLY

STATE OF VERMONT
DEPARTMENT OF HIGHWAYS

PROJECT IRASBURG-LEREY
TOWN OF IRASBURG 82-107

ROUTE No. 1-3 STA. 2532

I-91 OVER GARDNER RIVER AND RAY'S

PLAN AND ELEVATION

SCALE 1" = 30'

IN CHARGE G. TARRANT

DRAWN BY JMS Checked by A. CENTOFF

PROJECT NO. 79-3(9) 9-67

SHEET 162 OF 165 BR 100