



PLAN

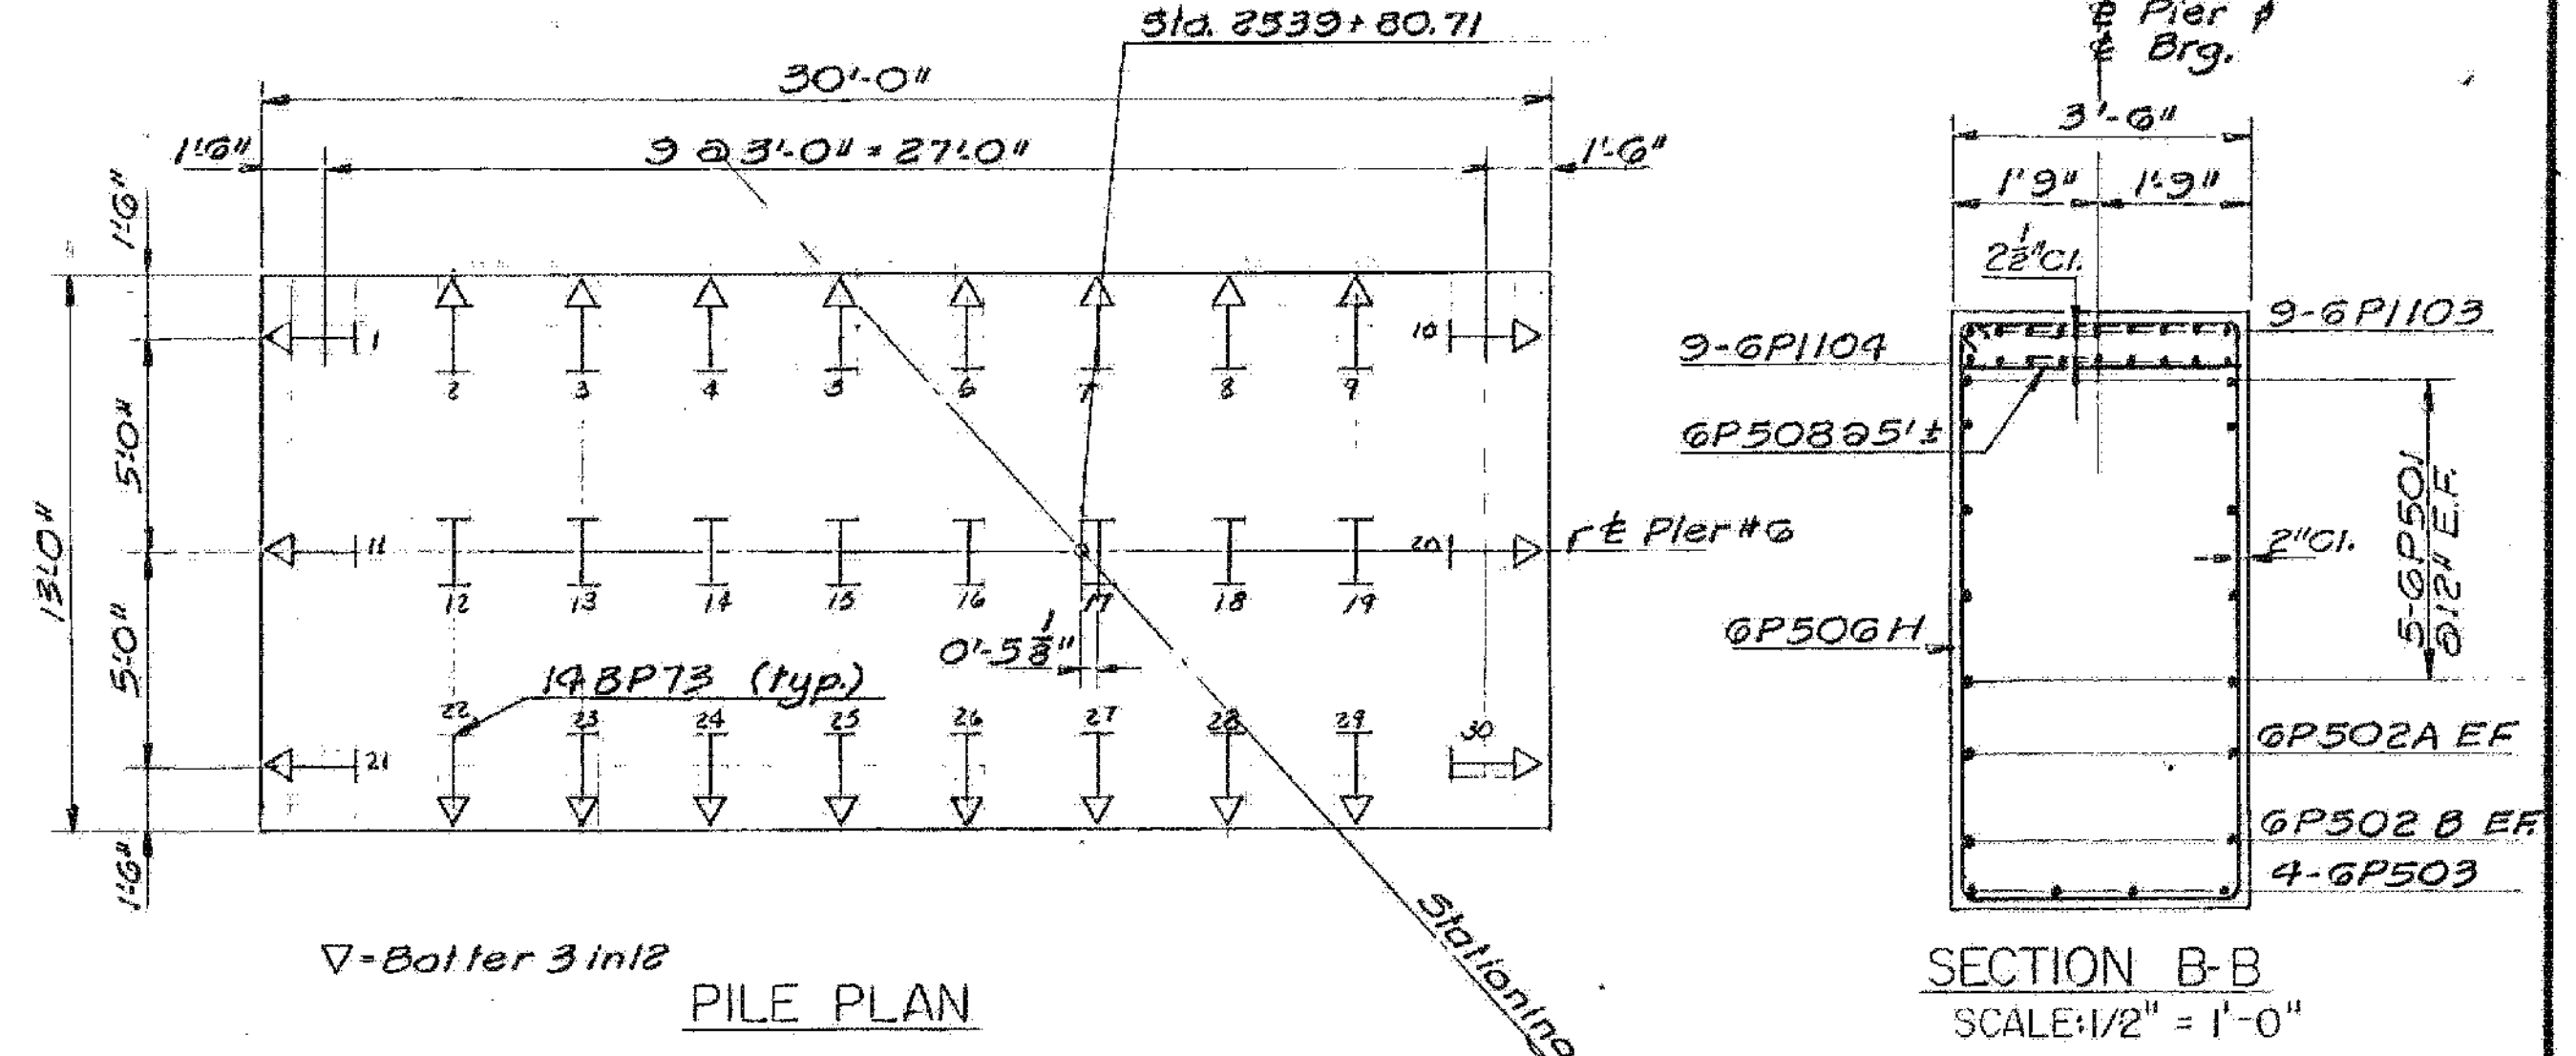


PILE PLAN


SECTION B-B
SCALE: 1/2" = 1'-0"

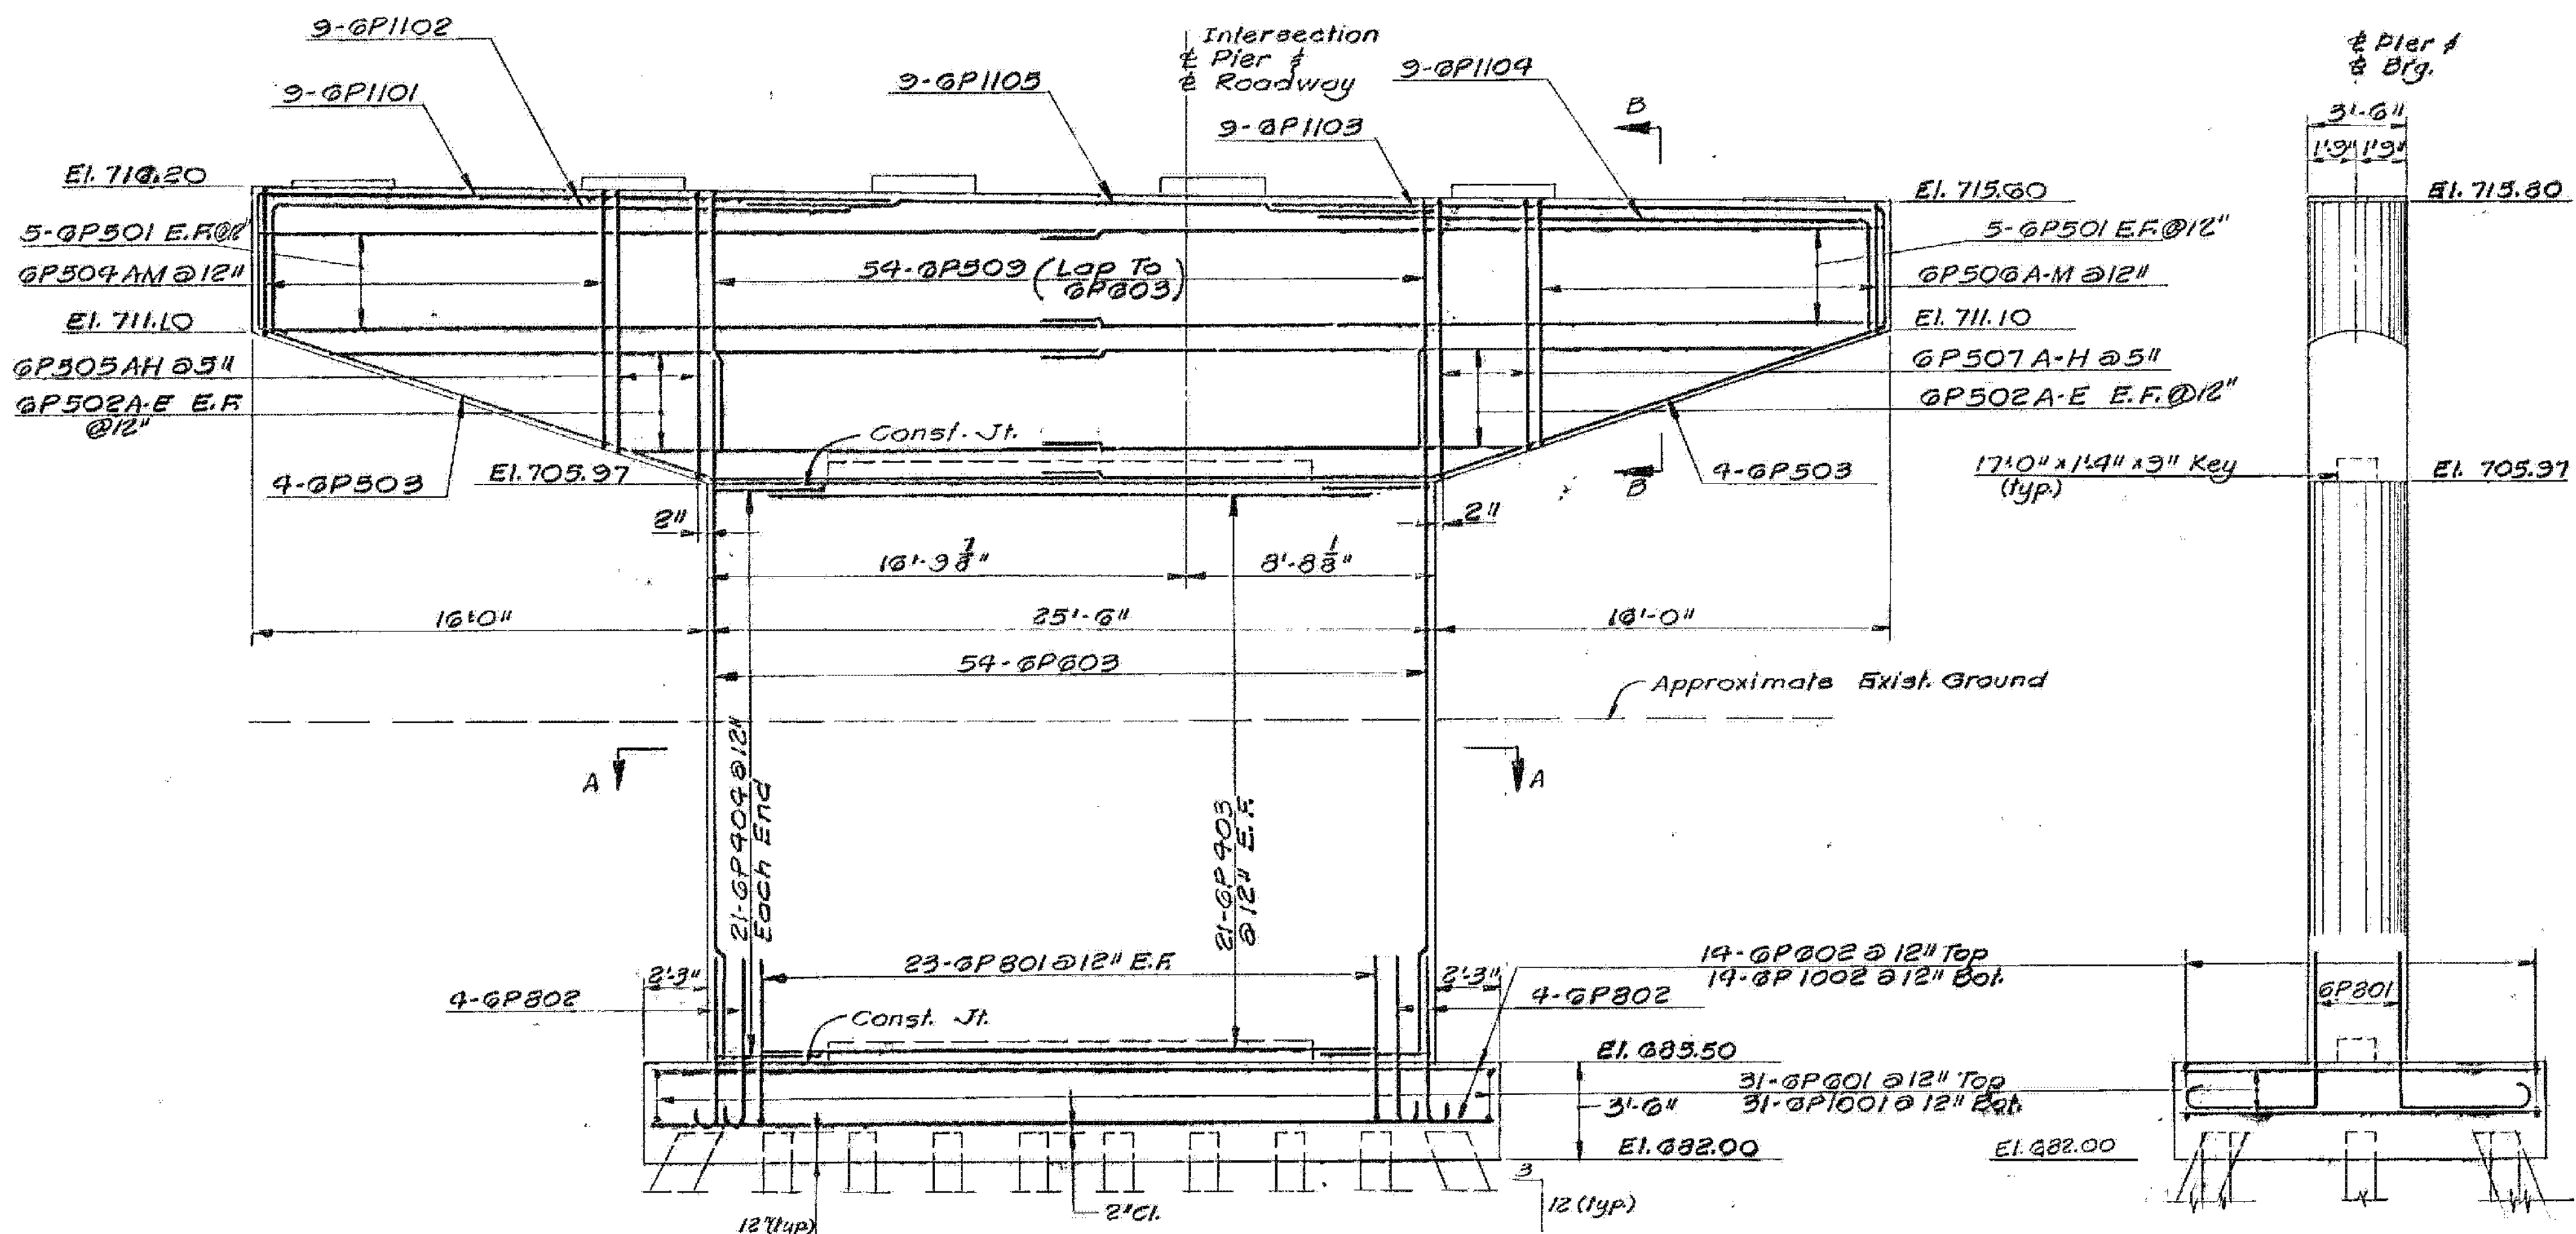


ELEVATION

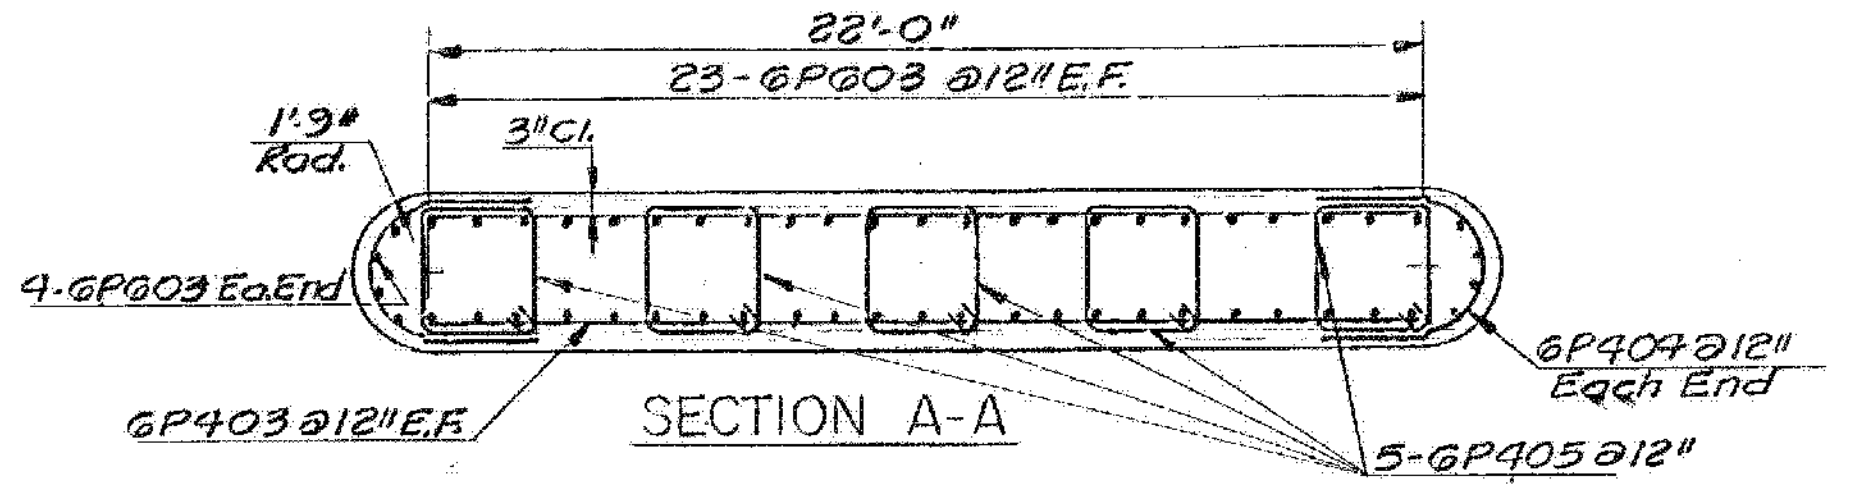

SECTION A-A

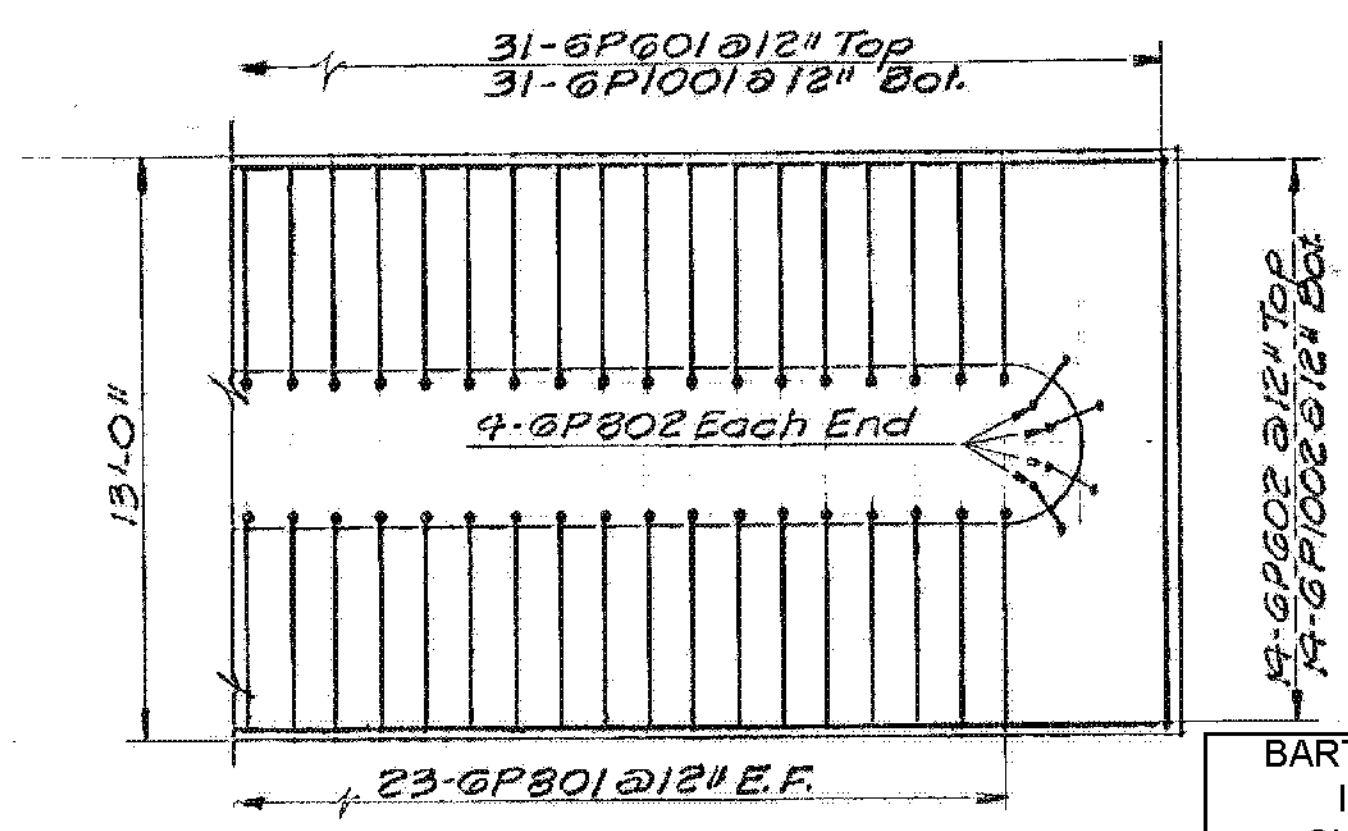

PARTIAL PLAN OF FOOTING REINFORCEMENT

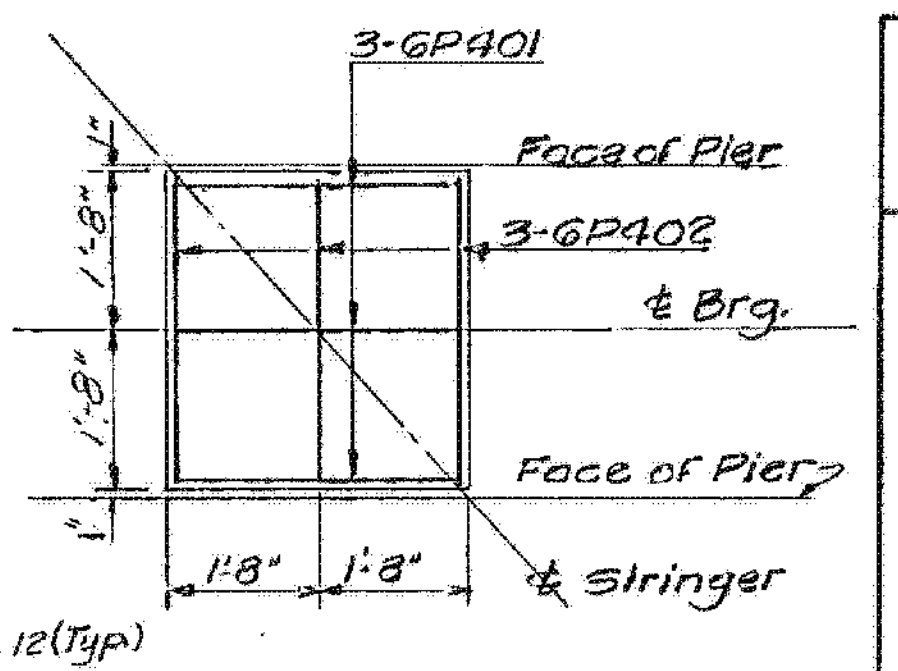

BEARING PAD REINFORCEMENT
N.T.S.

BARTON-COVENTRY
IM BNPT (11)
SHEET 74 OF 84
BRIDGE 107S
FOR REFERENCE ONLY

Br. 124 OF 129

STATE OF VERMONT
DEPARTMENT OF HIGHWAYS

PROJECT IRASBURG - DERBY
TOWN OF IRASBURG
ROUTE No. I-91 STA. 2539 ±
I-91 OVER BARTON RIVER AND 'SA' 3
PIER # 6
SCALE 1/4" = 1'-0" Except as Noted
IN CHARGE C. TERENCE
DRAWN BY JMB CHECKED BY A. CENTORE
PROJECT No. 191-3(8) 9-67
SHEET 193 OF 305 BR. 124