


PLAN

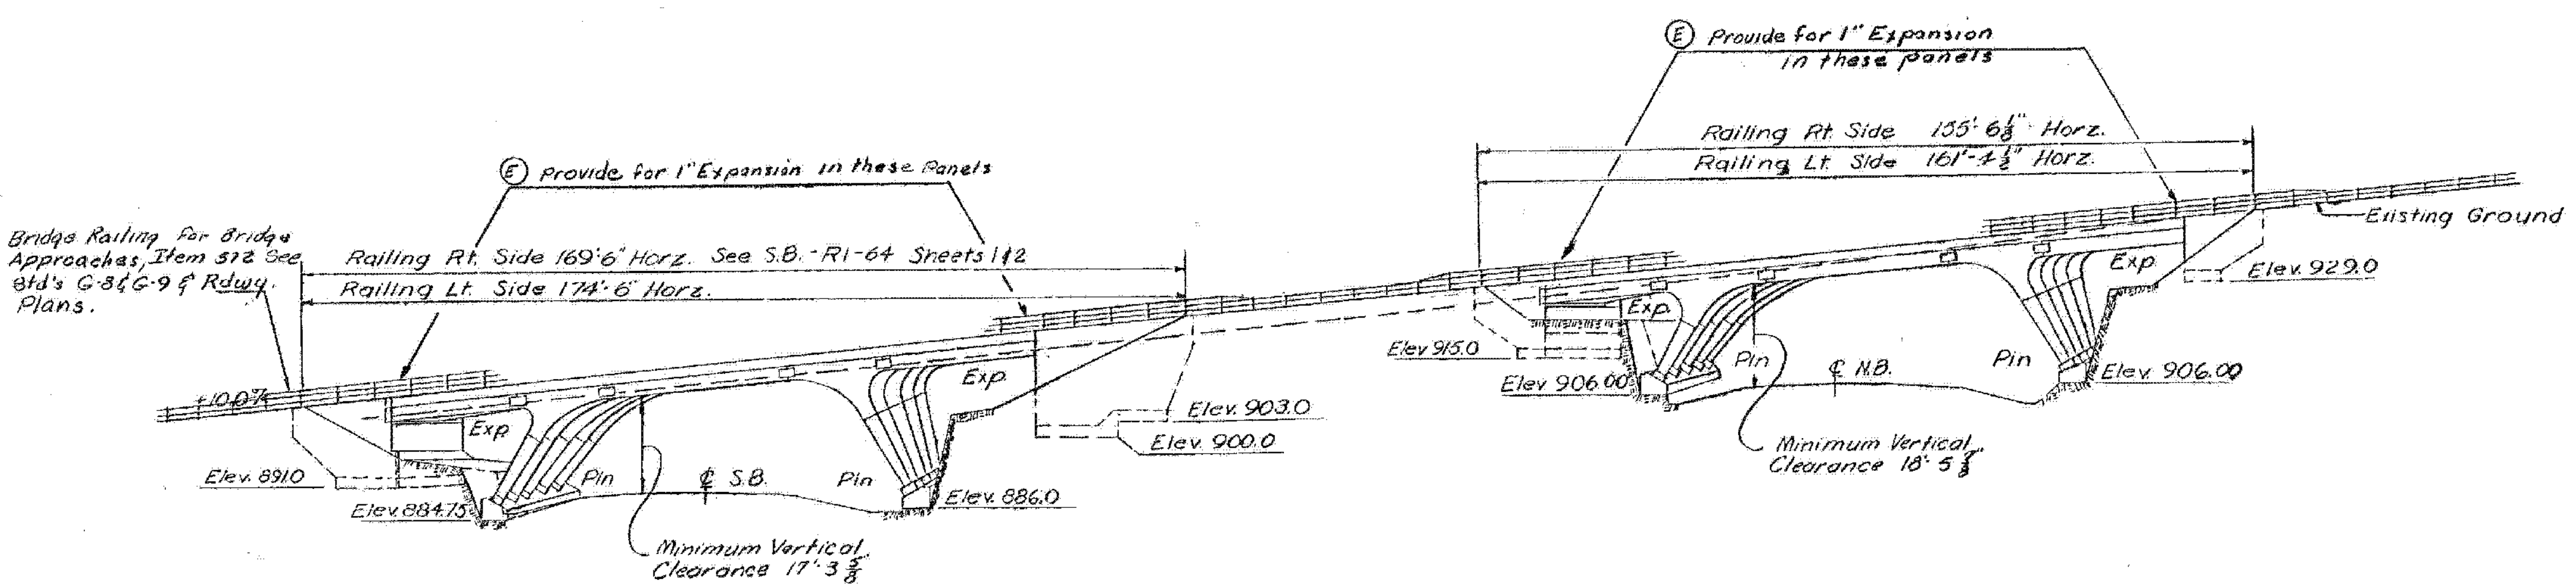

ELEVATION

List of Sheets.

- Br. 200 Plan And Elevation Sheet
- Br. 201 Bridge Quantity Sheet
- Br. 202 Preliminary Information Sheet
- Br. 203 Boring Logs
- Br. 204 Framing Plan And Deck Details
- Br. 205 Steel Details
- Br. 206 Frame Footing Details
- Br. 207 Abutment No. 1
- Br. 208 Abutment No. 2
- Br. 209 Abutment No. 3
- Br. 210 Abutment No. 4
- Br. 211-12 Reinforcing steel schedules

Standard Sheets Required

- SCB-D1-67 General Notes And Information 1/24/68
- SCB-D4-67 Reinforcing At Abutments 12/1/68
- SCB-D6-67 Details "A" And "B" 5-23-67 R
- SCB-D7-67 Detail "D" 1/24/68
- SCB-D8-67 Detail "A" 1/24/68
- SCB-D9-67 Detail "A" 1/24/68
- SB R-164 Aluminum Bridge Railing (2 sheets)
Sh. 1 of 2 12/11/68 R
Sh. 2 of 2 11/8/68 R

General Notes

1. See General Notes - Standard Sheet SCB-D1-67
2. For Super Structure Typical See BR 204
3. Item 440 Water Repellent Shall Consist Of Furrushing And Applying Water Repellent On Exterior Concrete Surfaces On Top Of The Safety Walks, On The Fascia And Back To The Fascia Beam Under The Slab, On The Frame, Footings And Exposed Areas Of Abutments Not Otherwise Treated.

BARTON-COVENTRY
IM BPNT (11)
SHEET 76 OF 84
BRIDGES 108N&S
FOR REFERENCE ONLY

Changed Rwy width from 30'-0" to 31'-4", curb width from 2'-8" to 2'-0". Updated Standard Sheets
P. Testa 4/28/69

ITEM NO.	ITEM	UNIT	NET	TOTAL	FINAL
	CHAN. EXCAV. OF EARTH	C.Y.			
	CHAN. EXCAV. OF ROCK	C.Y.			
	UNCLASS. CHAN. EXCAV.	C.Y.			
	STRUCT. EXCAV.	C.Y.			
	CONC. CLASS AA (MOD.)	C.Y.			
	CONC. CLASS B (MOD.)	C.Y.			
	REINF. STEEL	LBS.			
	ASPHALTIC-ASB. COATING	S.Y.			
	TREATED TIMBER PILING	L.F.			
	SPLICES FOR STEEL PILING	EA.			
	STEEL PILING	L.F.			
	UNTREATED TIMBER PILING	L.F.			

STATE OF VERMONT
DEPARTMENT OF HIGHWAYS
PROJECT IRASBURG-DERBY
TOWN OF COVENTRY
ROUTE No. 1-91 STA. 2683+
SA 3 OVER I-91 NB&SB
PLAN & ELEVATION
SCALE 1 IN. = 20 FT.
IN CHARGE EDWARDS & KELCEY
DRAWN BY SCURRAN CHECKED BY ACENTORE
PROJECT No. 1-91-3(8)
SHEET 199 OF 605 BR 200