



PLAN


For Corner Reinforcing Details, Superstructure Details At Abutment
And Abutment Notes See Br. Sh. 207
For Curb Joint Detail See Br. Sh. 209

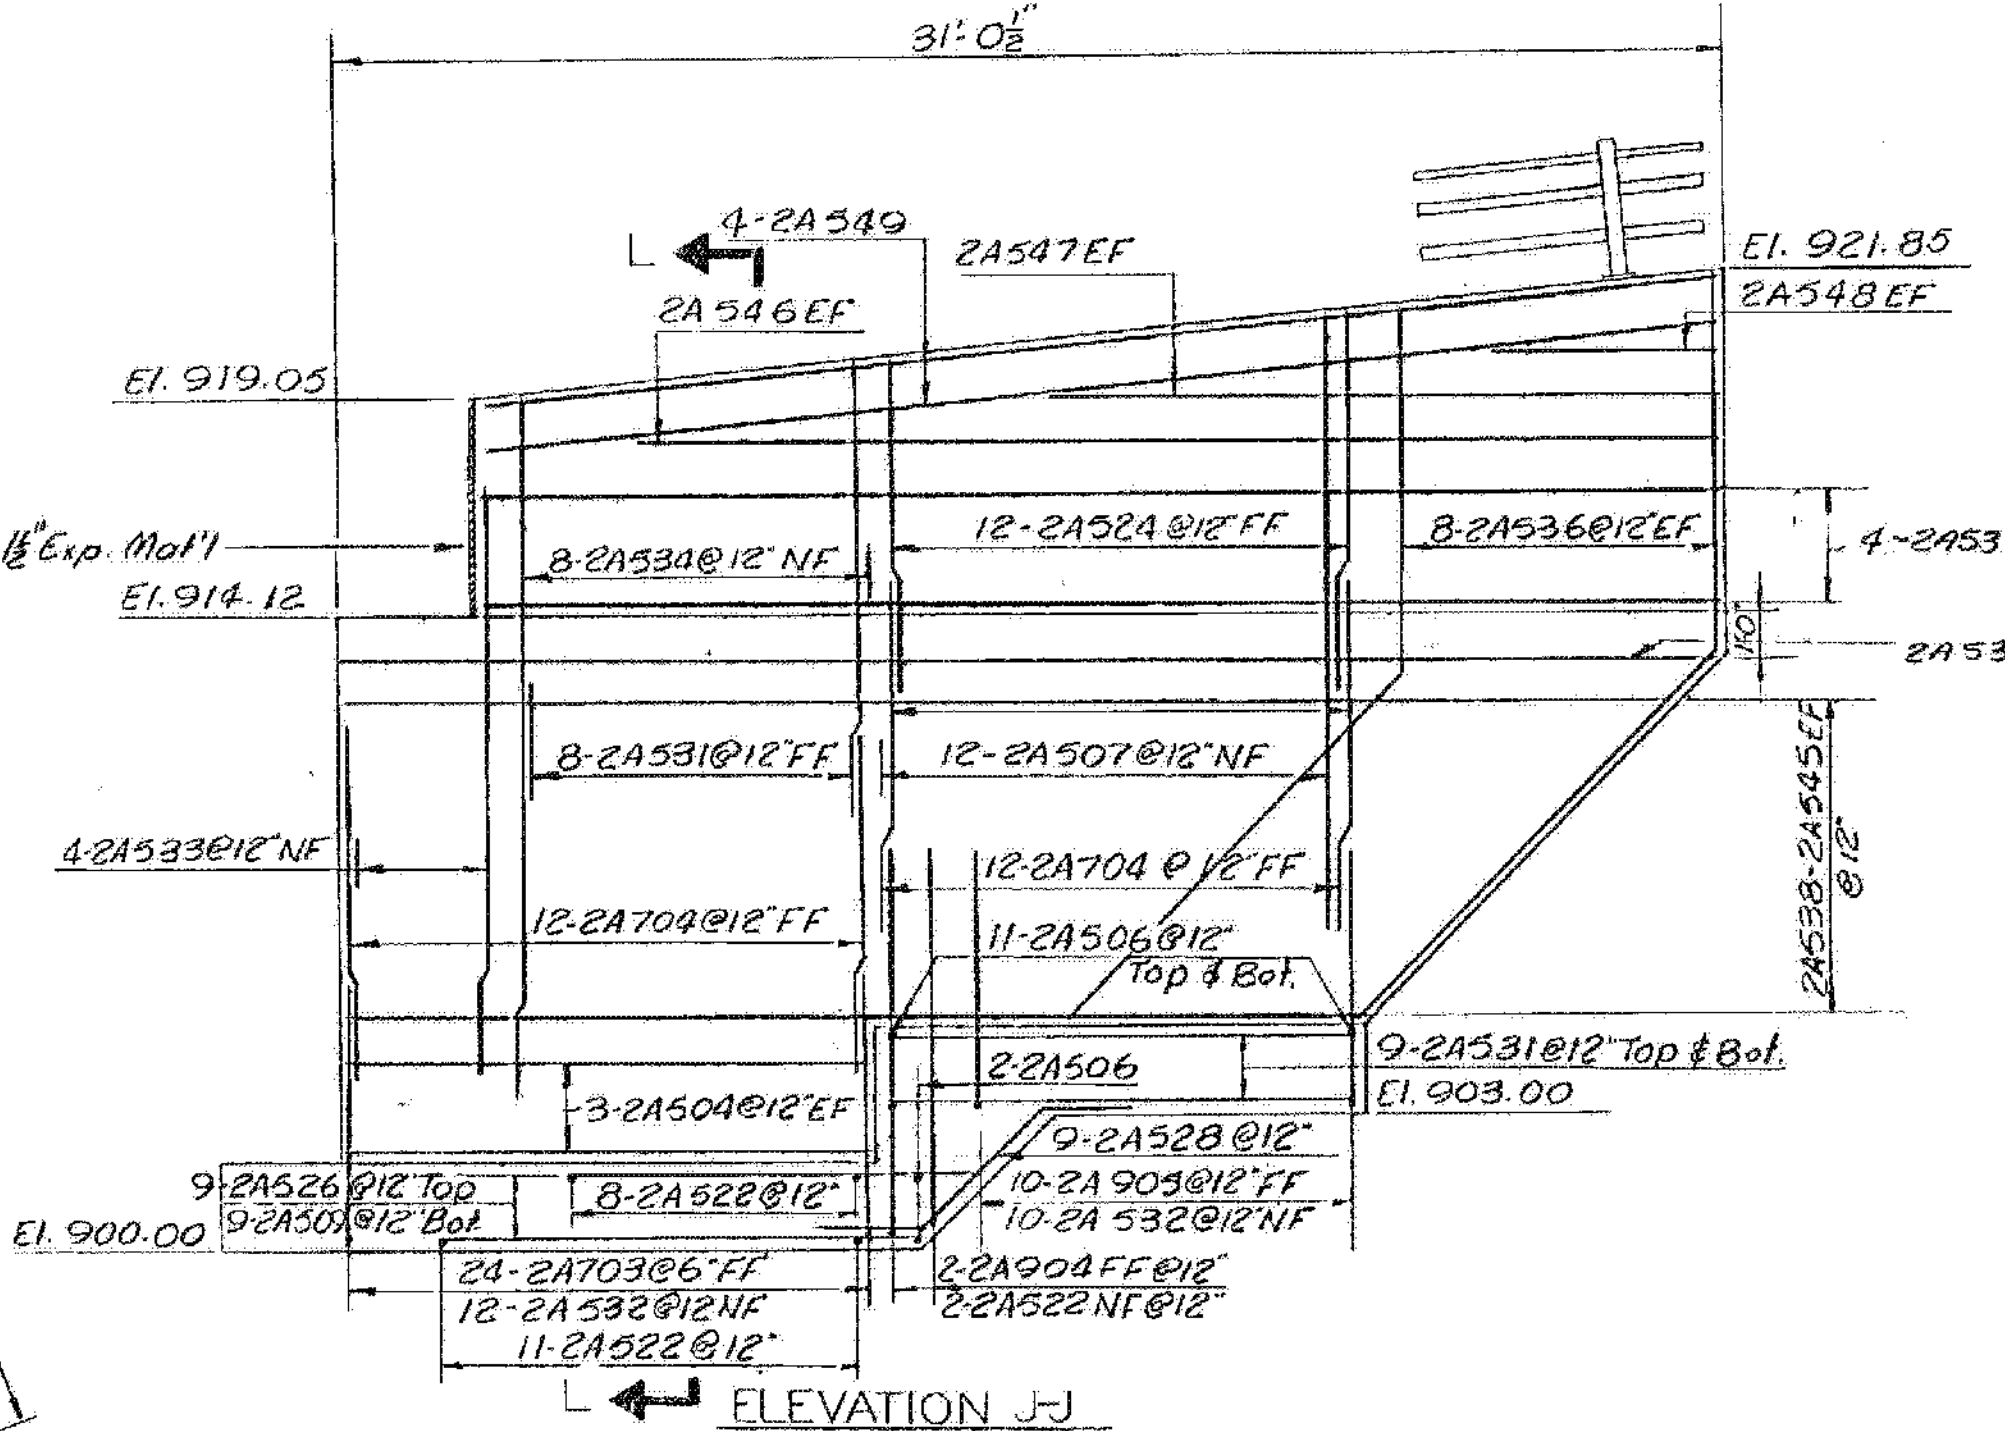


ELEVATION JJ

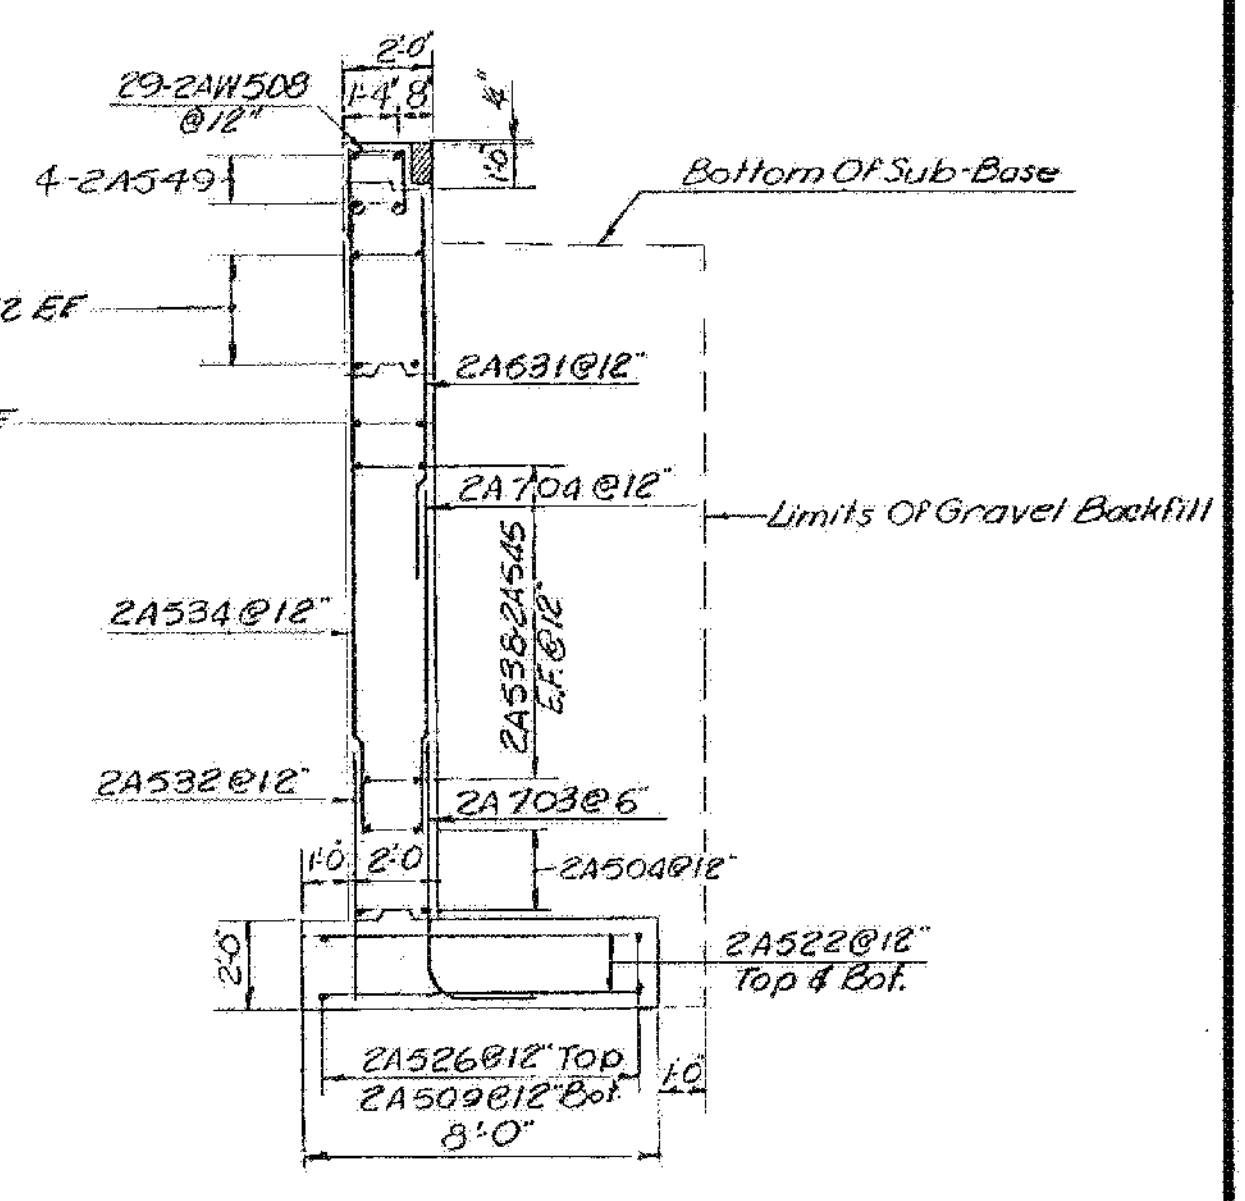

SECTION L-L

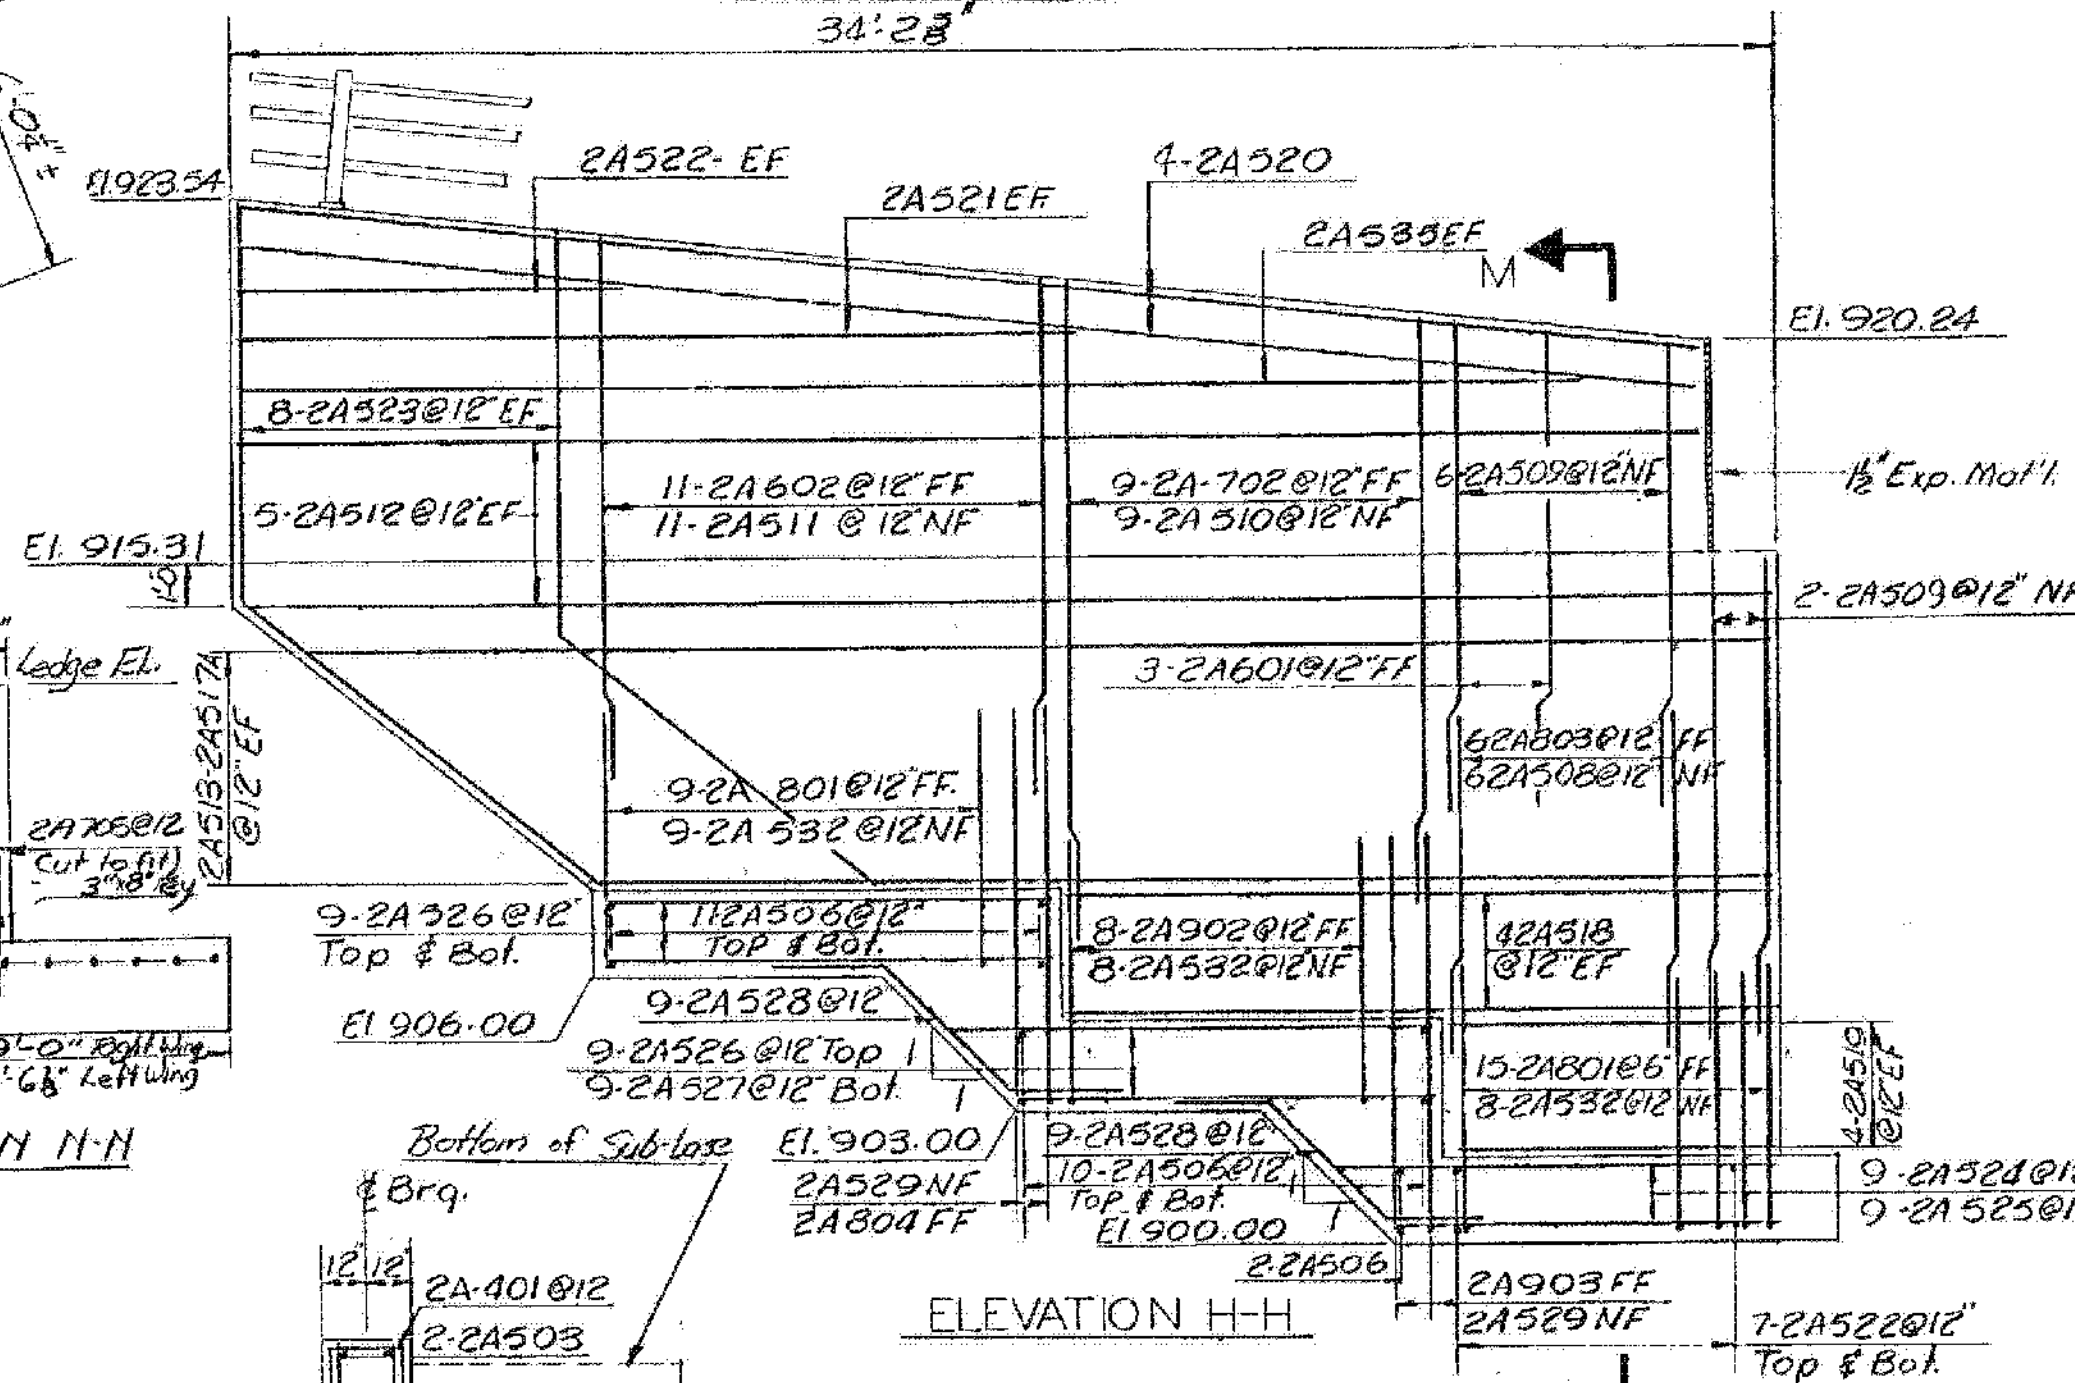


ELEVATION H-H

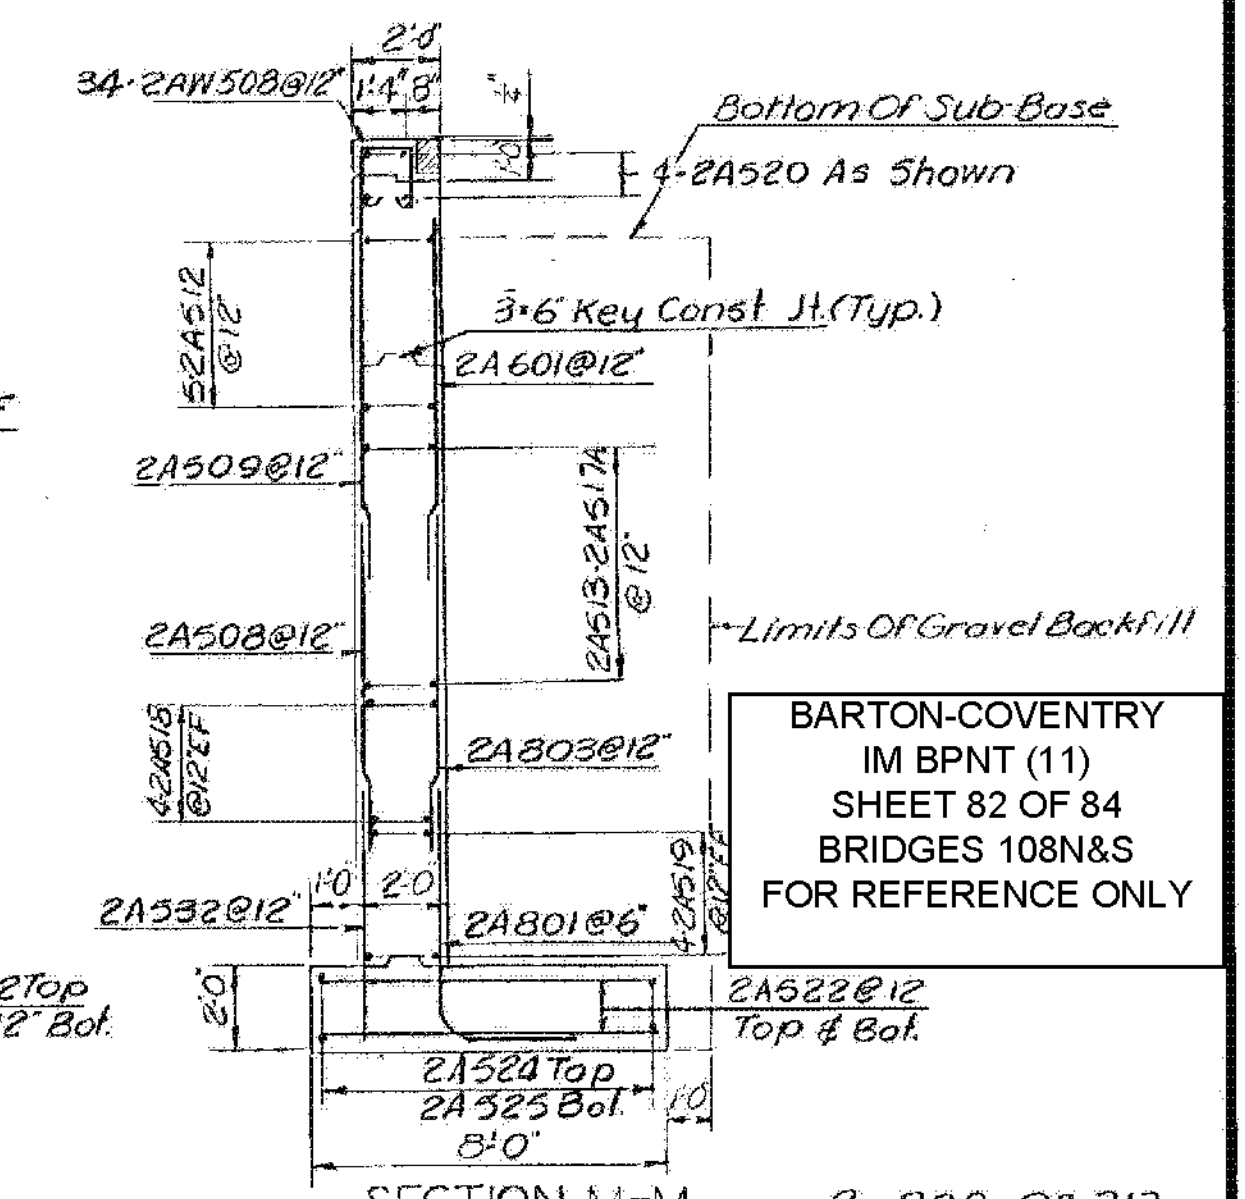


SECTION M-M


BARTON-COVENTRY
IM BPNT (11)
SHEET 82 OF 84
BRIDGES 108N&S
FOR REFERENCE ONLY

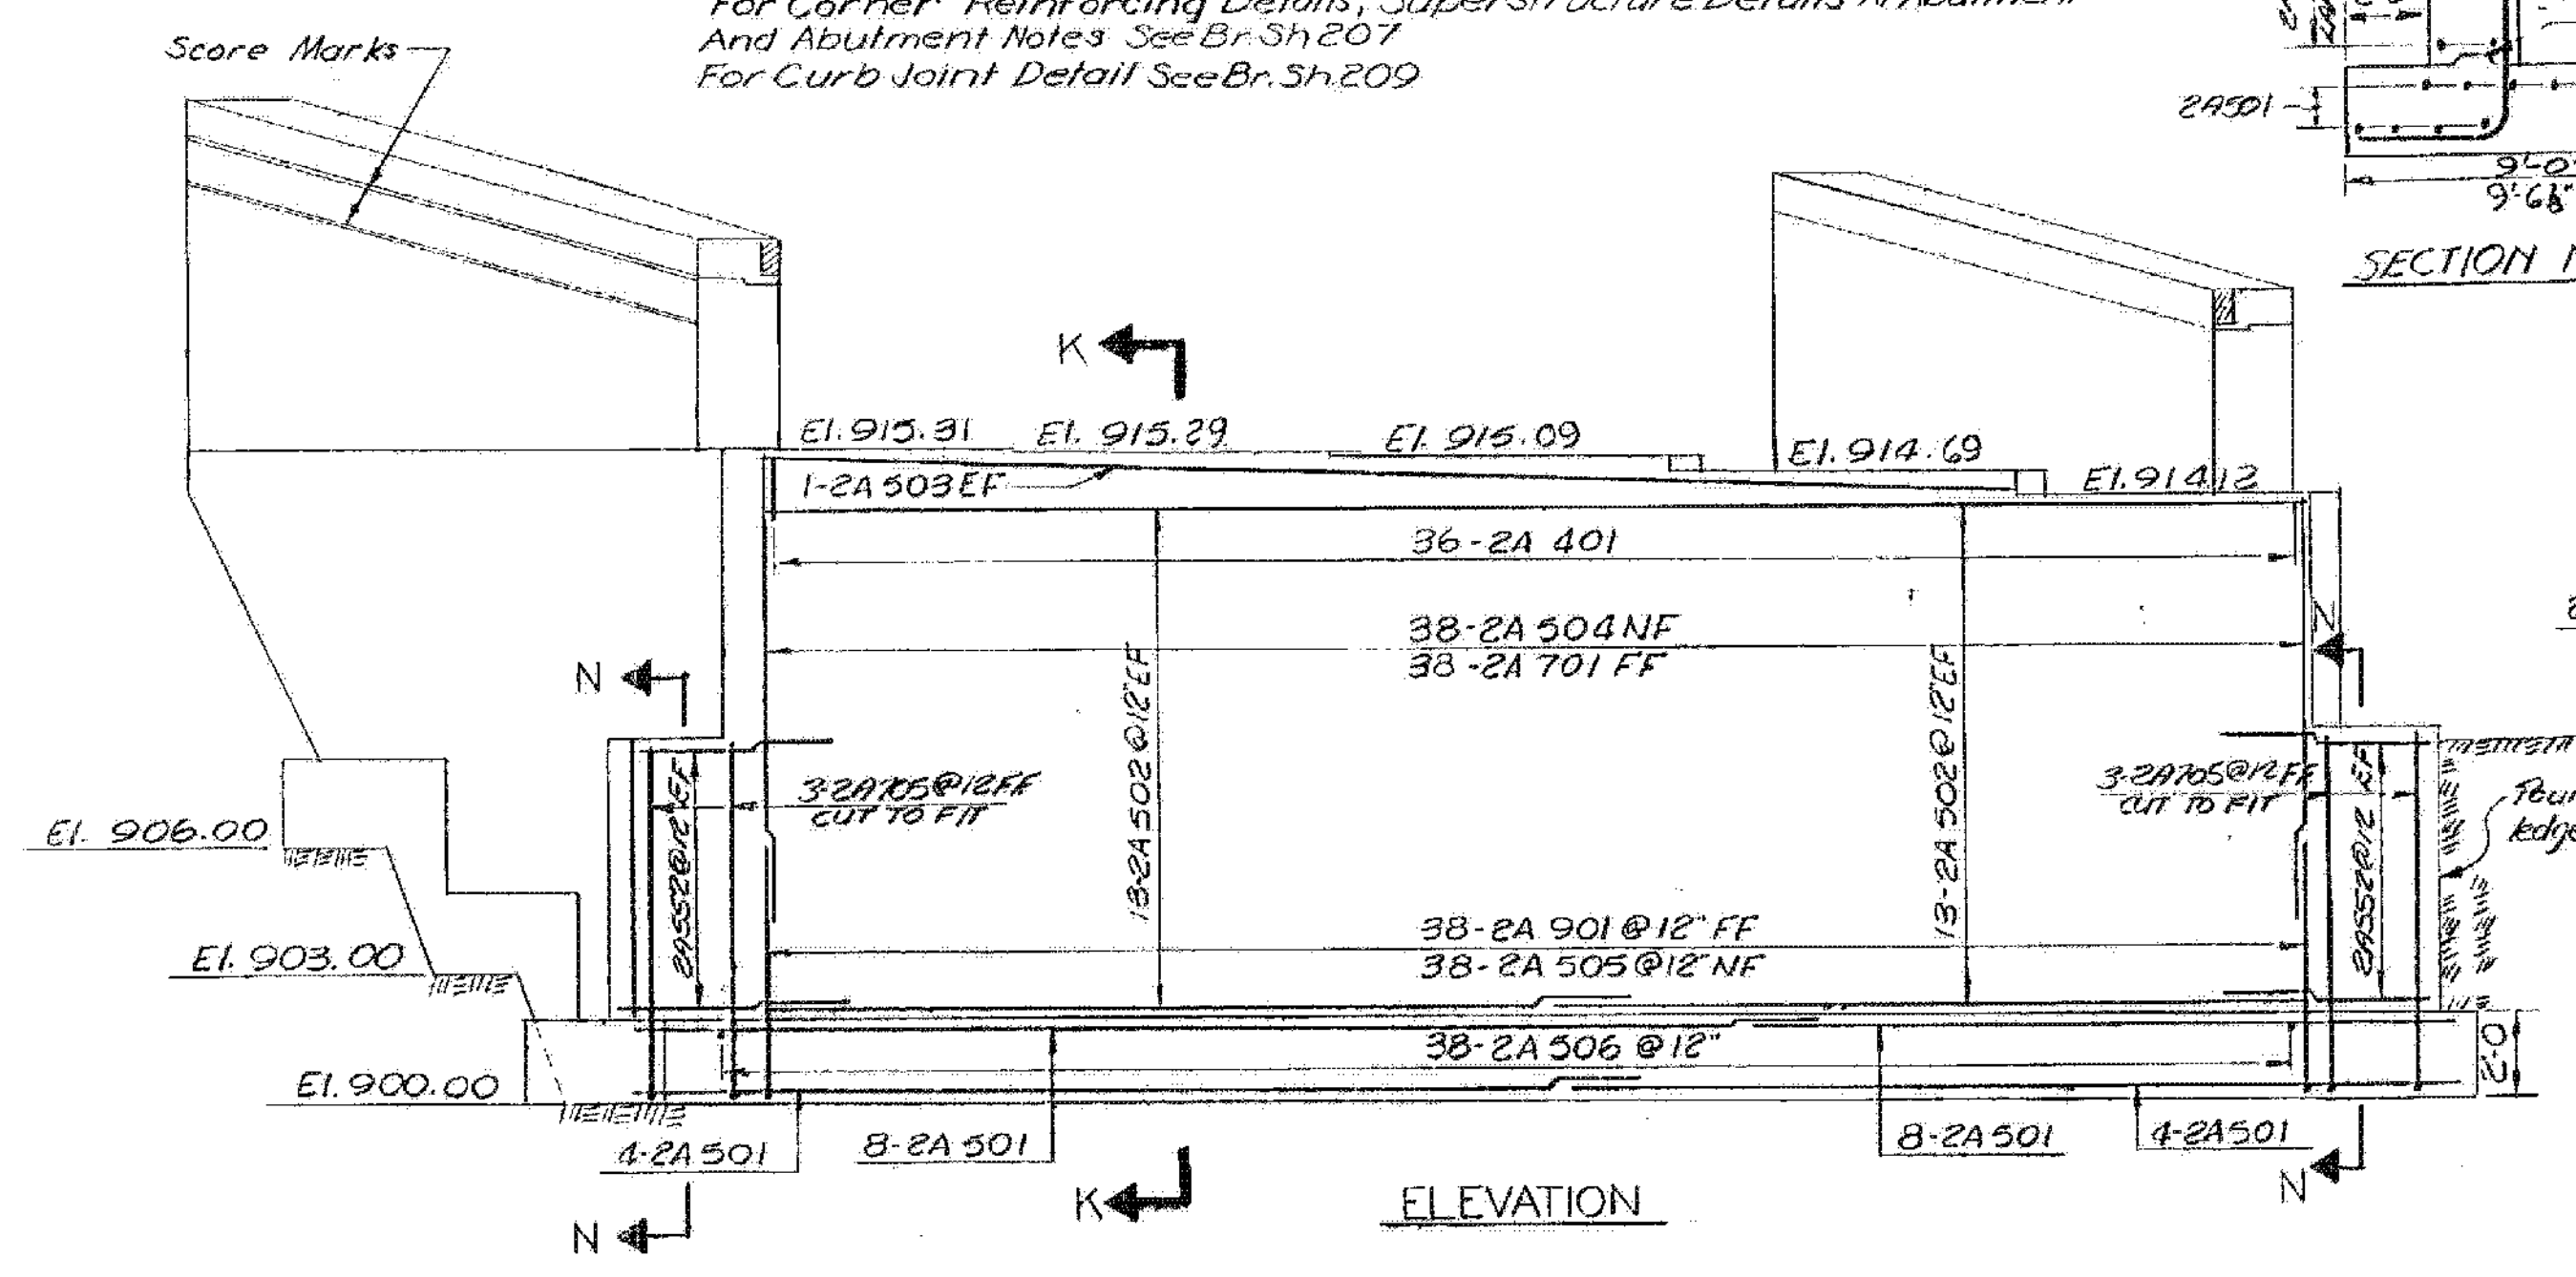

ELEVATION

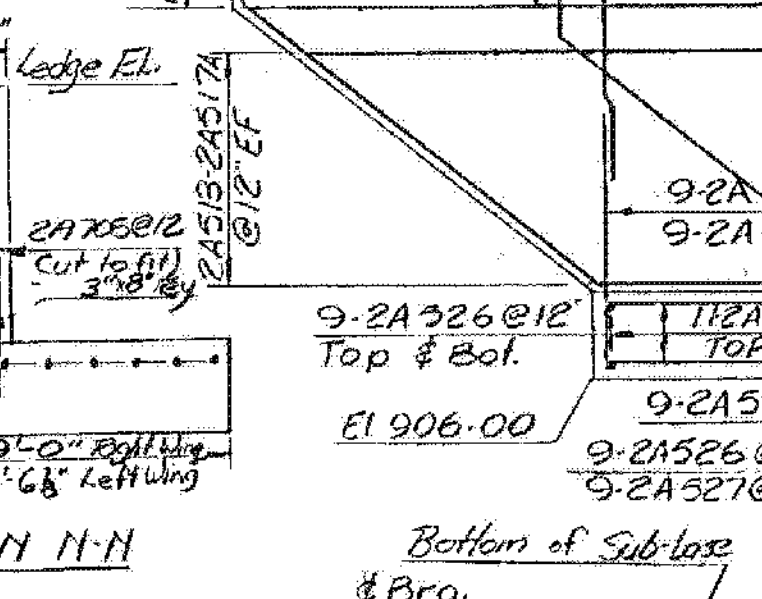

SECTION N-N

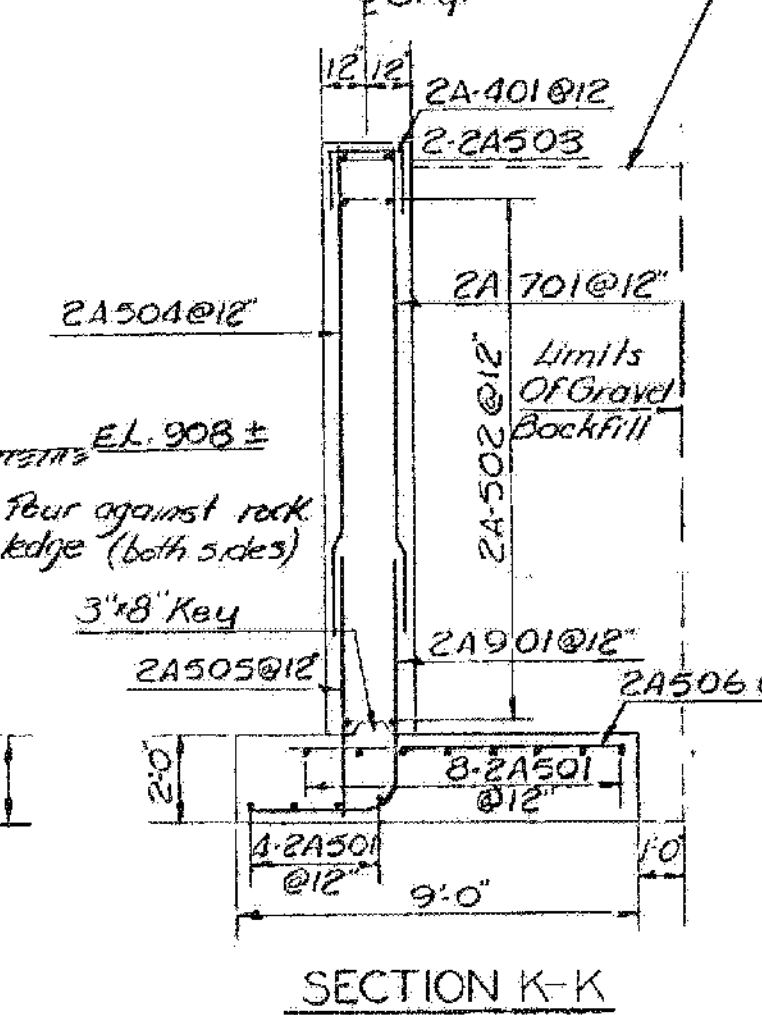

SECTION K-K

ITEM NO.	ITEM	UNIT	NET	TOTAL	FINAL
	CHAN. EXCAV. OF EARTH	C.Y.			
	CHAN. EXCAV. OF ROCK	C.Y.			
	UNCLASS. CHAN. EXCAV.	C.Y.			
	STRUCT. EXCAV.	C.Y.			
	CONC. CLASS AA (MOD.)	C.Y.			
	CONC. CLASS B (MOD.)	C.Y.			
	REINF. STEEL	LBS.			
	ASPHALTIC-ASB. COATING	S.Y.			
	TREATED TIMBER PILING	L.F.			
	SPLICES FOR STEEL PILING	EA.			
	STEEL PILING	L.F.			
	UNTREATED TIMBER PILING	L.F.			

Some changes as per 207 Closure
wall added to both sides. E. 1/24/49

STATE OF VERMONT
DEPARTMENT OF HIGHWAYS

PROJECT: IRASBURG-DERBY
TOWN OF: COVENTRY

ROUTE No. 191 STA. 2083±
SA3 OVER I-91
ABUTMENT #2

SCALE 1/4"=1'-0"
IN CHARGE: EDWARDS & KELCEY

DRAWN BY: D. LEE CHECKED BY: ACENTORE
PROJECT NO. I 91-3(8) 4-66
SHEET 207 OF 605 BR 208