


STATE OF VERMONT AGENCY OF TRANSPORTATION



PROPOSED IMPROVEMENT CITIES OF BURLINGTON AND SO. BURLINGTON COUNTY OF CHITTENDEN INTERSTATE ROUTE 189 EASTBOUND AND WESTBOUND TOWNS OF SWANTON AND HIGHGATE COUNTY OF FRANKLIN INTERSTATE ROUTE 89 NORTHBOUND

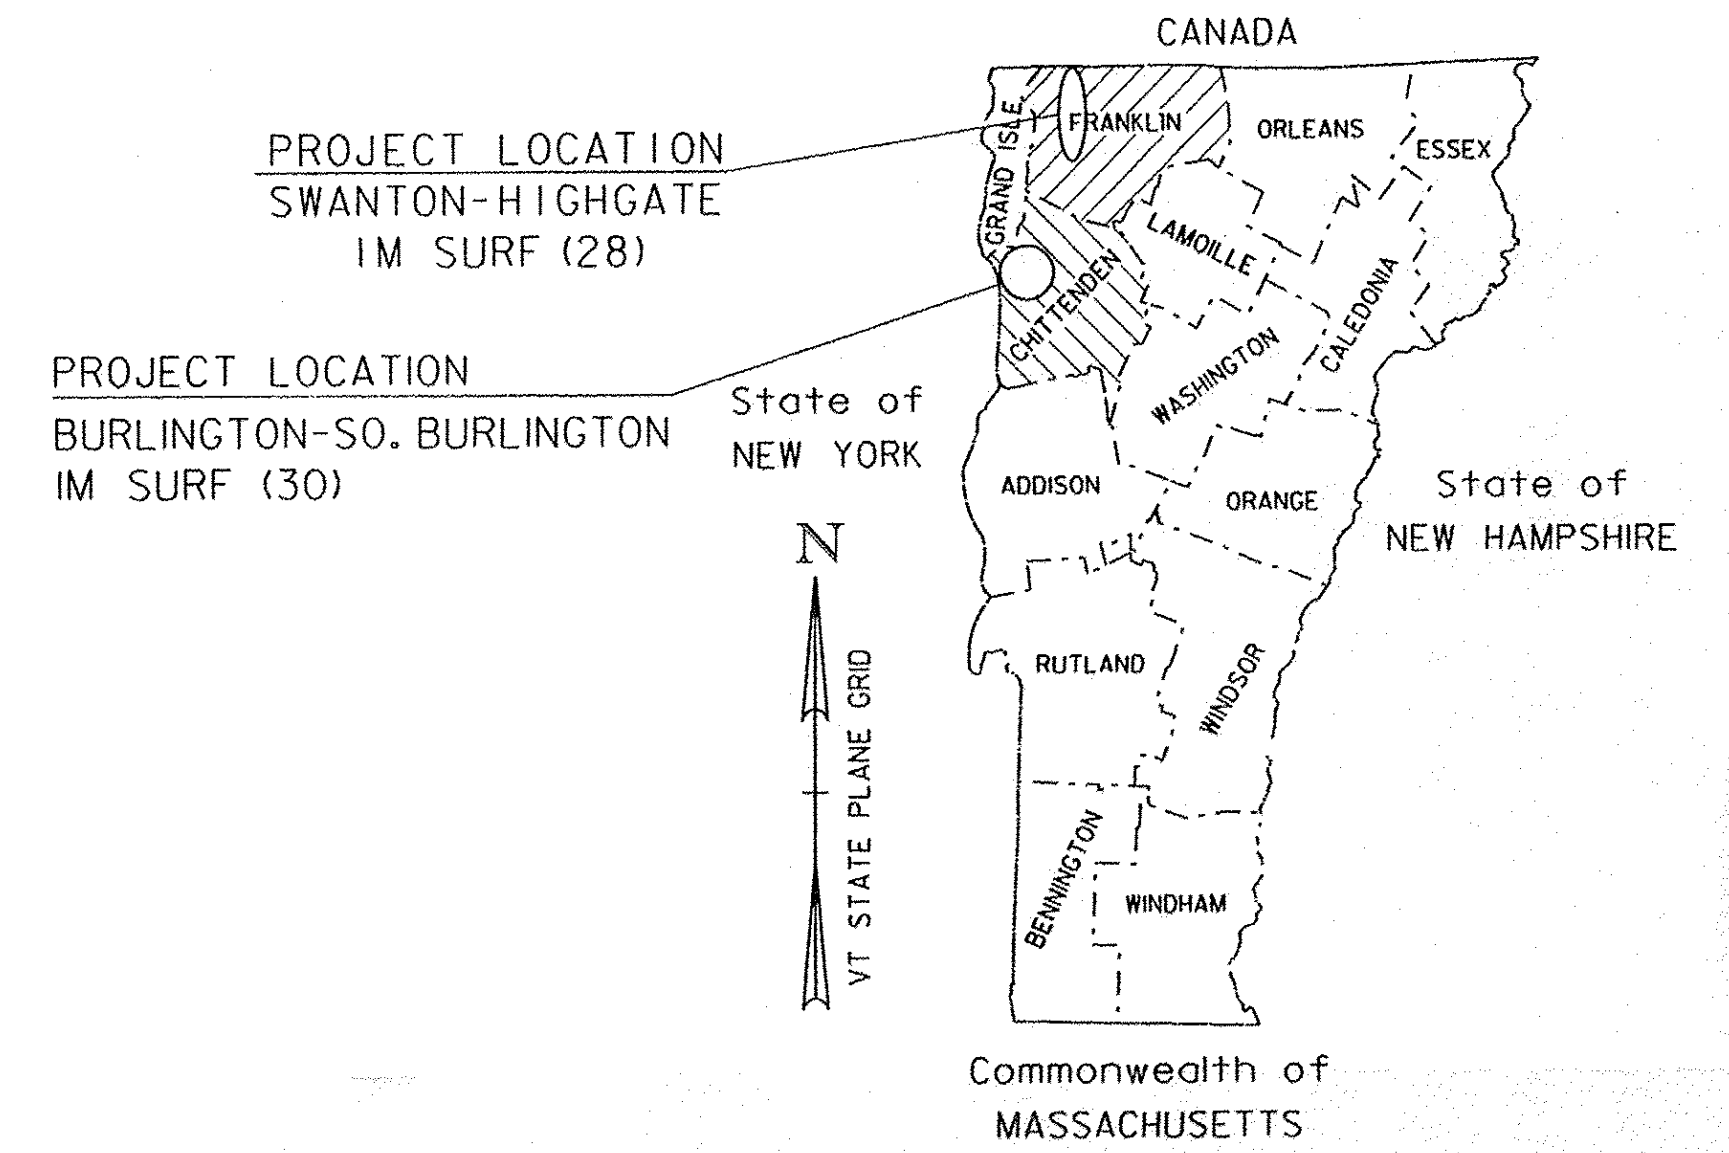

RECORD PLANS	
CONTRACTOR:	PIKE INDUSTRIES, INC. - BERLIN, VT
RESIDENT ENGINEER:	BOB SUCKERT
CONSTRUCTION BEGAN:	JULY 15, 2012
CONSTRUCTION COMPLETE:	OCTOBER 1, 2012
RECORD PLANS BY:	BOB SUCKERT
I HEREBY CERTIFY THAT ALL THE CONSTRUCTION REQUIRED BY THIS SET OF DRAWINGS HAS BEEN ACCOMPLISHED AS INDICATED HEREIN.	
BY	<i>Bob Suckert</i> RESIDENT ENGINEER
DATE	3-13-15
NOTE: Any further information concerning final quantities, amounts or other details relative to this project may be found at Central Files in the electronic archives.	



BURLINGTON-SO. BURLINGTON
IM SURF (30)
SEE SHEET 11
FOR ADDITIONAL PROJECT INFORMATION

SWANTON-HIGHGATE
IM SURF (28)
SEE SHEET 38
FOR ADDITIONAL PROJECT INFORMATION

- UTILITY LEGEND**
- ⊙ = EXISTING HYDRANT
 - ⊠ = EXISTING DI
 - = EXISTING MANHOLE
 - ⊙ TEL = EXISTING TELEPHONE MANHOLE
 - ⊙ ELEC = EXISTING ELECTRIC MANHOLE
 - ⊙ SMH = EXISTING SEWER MANHOLE
 - WSO = EXISTING WATER SHUTOFF
 - GSO = EXISTING GAS SHUTOFF
 - ⊙ = EXISTING LIGHT POLE
 - ⊠ = EXISTING SCUPPER
- SIGN LEGEND**
- RET = RETAIN
 - B-B = BACK TO BACK

QUALITY ASSURANCE PROGRAM: LEVEL 1

- CONVENTIONAL SYMBOLS**
- COUNTY LINE
 - TOWN LINE
 - LIMITS OF ACCESS
 - POINT OF ACCESS
 - FENCE LINE
 - STONE WALL
 - TRAVELED WAY
 - GUARD RAIL
 - RAILROAD
 - SURVEY LINE
 - CULVERT
 - POWER POLE
 - TELEPHONE POLE
 - TREES
 - CONTROL OF ACCESS
 - PROPERTY LINE
 - R.O.W. TAKING LINE
 - SLOPE RIGHTS
 - TOP OF CUT
 - TOE OF SLOPE

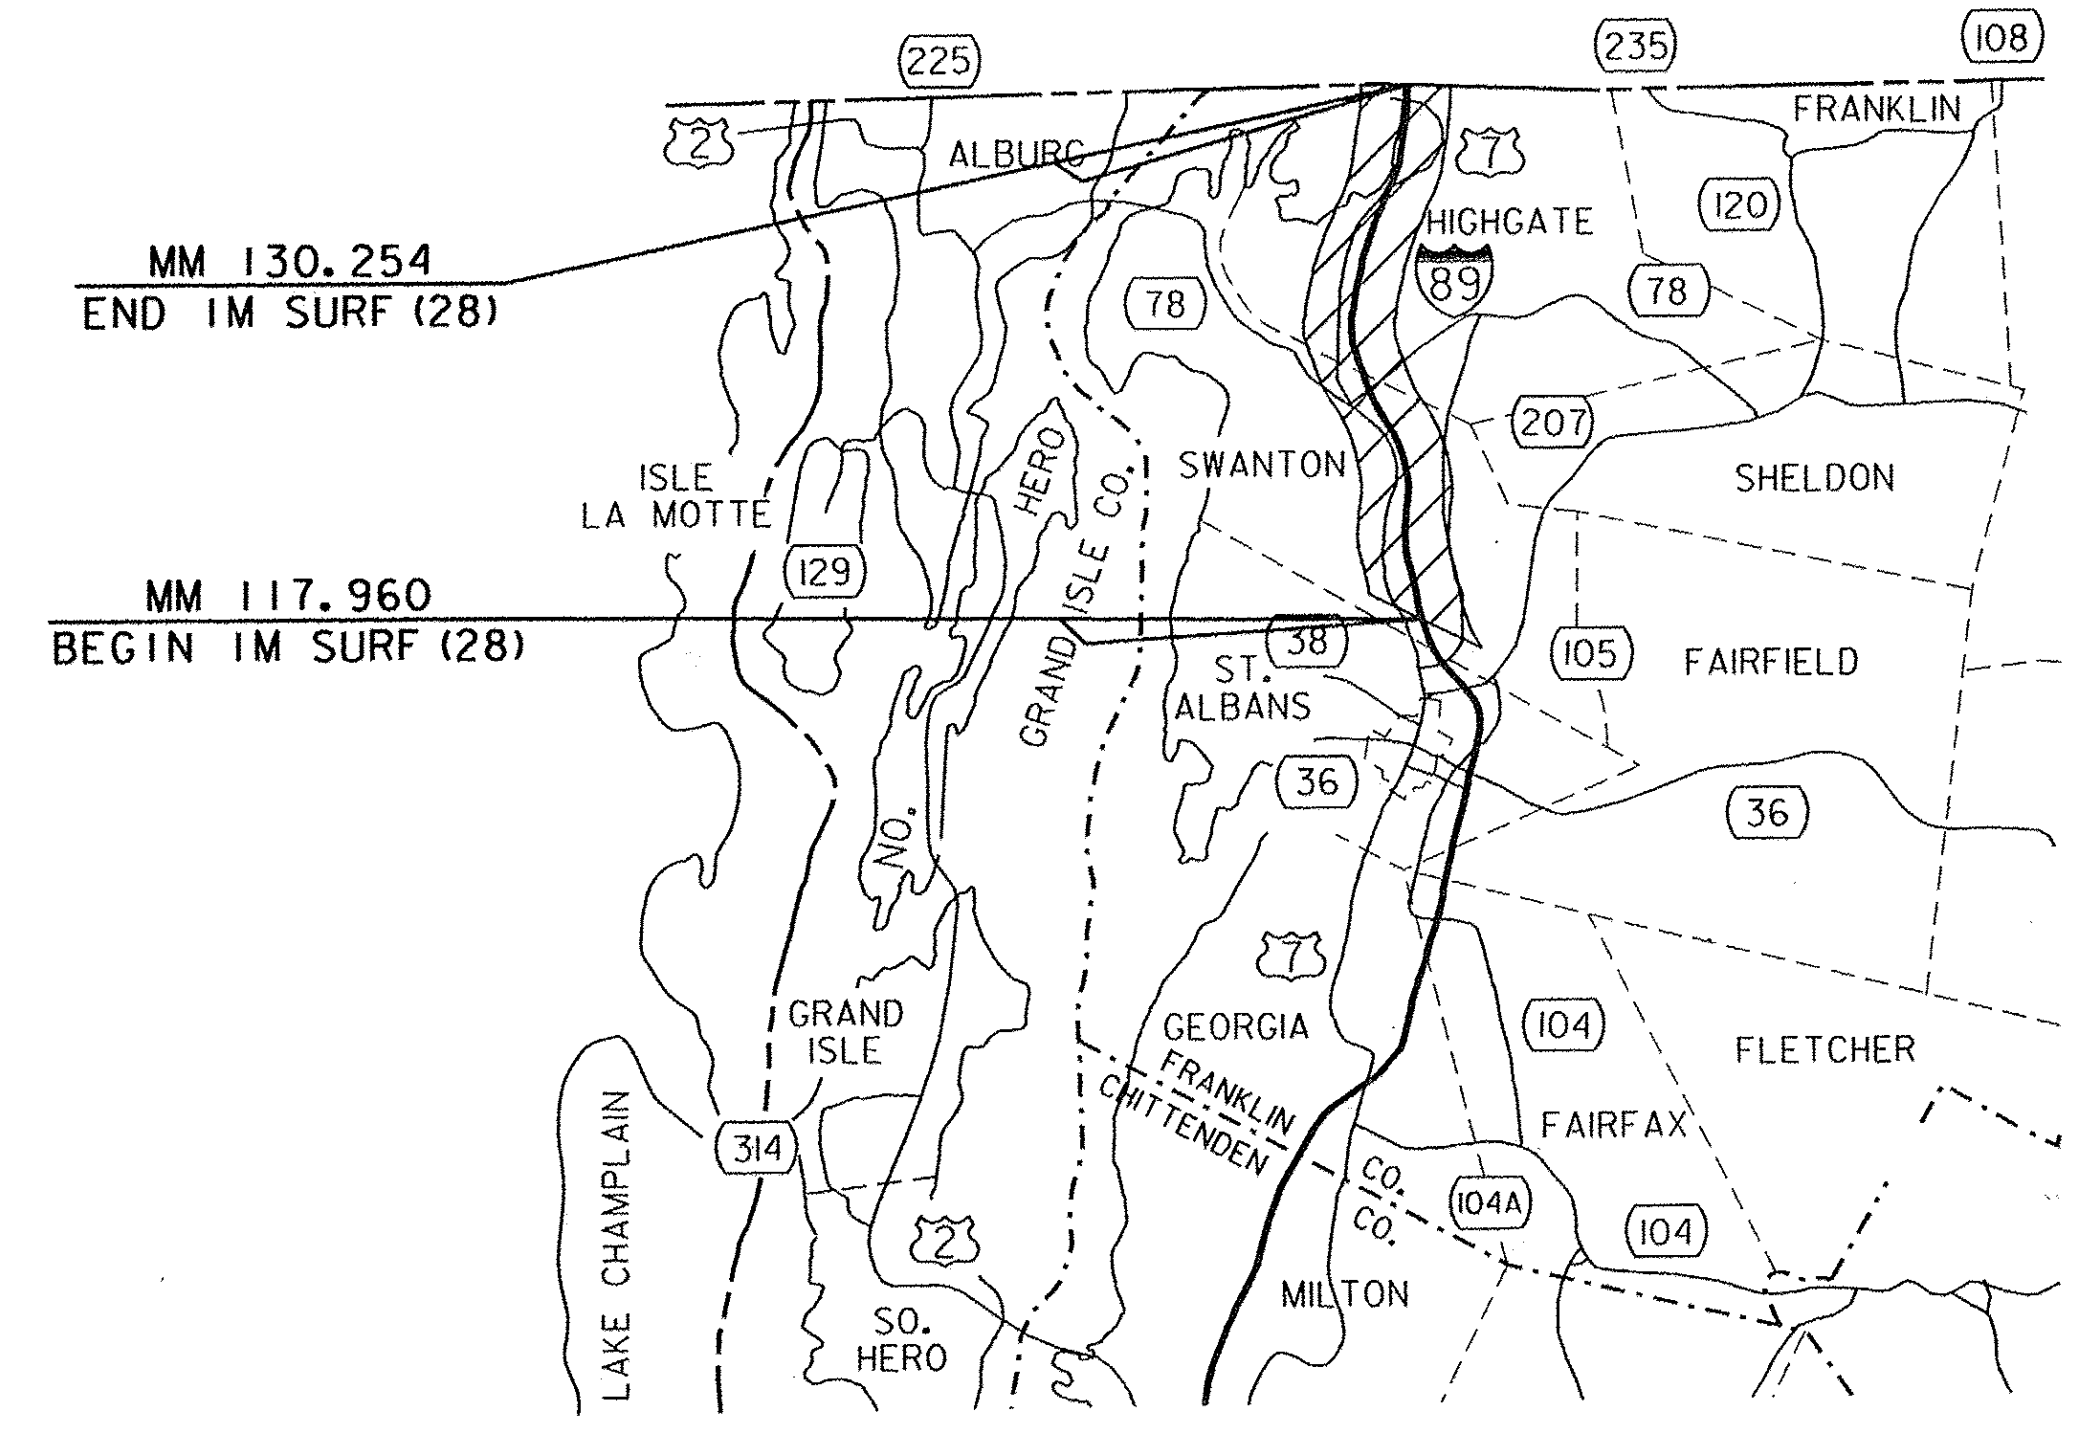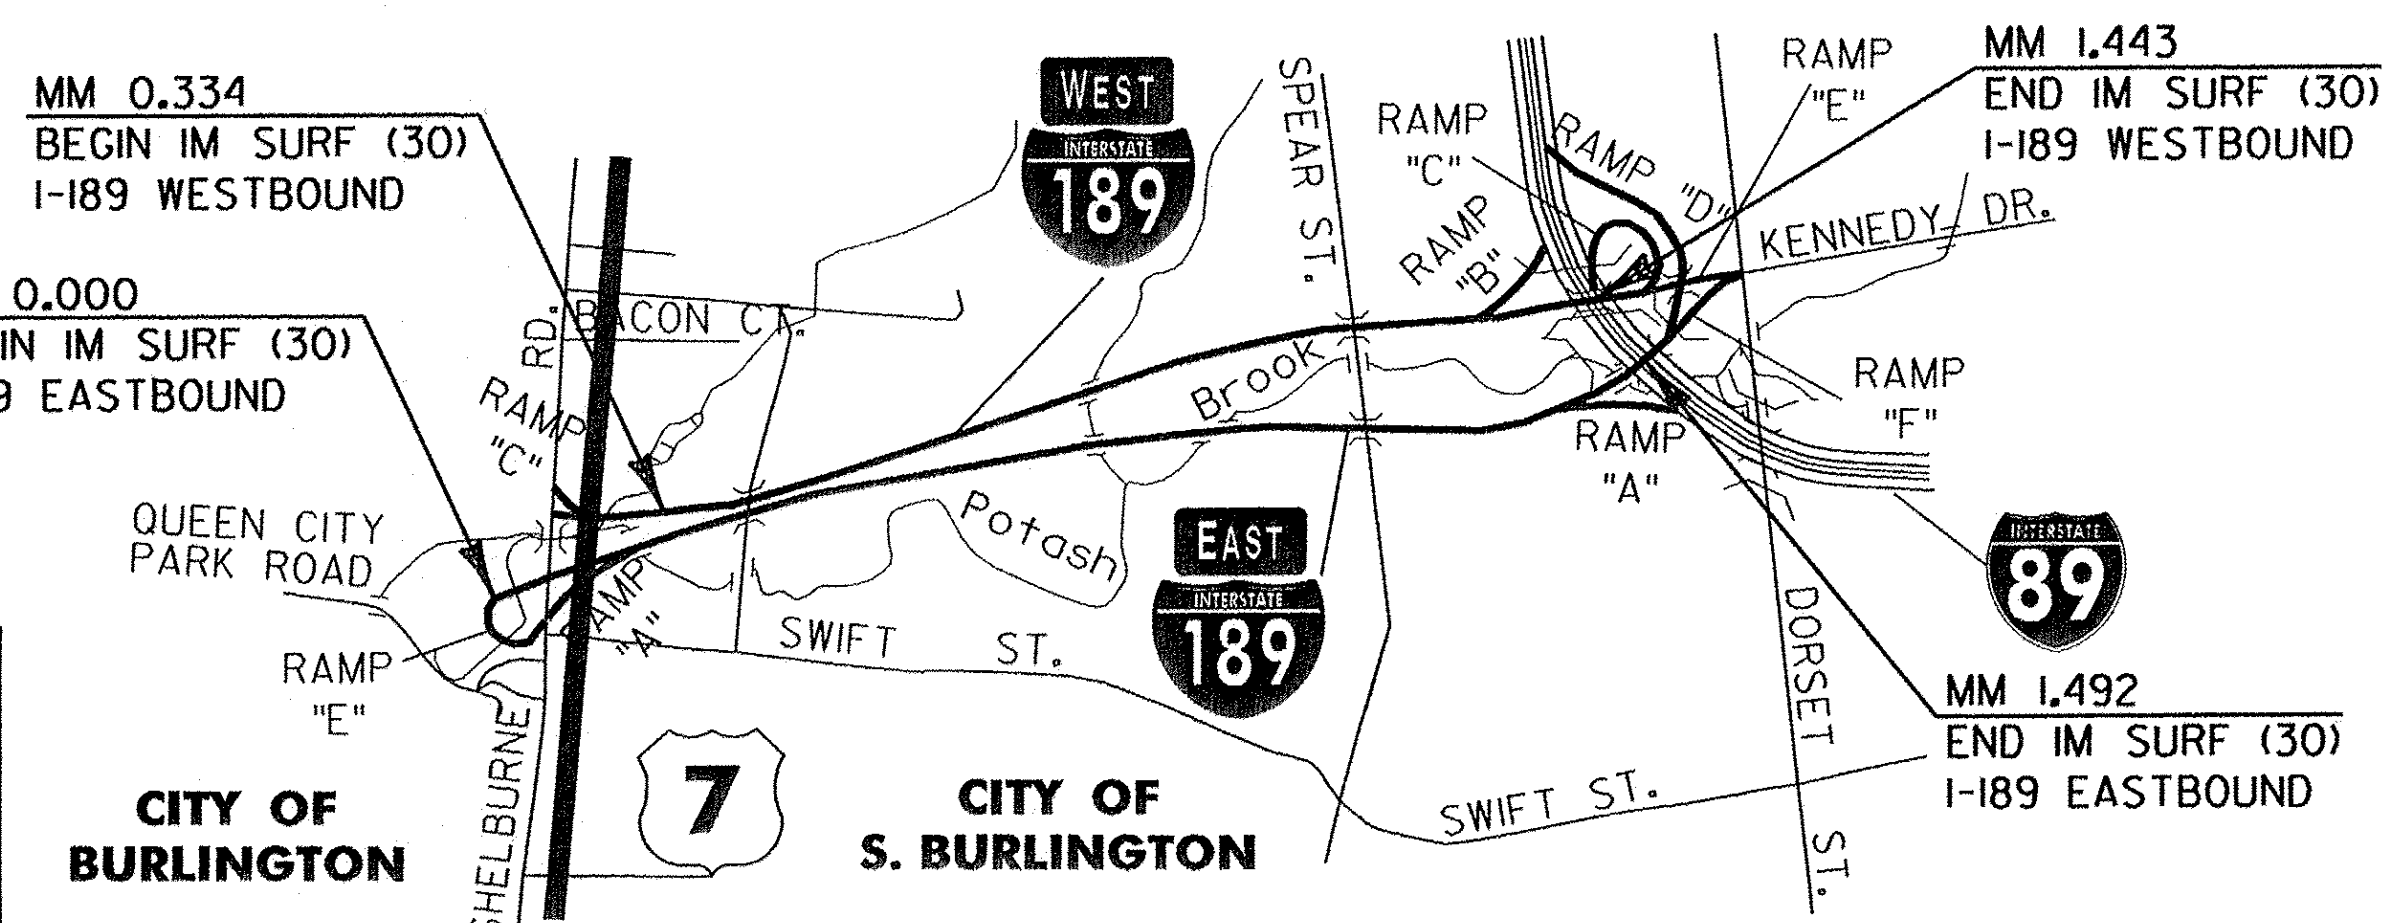

BUILT AS DESIGNED

SURVEYED BY :	N/A
SURVEYED DATE :	N/A
DATUM	
VERTICAL	N/A
HORIZONTAL	N/A

THESE PLANS ARE SUBJECT TO SUCH ENGINEERING CHANGES AS MAY BE REQUIRED BY THE FEDERAL HIGHWAY ADMINISTRATION OR THE DIRECTOR OF PROGRAM DEVELOPMENT.

CONSTRUCTION IS TO BE CARRIED ON IN ACCORDANCE WITH THESE PLANS AND THE STANDARD SPECIFICATIONS FOR CONSTRUCTION DATED 2011, AS APPROVED BY THE FEDERAL HIGHWAY ADMINISTRATION ON JULY 20, 2011 FOR USE ON THIS PROJECT, INCLUDING ALL SUBSEQUENT REVISIONS AND SUCH REVISED SPECIFICATIONS AND SPECIAL PROVISIONS AS ARE INCORPORATED IN THESE PLANS.

DIRECTOR OF PROGRAM DEVELOPMENT	
APPROVED	<i>James V. Bush</i> DATE 4-12-2012
PROJECT MANAGER : M. FOWLER	
PROJECT NAME : BURLINGTON-SO. BURLINGTON & SWANTON-HIGHGATE	
PROJECT NUMBER : IM SURF (30) & IM SURF (28)	
SHEET 1 OF 49 SHEETS	