


BRIDGE 2E

MM 0.320

LENGTH OF ASPHALTIC PLUG JOINTS:

JOINT #1 - 40'
JOINT #2 - 40'

TOTAL = 80'

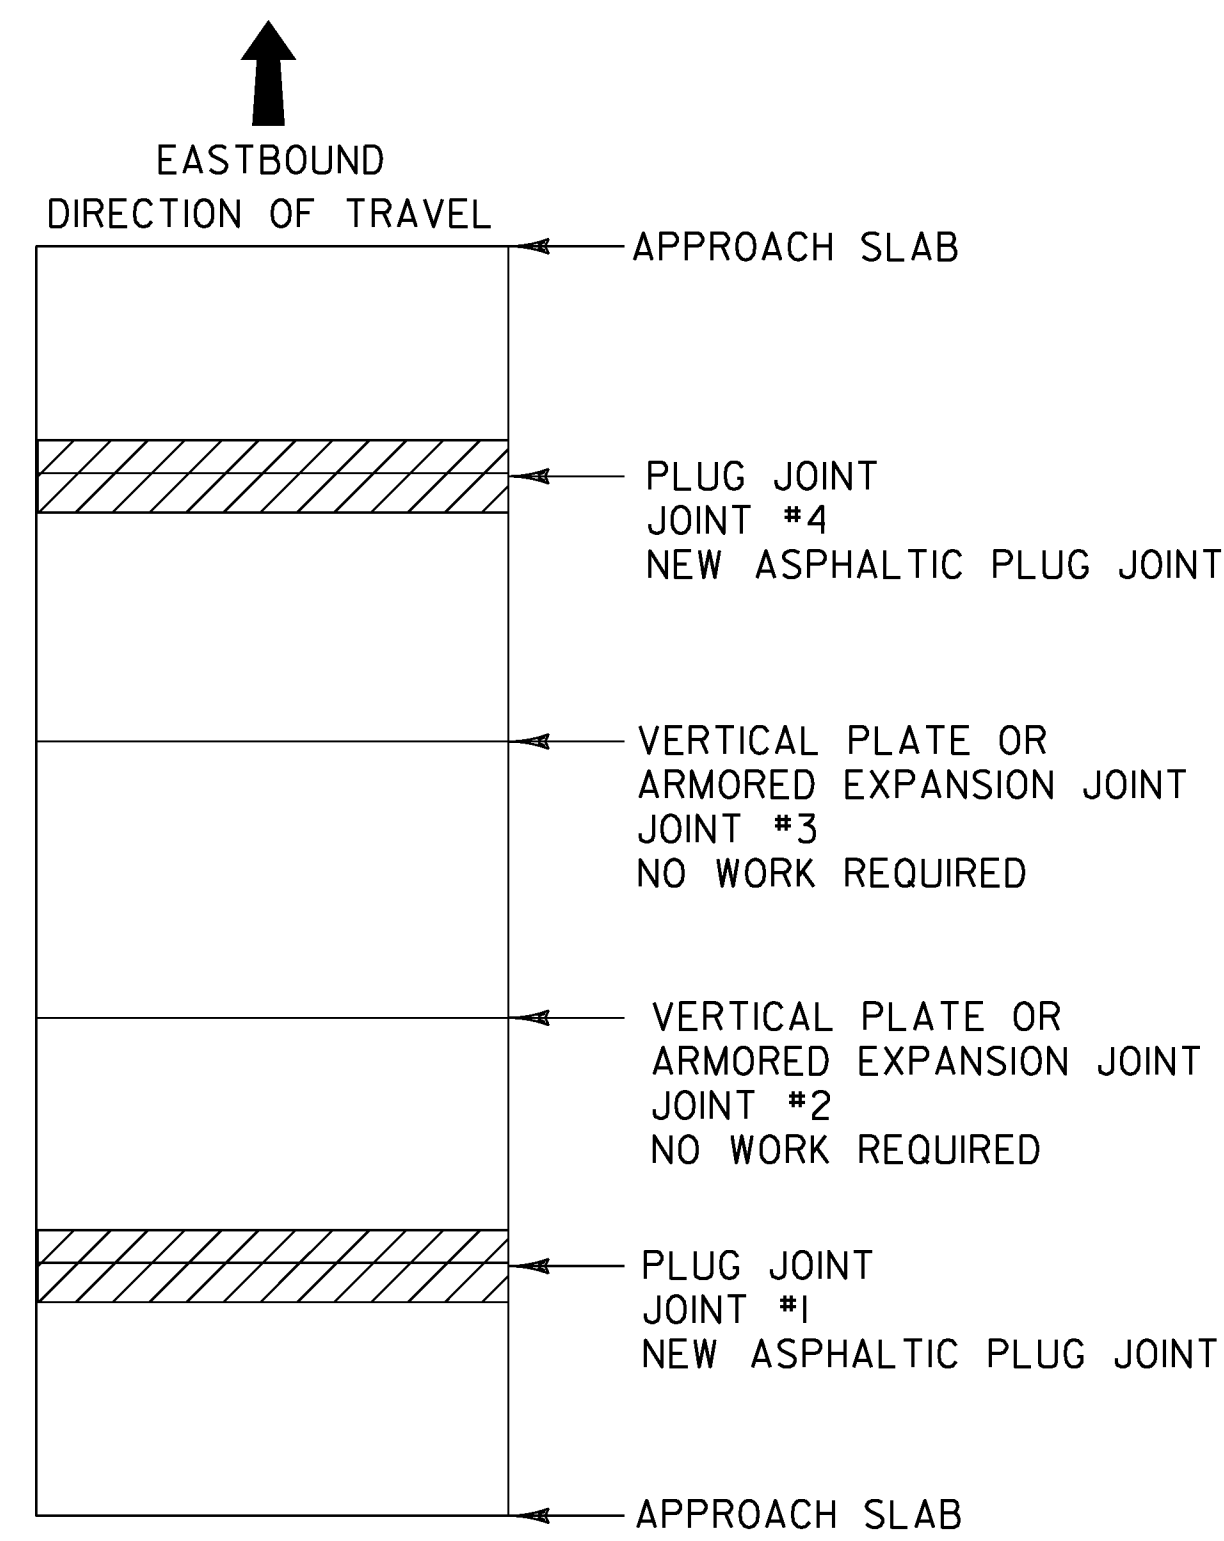


BRIDGE 3E

MM 1.116

LENGTH OF ASPHALTIC PLUG JOINTS:

JOINT #1 - 40'
JOINT #2 - 40'

TOTAL = 80'

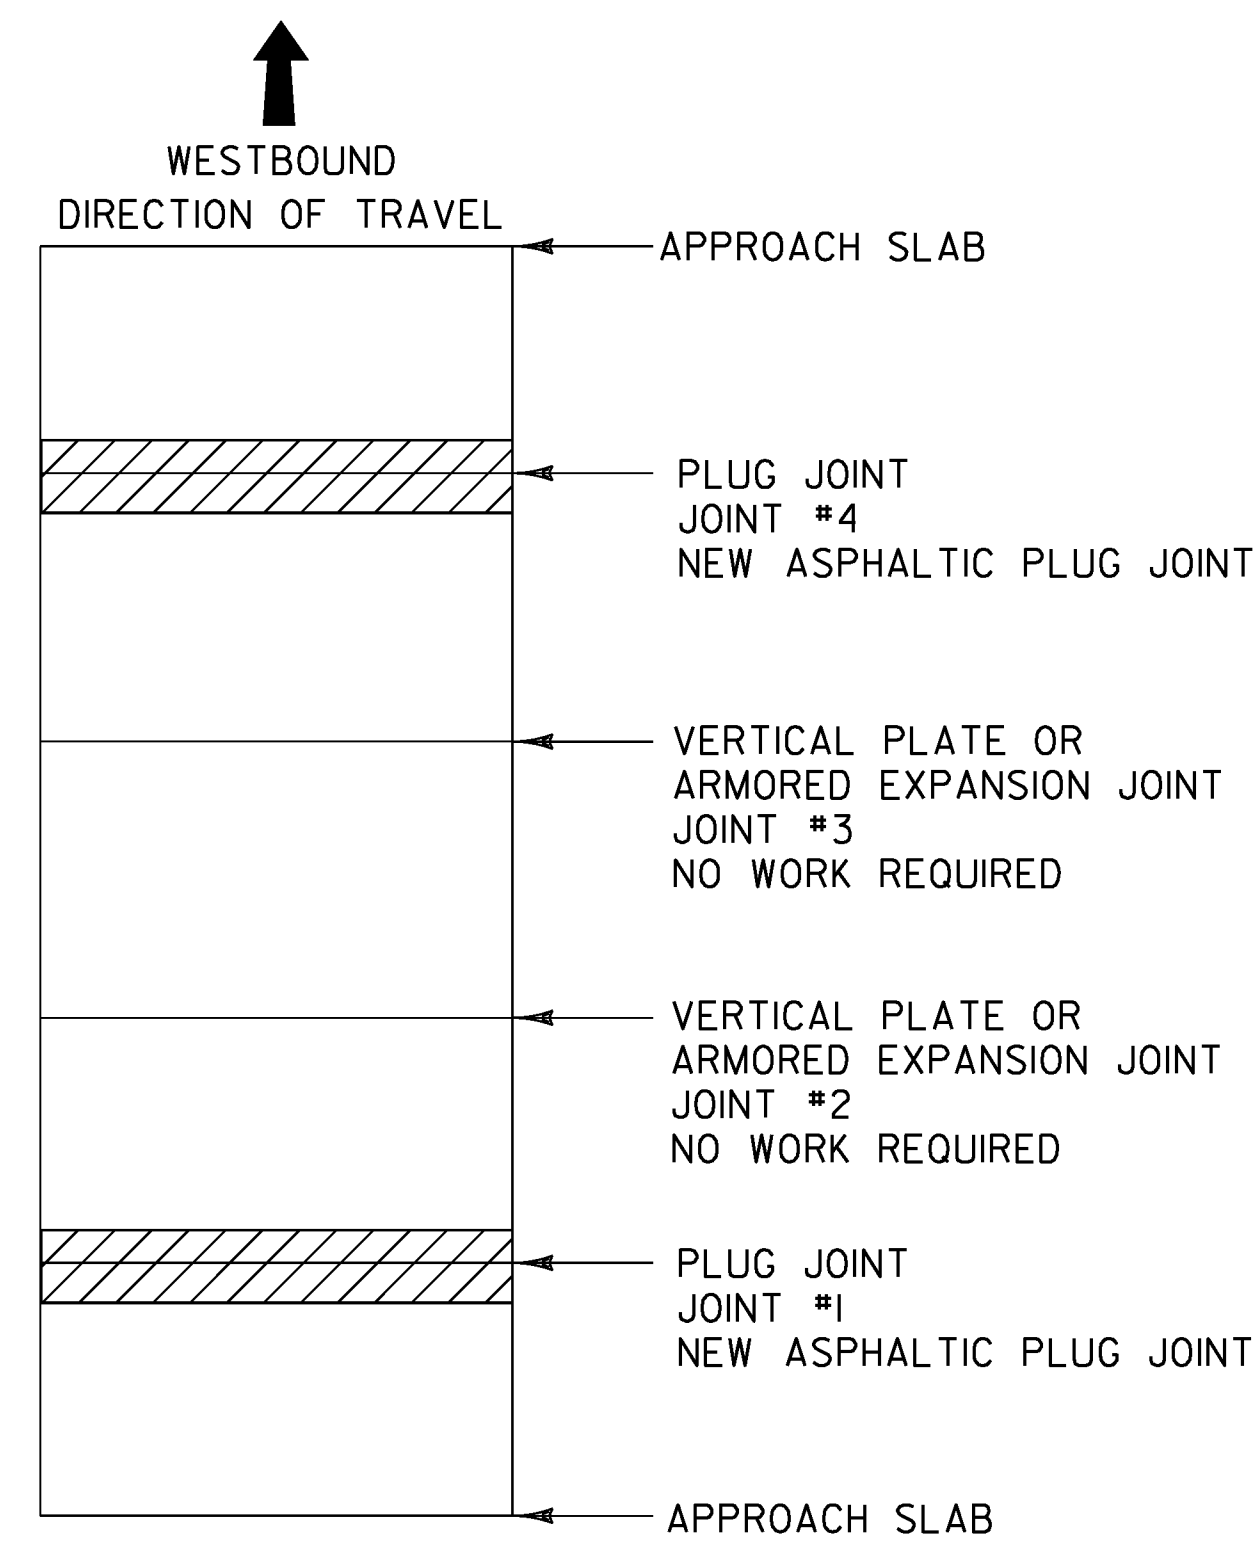


BRIDGE 3W

MM 1.126

LENGTH OF ASPHALTIC PLUG JOINTS:

JOINT #1 - 38'
JOINT #2 - 38'

TOTAL = 76'

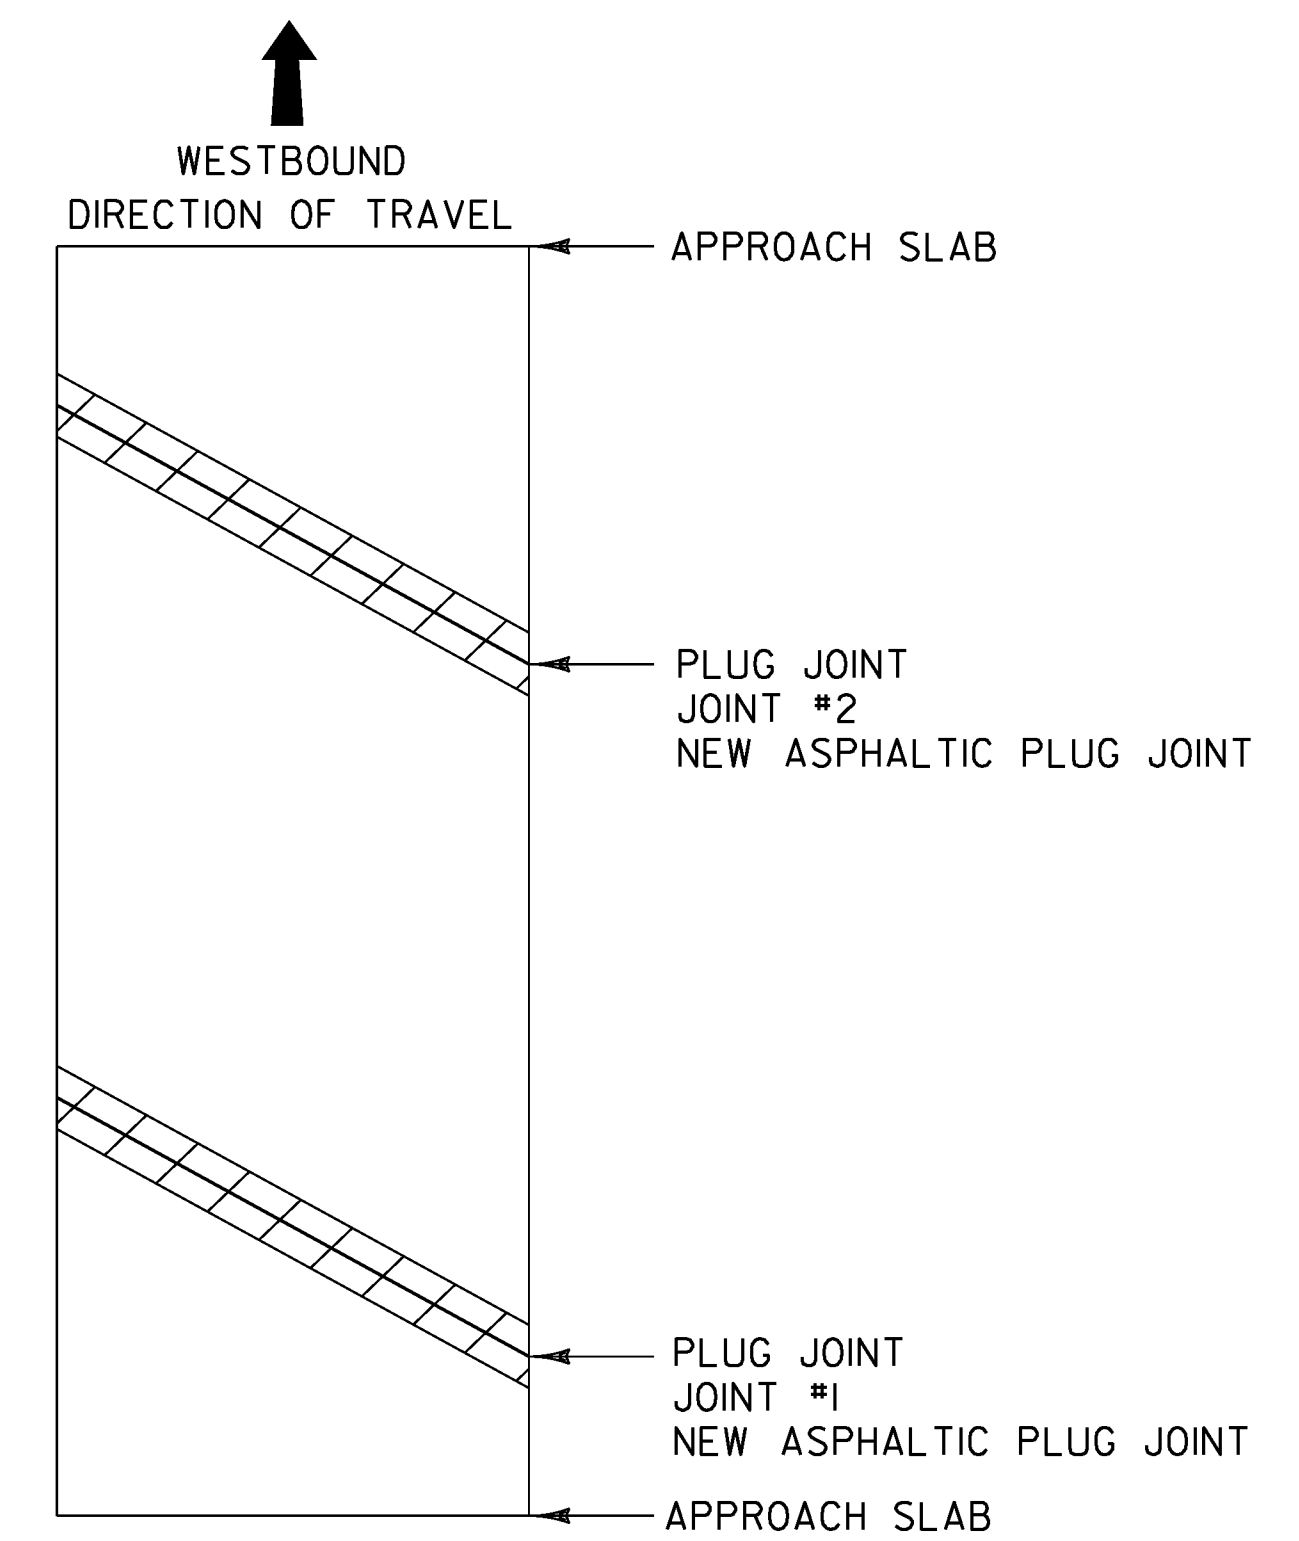


BRIDGE 2W

MM 0.324

LENGTH OF ASPHALTIC PLUG JOINTS:

JOINT #1 - 40'
JOINT #2 - 40'

TOTAL = 80'

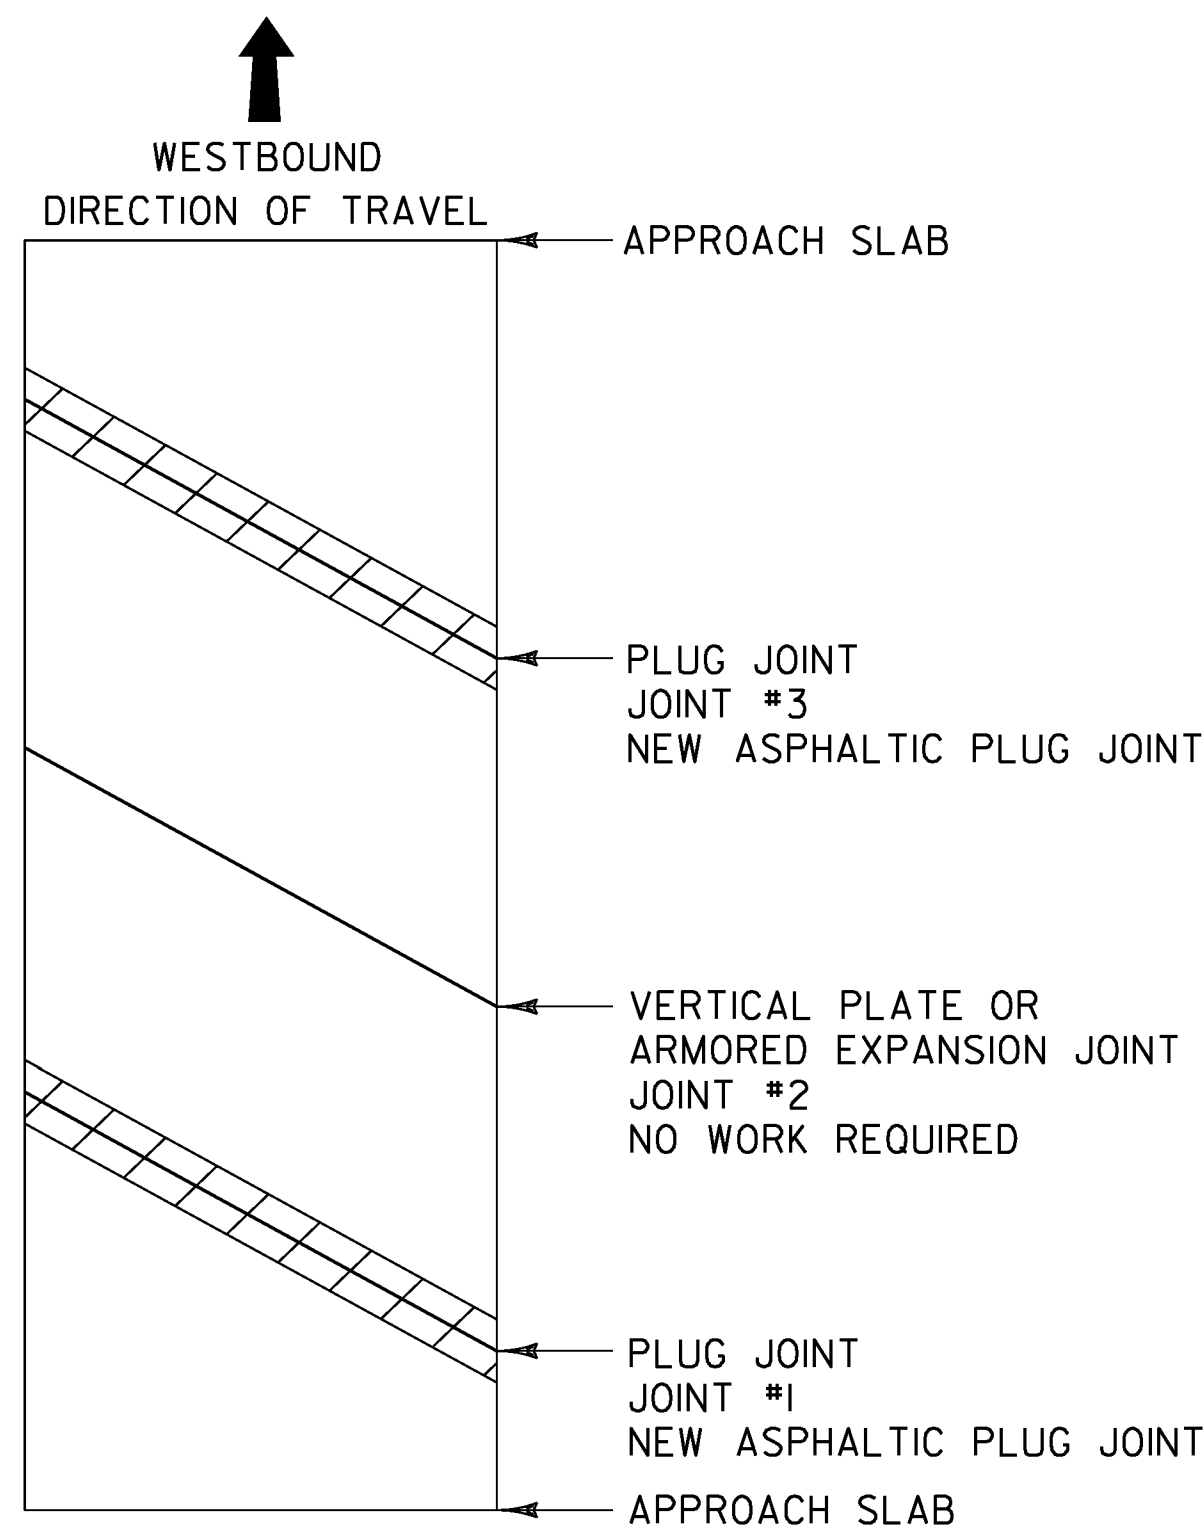

BRIDGE NO.67-E RAMP E

MM 0.097

LENGTH OF ASPHALTIC PLUG JOINTS:

JOINT #1 - 40'
JOINT #2 - 40'

TOTAL = 80'

NOTES:

- BRIDGE 4W HAS A MEMBRANE PROJECT EXPECTED TO BE COMPLETED BY JUNE 29, 2012 AND THEREFORE IS NOT INCLUDED UNDER OF THIS PROJECT.
- SEE STRUCTURES DETAIL SD-516.10, BRIDGE JOINT ASPHALTIC PLUG FOR NOTES AND DETAILS.
- AN ADDITIONAL ASPHALTIC PLUG JOINT SHALL BE INSTALLED AT RAMP C MM 0.203 (SEE LAYOUT SHEET #4).

**BRIDGE
DETAIL SHEET**

PROJECT NAME:	BURLINGTON-SO. BURLINGTON
PROJECT NUMBER:	IM SURF (30)
FILE NAME: Ila028.dgn	PLOT DATE: 12-APR-2012
PROJECT LEADER: M. FOWLER	DRAWN BY: L. BULLOCK
DESIGNED BY: L. BULLOCK	CHECKED BY: PAVT MGMT
IPARM FILE NAME: Ila028bdl.1	SHEET 12 OF 49

NOT TO SCALE