

TEMPORARY 6" WHITE LINE
 I-189 EB MM 0.162 TO I-189 EB MM 0.193, SOLID RT.
 I-189 EB MM 0.162 TO I-189 EB MM 0.270, DASHED CENTERLINE
 I-189 EB MM 0.193 TO I-189 EB MM 0.270, SOLID RT.
 I-189 EB MM 0.232 TO I-189 EB MM 0.270, DOTTED RT.
 RAMP A MM 0.137 TO RAMP A MM 0.169, SOLID RT.
 RAMP C MM 0.062 TO RAMP C MM 0.162, SOLID RT./DASHED CENTERLINE

6" WHITE LINE
 I-189 EB MM 0.162 TO I-189 EB MM 0.193, SOLID RT.
 I-189 EB MM 0.162 TO I-189 EB MM 0.270, DASHED CENTERLINE
 I-189 EB MM 0.193 TO I-189 EB MM 0.270, SOLID RT.
 I-189 EB MM 0.232 TO I-189 EB MM 0.270, DOTTED RT.
 RAMP A MM 0.137 TO RAMP A MM 0.169, SOLID RT.
 RAMP C MM 0.062 TO RAMP C MM 0.162, SOLID RT./DASHED CENTERLINE

TEMPORARY 6" YELLOW LINE
 I-189 EB MM 0.162 TO I-189 EB MM 0.270, SOLID LT.
 RAMP A MM 0.137 TO RAMP A MM 0.169, SOLID LT.
 RAMP C MM 0.062 TO RAMP C MM 0.162, SOLID LT.


6" YELLOW LINE
 I-189 EB MM 0.162 TO I-189 EB MM 0.270, SOLID LT.
 RAMP A MM 0.137 TO RAMP A MM 0.169, SOLID LT.
 RAMP C MM 0.062 TO RAMP C MM 0.162, SOLID LT.

TEMPORARY LETTER OR SYMBOL
 RAMP C MM 0.109, LT. & RT. - "SIGNAL"
 RAMP C MM 0.117, LT. & RT. - "AHEAD"

LETTER OR SYMBOL
 RAMP C MM 0.109, LT. & RT. - "SIGNAL"
 RAMP C MM 0.117, LT. & RT. - "AHEAD"

TEMPORARY 12" WHITE LINE
 I-189 EB MM 0.193 TO I-189 EB MM 0.232, DOUBLE SOLID RT.

12" WHITE LINE
 I-189 EB MM 0.193 TO I-189 EB MM 0.232, DOUBLE SOLID RT.

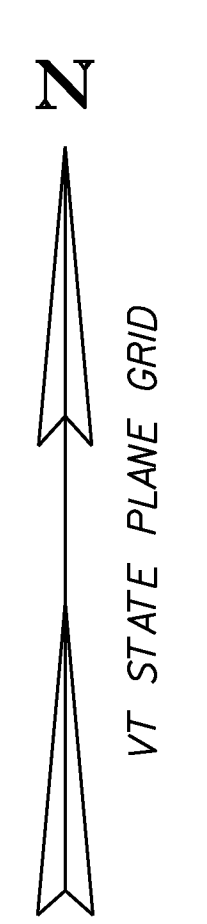

NOTES: 1) FOR STRIPING DETAILS AT THE GORES, SEE VAOT STANDARDS E-191 & E-192
 2) DIRECTION OF TRAVEL →
 3) EW= EXISTING ROADWAY WIDTH

NOT TO SCALE

LAYOUT SHEET #3	PROJECT NAME: BURLINGTON-SO. BURLINGTON
	PROJECT NUMBER: IM SURF (30)
FILE NAME: Ila028/Ila028.dgn	PLOT DATE: 12-APR-2012
PROJECT LEADER: M. FOWLER	DRAWN BY: L. BULLOCK
DESIGNED BY: L. BULLOCK	CHECKED BY: M. FOWLER
Ila028Ia3.1	SHEET 18 OF 49