
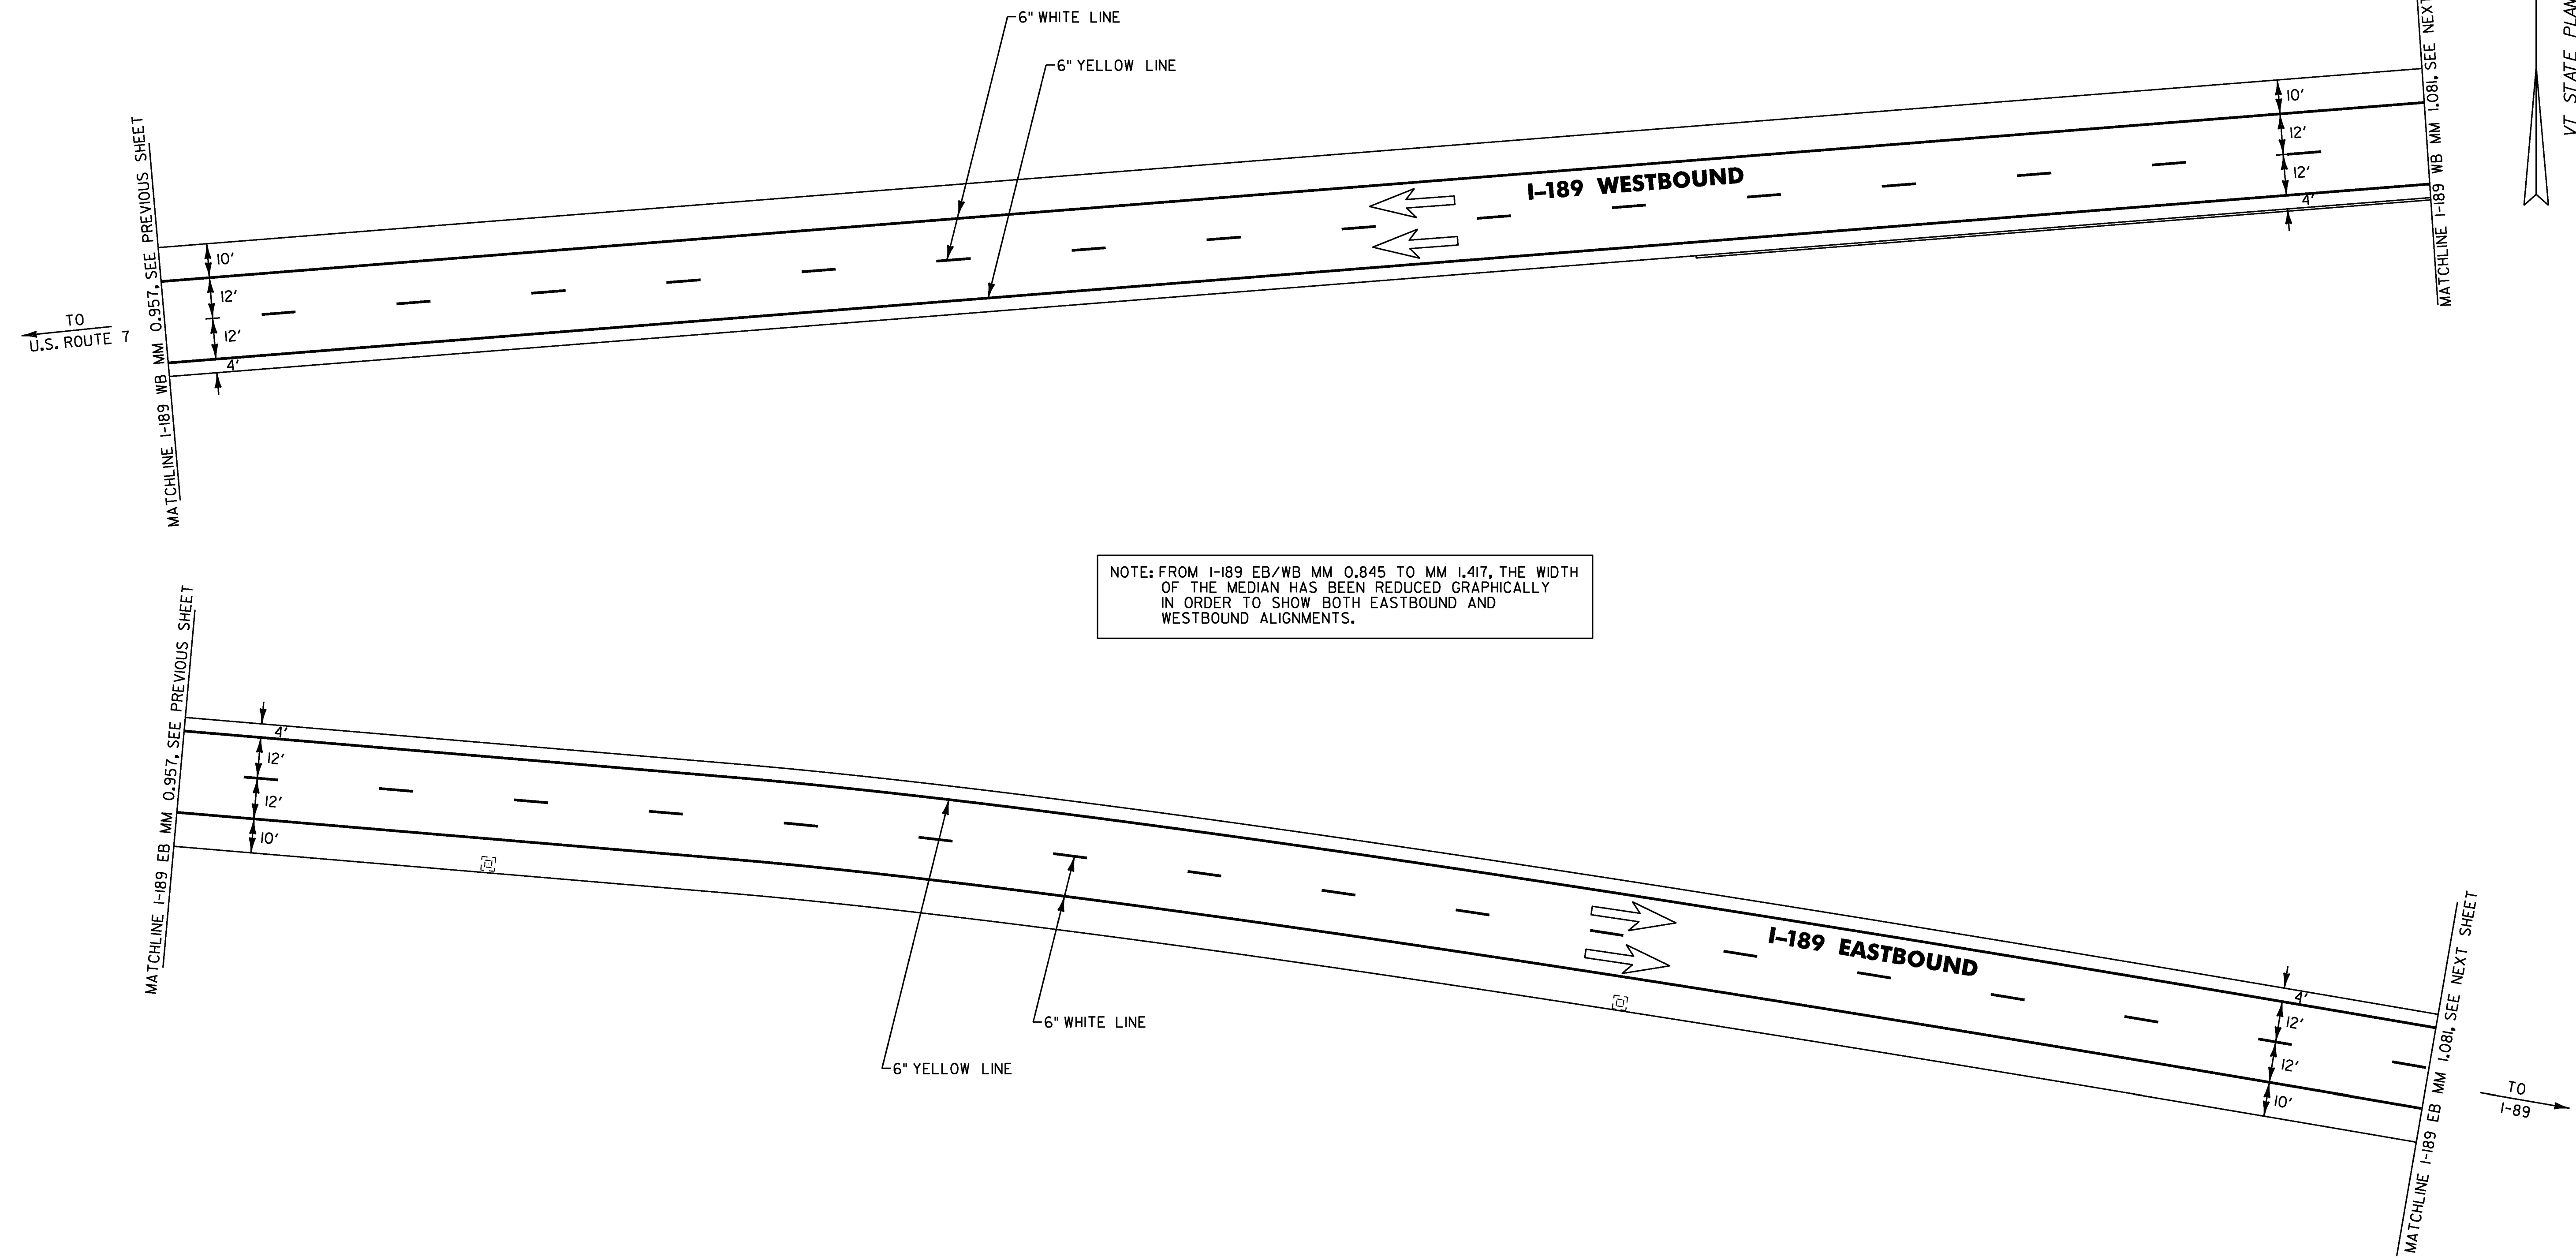


TEMPORARY 6" WHITE LINE
 I-189 EB MM 0.957 TO I-189 EB MM 1.081, DASHED CENTERLINE/SOLID RT.
 I-189 WB MM 0.957 TO I-189 WB MM 1.081, DASHED CENTERLINE/SOLID LT.

TEMPORARY 6" YELLOW LINE
 I-189 EB MM 0.957 TO I-189 EB MM 1.081, SOLID LT.
 I-189 WB MM 0.957 TO I-189 WB MM 1.081, SOLID RT.

6" WHITE LINE
 I-189 EB MM 0.957 TO I-189 EB MM 1.081, DASHED CENTERLINE/SOLID RT.
 I-189 WB MM 0.957 TO I-189 WB MM 1.081, DASHED CENTERLINE/SOLID LT.

6" YELLOW LINE
 I-189 EB MM 0.957 TO I-189 EB MM 1.081, SOLID LT.
 I-189 WB MM 0.957 TO I-189 WB MM 1.081, SOLID RT.

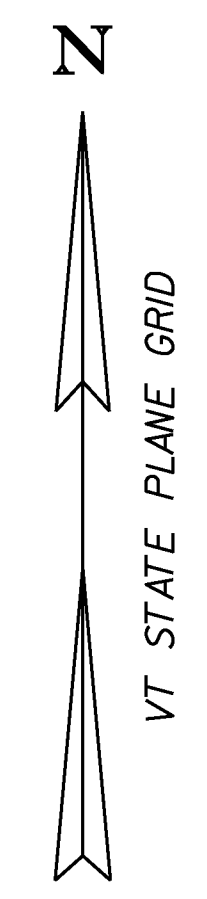

NOTE: FROM I-189 EB/WB MM 0.845 TO MM 1.417, THE WIDTH OF THE MEDIAN HAS BEEN REDUCED GRAPHICALLY IN ORDER TO SHOW BOTH EASTBOUND AND WESTBOUND ALIGNMENTS.

- NOTES: 1) FOR STRIPING DETAILS AT THE GORES, SEE VAOT STANDARDS E-191 & E-192
 2) DIRECTION OF TRAVEL
 3) EW= EXISTING ROADWAY WIDTH

NOT TO SCALE

LAYOUT SHEET #11	PROJECT NAME: BURLINGTON-SO. BURLINGTON
	PROJECT NUMBER: IM SURF (30)
FILE NAME: Ila028/Ila028.dgn	PLOT DATE: 12-APR-2012
PROJECT LEADER: M. FOWLER	DRAWN BY: L. BULLOCK
DESIGNED BY: L. BULLOCK	CHECKED BY: M. FOWLER
Ila028Ia11	SHEET 26 OF 49